


| | | | | | |
|--------------------|--------|-----------------|------|--------------|-----------------|
| FHWA REG NO. | STATE | PROJECT NO. | YEAR | SHEET NO. | TOTAL SHEETS |
| 7 | KANSAS | 54-87 K-6657-01 | 2002 | 1103 | 1122 |
| 32 | | 36 | | 40 | |

| | |
|-------------------------------------|------|
| FINAL SURVEY NOTE BOOK NO. | DATE |
| | |
| SURVEYED BY | |
| PLOTTED BY | |
| TEMPLATE AREAS | |
| CHECKED AREAS | |

DSWR: RCH OPER: SVB SCALE: 1:100
 I:/1997/07362/As-Built/sgn's/vol.5/5h_1103-Tyler-XS5630.dgn

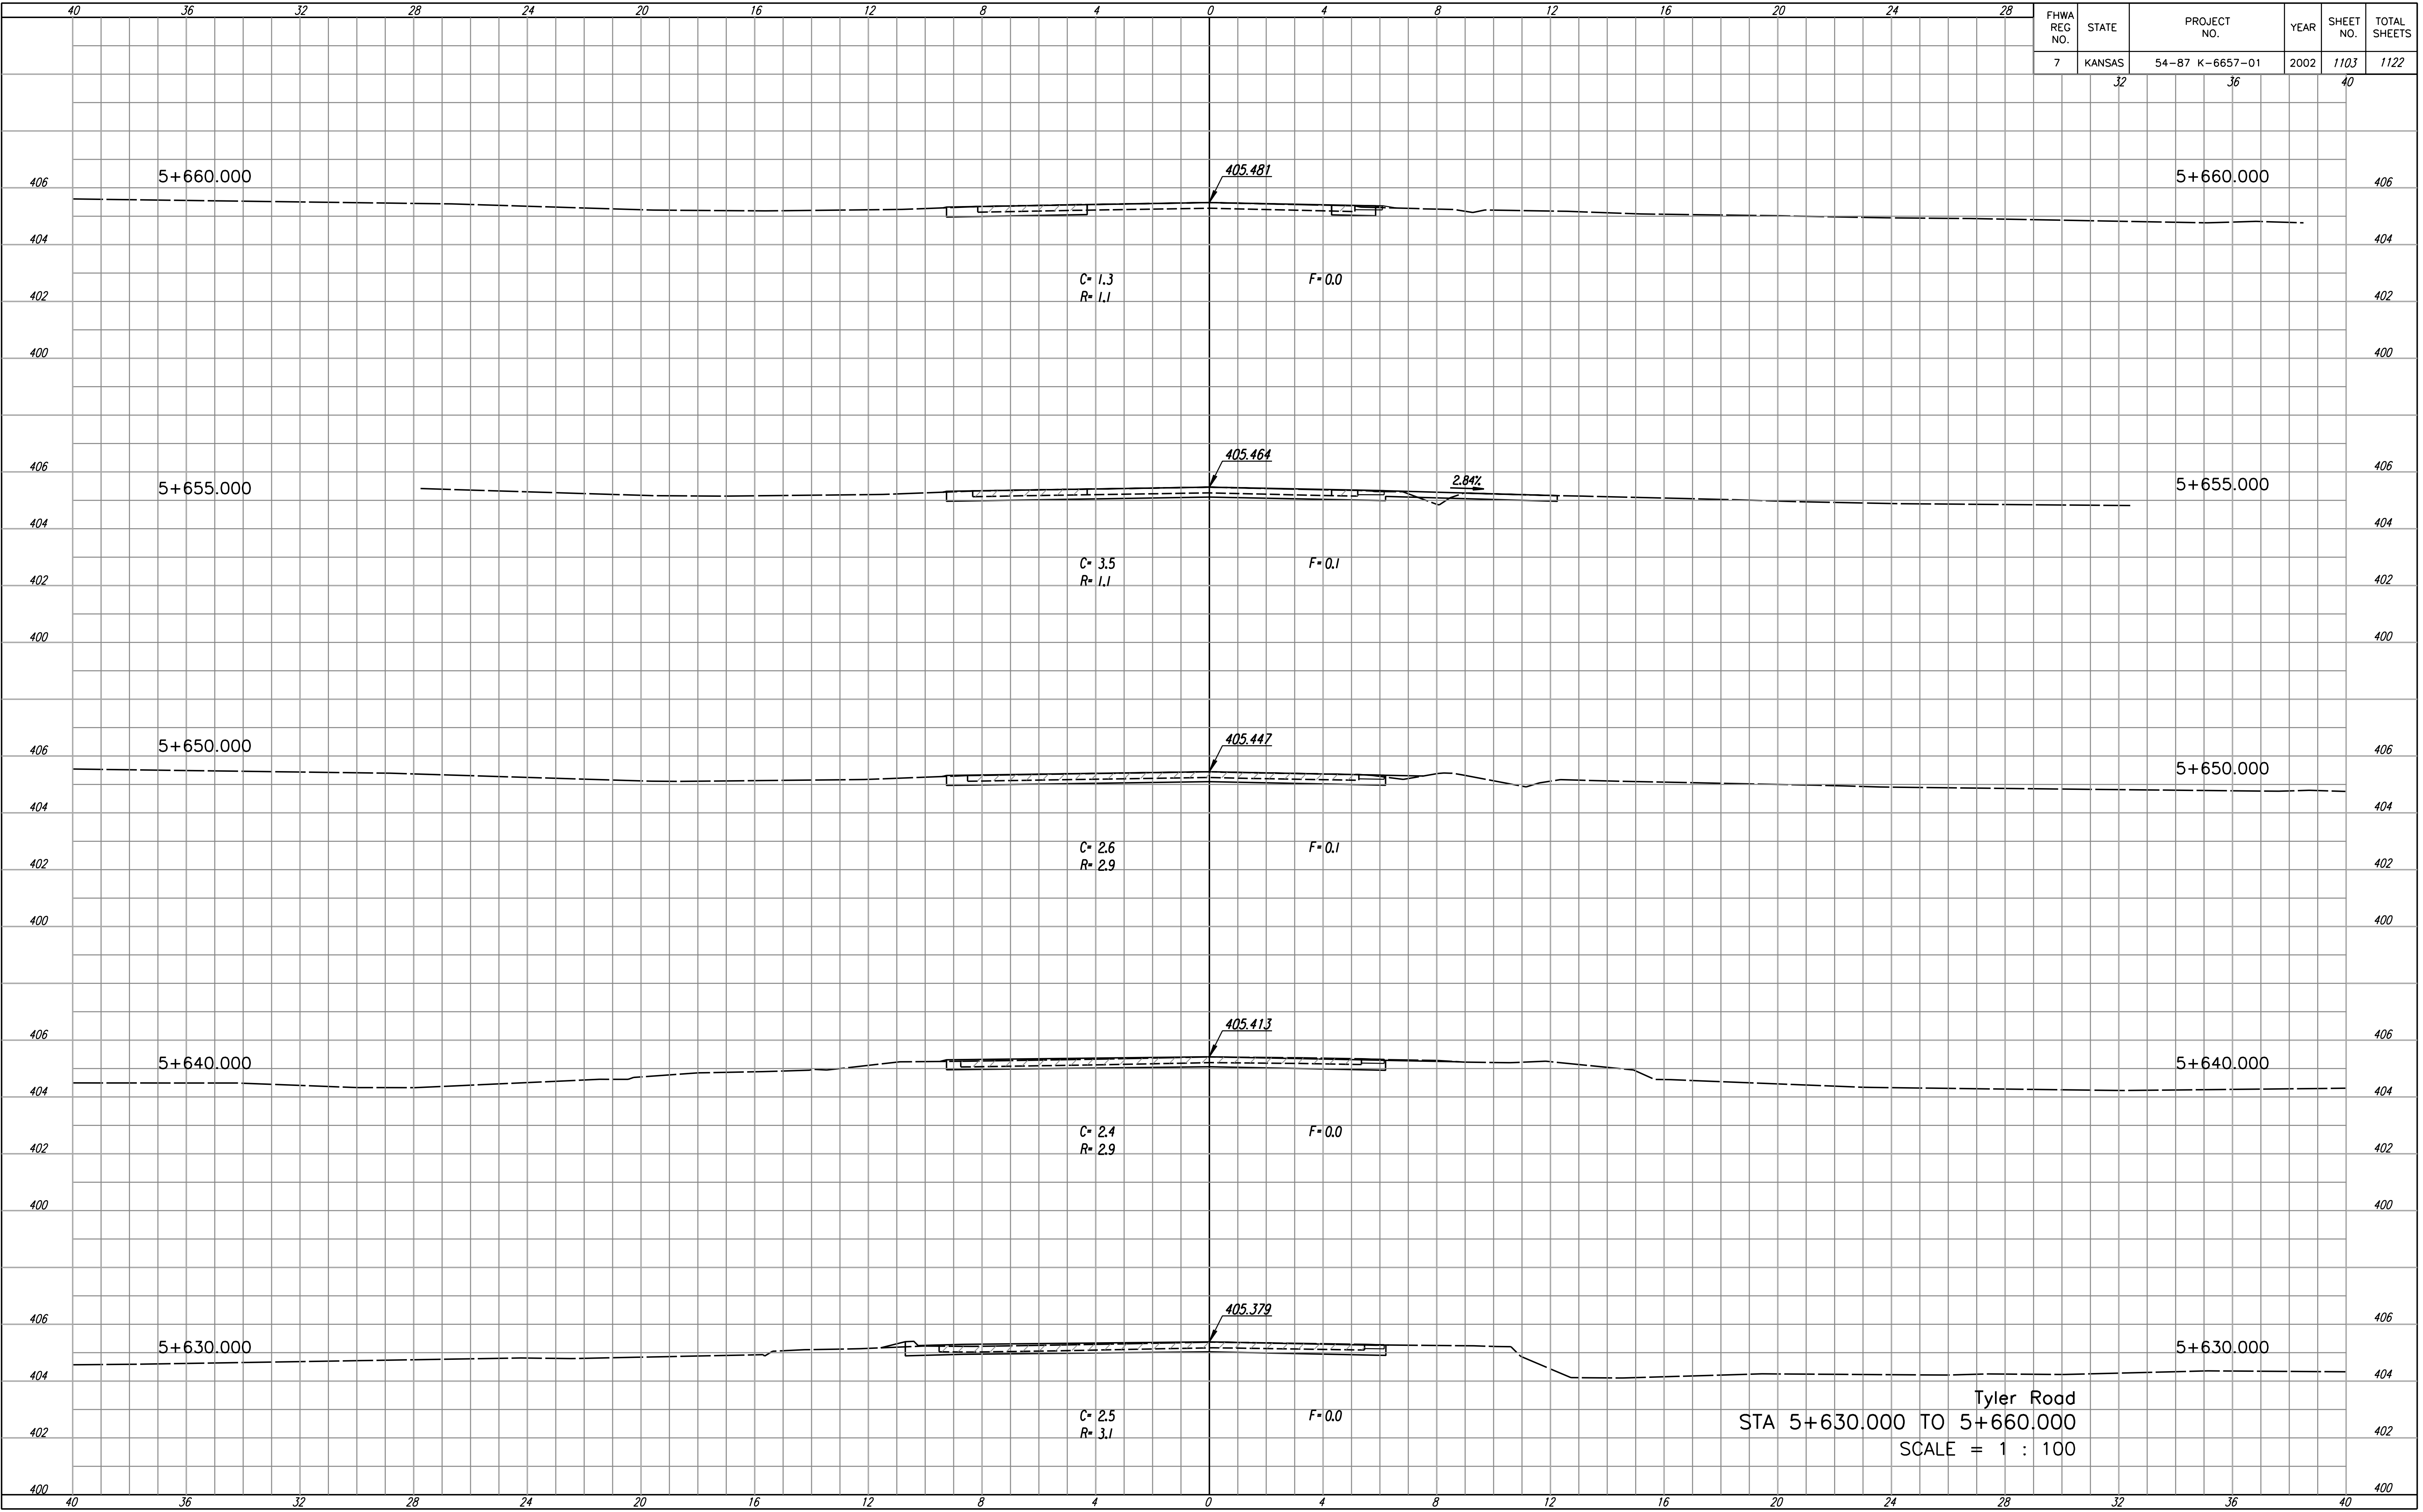

Tyler Road
 STA 5+630.000 TO 5+660.000
 SCALE = 1 : 100