


FHWA REG NO.	STATE	PROJECT NO.	YEAR	SHEET NO.	TOTAL SHEETS
7	KANSAS	54-87 K-6657-01	2002	1109	1122
		32	36	40	

FINAL SURVEY NO.	BY	DATE
SURVEYED AREAS	PLOTTED AREAS	DATE
NOTE BOOK NO.	TEMPLATE AREAS	CHECKED AREAS

DSNR: RWM OPER: SCALE: 1:100
 I:/1997/97362/As-Builts/egn's/Vol.5/Sh. 1109-Wachuck-KS4935.egn

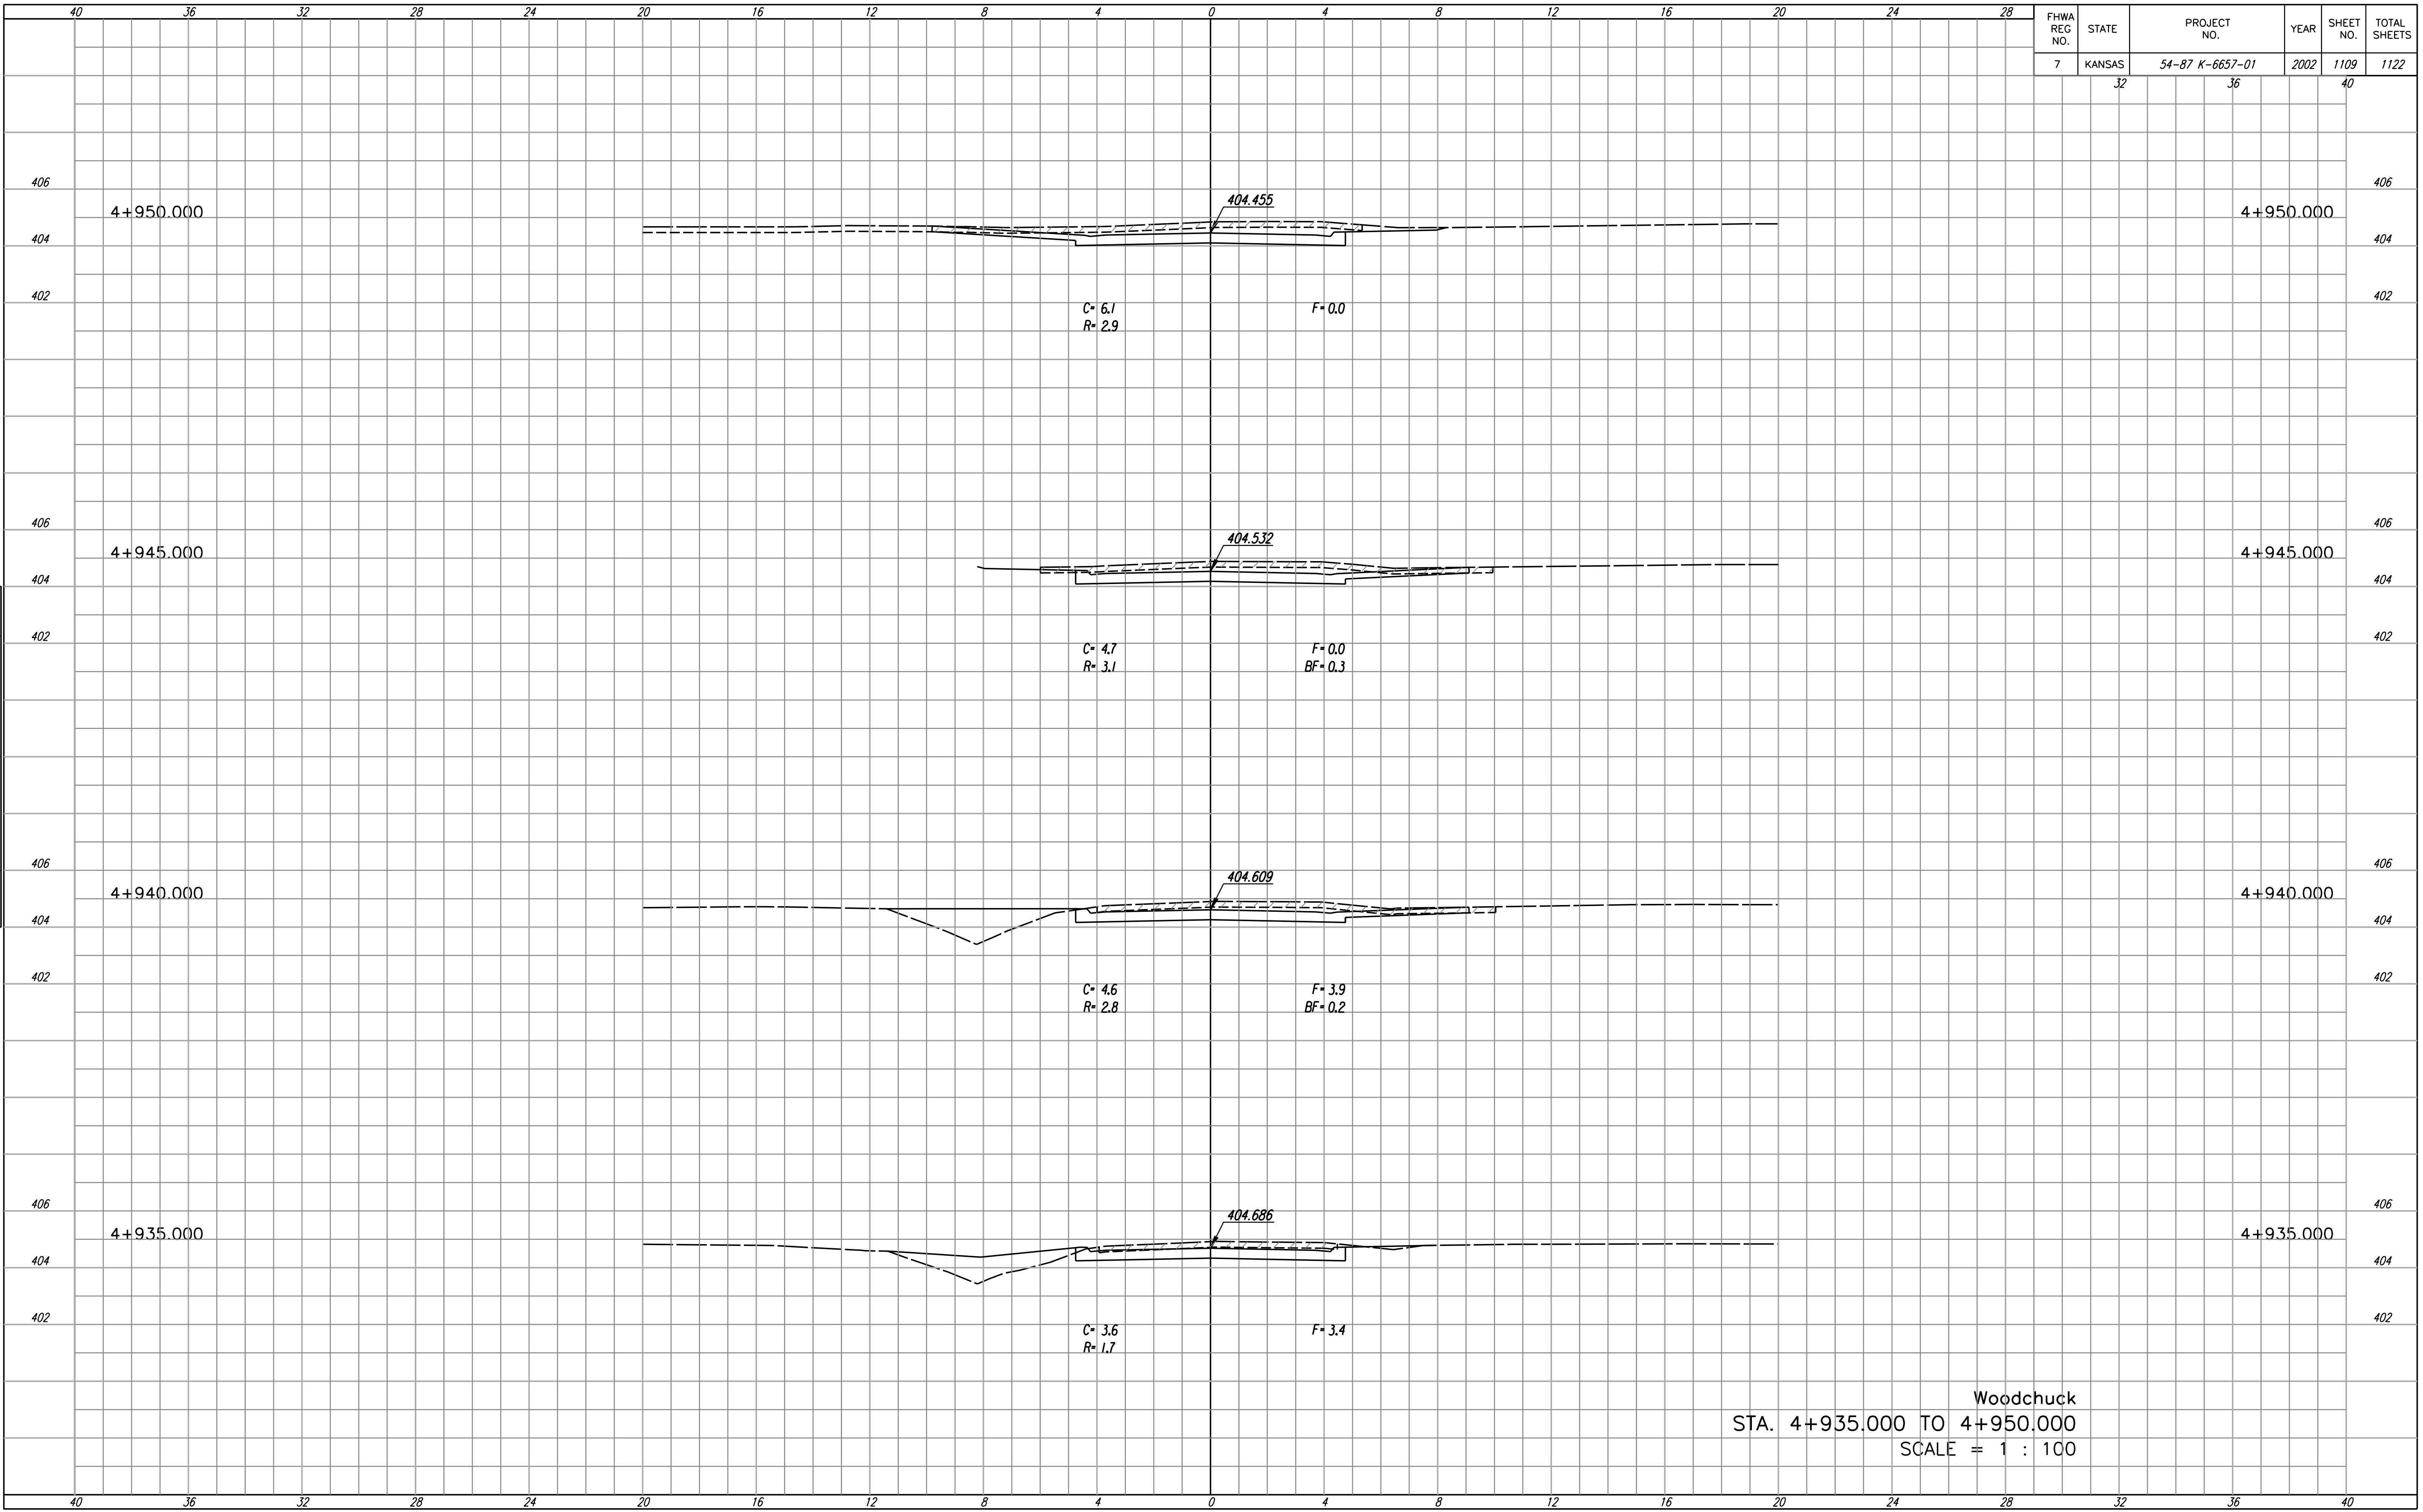

Woodchuck
 STA. 4+935.000 TO 4+950.000
 SCALE = 1 : 100