


FHWA REG NO.	STATE	PROJECT NO.	YEAR	SHEET NO.	TOTAL SHEETS
7	KANSAS	54-87 K-6657-01	2002	1121	1122

FINAL SURVEY NO.	BY	DATE
SURVEYED		
PLOTTED		
TEMPLATE		
AREAS		
CHECKED		

Drawn: RMM Oper: Scale: 1:100  
 i:\1997\97362\As-Builts\ dgn\ Vol.5\Sh\_1121-Channel-XS4914.dgn

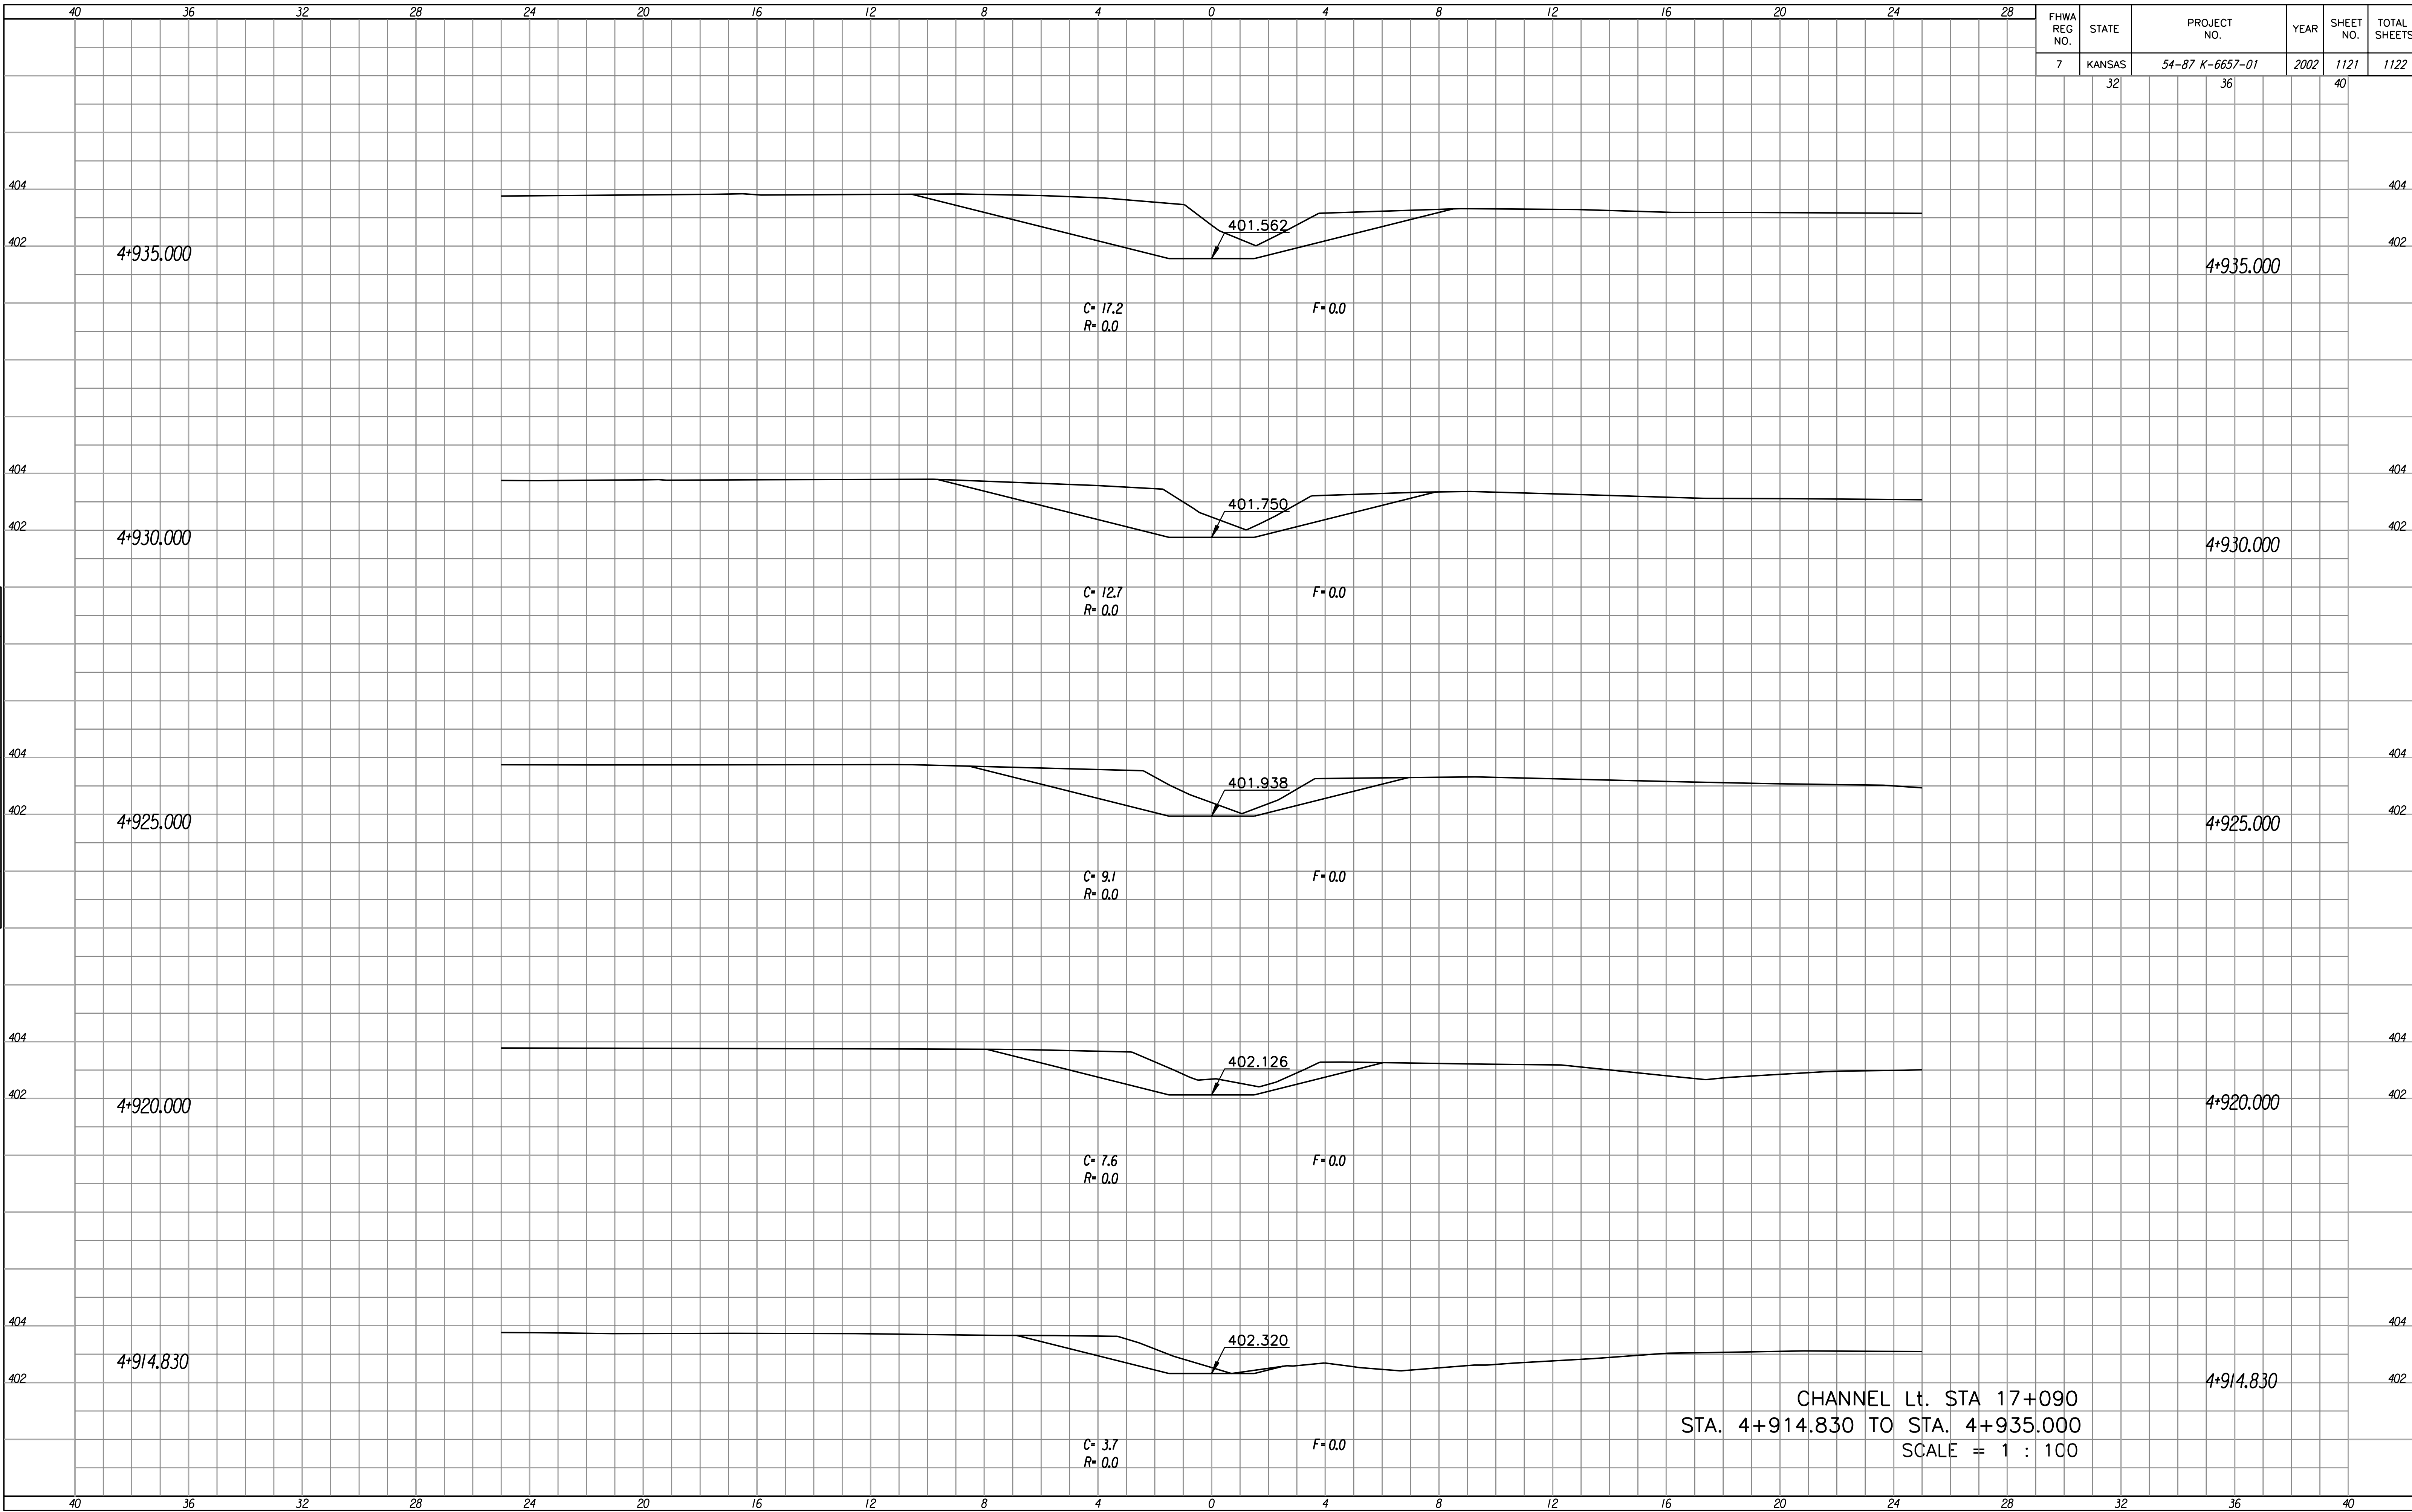

CHANNEL Lt. STA 17+090  
 STA. 4+914.830 TO STA. 4+935.000  
 SCALE = 1 : 100