


FHWA REG NO.	STATE	PROJECT NO.	YEAR	SHEET NO.	TOTAL SHEETS
7	KANSAS	54-87 K-6657-01	2002	1122	1122
32		36		40	

FINAL SURVEY NO.	BY	DATE
SURVEYED		
PLOTTED		
TEMPLATE		
AREAS		
CHECKED		

Desc: RWM Oper: Scale: 1:100
 i:/1997/97362/As-Built/dgn/1122-Channel-XS490.dgn

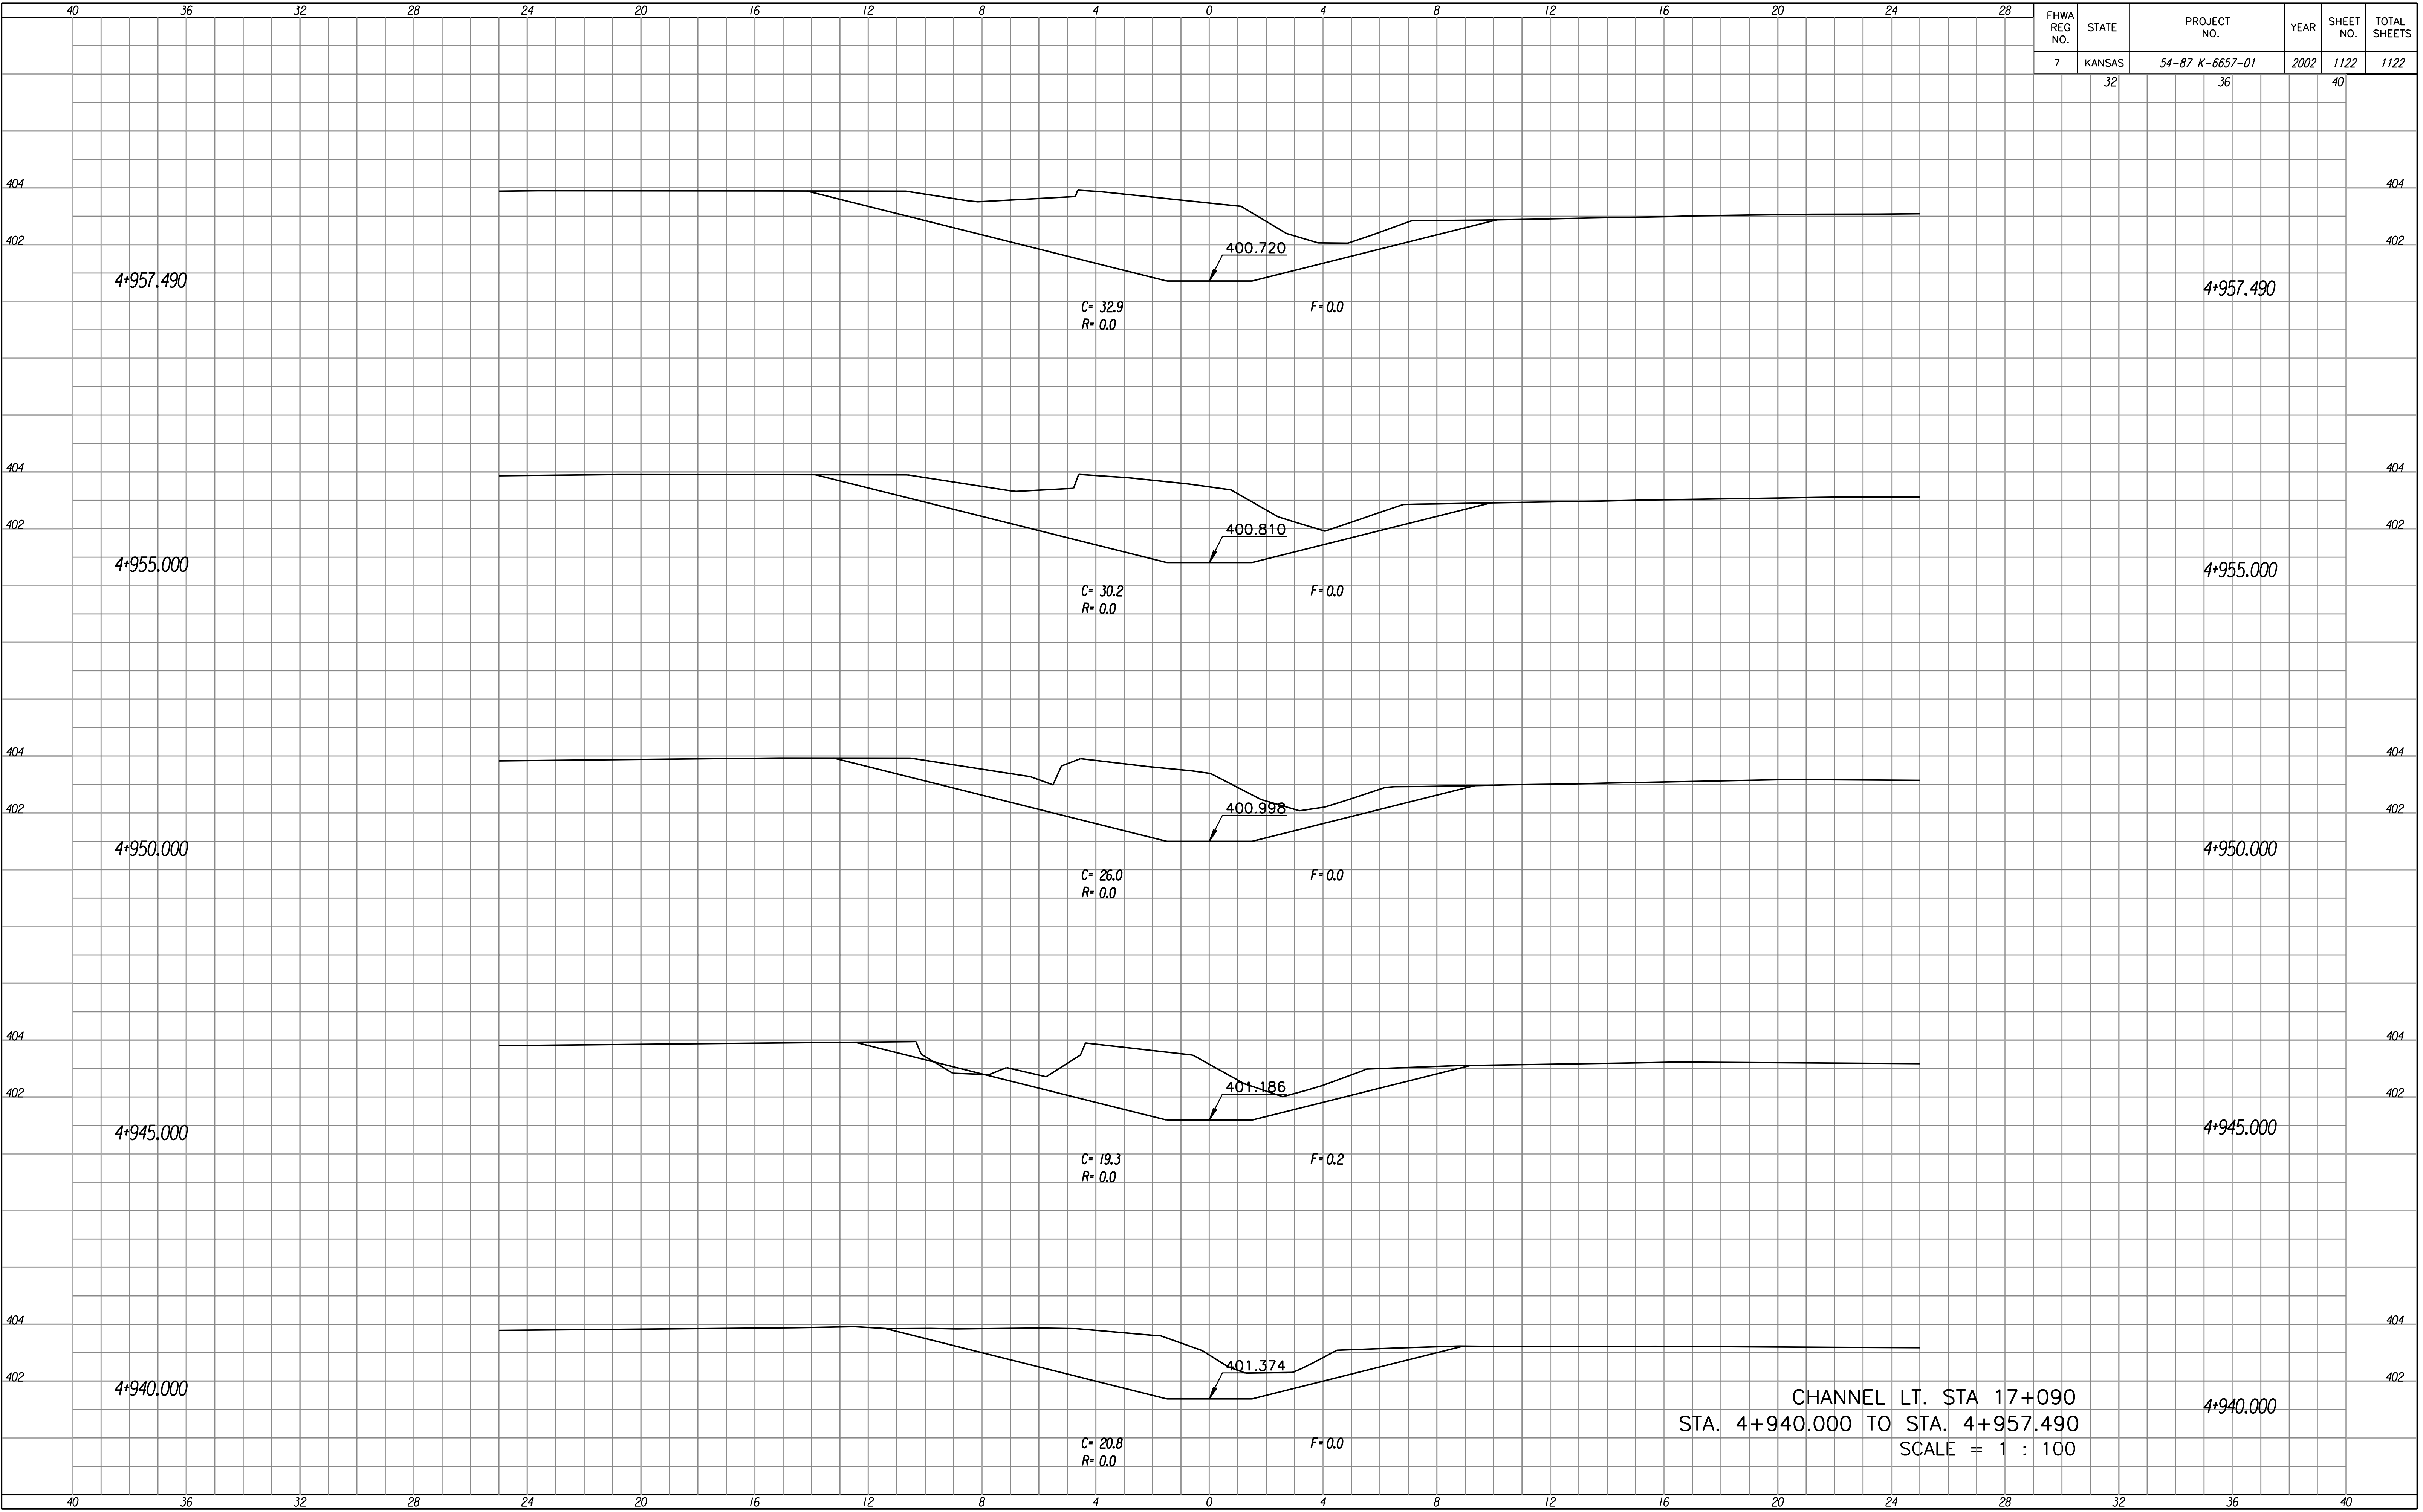

CHANNEL LT. STA 17+090
 STA. 4+940.000 TO STA. 4+957.490
 SCALE = 1 : 100