




24" RCP and Sea Wall (Plan Detail)

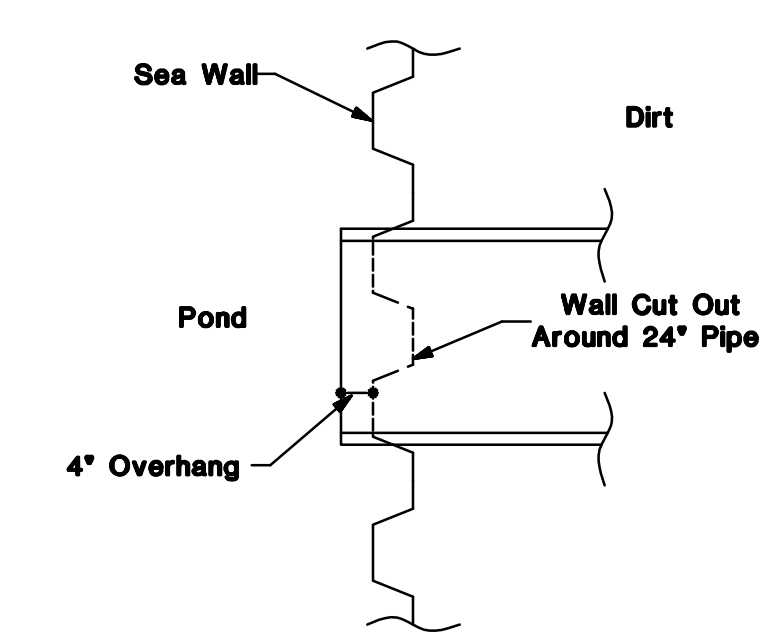

24" RCP and Sea Wall (Profile Detail)

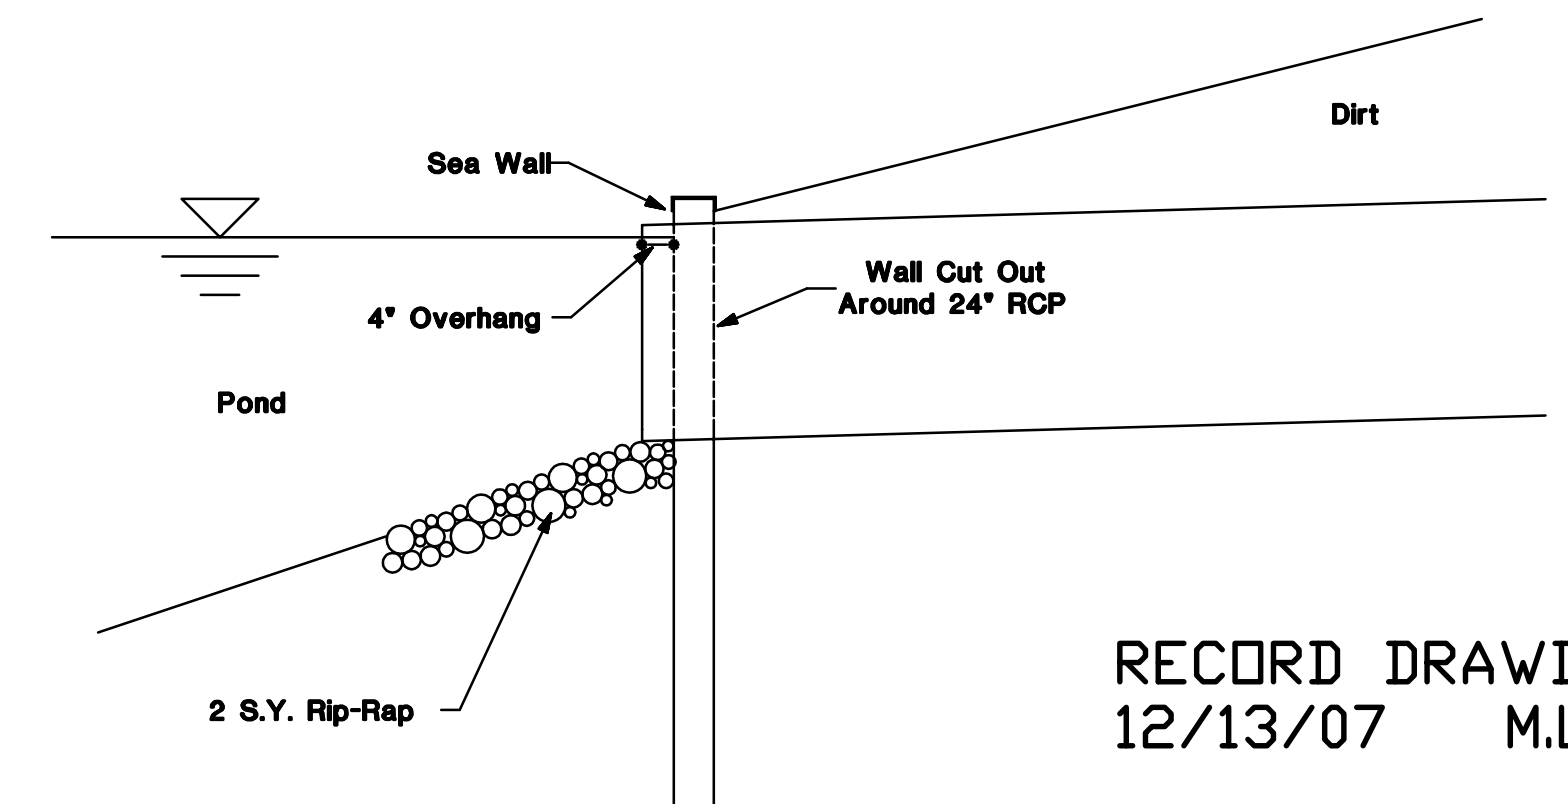


RECORD DRAWING  
12/13/07 M.L.T.

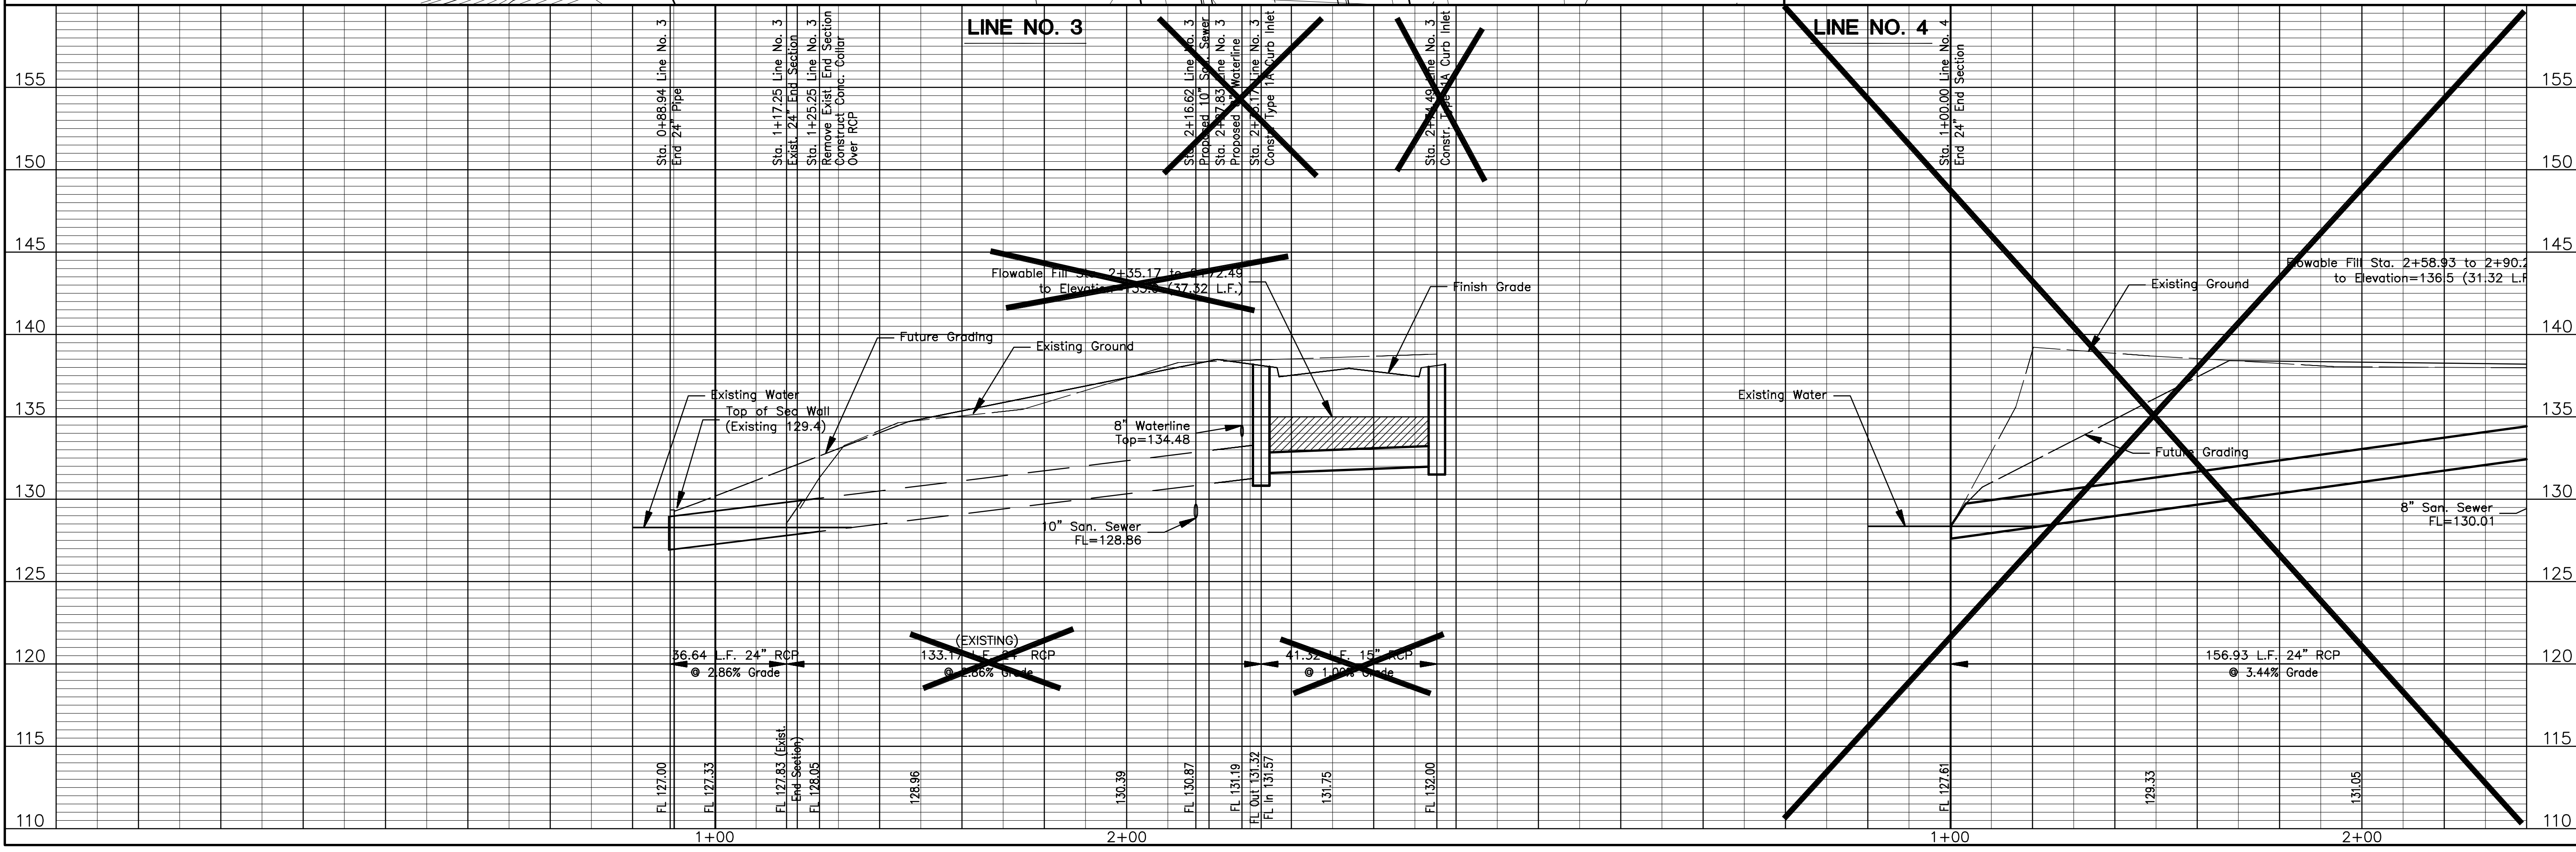

Revision	
Approved	
Date	
No.	

HARBOR ISLE 3RD ADDITION  
STORM WATER SEWER  
LINE NUMBER 3  
CITY OF WICHITA, KANSAS  
JAMES ARMOUR, P.E. - CITY ENGINEER  
C.O.W. Project # 1821 PPS O.C.A. # 607861

POE & ASSOCIATES, INC.  
CONSULTING ENGINEERS  
5940 E. Central, Suite 200 ■ Wichita, KS 67208-4242  
Phone 316/685-4114 ■ FAX 316/685-4444

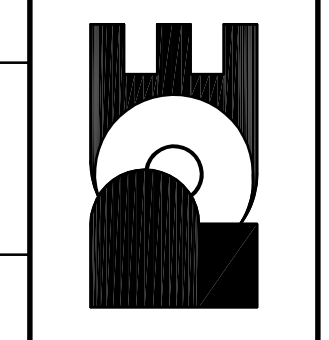

**FINAL**  
Designed By: J. Ubert / J. Dickman  
Drawn By: J. Dickman  
Poe Job No.: 1786  
Date: October 2007  
Sheet  
2 of 2