


SCALE: 1" = 40'

AS-BUILT PLANS
 CONTRACTOR *A. & F. EXCAVATING*
 TITTLE & ASSOCIATES, INC.
 INSPECTOR *BRYAN DEAR*
 .pdf by: *BD* 9-25-07

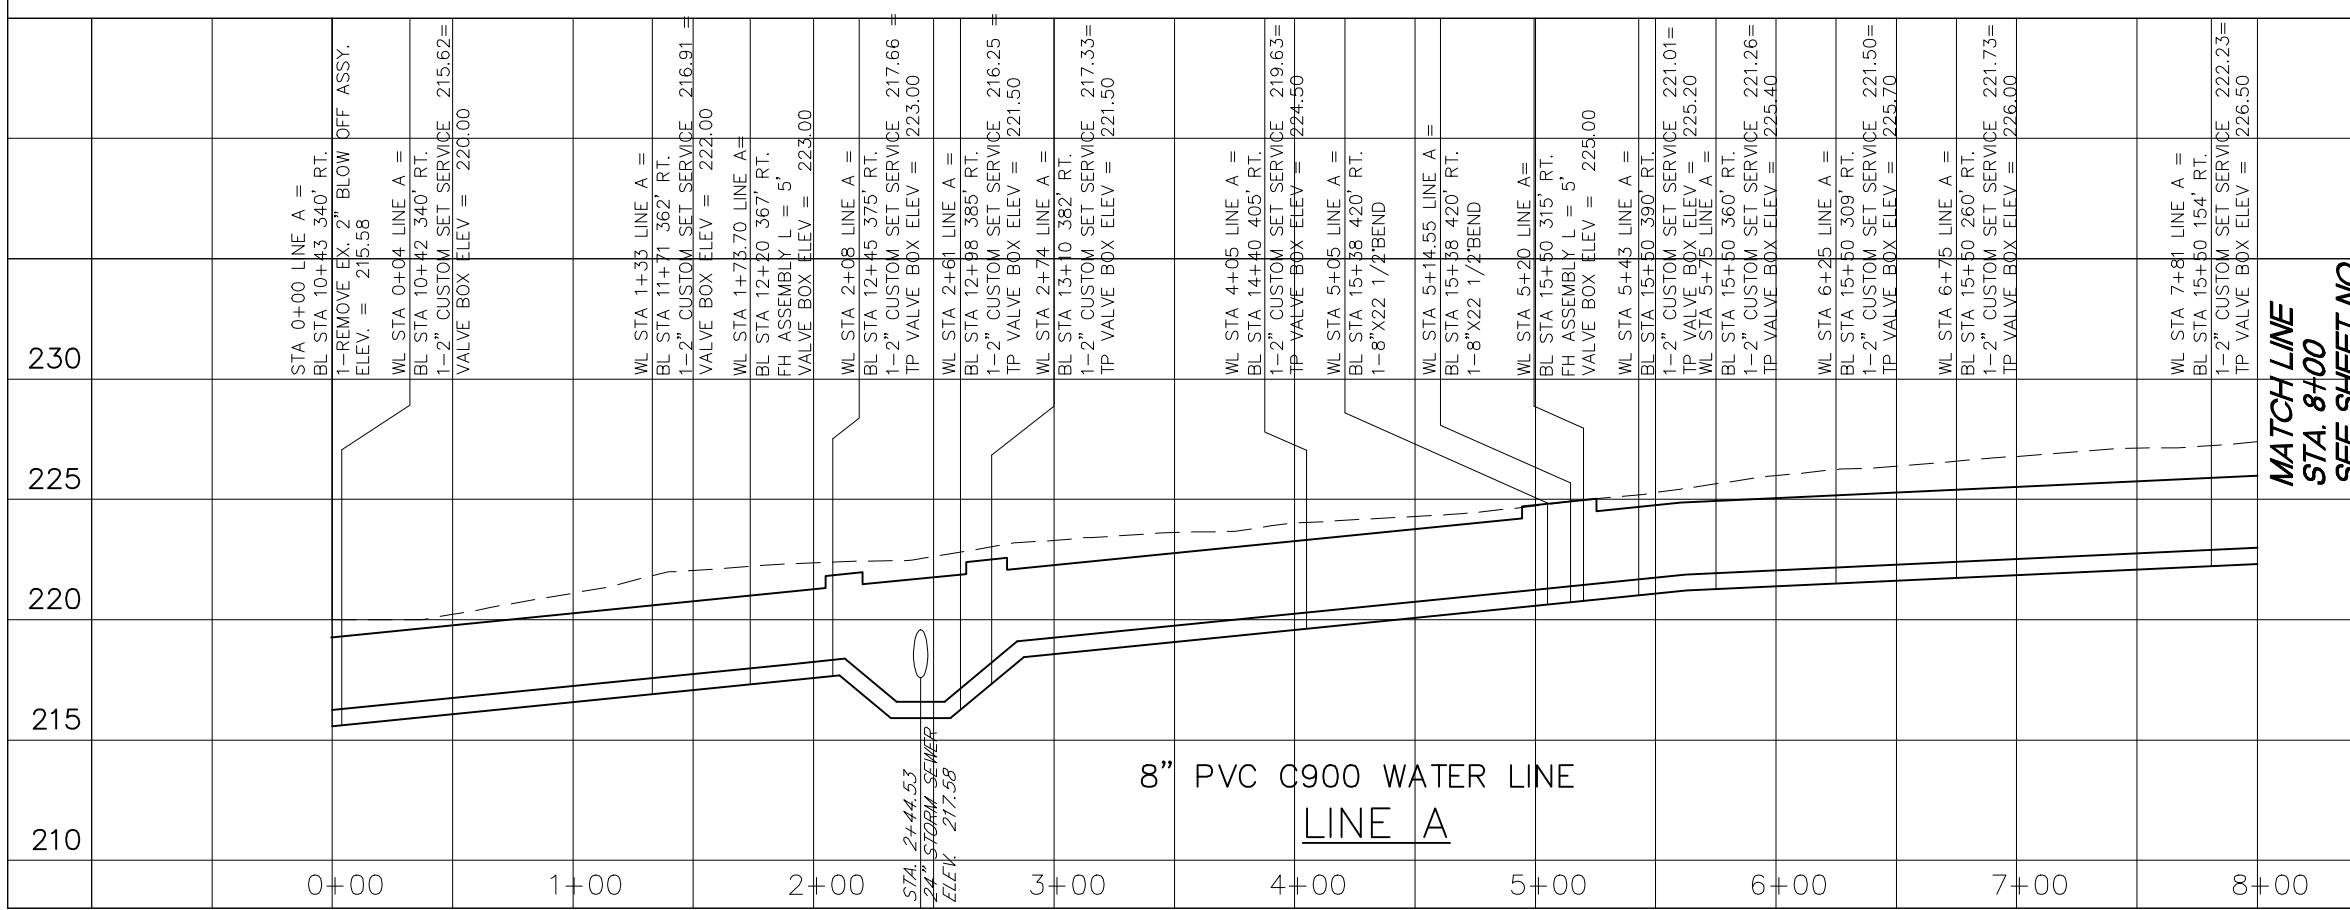


STATION	ELEVATION	DESCRIPTION
0+00	215.62	1-2" CUSTOM SET SERVICE VALVE BOX ELEV = 215.62
0+04	220.00	1-1" CUSTOM SET SERVICE BY WWU VALVE BOX ELEV = 220.00
1+33	222.00	1-1" CUSTOM SET SERVICE BY WWU VALVE BOX ELEV = 222.00
2+08	223.00	1-1" CUSTOM SET SERVICE BY WWU VALVE BOX ELEV = 223.00
2+61	221.50	1-1" CUSTOM SET SERVICE BY WWU VALVE BOX ELEV = 221.50
2+74	221.50	1-1" CUSTOM SET SERVICE BY WWU VALVE BOX ELEV = 221.50
4+05	224.50	1-1" CUSTOM SET SERVICE BY WWU VALVE BOX ELEV = 224.50
5+20	225.00	1-1" CUSTOM SET SERVICE BY WWU VALVE BOX ELEV = 225.00
5+43	225.20	1-1" CUSTOM SET SERVICE BY WWU VALVE BOX ELEV = 225.20
5+75	226.00	1-1" CUSTOM SET SERVICE BY WWU VALVE BOX ELEV = 226.00
6+25	225.70	1-1" CUSTOM SET SERVICE BY WWU VALVE BOX ELEV = 225.70
7+81	226.50	1-1" CUSTOM SET SERVICE BY WWU VALVE BOX ELEV = 226.50

MATCH LINE STA. 8+00 SEE SHEET NO.		235
		230
		225
		220
		215
		210

BY	REVISION	DATE

PLANS & ESTIMATES PREPARED BY: TITTLE & ASSOCIATES, INC.	9718 E. 55TH PL. TULSA, OK. 74146 918-663-5567
DESIGNED BY:	
DFILE: 4826WATP&P	
RECOMMENDED:	
DEVELOPMENT SERVICES	
RECOMMENDED:	
ENGINEERING SERVICES	
PUBLIC WORKS DIRECTOR	
FILE DRAWING	DATE
ATLAS PAGE NO	SHEET 4 OF 7 SHEETS

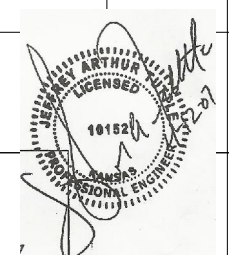

PROJECT NUMBER
1309 PPW607853

WATER PLAN AND PROFILE
 WATERFORD II APARTMENTS
 CITY OF WICHITA, KANSAS