


RECORD DRAWING
1/9/2008
MLT

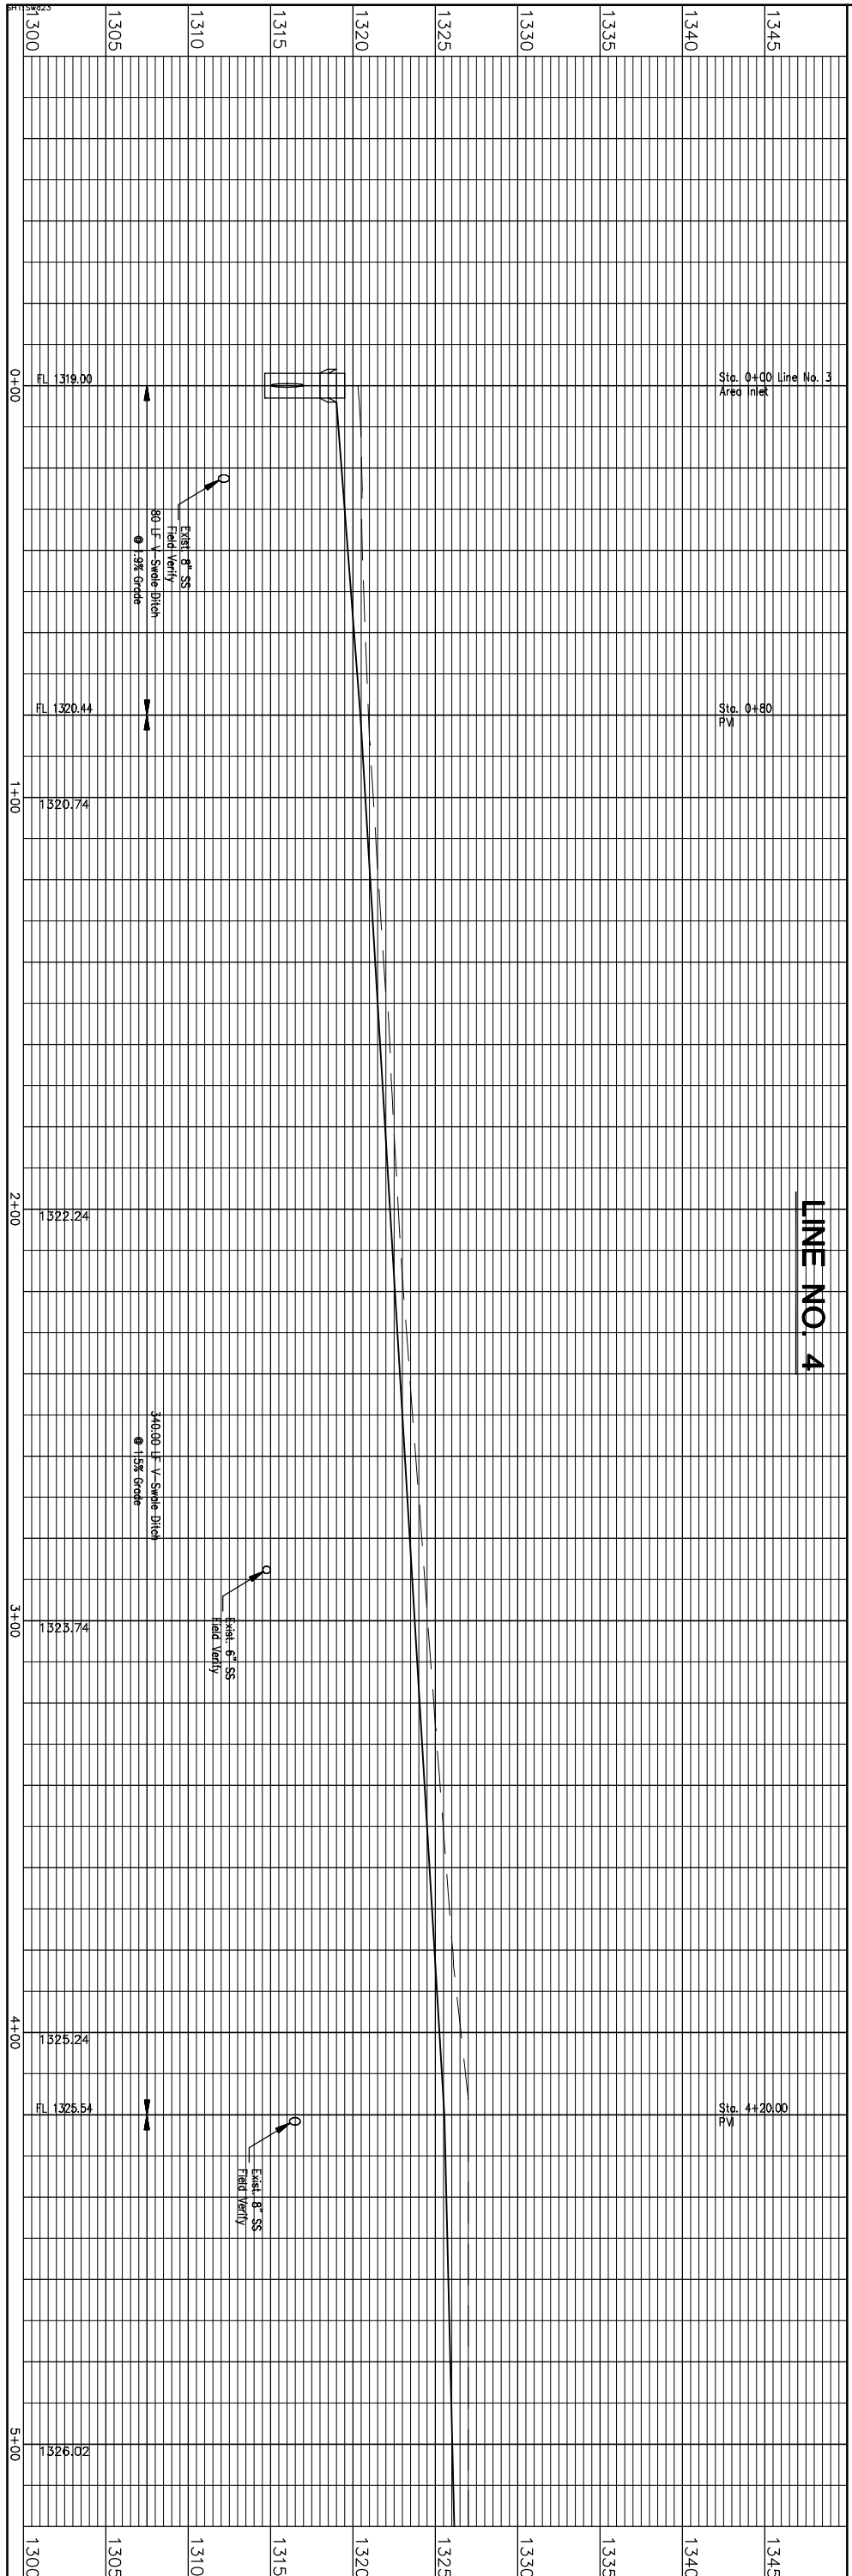

LINE NO. 4

No.	Date	By	Approved	Revision
1	1/9/08	MLT	JPD	Moved Curb Inlet South to New Location

FINAL

Designed By: J. Ubert / J. Dickman
 Drawn By: M. Tucker
 Poe Job No.: 1809
 Date: April 2007



POE & ASSOCIATES, INC.
 CONSULTING ENGINEERS
 5940 E. Central, Suite 200 ■ Wichita, KS 67208-4242
 Phone 316/685-4114 ■ FAX 316/685-4444

TERRADYNE WEST ADDITION
 STREET & STORM SEWER IMPROVEMENTS
 STORM SEWER LINE NO. 4
CITY OF WICHITA, KANSAS
 JAMES L. ARMOUR, P.E. - CITY ENGINEER
 Private Project # 179PPP OCA# 607879