

PRIVATE STORM WATER SEWER EXTENSION

TO SERVE

CESSNA LCC ANNEX

PRIVATE PROJECT NO. 1783 PPS (607861)


CITY OF WICHITA, KANSAS

JAMES L. ARMOUR, P.E. - CITY ENGINEER

AS BUILT PLANS
 CONTRACTOR - FAGGAN CONSTRUCTION
 INSPECTOR - TERRY HENRY (CED)
 PDF by - JT(CED), 2-20-08

INDEX OF SHEETS

SHEET NO. C2.1	TITLE SHEET
SHEET NO. C2.2	KEY MAP AND GENERAL NOTES
SHEET NO. C2.3	PLAN/PROFILE
SHEET NO. C2.4	AREA INLET DETAILS
SHEET NO. C2.5	R.C. MANHOLE DETAILS
SHEET NO. C2.6	STANDARD/SPECIAL SHALLOW MANHOLES TYPE 'A' & 'B'
SHEET NO. C2.7	MANHOLE FRAME AND COVER DETAILS
SHEET NO. C3.1-C3.3	SOIL EROSION BMP DETAILS

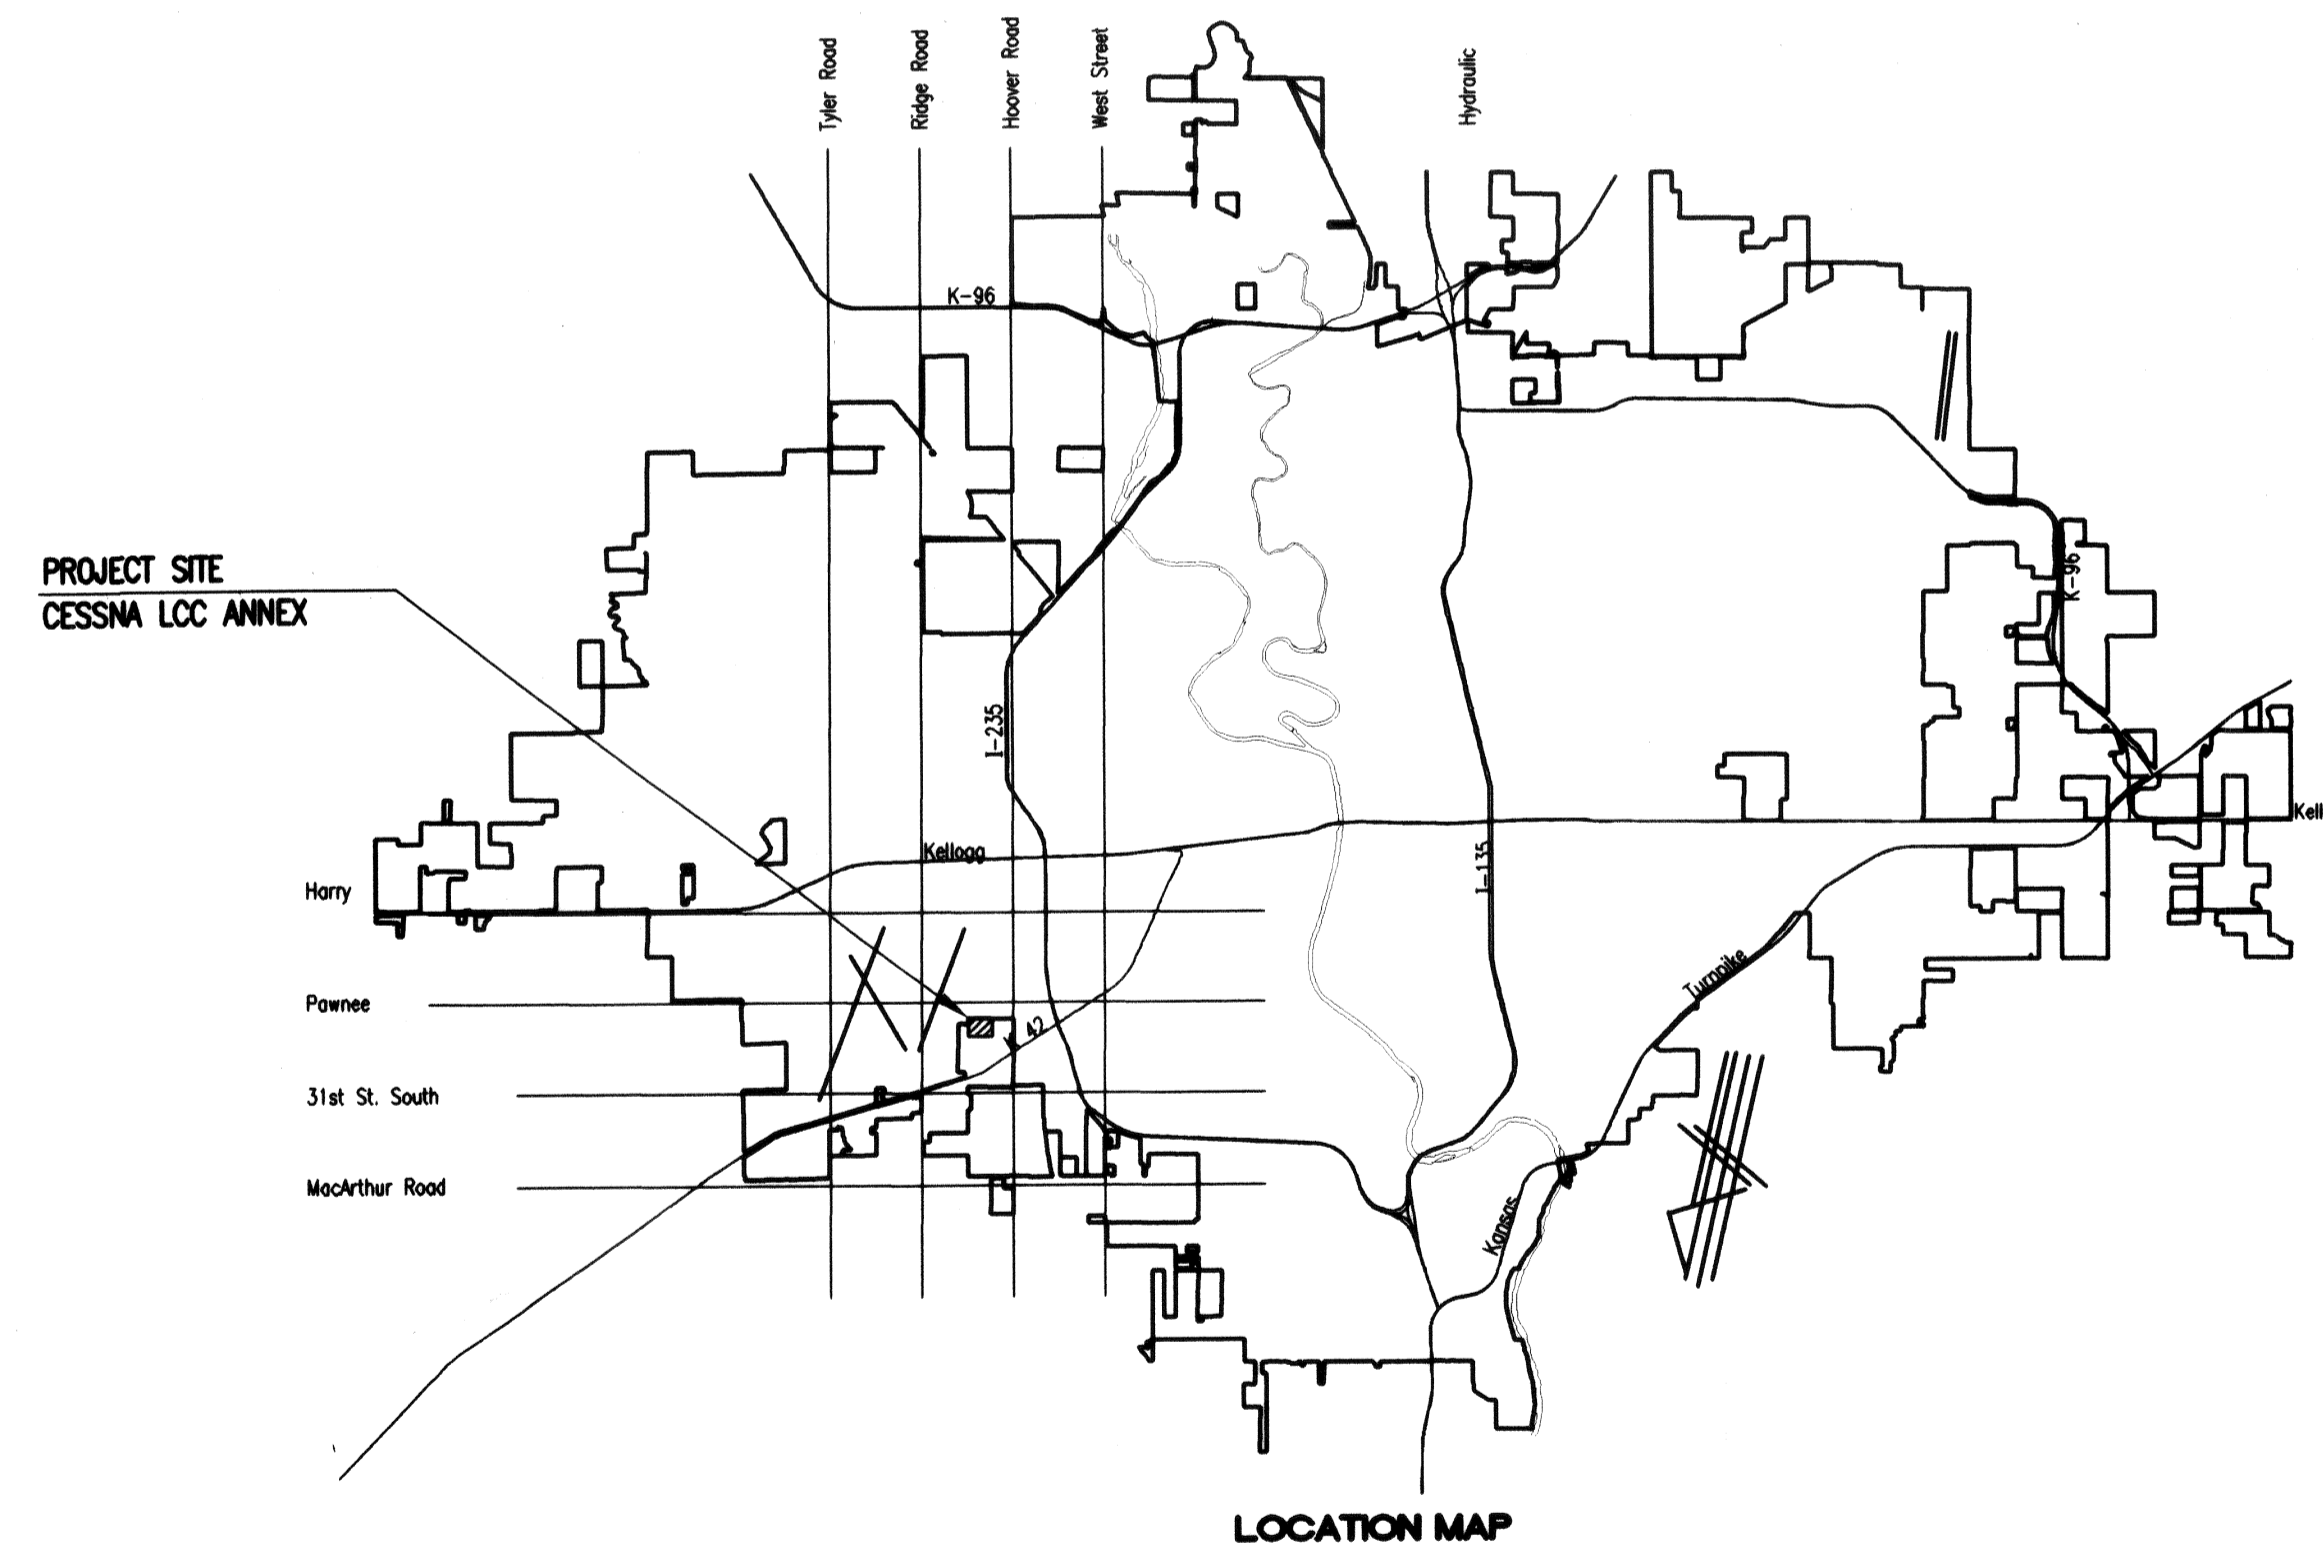

APPROVED AS NOTED
 By CITY ENGINEER OF WICHITA

Sanitary Sewers _____
 Storm Sewers VRH 6/8/07
 Driveway Approaches _____
 Paving _____

NOTE TO CONTRACTOR

INSPECTION AND TESTING FOR THIS PROJECT IS TO BE PROVIDED BY A LICENSED CONSULTING ENGINEERING FIRM CONTRACTED BY THE CONTRACTOR. SAID INSPECTION TO BE IN ACCORDANCE WITH THE CITY OF WICHITA STANDARD CONSTRUCTION ENGINEERING PRACTICES AND CERTIFIED BY A LICENSED PROFESSIONAL ENGINEER. NO WORK SHALL BE PERFORMED IN DEDICATED EASEMENTS OR PUBLIC RIGHT-OF-WAY BY THE CONTRACTOR UNTIL SUCH INSPECTION IS ARRANGED FOR AND REQUIRED BONDS HAVE BEEN SUBMITTED TO AND APPROVED BY THE CITY. NOR SHALL ANY WORK BE COMMENCED IN DEDICATED EASEMENTS OR PUBLIC RIGHT-OF-WAY WITHOUT WRITTEN AUTHORIZATION BY THE CITY ENGINEER. IMPROVEMENTS PERFORMED UNDER THIS PROJECT SHALL NOT BE ACCEPTED BY THE CITY UNTIL ALL APPLICABLE DOCUMENTATION HAS BEEN SUBMITTED TO THE CITY ENGINEER. THIS MAY INCLUDE: RECORD DRAWINGS, INSPECTION LOGS, TEST DOCUMENTATION, TV TAPES, AND A CERTIFICATE OF COMPLETION. THE ABOVE SHALL BE PERFORMED BY THE CONSULTING FIRM CONTRACTED TO INSPECT THIS PROJECT.

JUNE 2007
 PLANS PREPARED BY
PROFESSIONAL ENGINEERING CONSULTANTS, P.A.
 ENGINEERS
 WICHITA, KANSAS



Sheet 06-07-0007 0.34.30 PM by: GSW
 Date: 06-07-2007 05:56:52 PM by: GSW
 C:\2007\17283\OFFICE CHECK PLANS\17283-C2.1-SWStile Sheet