


Scale Plan 1"=40'
Profile 1"=10' Horiz.
1"=5' Vert.

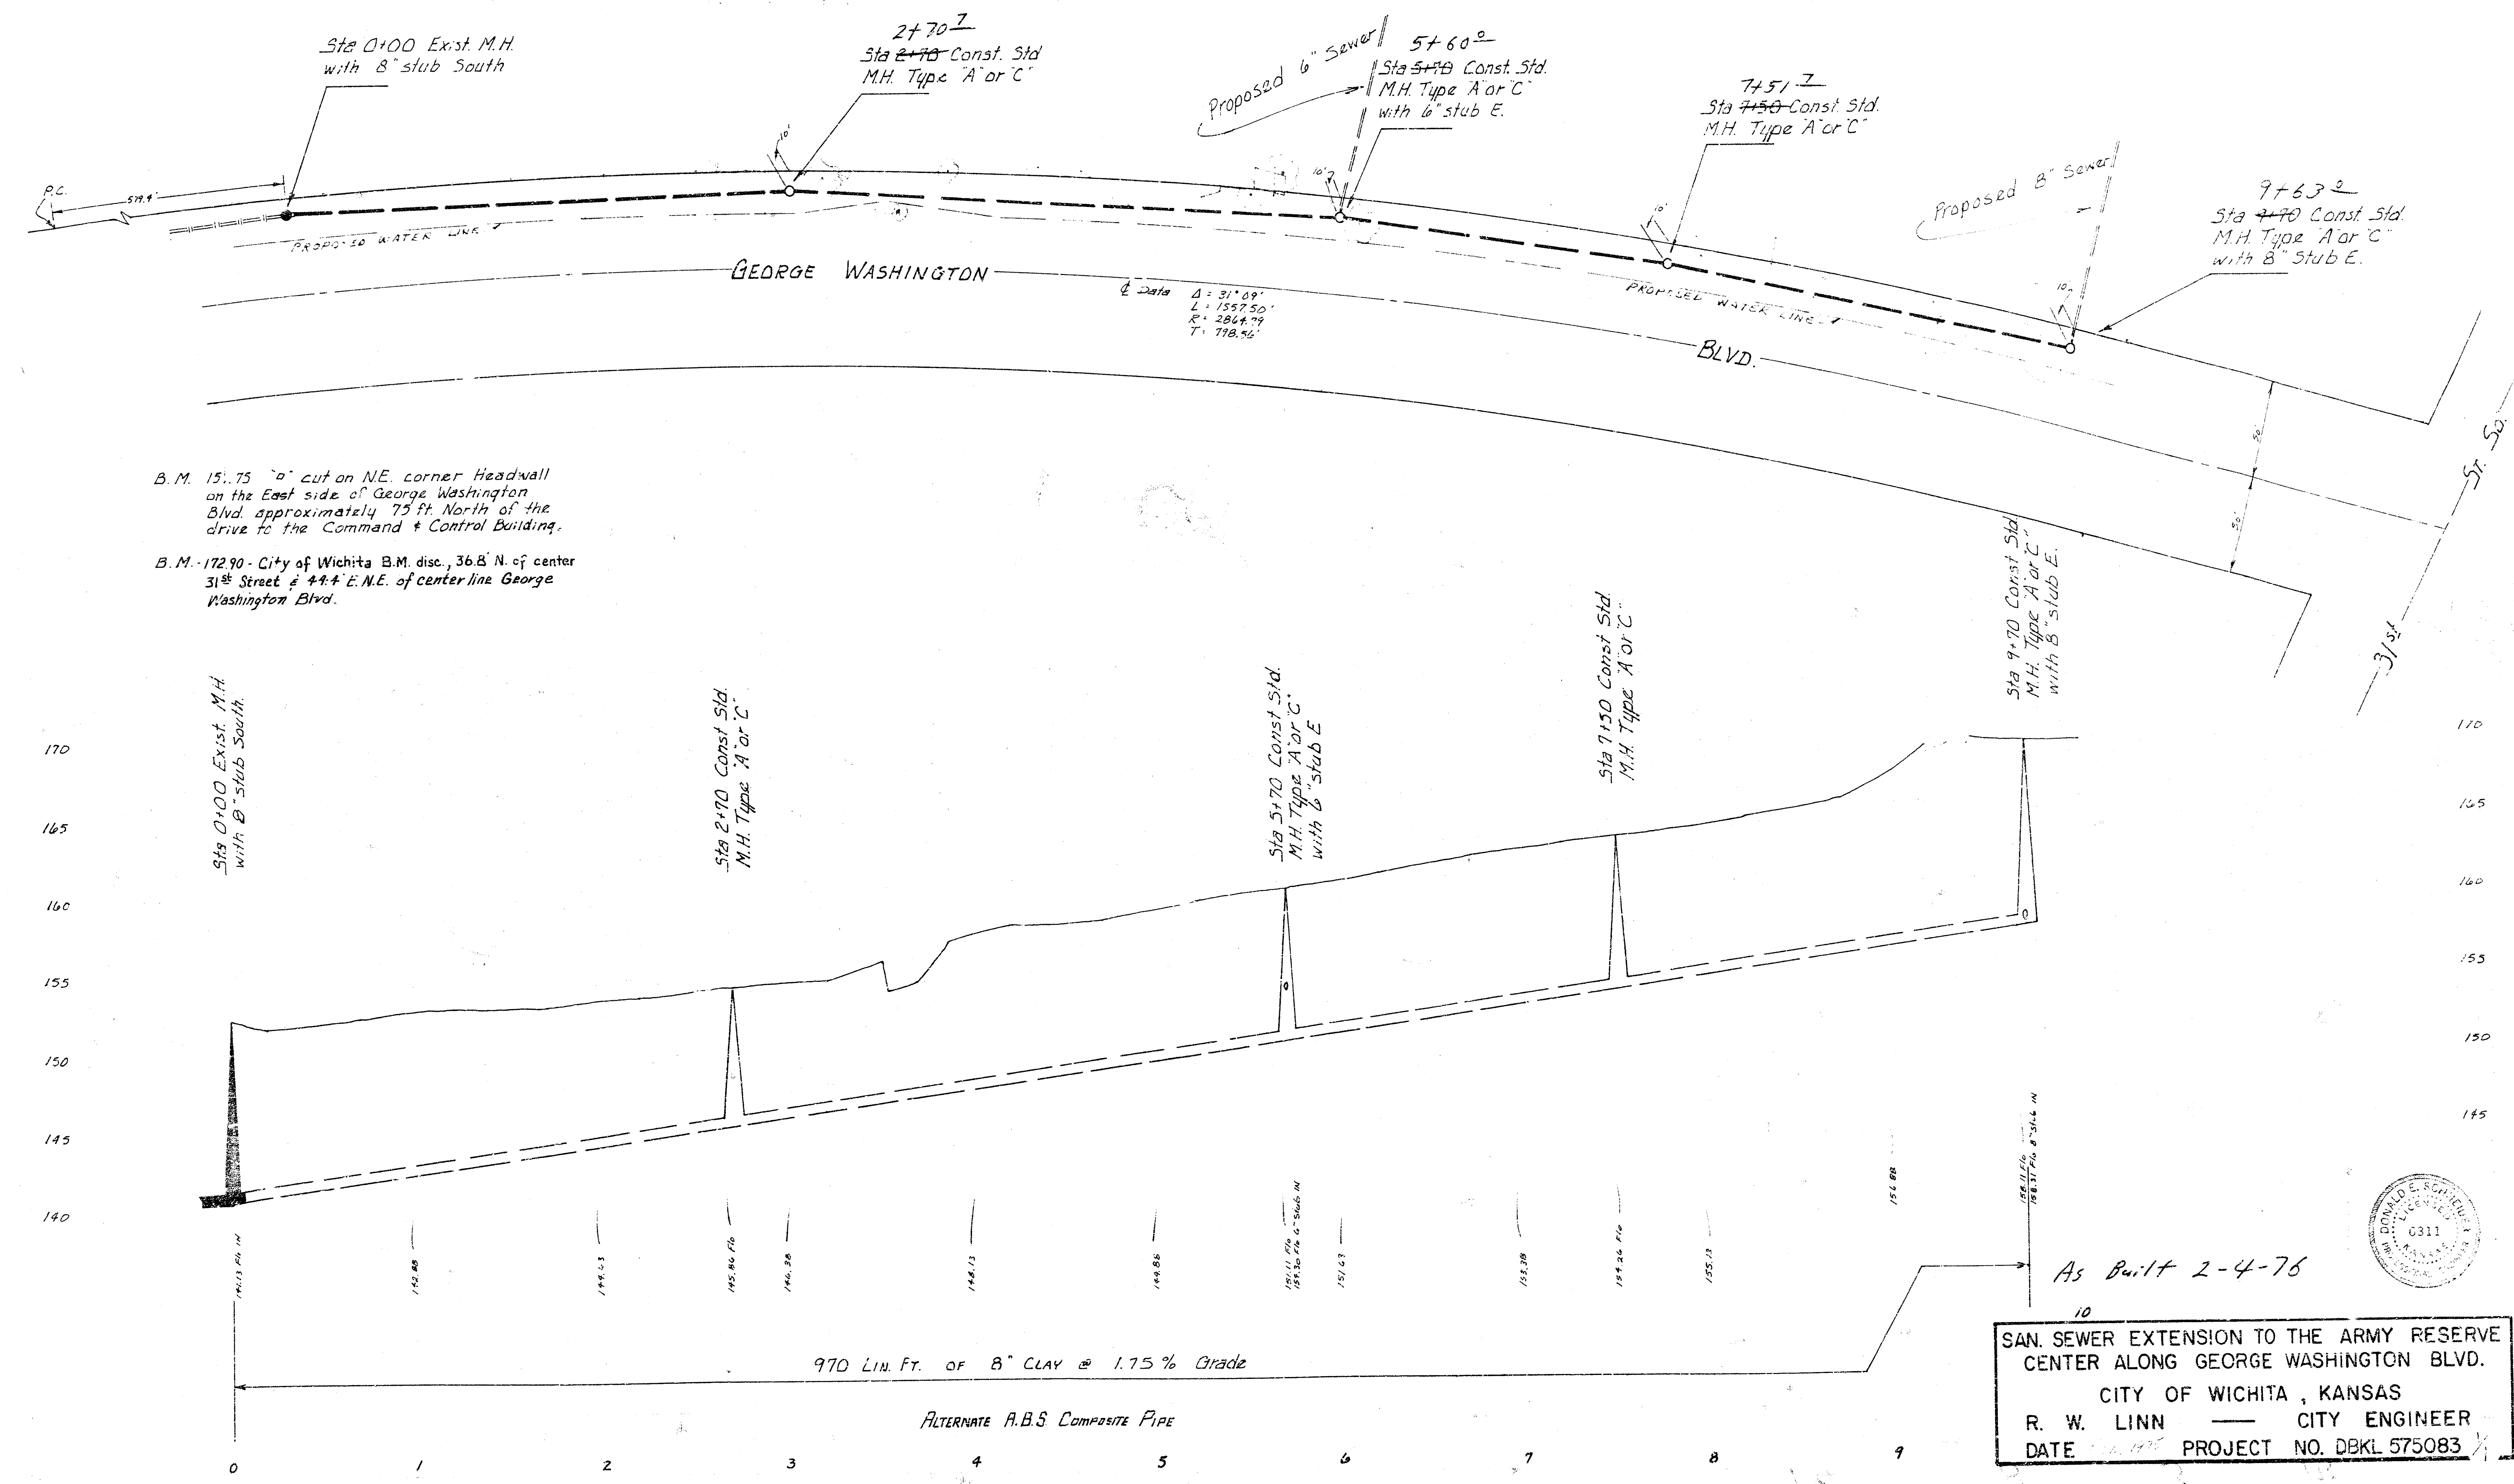

B.M. 151.75 "a" cut on N.E. corner Headwall on the East side of George Washington Blvd. approximately 75 ft North of the drive to the Command & Control Building.
B.M. 172.90 - City of Wichita B.M. disc., 36.8' N. of center 31st Street & 44.4' E.N.E. of center line George Washington Blvd.

As Built 2-4-76
10
SAN SEWER EXTENSION TO THE ARMY RESERVE CENTER ALONG GEORGE WASHINGTON BLVD.
CITY OF WICHITA, KANSAS
R. W. LINN — CITY ENGINEER
DATE 1-14-76 PROJECT NO. DBKL 575083

