
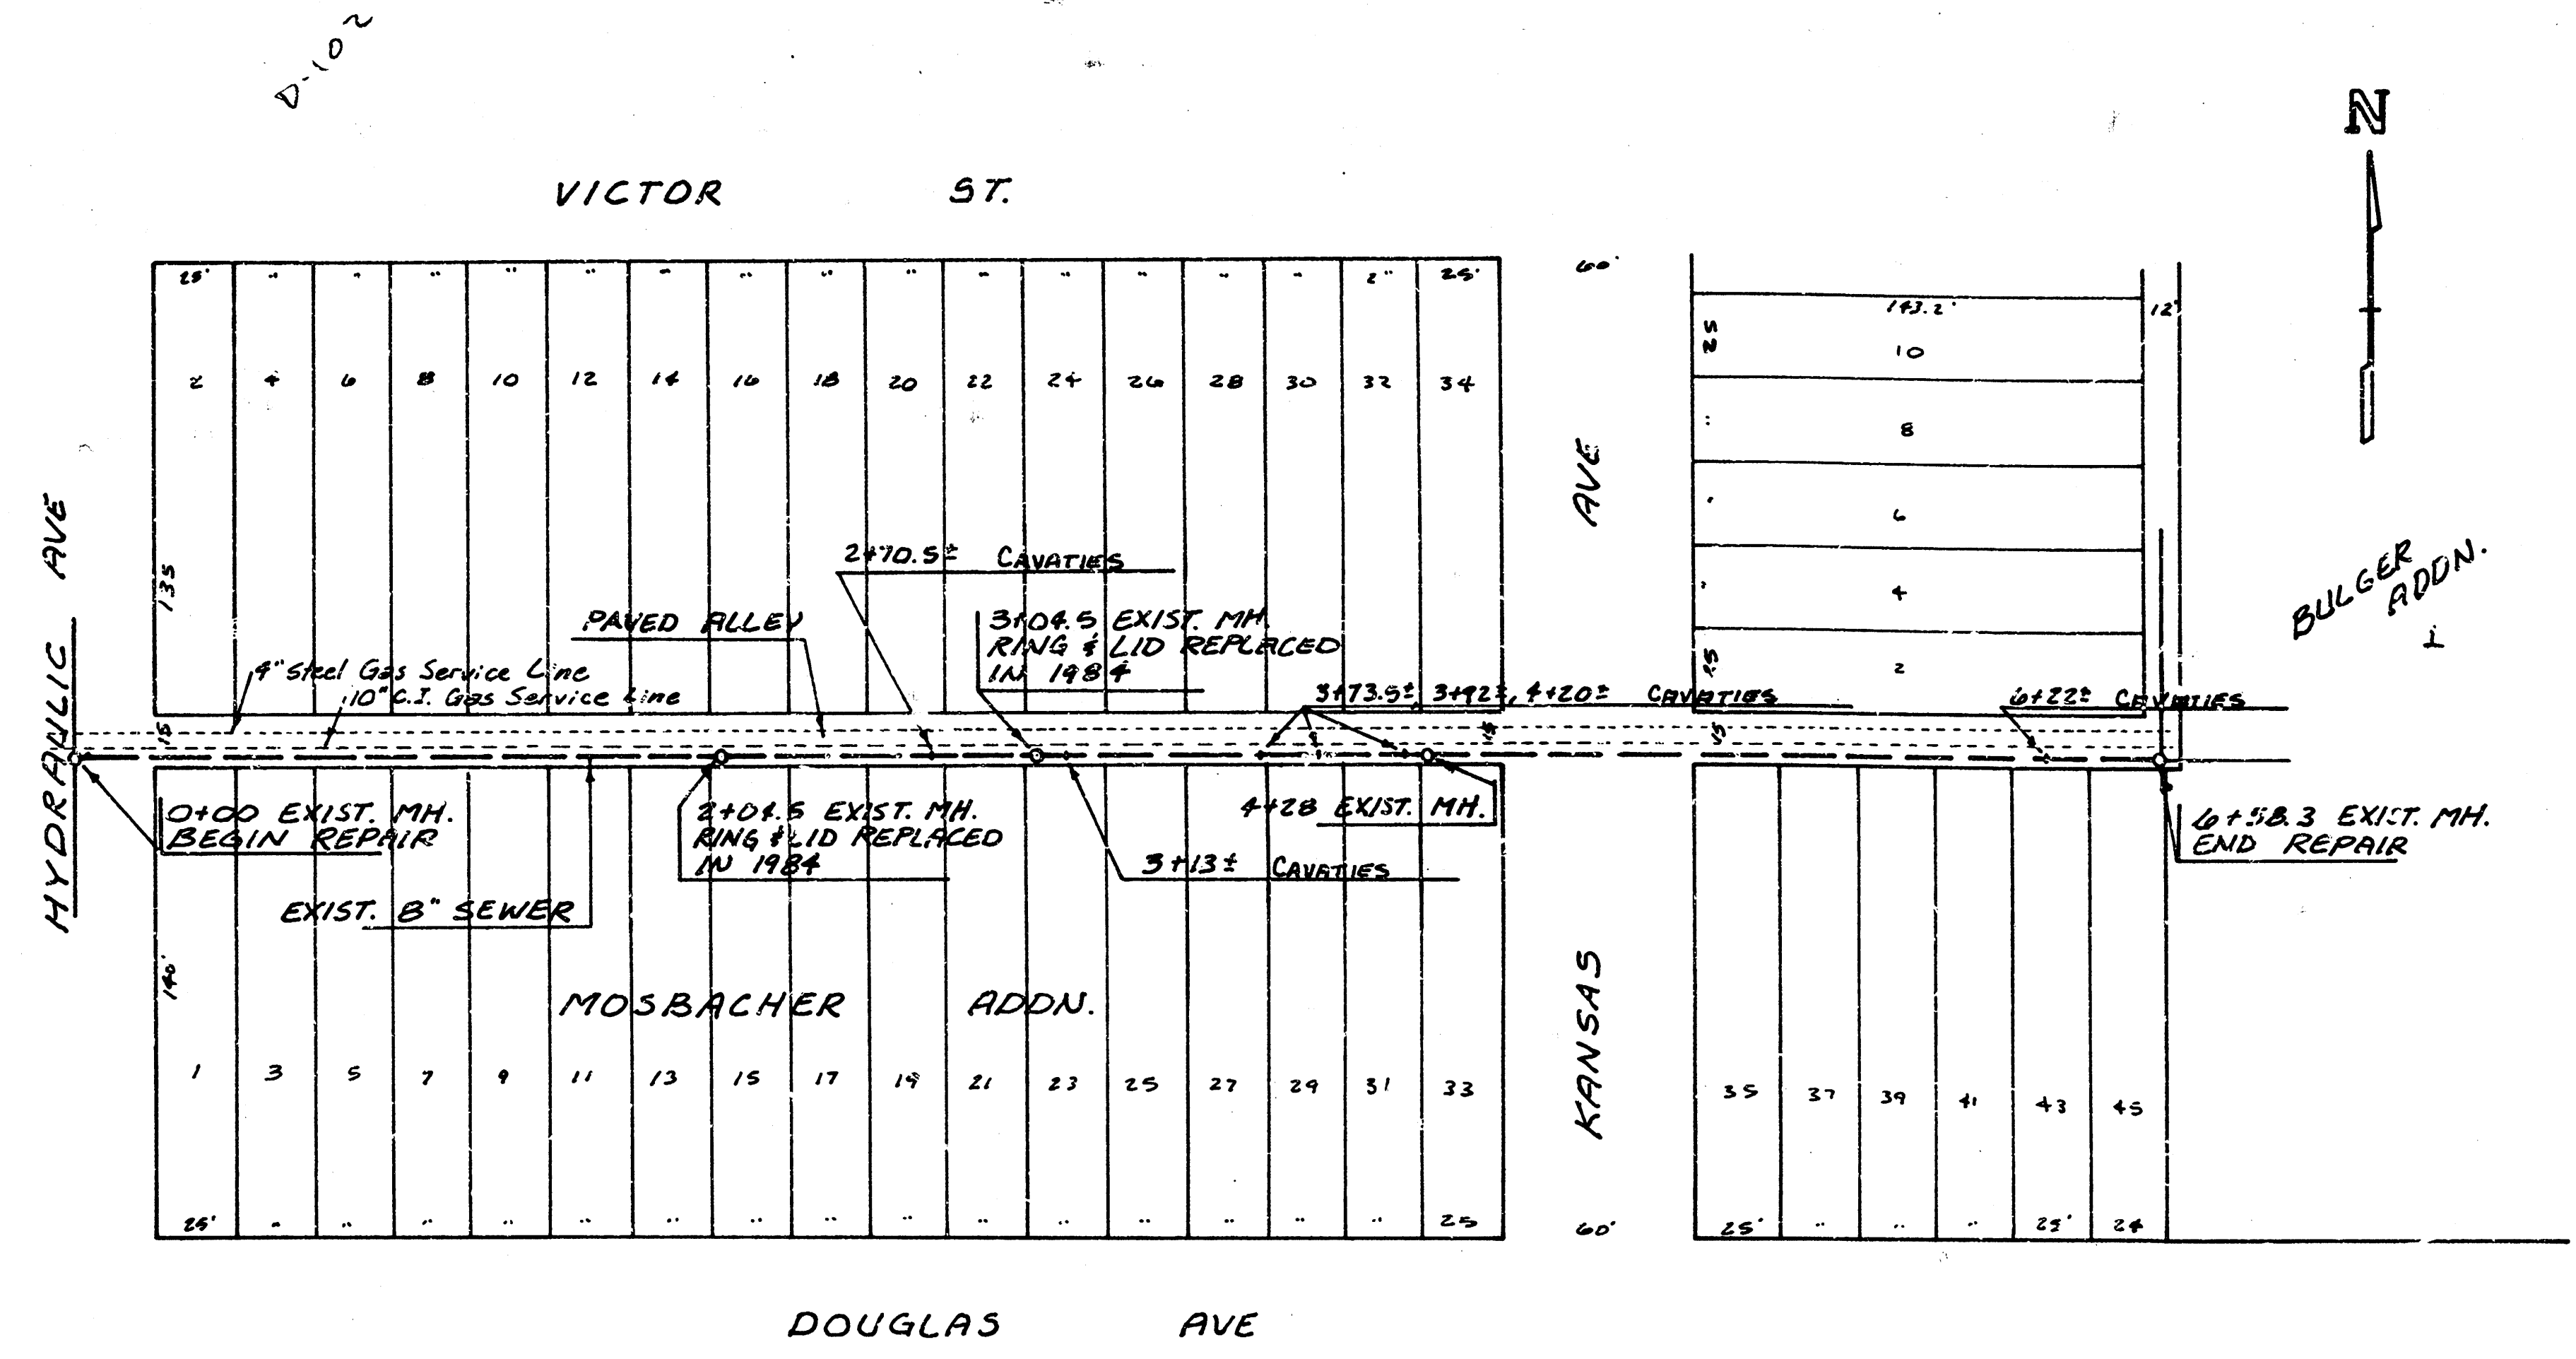
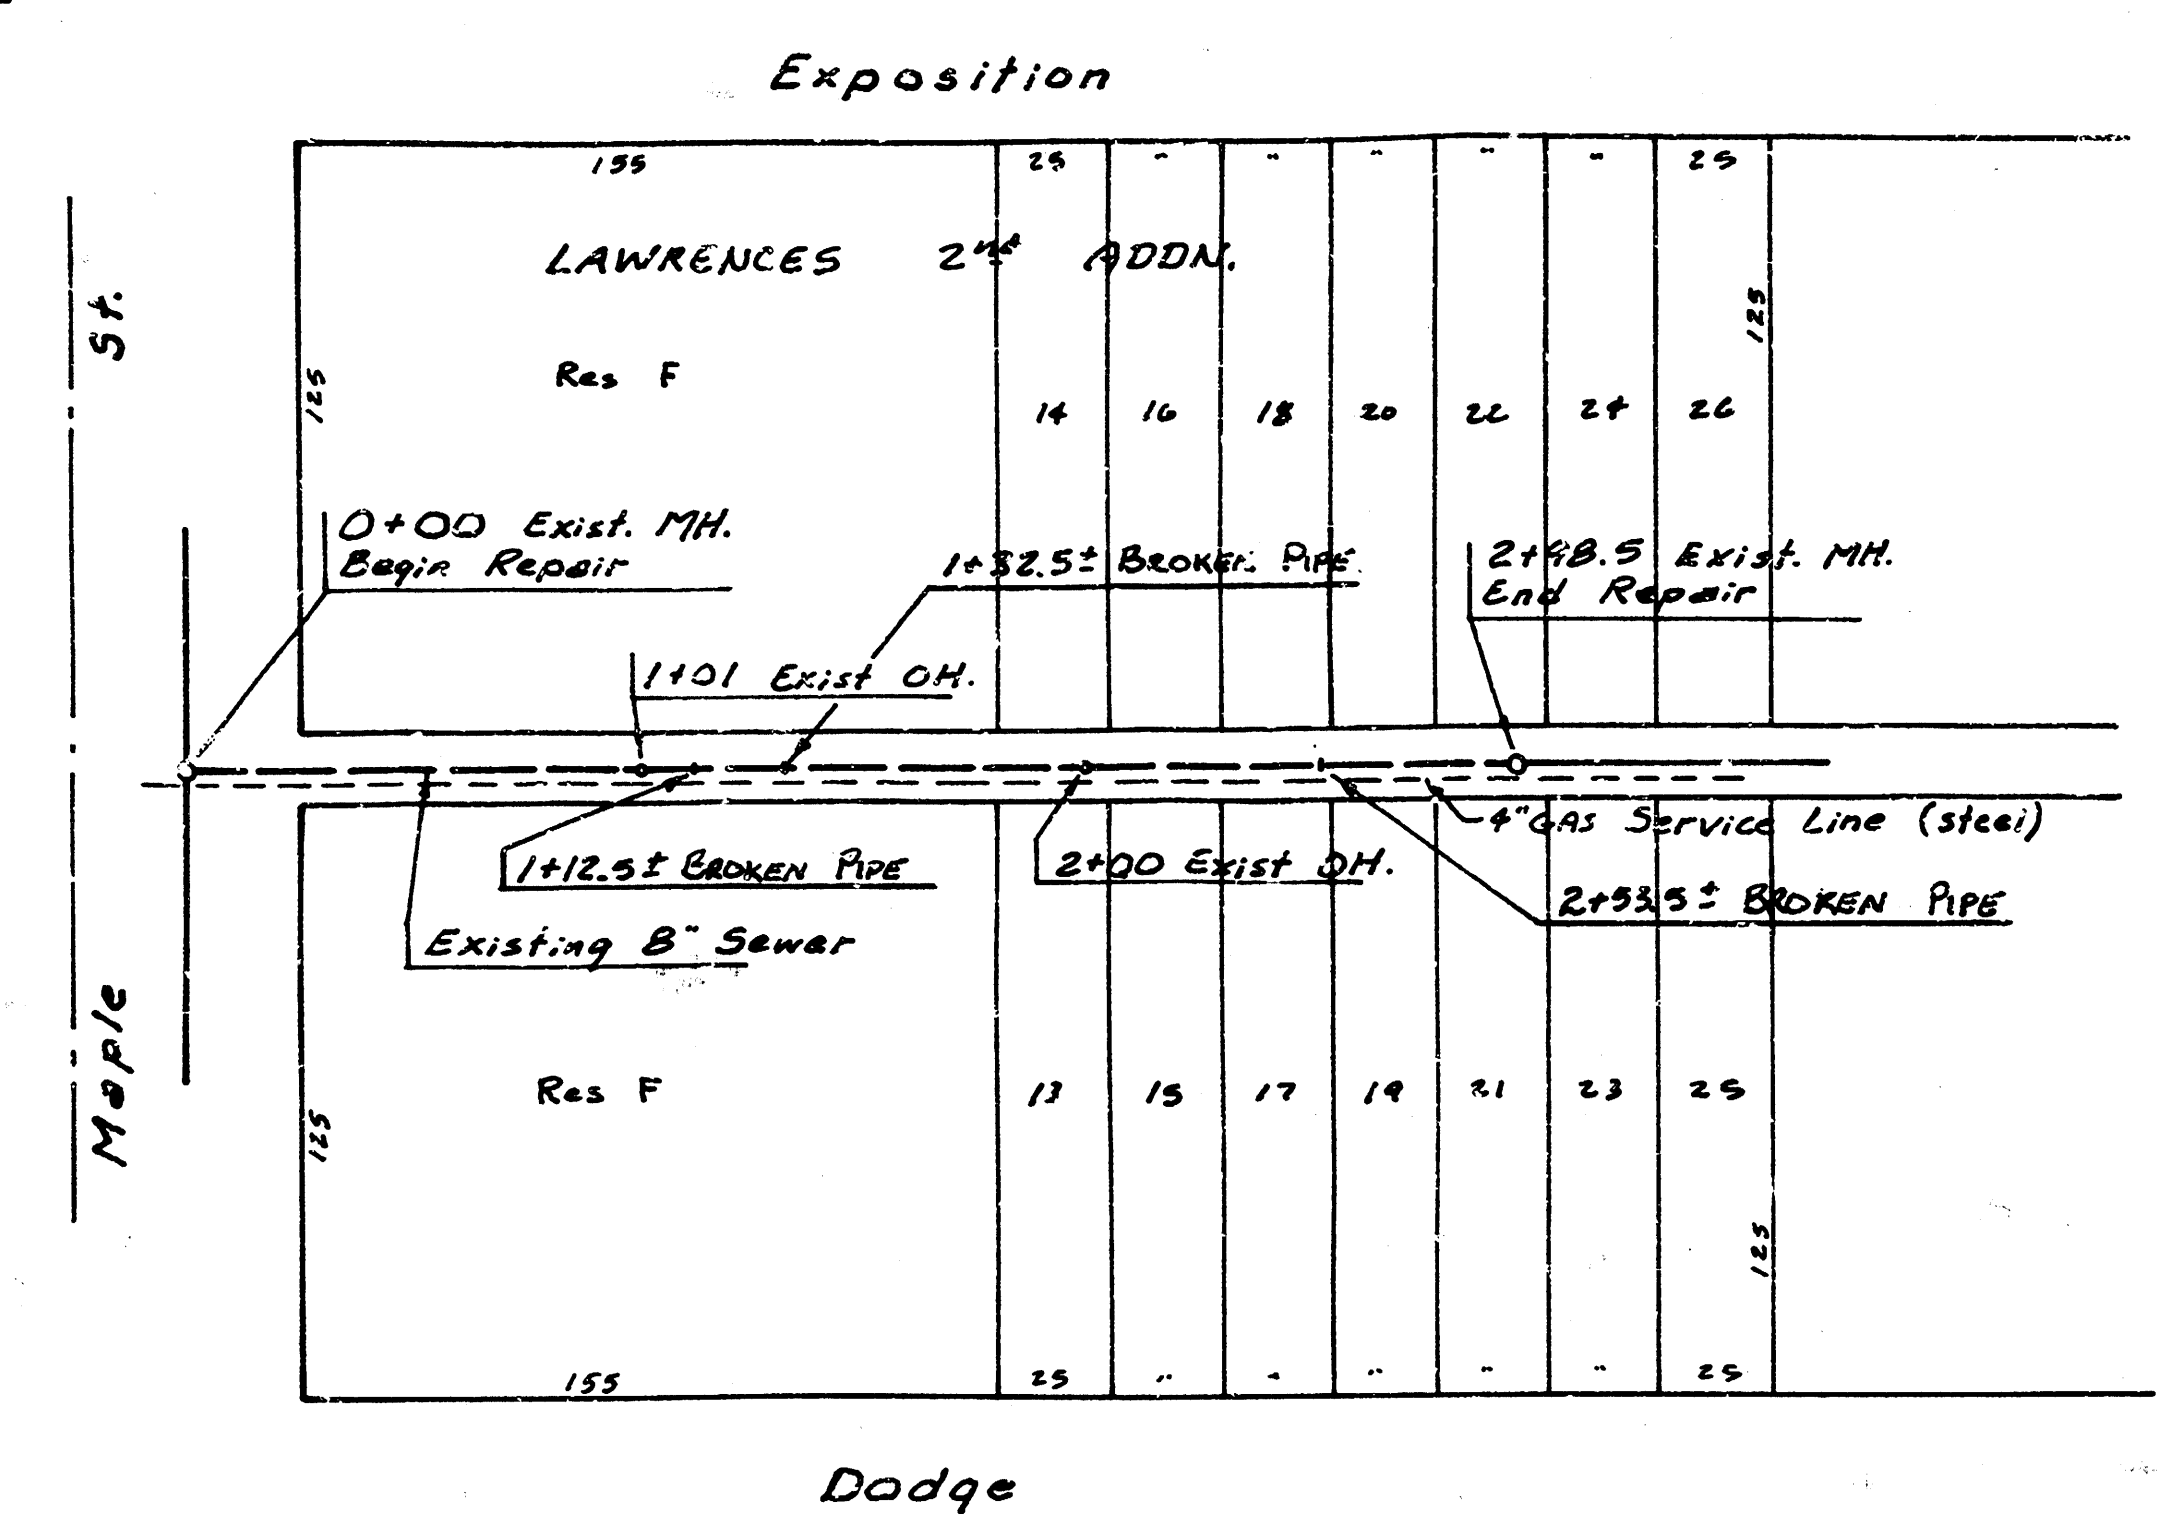



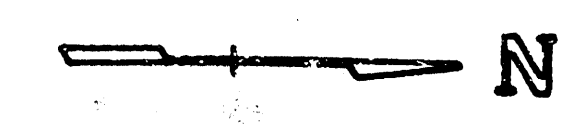


SCALE PLAN 1"=50'
PROFILE 1"=50' HORIZ.
1"=5' VERT.

NOTE: CONTRACTOR TO MAINTAIN MINIMUM
OF TWO-WAY ONE LANE TRAFFIC ON
MAPLE AND HYDRAULIC.

NOTE: ARKLA GAS LINE - 2" IN E PARKING HYDRAULIC -
1 1/2" PLASTIC GOING E. IN ALLEY - CHANGES TO
4" STEEL AND TERMINATES AT W.L. KANSAS.

110
105
100

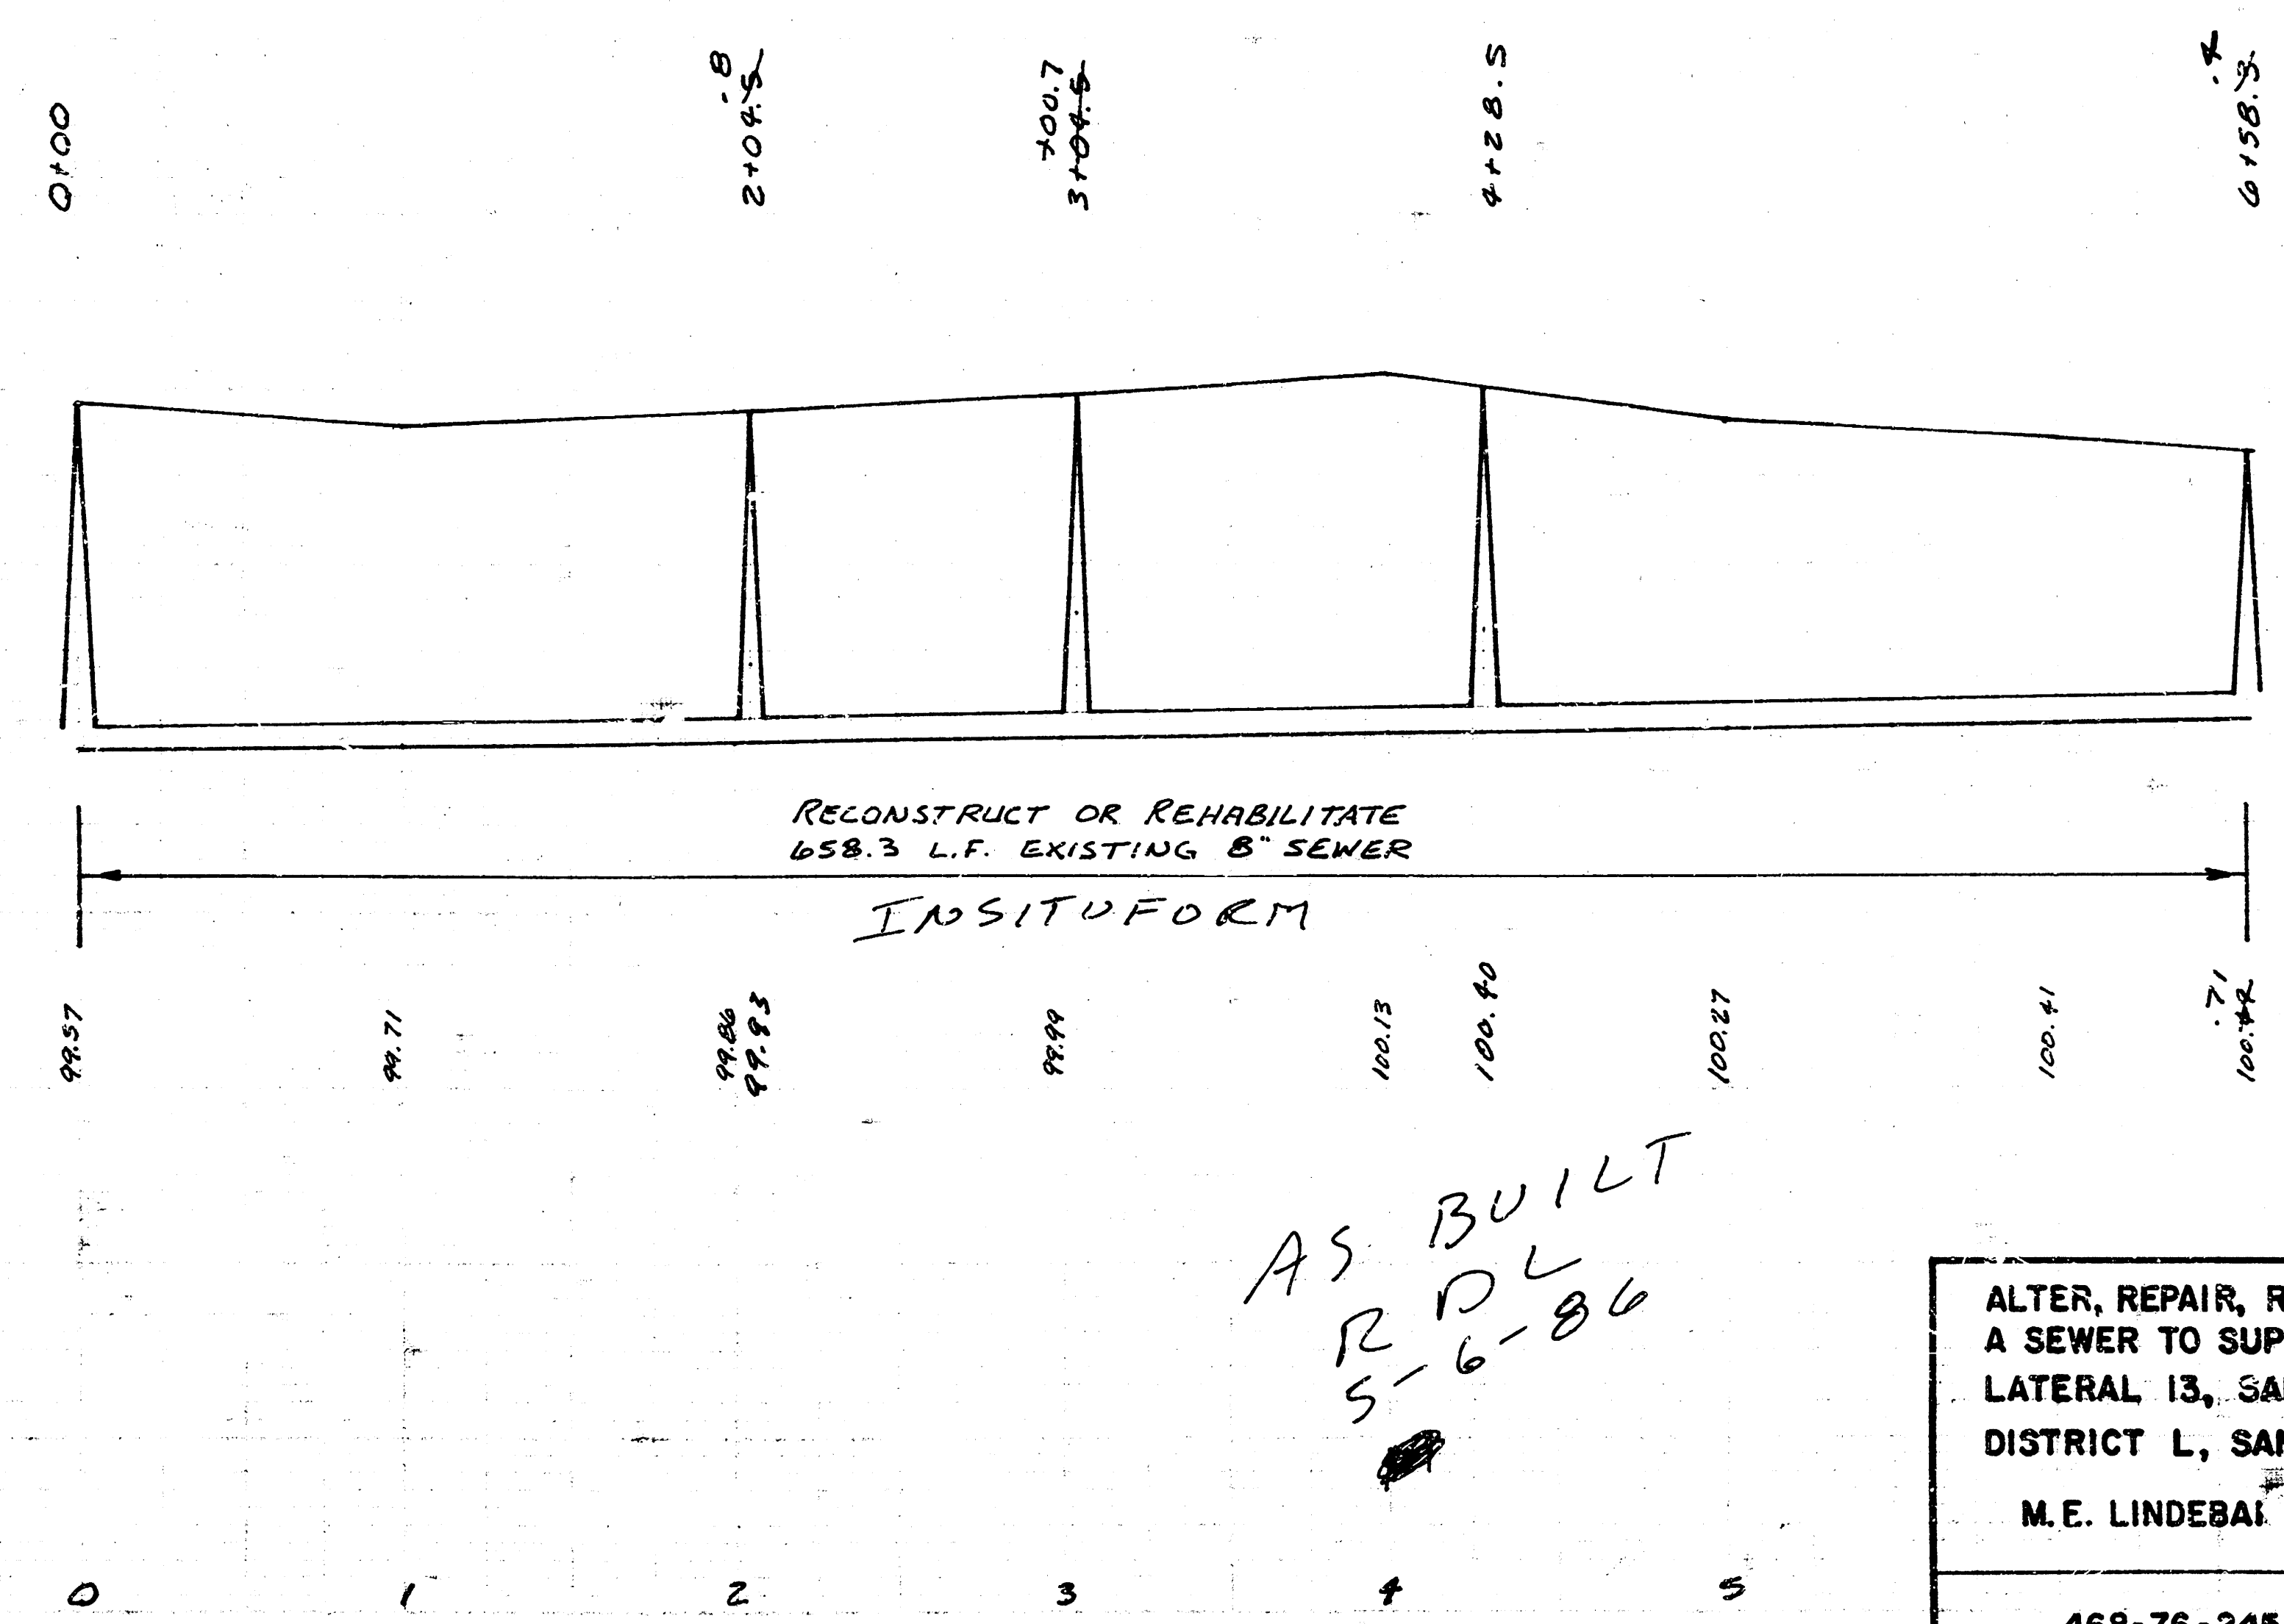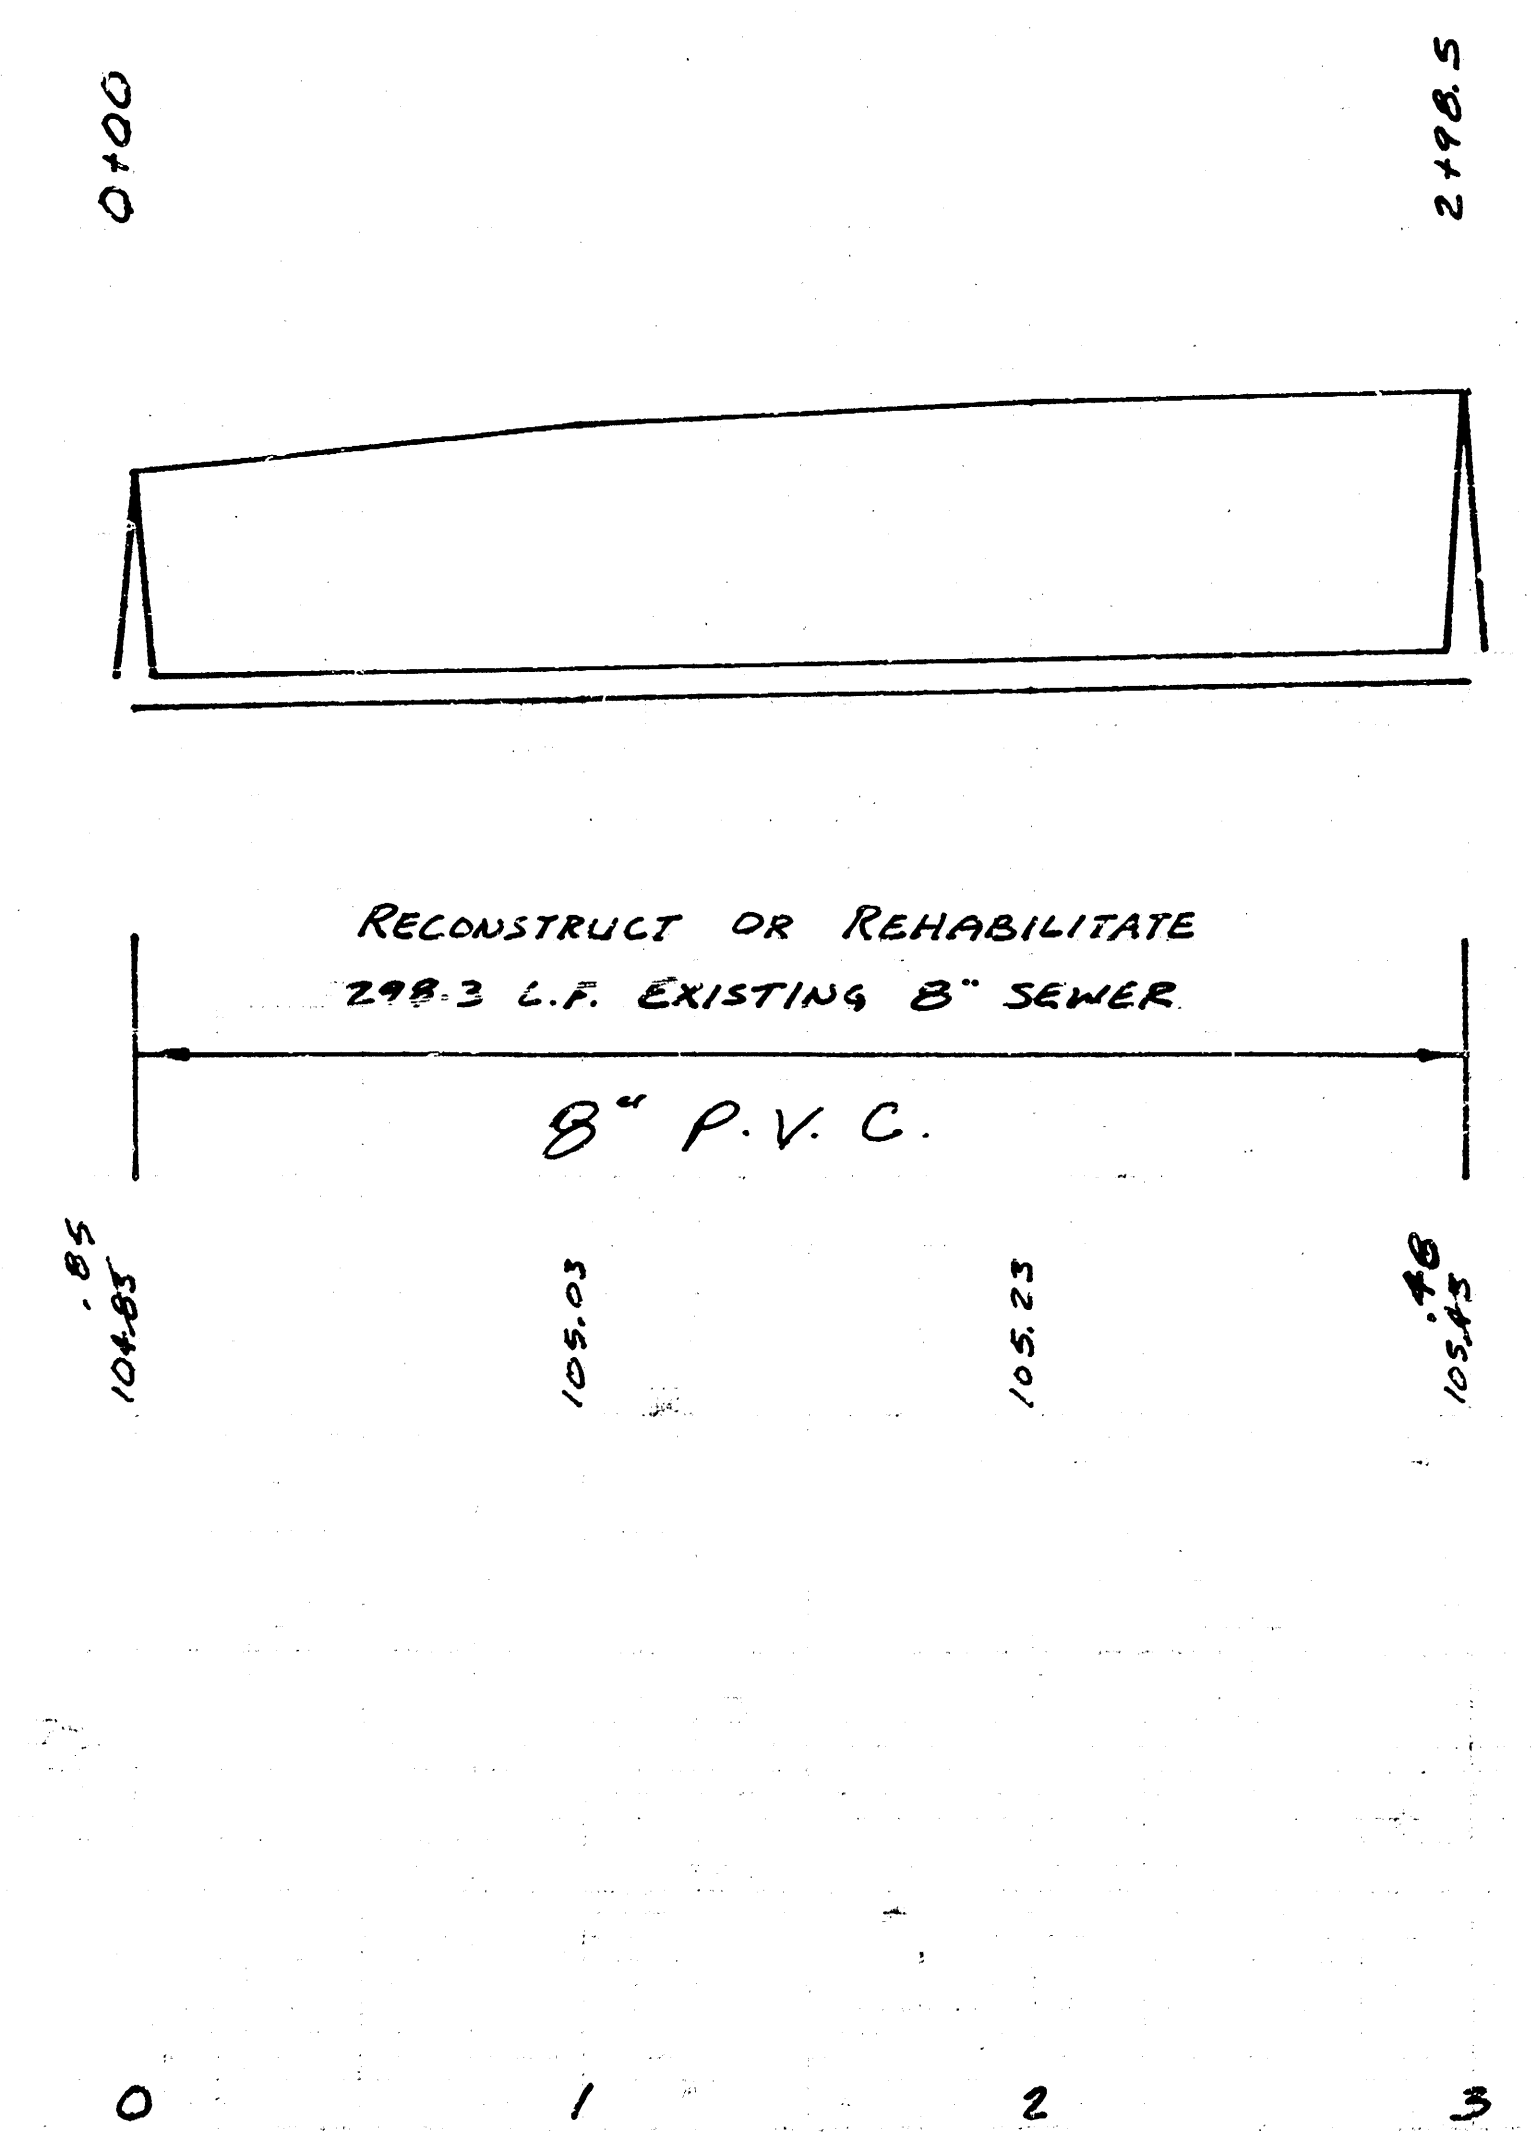


AS BUILT
R.D.L.
5-6-86

ALTER, REPAIR, RECONSTRUCT OR CONSTRUCT
A SEWER TO SUPPLEMENT A PORTION OF
LATERAL 13, SANITARY SEWER NO. 8
DISTRICT L, SANITARY SEWER NO. 20
M.E. LINDEBAI — CITY ENGINEER
PROJECT NUMBER
468-76-245-81541-000-0001



10 2 3 8 1/3

FILMED FROM THE BEST
AVAILABLE COPY.....

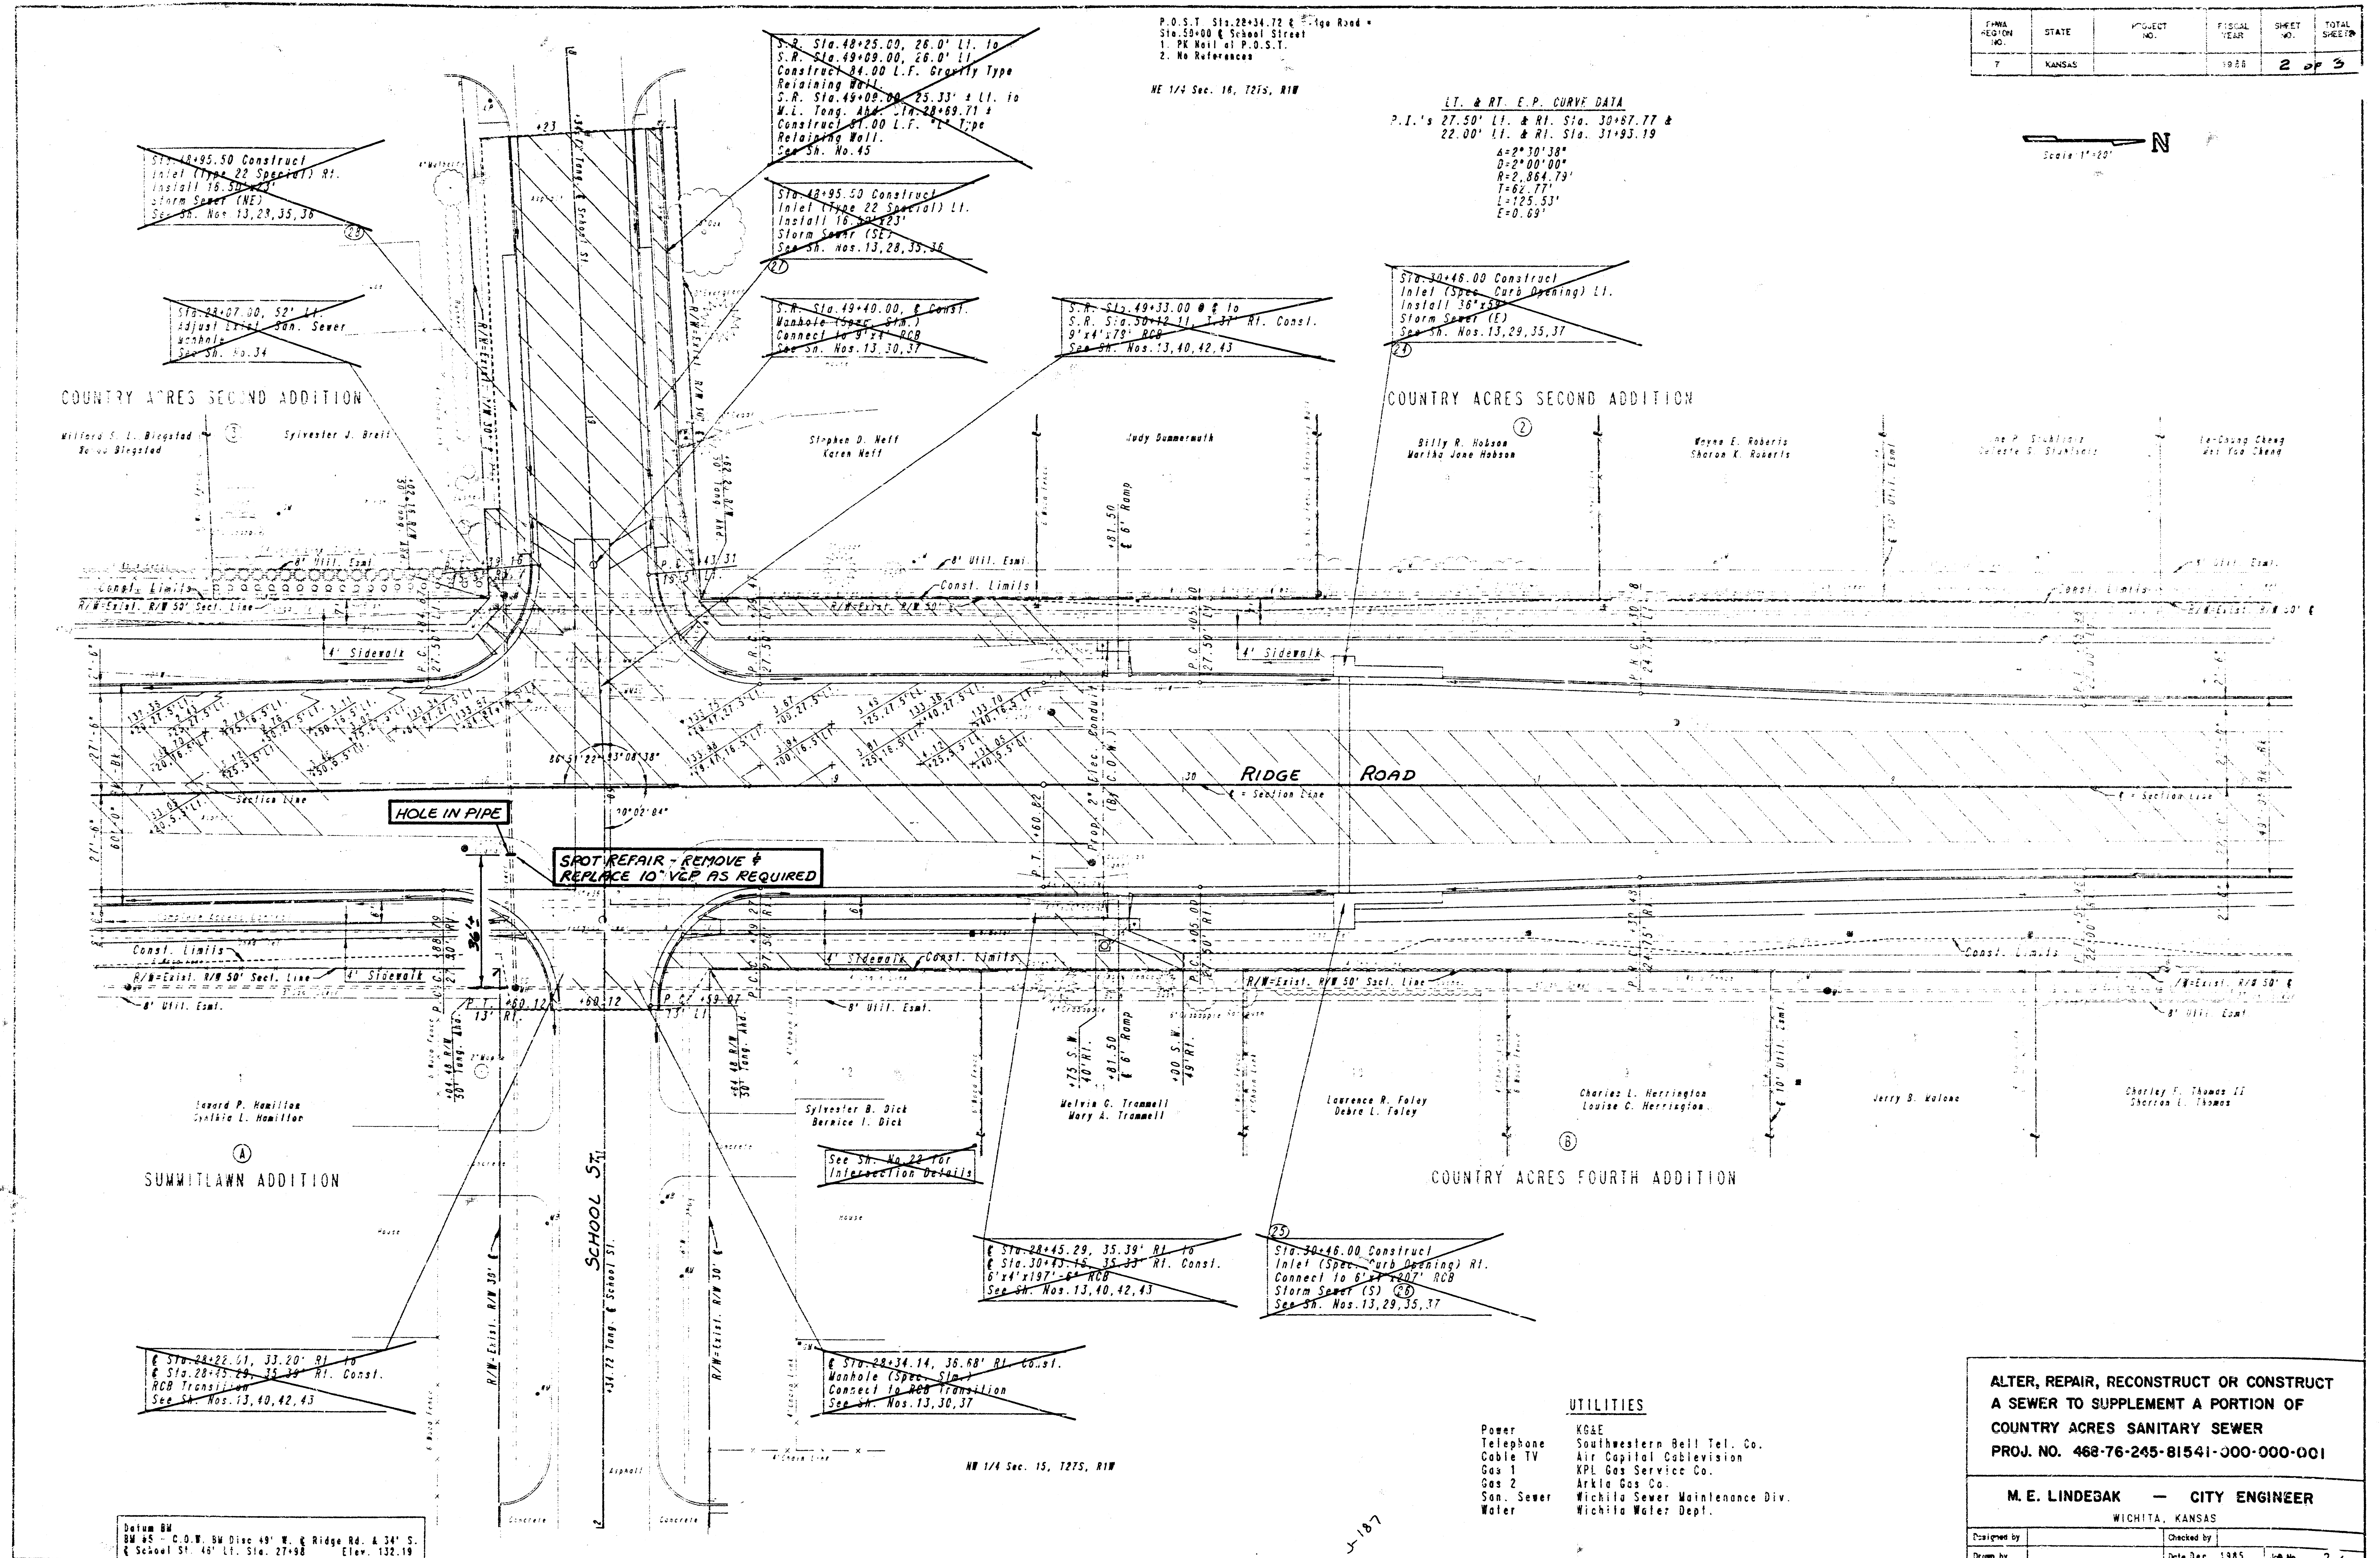

FWMA REGION NO.	STATE	PROJECT NO.	FISCAL YEAR	SHEET NO.	TOTAL SHEETS
7	KANSAS		1985	2 of 3	

Scale 1"=20'

LT. & RT. E.P. CURVE DATA
P.I.'s 27.50' LI. & RT. Sta. 30+87.77 & 22.00' LI. & RT. Sta. 31+83.19
A=2°30'38"
D=2°00'00"
R=2,064.79'
T=62.77'
L=125.53'
E=0.69'

UTILITIES	
Power	K&E
Telephone	Southwestern Bell Tel. Co.
Cable TV	Air Capital Cablevision
Gas 1	XPL Gas Service Co.
Gas 2	Arkla Gas Co.
San. Sewer	Wichita Sewer Maintenance Div.
Water	Wichita Water Dept.

ALTER, REPAIR, RECONSTRUCT OR CONSTRUCT A SEWER TO SUPPLEMENT A PORTION OF COUNTRY ACRES SANITARY SEWER PROJ. NO. 468-76-245-81541-000-000-001	
M.E. LINDEBAK — CITY ENGINEER WICHITA, KANSAS	
Designed by	Checked by
Drawn by	Date Dec. 1985 Job No. 2/13

FILMED FROM THE BEST AVAILABLE COPY.....


FEMA REGION NO.	STATE	PROJECT NO.	FISCAL YEAR	SHEET NO.	TOTAL SHEETS
7	KANSAS		1985	3 of 3	3

Scale: 1"=20'

1. E.P. CURVE DATA
P.I. 19.93' Lt. & Sta. 45+58.78
A=2°26'58"
T=2°00'00"
R=2,864.79'
L=122.44'
E=0.65'

NE 1/4 Sec. 16, T27S, R1W

COUNTRY ACRES THIRD ADDITION

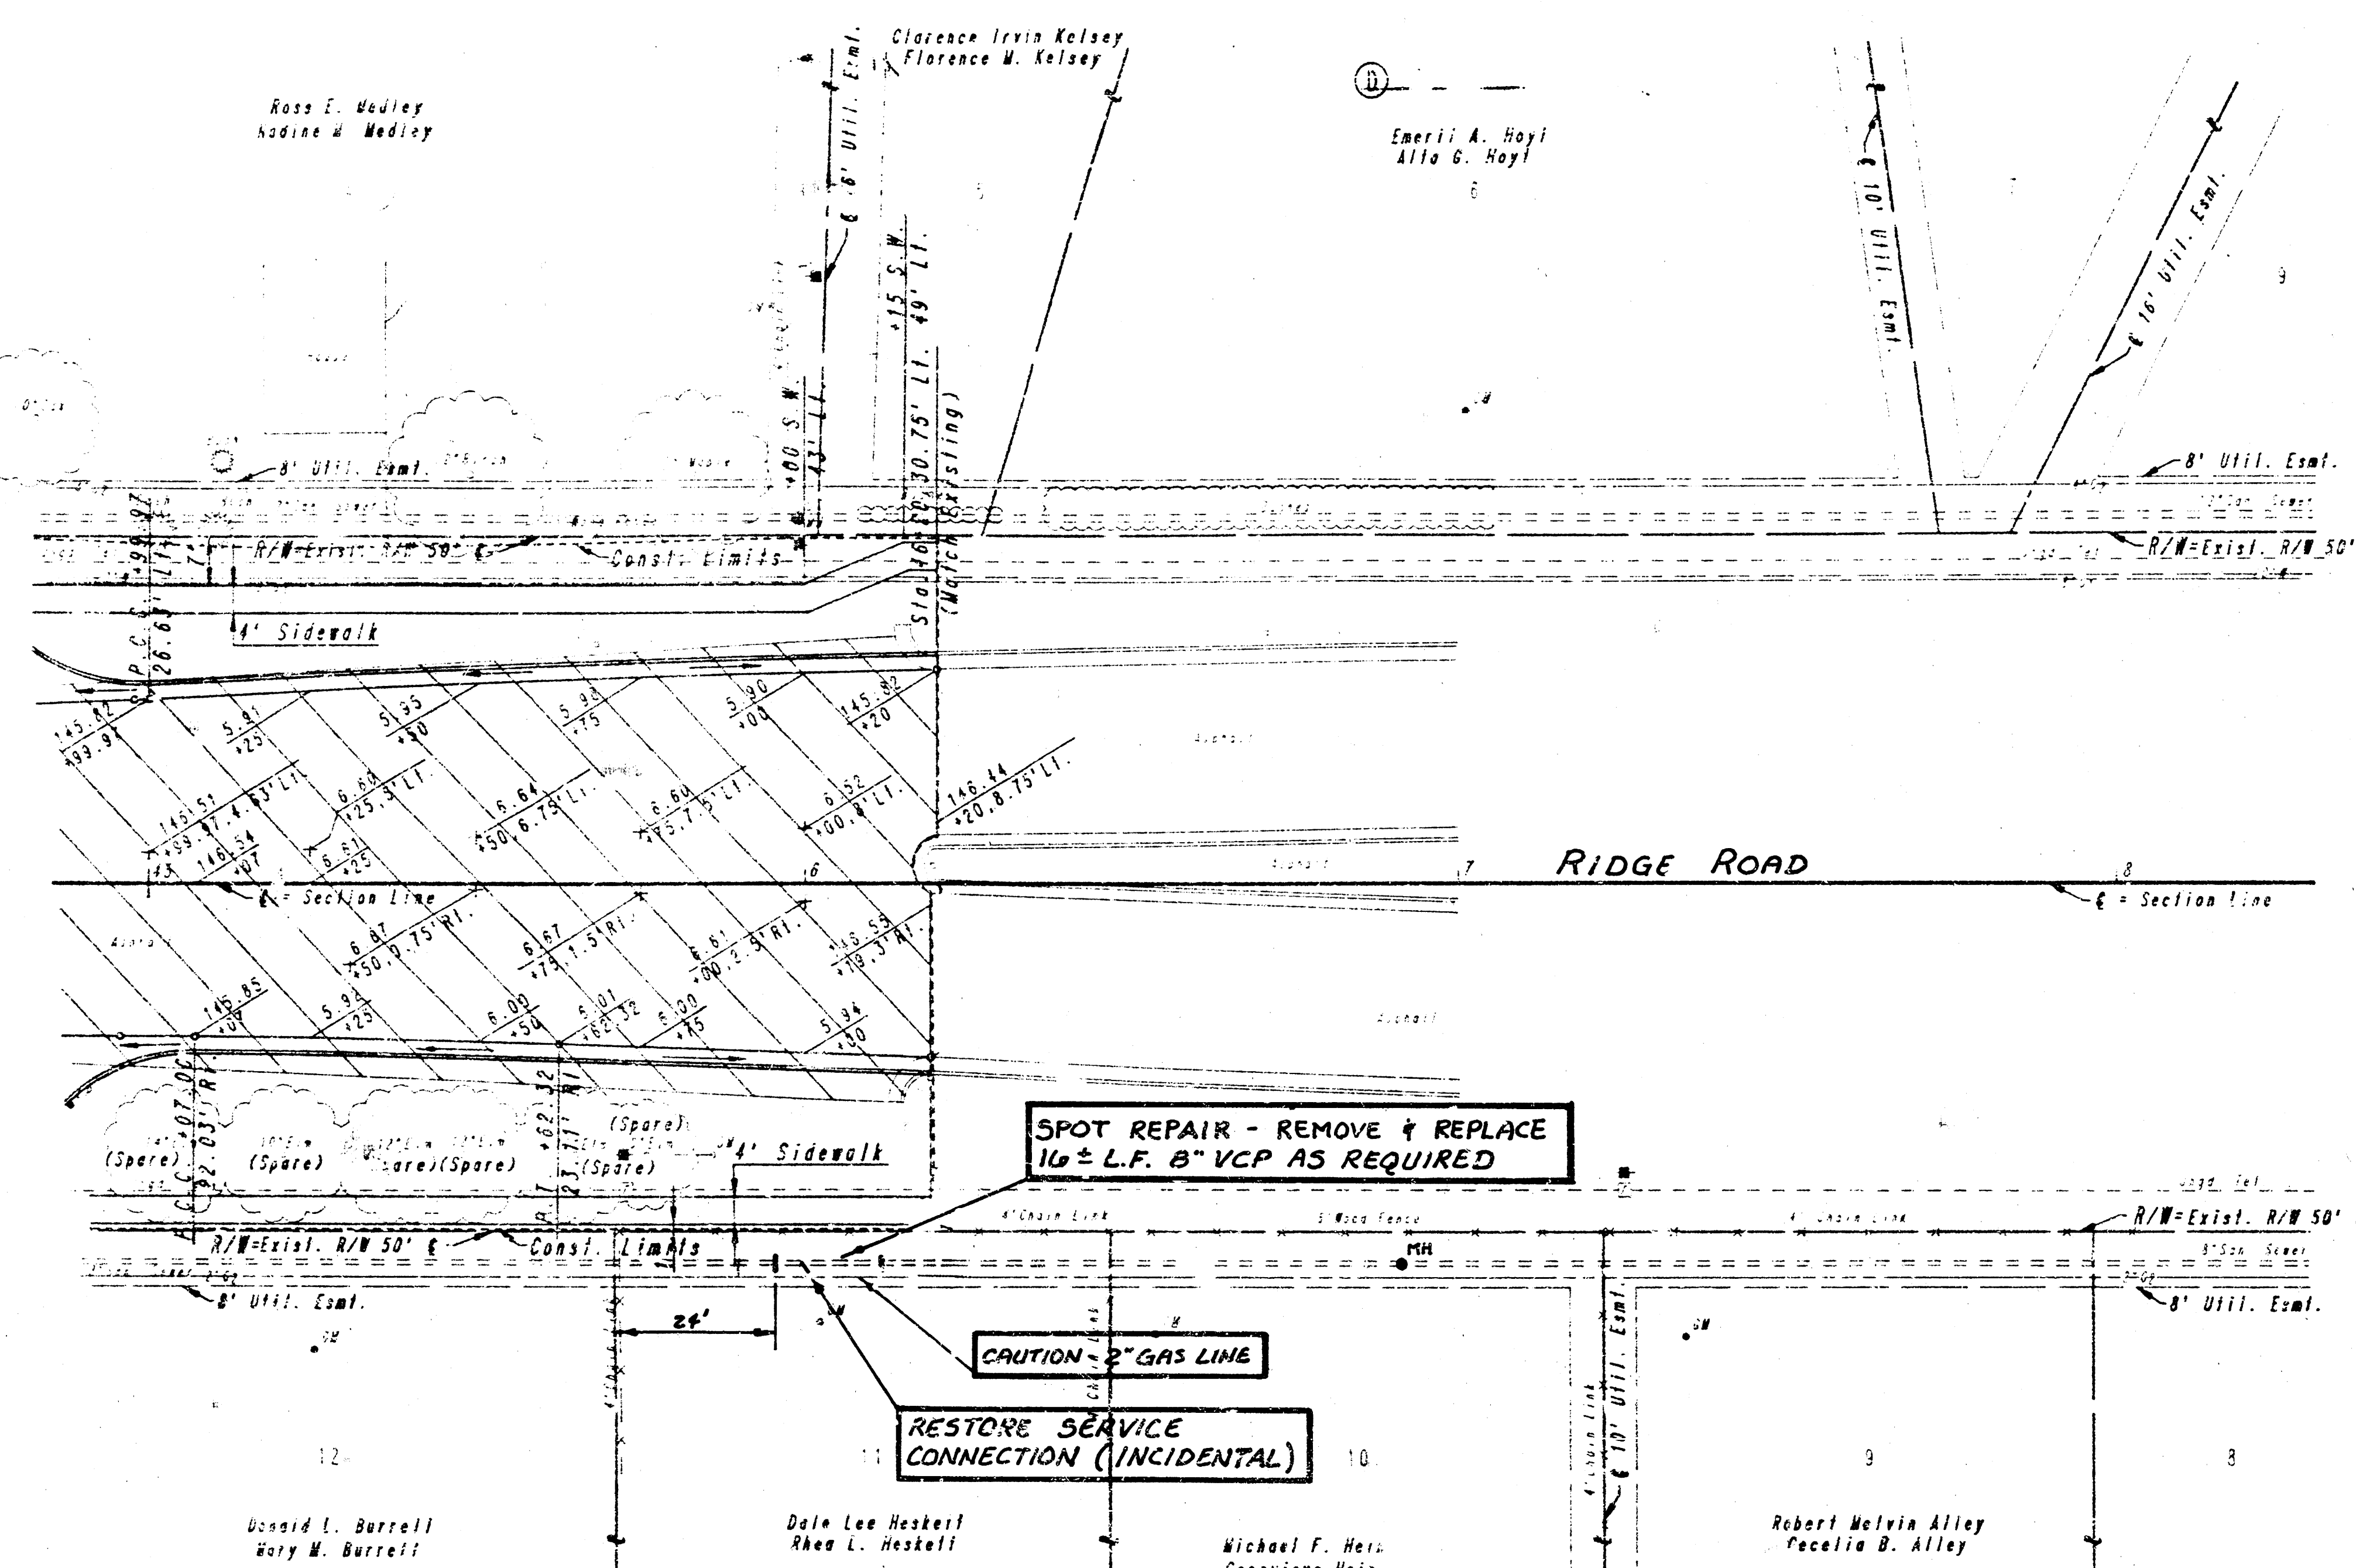

2. E.P. CURVE DATA
P.I. 22.00' Rt. & Sta. 45+29.00
A=1°54'33"
D=2°51'53"
R=2,000.00'
T=33.32'
L=66.64'
E=0.28'

NW 1/4 Sec. 15, T27S, R1W

COUNTRY ACRES FOURTH ADDITION

STA. 46+20.00 END
Proj. No. 87-11-1037-01 =
Ridge Road Sta. 66+40.30 on
Proj. No. 87S-SU-1374(1)

BM 47 - Chis. "0" Back W. Median Curb at P.O. of
Back Curb. 4.5' Lt. Sta. 46+20. Elev. 147.12

UTILITIES

Power KCAE
Telephone Southwestern Bell Tel. Co.
Cable TV Air Capital Cablevision
Gas 1 CPL Gas Service Co.
Gas 2 Arkla Gas Co.
San. Sewer Wichita Sewer Maintenance Div.
Water Wichita Water Dept.

SW Cor. Sec. 10, T27S, R1W
1. 12\"/>

ALTER, REPAIR, RECONSTRUCT OR CONSTRUCT
A SEWER TO SUPPLEMENT A PORTION OF
COUNTRY ACRES SANITARY SEWER
PROJ. NO. 488-76-245-81541-000-000-001

M.E. LINDEBAK — CITY ENGINEER
WICHITA, KANSAS

Designed by _____ Checked by _____
Drawn by _____ Date Dec. 1985

3/3

FILMED FROM THE BEST
AVAILABLE COPY