
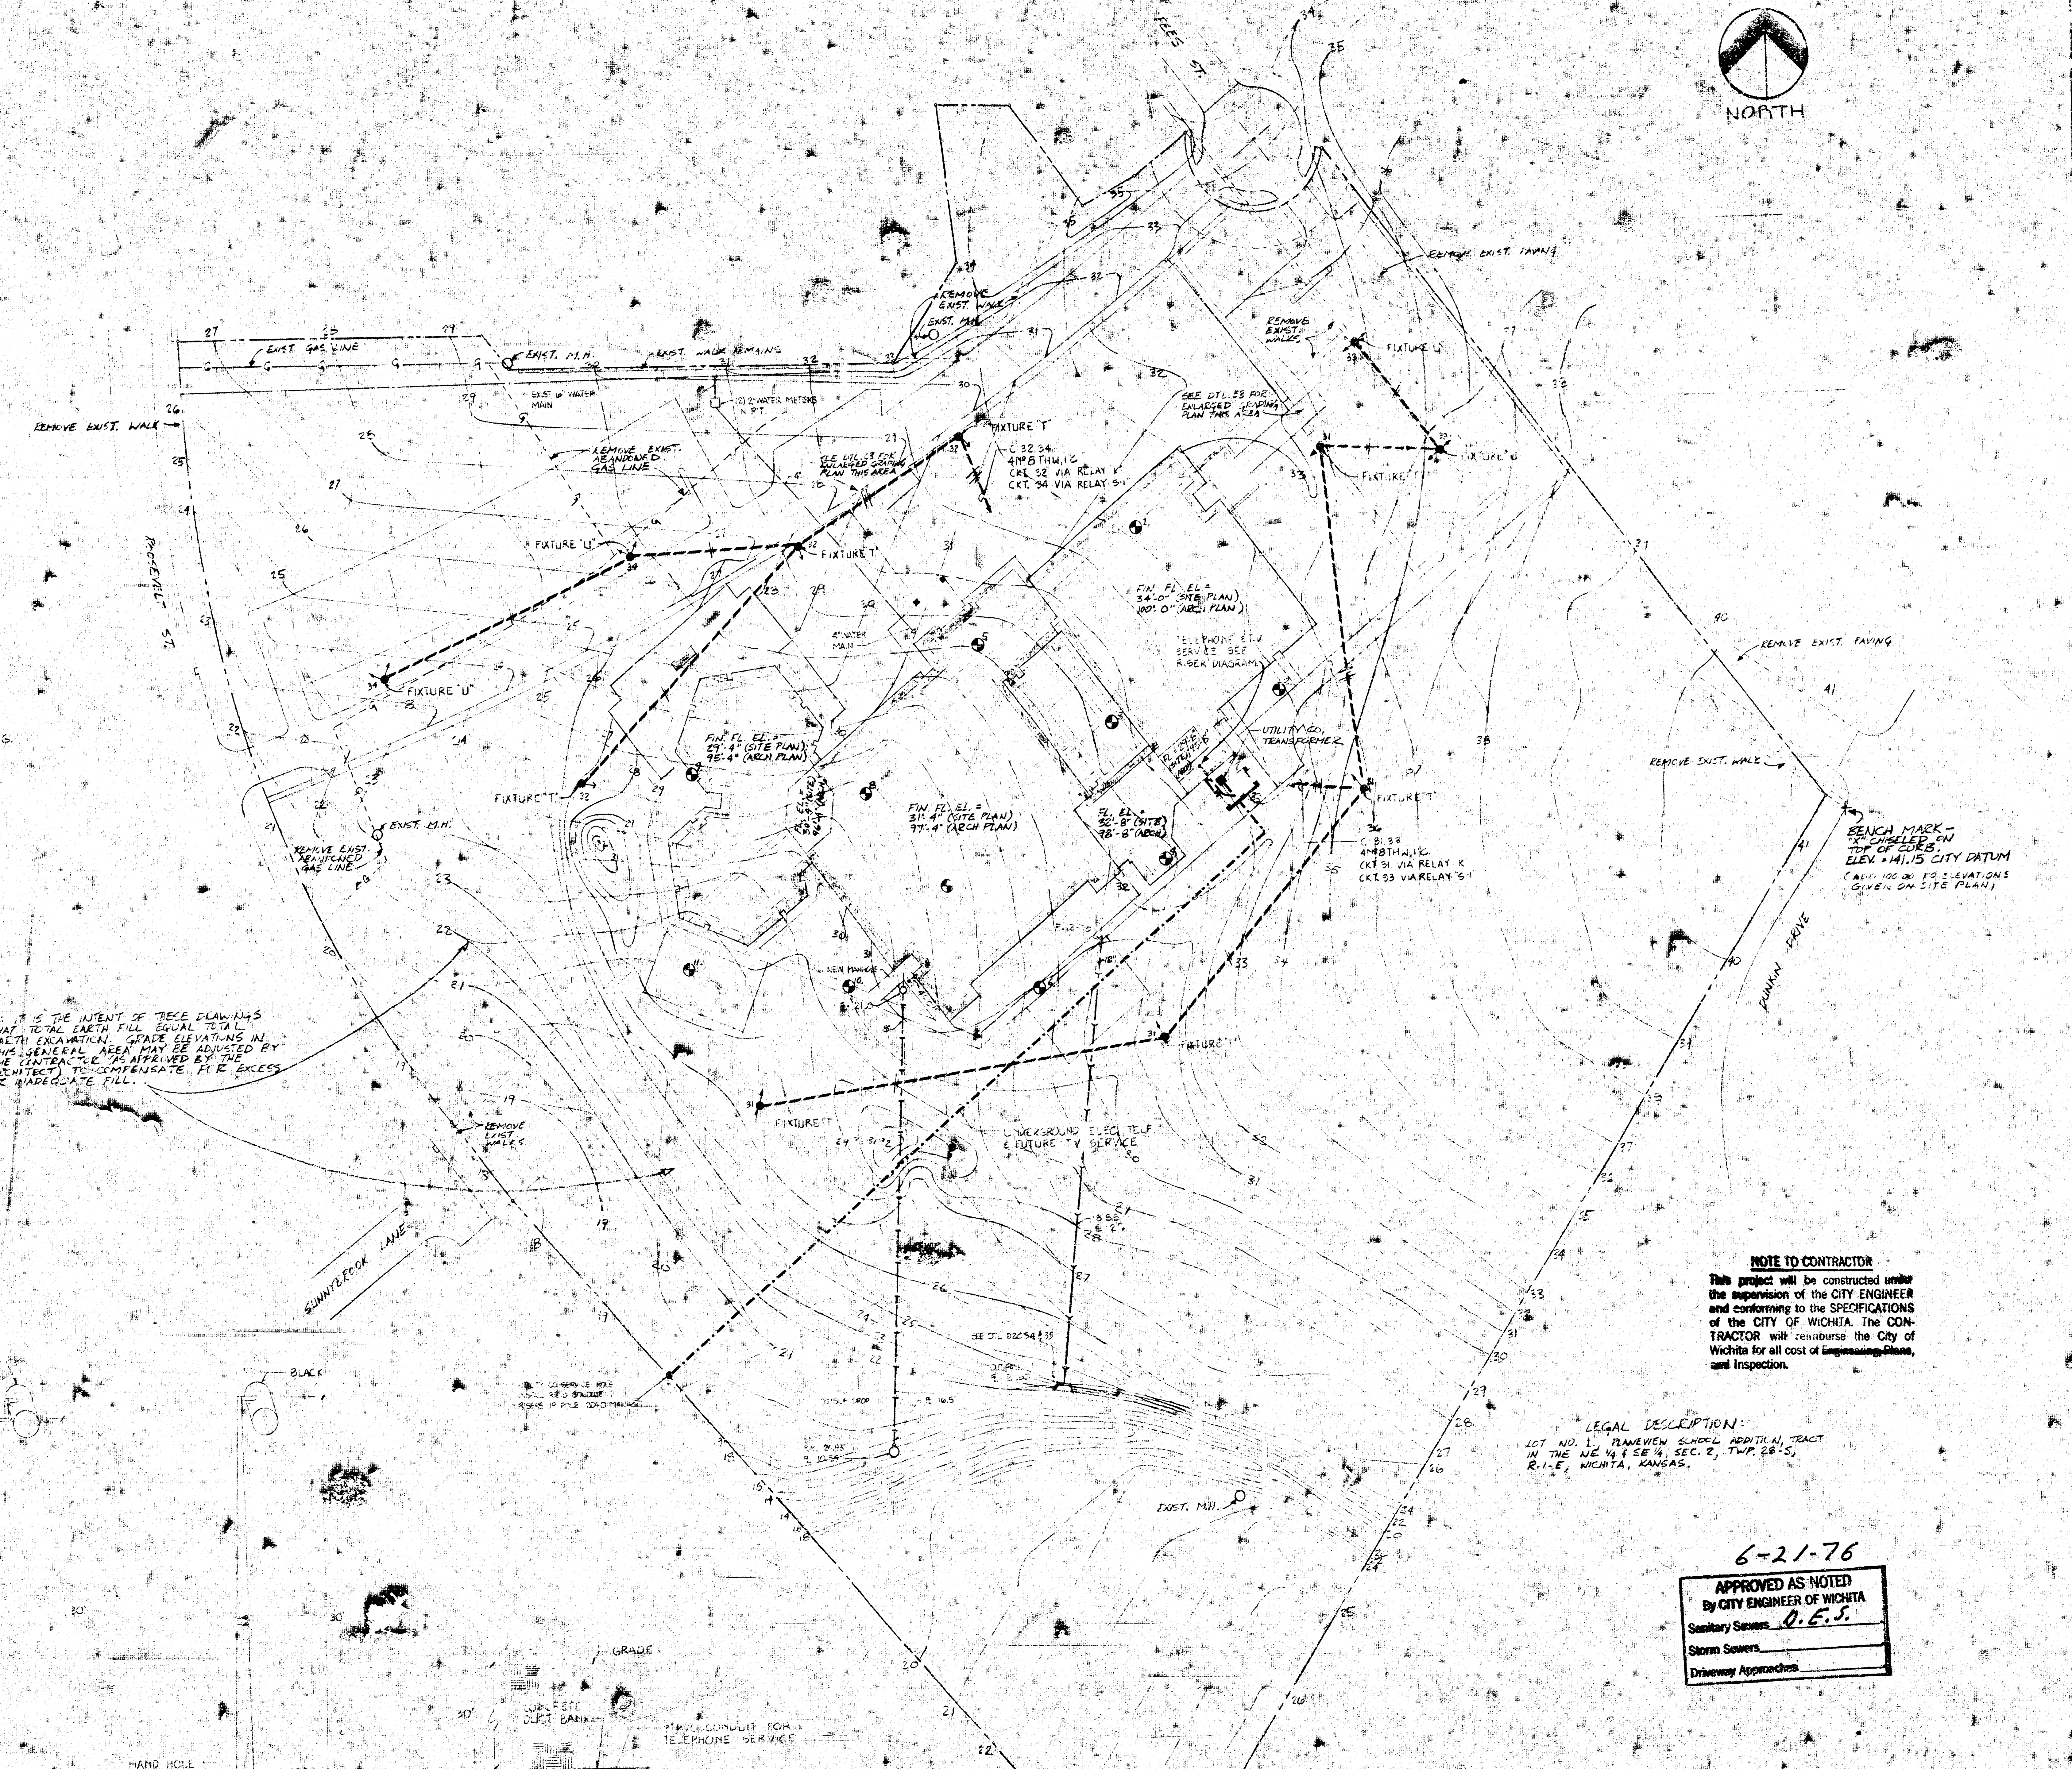
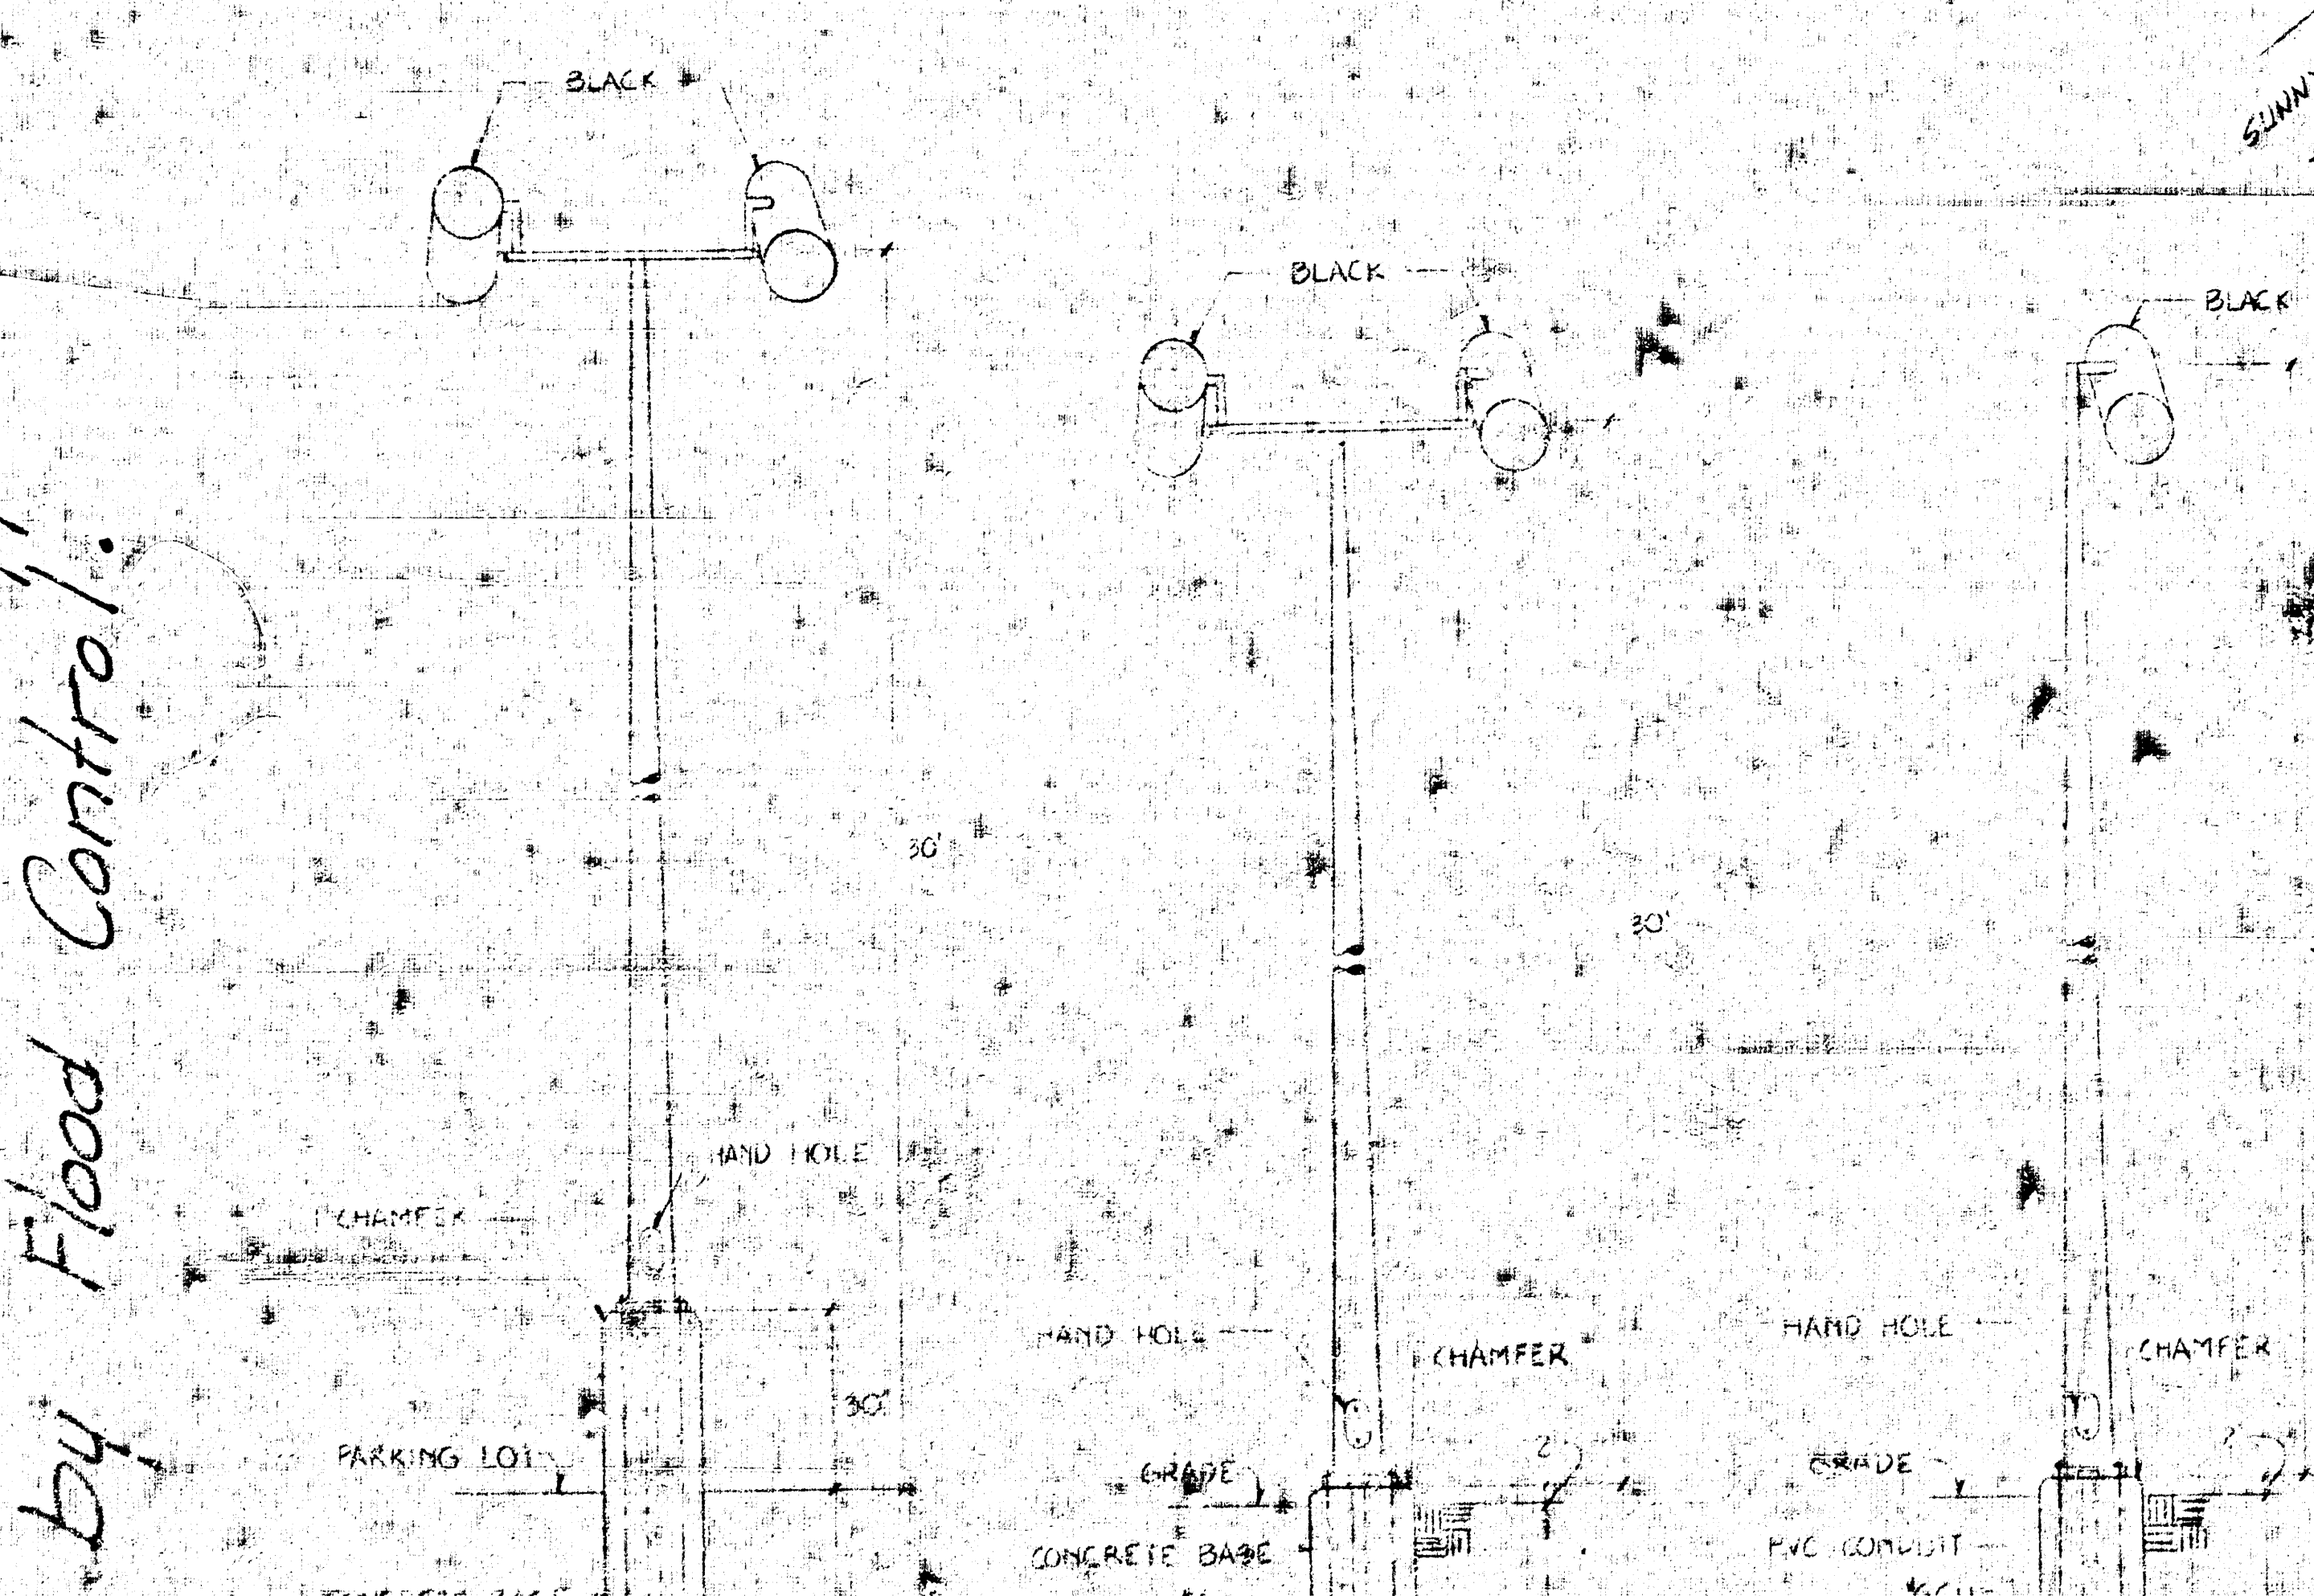


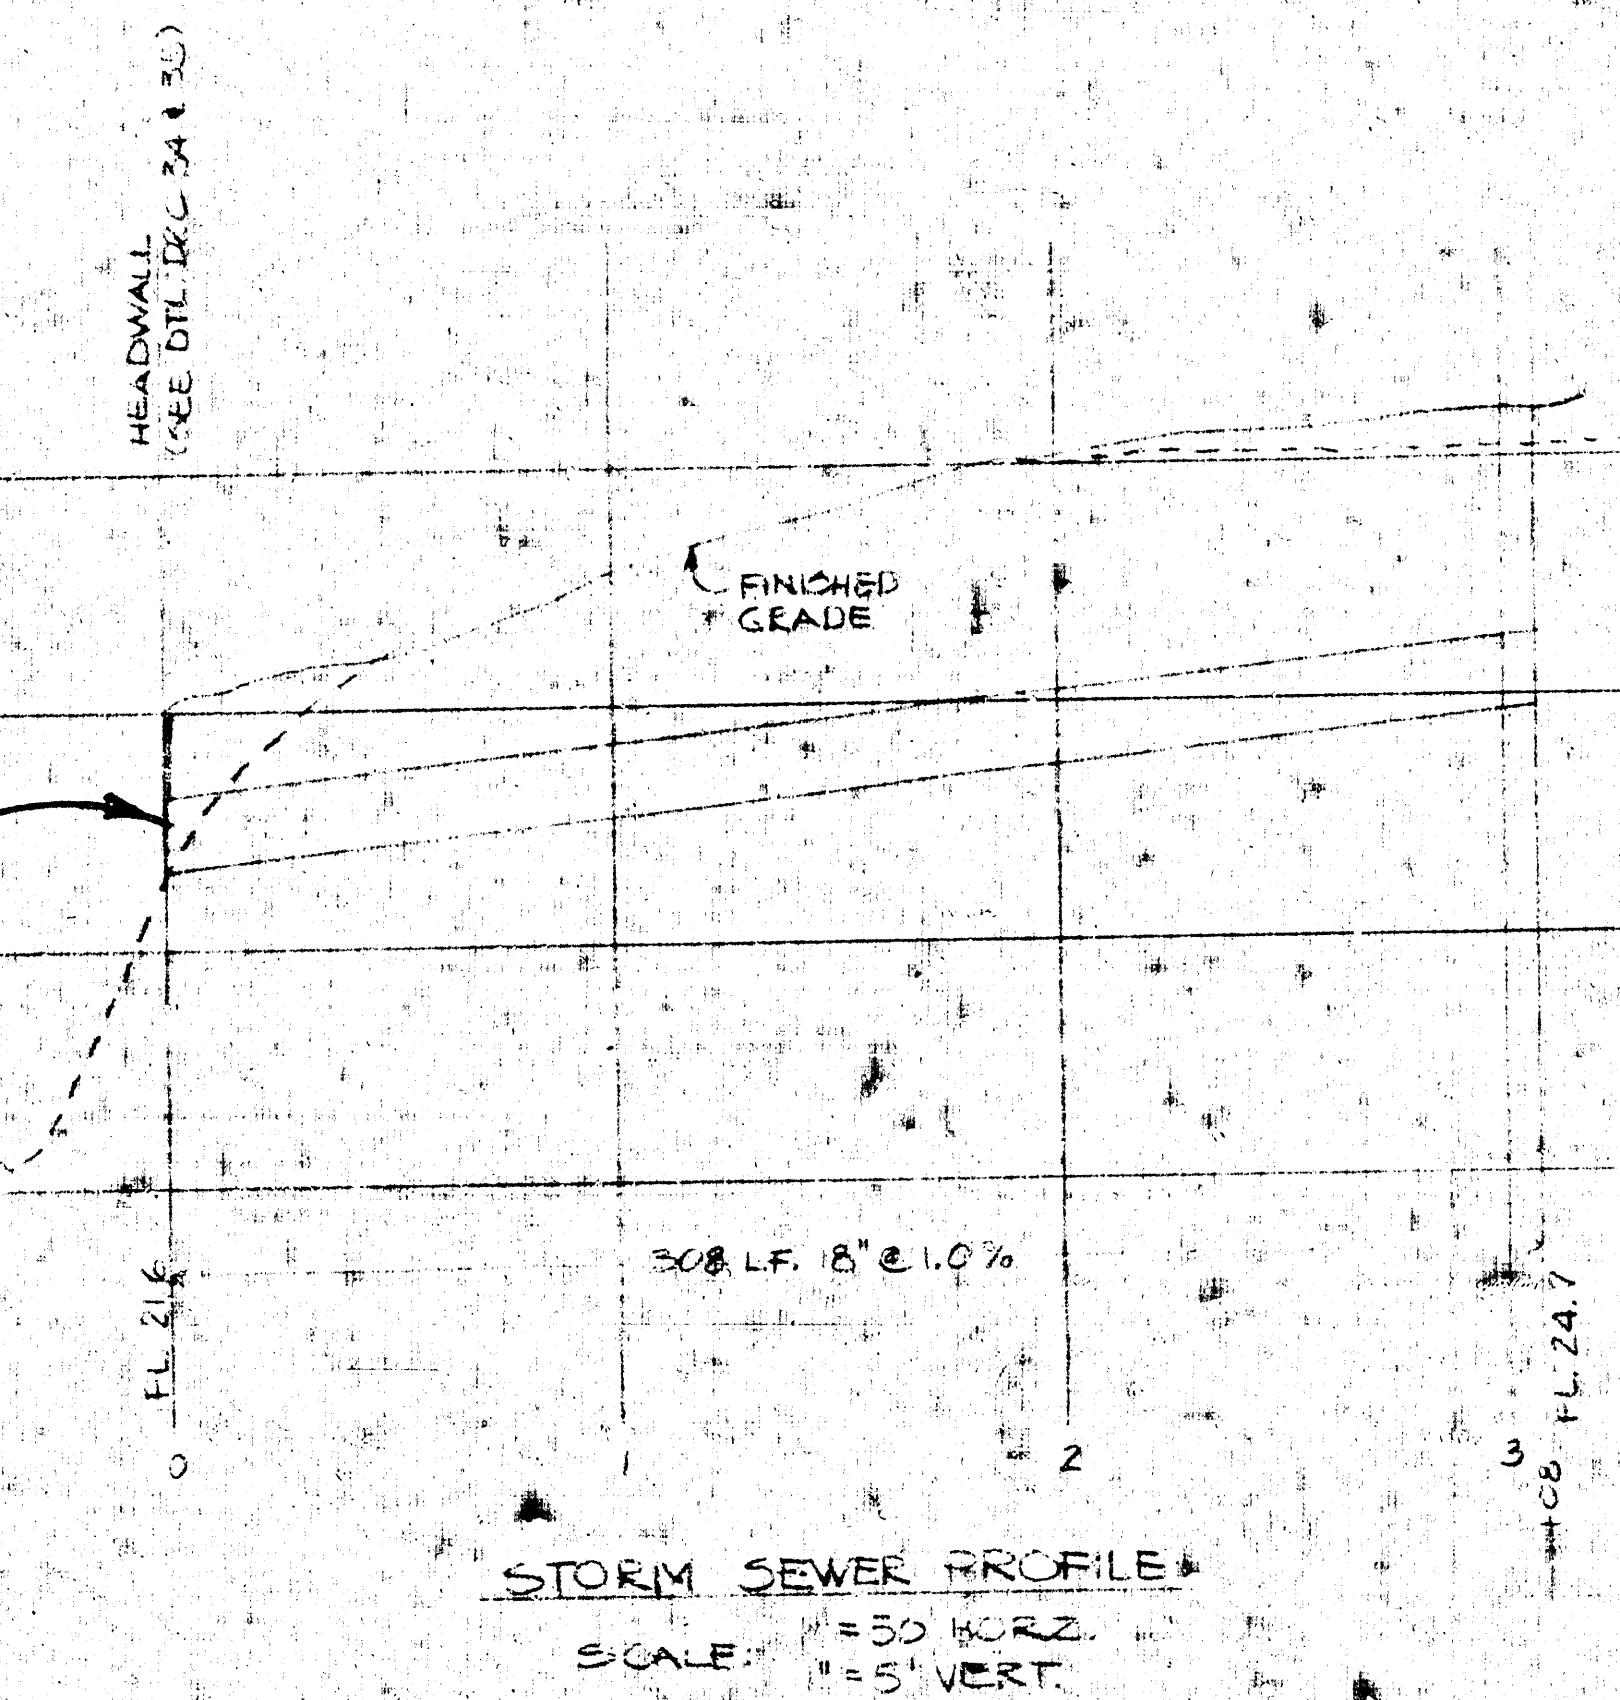

NOTE: IT IS THE INTENT OF THESE DRAWINGS THAT TOTAL EARTH FILL EQUAL TOTAL EARTH EXCAVATION. GRADE ELEVATIONS IN THIS GENERAL AREA MAY BE ADJUSTED BY THE CONTRACTOR AS APPROVED BY THE ARCHITECT TO COMPENSATE FOR EXCESS OR INADEQUATE FILL.

NOTE TO CONTRACTOR

This project will be constructed under the supervision of the CITY ENGINEER and conforming to the SPECIFICATIONS of the CITY OF WICHITA. The CONTRACTOR will reimburse the City of Wichita for all cost of Engineering, Plans, and Inspection.

LEGAL DESCRIPTION:
LOT NO. 1, PLANEVIEW SCHOOL ADDITION, TRACT
IN THE NE ¼ & SE ¼, SEC. 2, TWP. 28-S,
R. 1-E, WICHITA, KANSAS.

6-21-76

APPROVED AS NOTED
By CITY ENGINEER OF WICHITA

Sanitary Sewers *D.E.S.*

Storm Sewers _____

Driveway Approaches _____

A SITE GRADING & UTILITIES
1" = 50'-0"

NOTE: SEE PLAN A31 FOR SPOT ELEVATIONS ON PAVING WALKS AND GRADE AT BUILDING CORNERS.

by Flood Control.

PLANEVIEW ELEMENTARY SCHOOL AND
COMMUNITY CENTER