


B.M. 117.39 R.R. Spk. NW face of Tele. Pole $\approx 305'$ So.
of E of 8th St. & W. of WRCO.





÷ SCALE ÷
 PLAN 1" = 20'
 PROFILE
 Horiz. 1" = 20'
 Vert. 1" = 5'

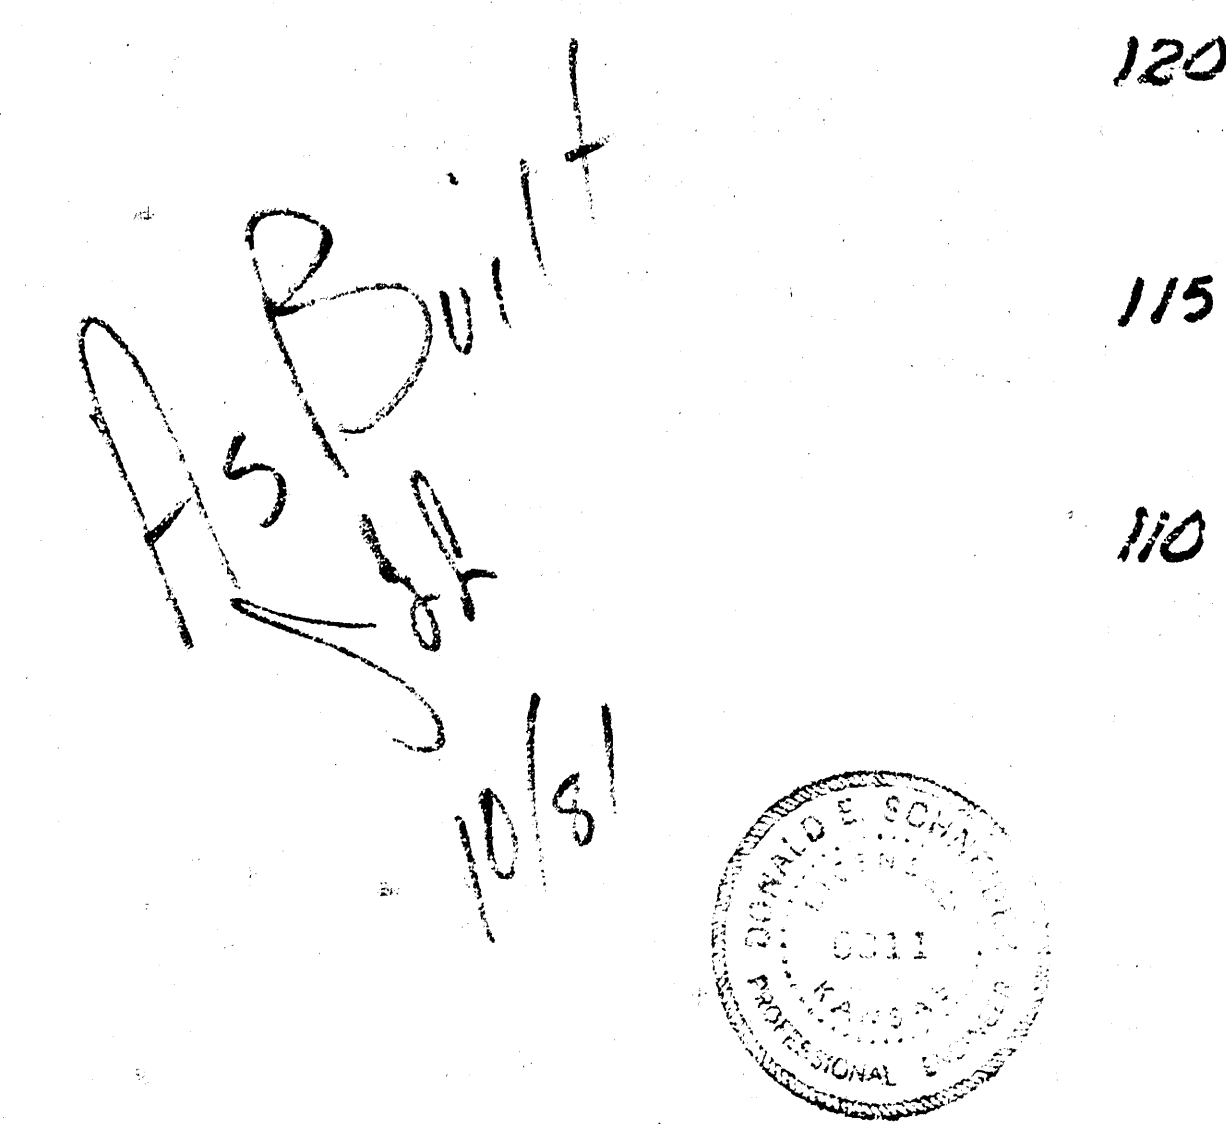


City of WICHITA, KANSAS
R. W. Bruggeman — City Engineer

DATE _____ Sheet 1 of 2
Proj. No.: 542-80-245-80006-000-000-00

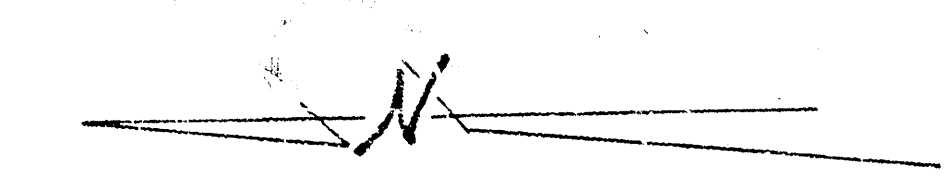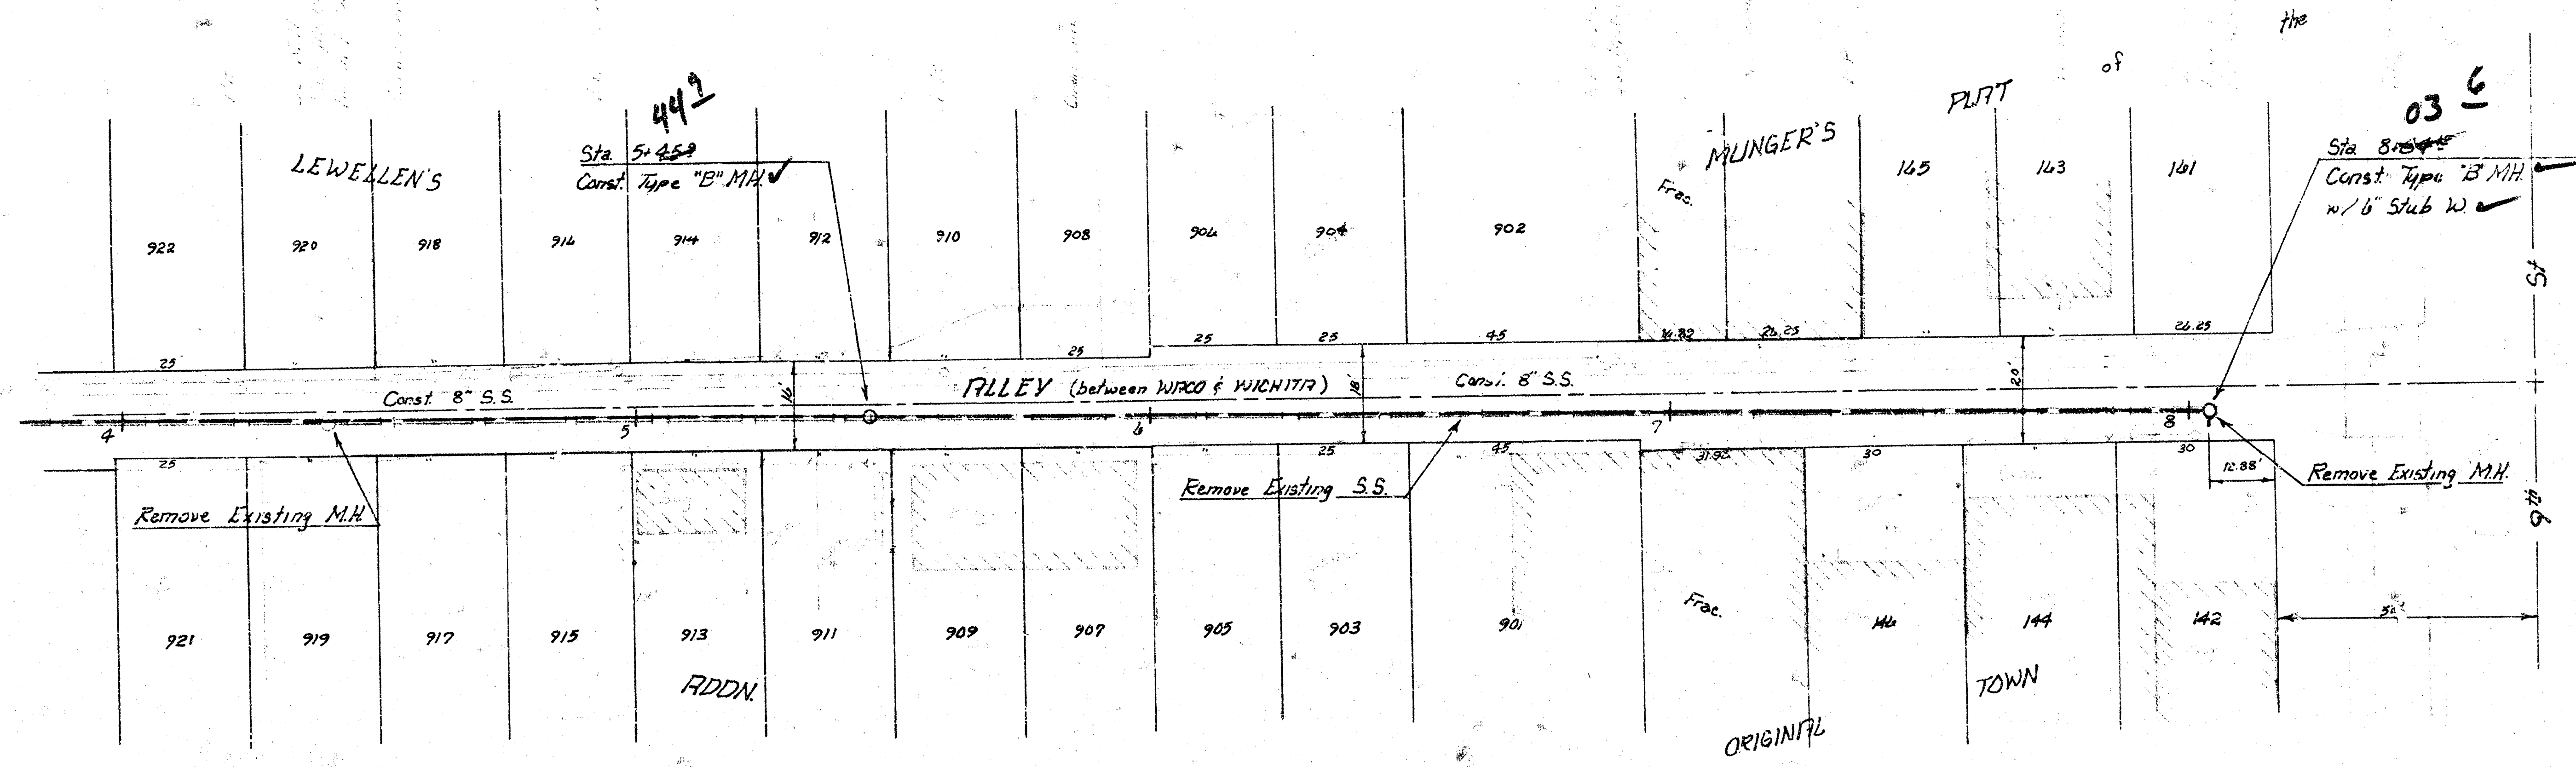

SCALE
 PLAN 1" = 20'
 PROFILE 1" = 20'
 Vert. 1" = 5'

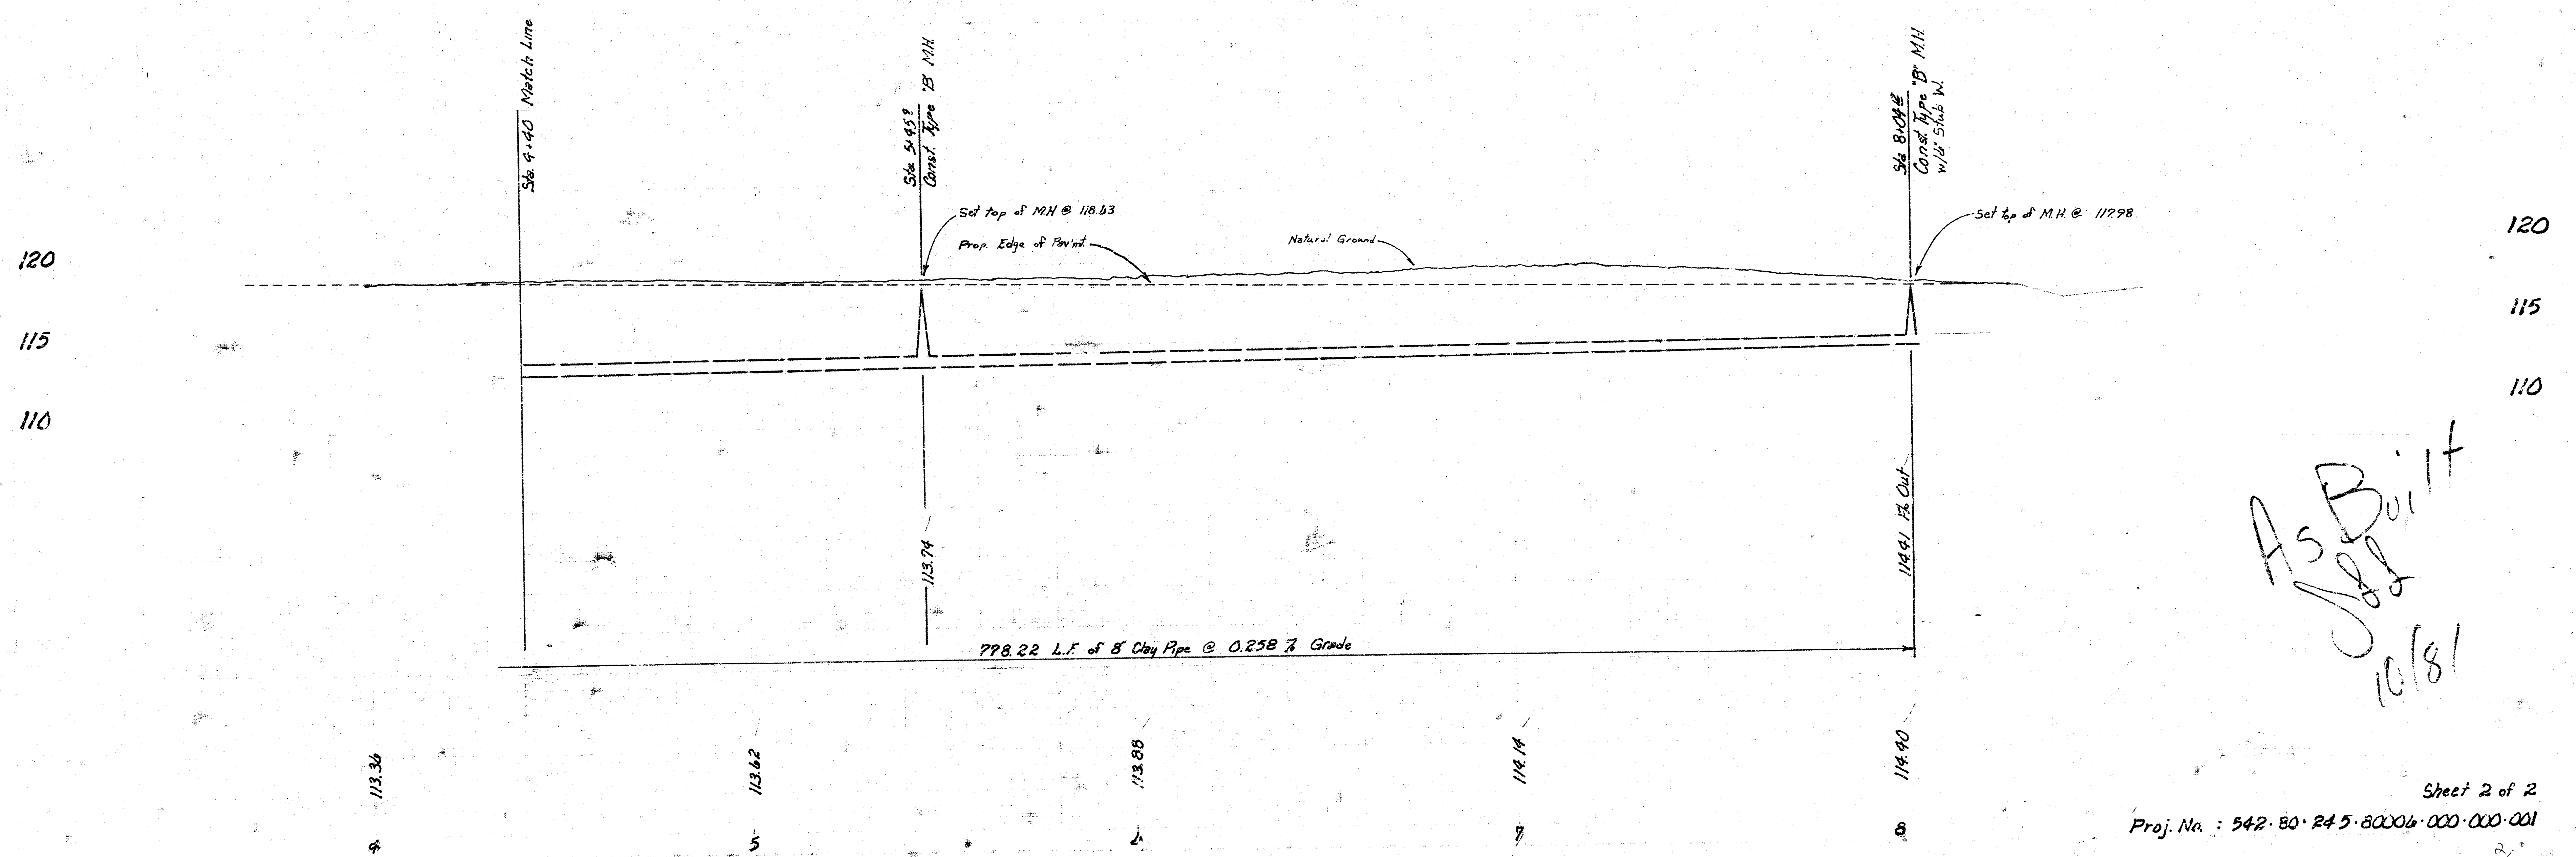

As Built
 JSS
 10/8/1