


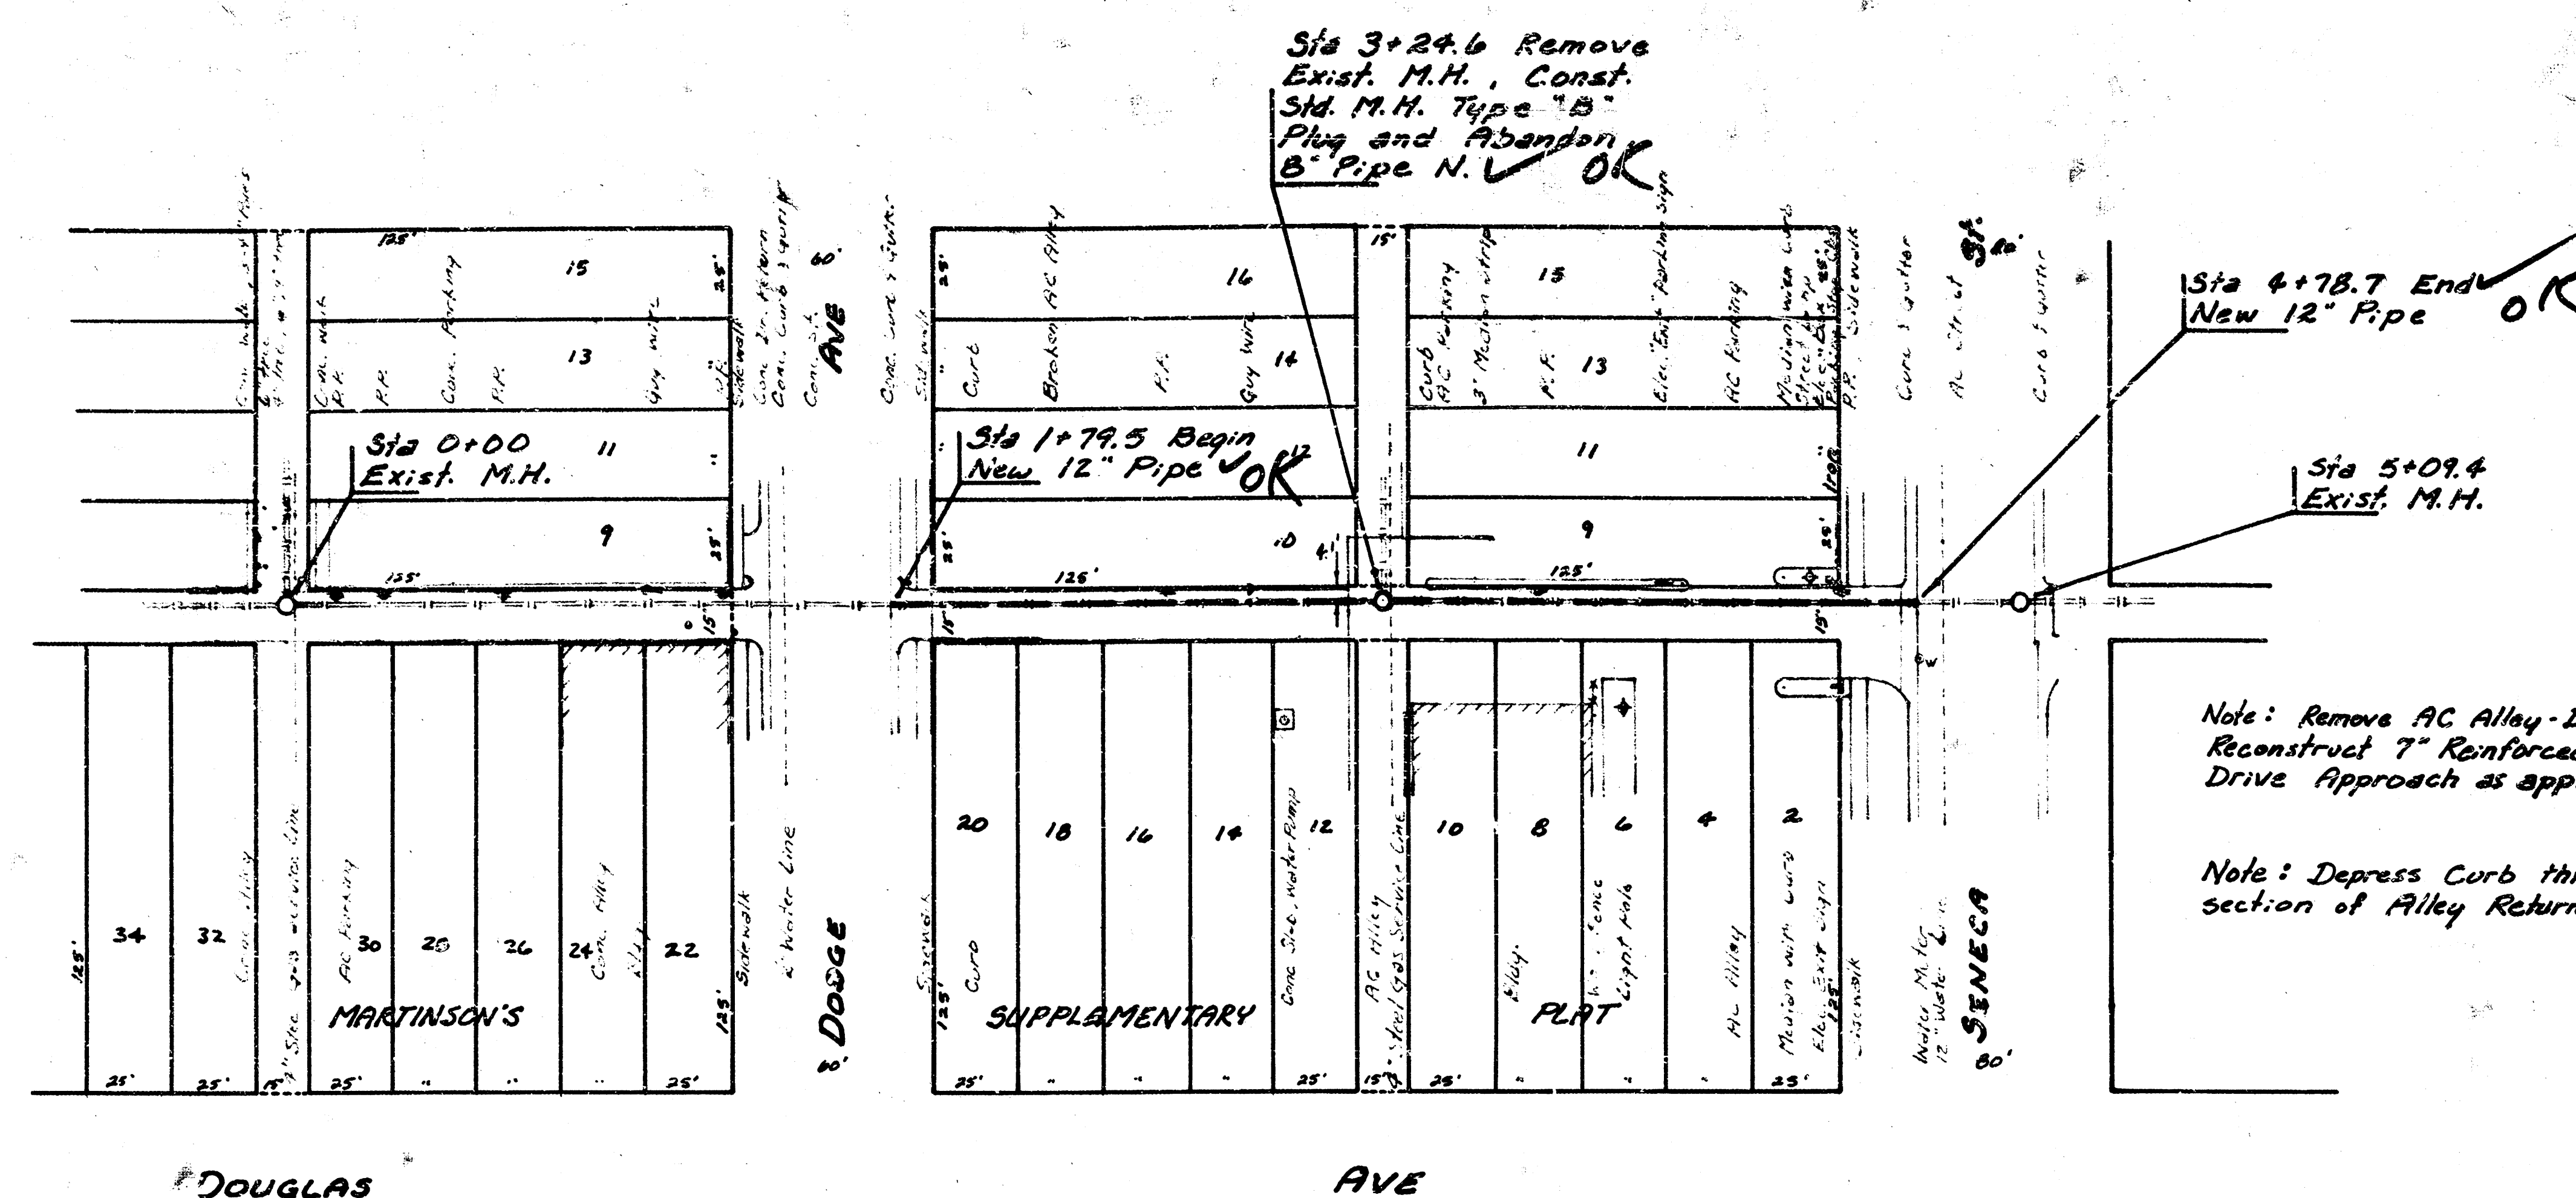


Note: Remove AC Alley-Drive Approach.
Reconstruct 7" Reinforced Conc. Alley-
Drive Approach as approved by Engineer

Note: Depress Curb through Sidewalk section of Alley Return.

B.M. 118.67 'x' Bk. Walk at corner Bldg. NE.
corner Seneca and Douglas.

B.M. 109.777 City Disc. 32.6' S and 39' W
of E both Seneca and Maple.


B.M. 112.655 'x' on side walk at SE. corner
of Bldg. NW corner of Doyles and Dodge

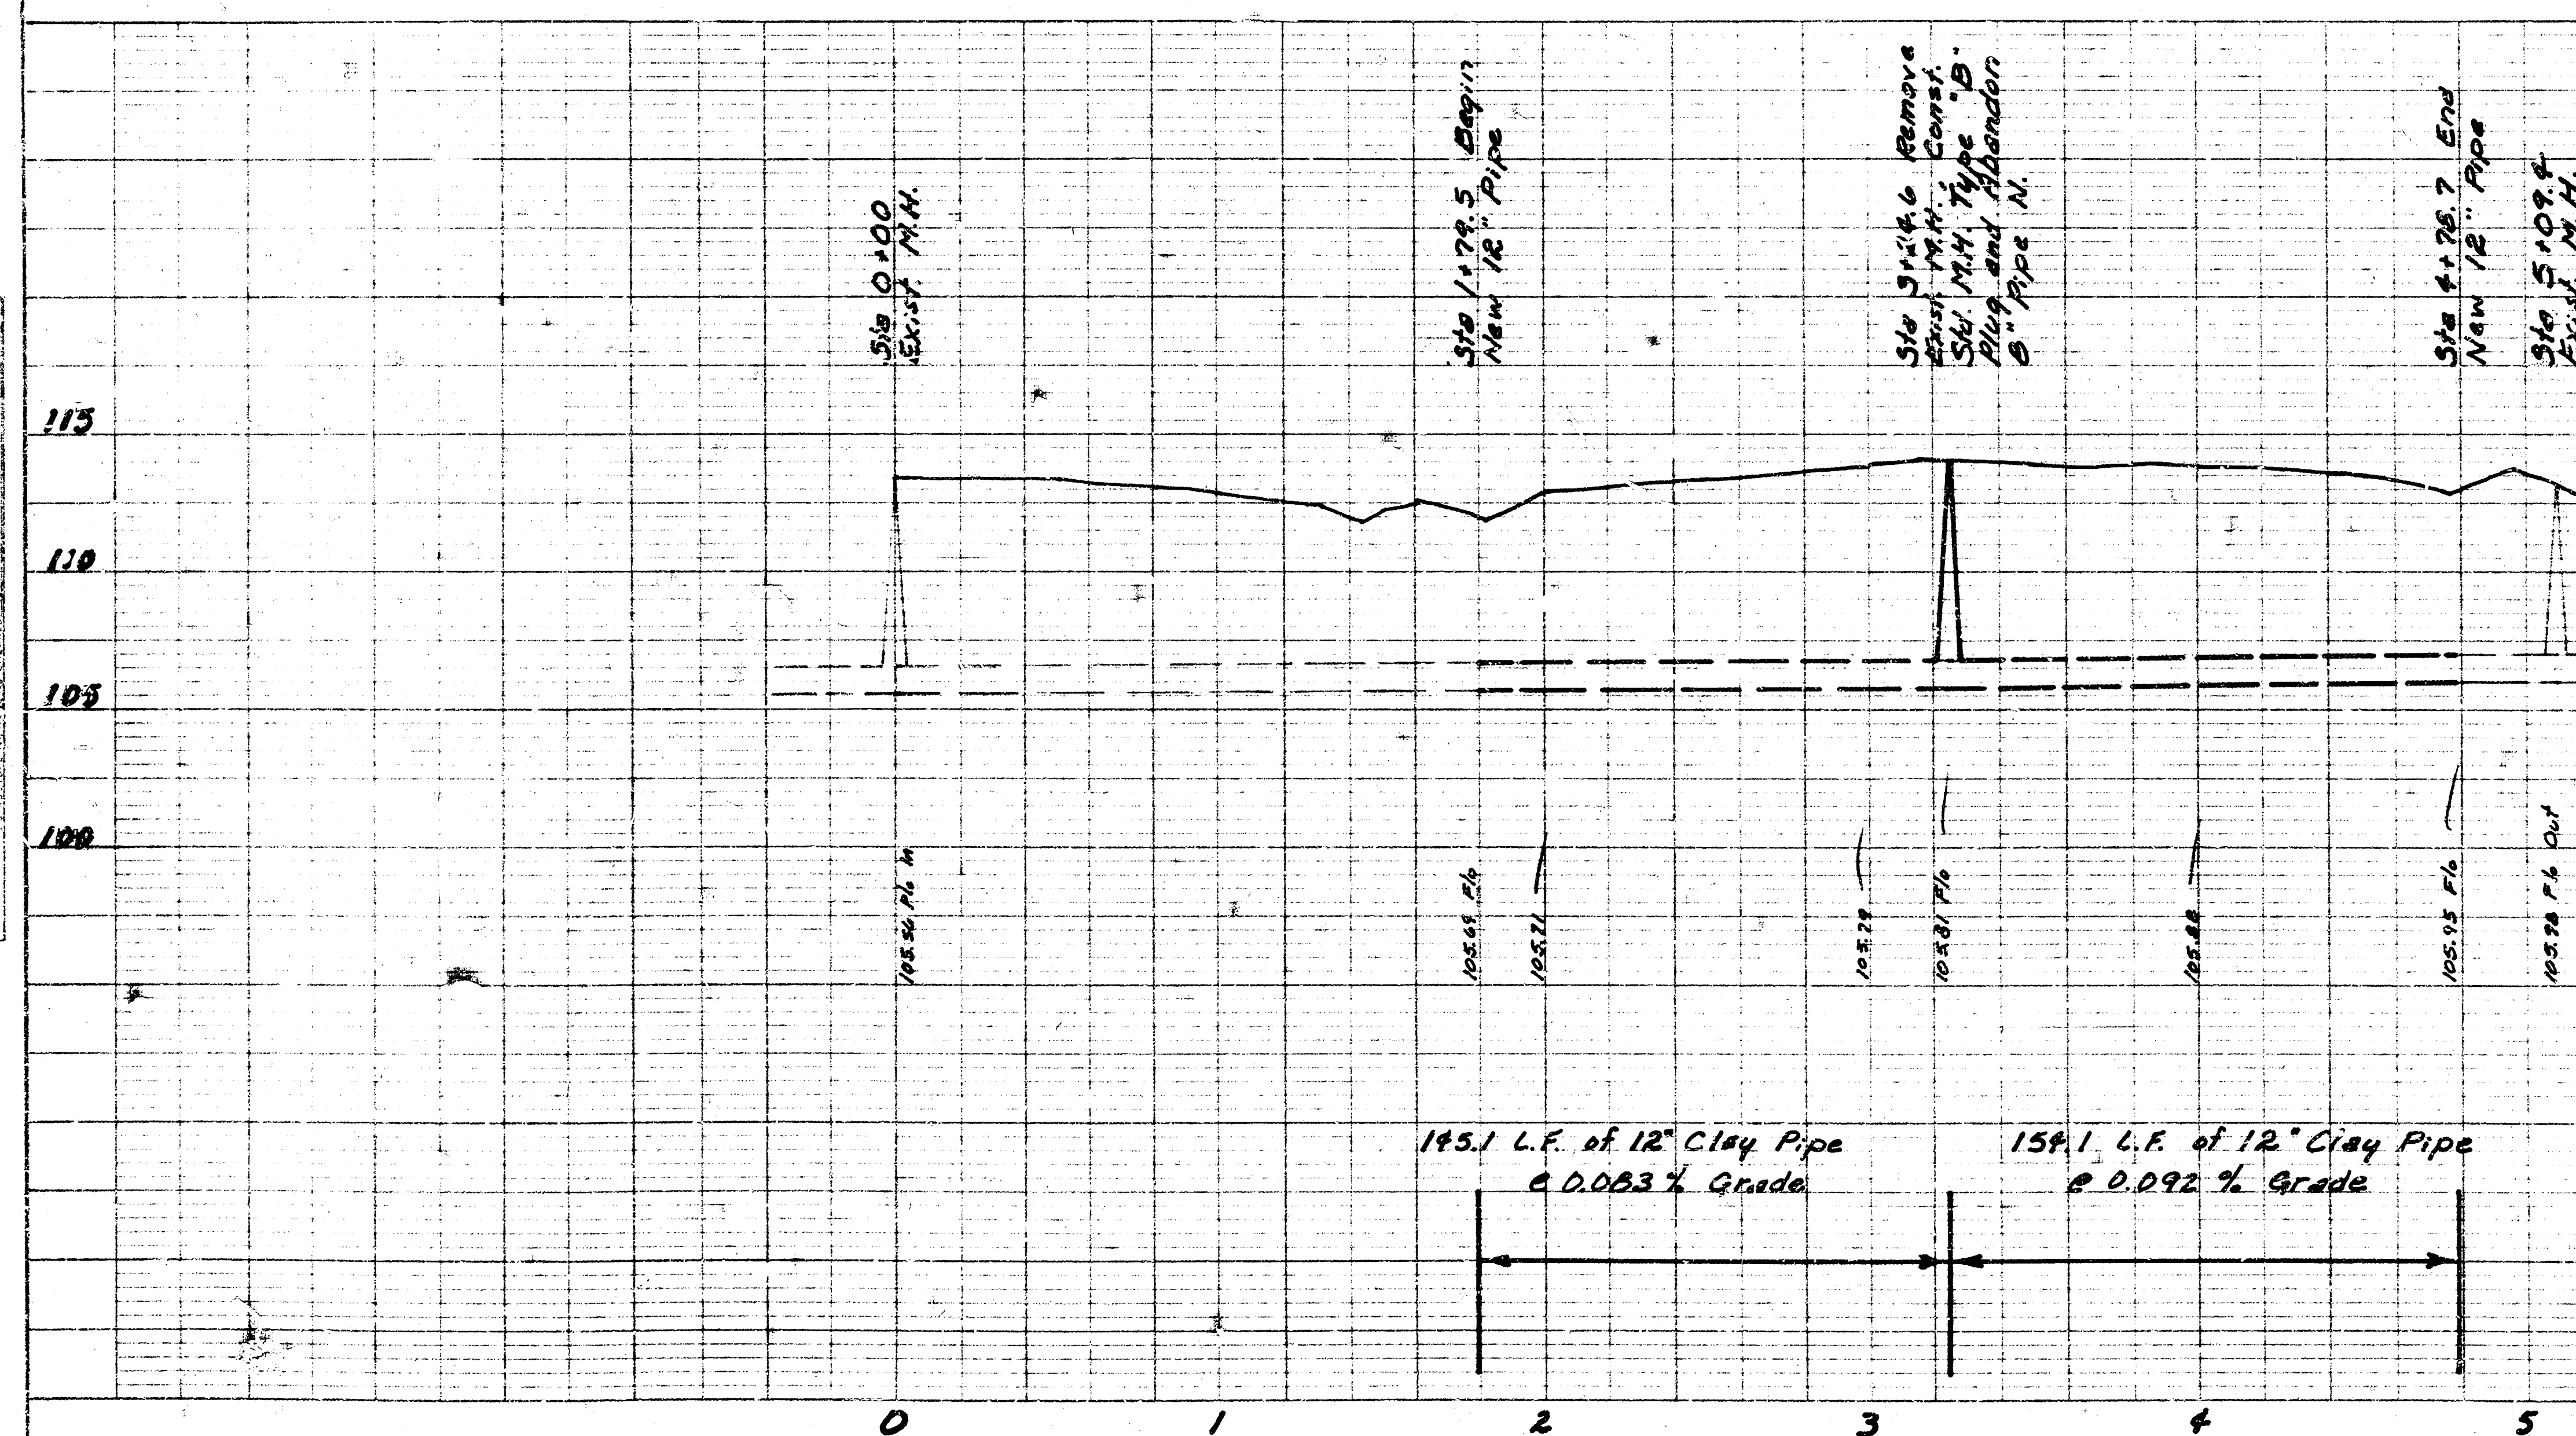

NOTE: CONTRACTOR'S METHOD FOR HANDLING SEWAGE FLOWS DURING CONSTRUCTION OF THIS PROJECT SHALL BE APPROVED BY THE ENGINEER. CONTRACTOR WILL BE REQUIRED TO OBTAIN PERMITS FROM PUBLIC WORKS ADMINISTRATION BEFORE RECONNECTING BUILDING SEWER LINES. PERMIT FEE WILL BE WAIVED. BID ITEMS FOR SEWER CONNECTIONS SHALL COVER ALL COSTS FOR FURNISHING AND INSTALLING SADDLE INCLUDING TAPPING PIPES. PIPES LAPS ARE TO BE MADE BY CITY MAINTENANCE DEPARTMENT. PERSONNEL UNLESS APPOINTED OTHERWISE BY THE ENGINEER, ONLY ACTIVE BUILDING SANITARY SEWER LINES ARE TO BE RECONNECTED TO EXISTING SEWER LINES. ALL OTHER SEWER LINES ARE TO BE RECONNECTED TO THE CITY MAINTENANCE DEPARTMENT. ALL SEWER LINES SHALL BE TRAPPED. CLEAN OUTS SHALL BE INSTALLED WITH THE TRAPS. MINIMUM CLEAN OUT SHALL BE CLASS 5 CAST IRON PIPE AND BE PAID FOR AT THE LOWEST PRICE PER LINEAL FOOT OF CAST IRON PIPE. LOCATION OF TRAPS AND CLEAN OUTS SHALL BE AS APPROVED BY THE ENGINEER. THE SEWER MAINS AND SEWER CONNECTIONS TO BE INSTALLED SHALL BE CLASS 5 CAST IRON PIPE. THE CONTRACTOR SHALL HAVE ALL PROPERTY OWNERS AND TENANTS ADVISED BY THE CONSTRUCTION OF THIS PROJECT A MINIMUM OF 30 DAYS ADVANCE NOTICE PRIOR TO START OF CONSTRUCTION.

ALL 4" AND 6" SEWER CONSTRUCTION SHALL CONFORM TO THE APPLICABLE SECTIONS OF THE CITY OF WICHITA CODE.

As Built

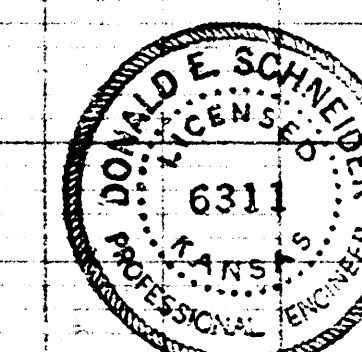

RECONSTRUCTION OF A PORTION OF SAN. SEWER NO. 8
IN THE E-W ALLEY N. OF DOUGLAS, SENECA TO DODGE

CITY OF WICHITA, KANSAS
DEAN SELLERS — CITY ENGINEER
PROJ. NO. 542-80-245-80005-000000-001

K-E PLATE 1, PLAN-PROFILE
KILGUS & ESSER CO.
46 7024 MADE IN U.S.A.

FILMED FROM THE BEST
AVAILABLE COPY