



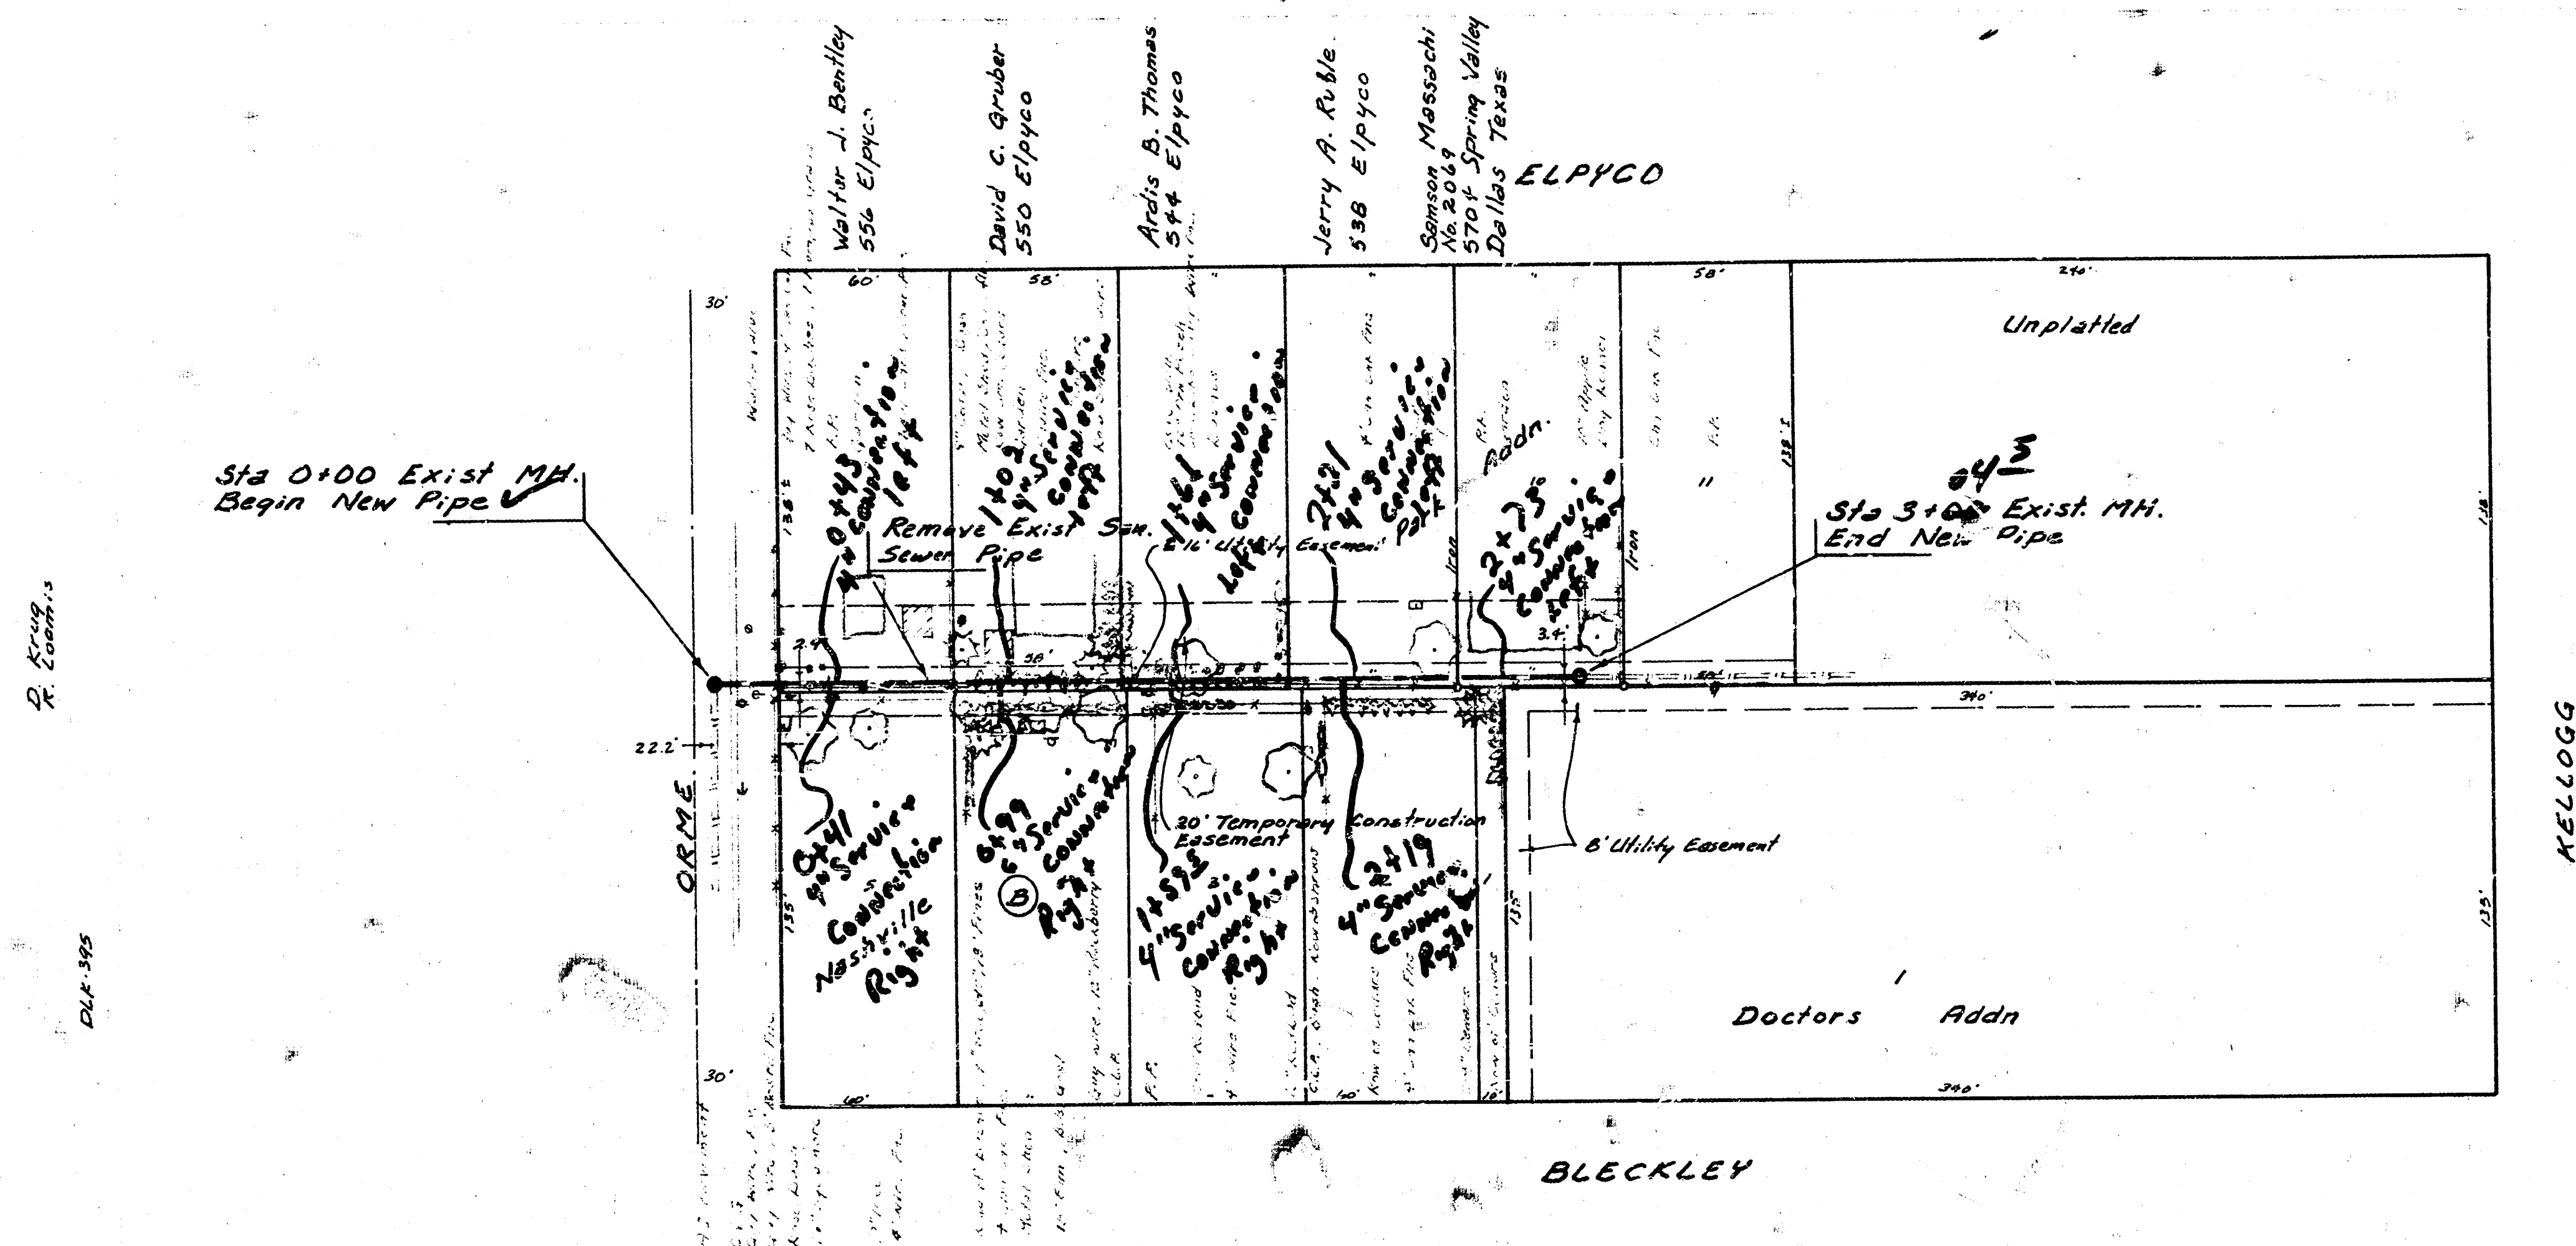


Scale Plan 1" = 40'
 Profile 1" = 40' Horiz.
 1" = 5' Vert.

THE CONTRACTOR SHALL BE RESPONSIBLE FOR PRESERVING PROPERTY LINES. THE CONTRACTOR SHALL BE REQUIRED TO RE-ESTABLISH ANY PROPERTY LINES THAT ARE DAMAGED OR DESTROYED BY HIS CONSTRUCTION OPERATIONS. SUCH LINES SHALL BE RE-ESTABLISHED BY A LICENSED SURVEYOR OR A LICENSED PROFESSIONAL ENGINEER IN ACCORDANCE WITH STATE LAWS.

B.M. 151.61 City Std. on NE Corner of RCBC at Pinecrest and E. Fork of Dry Creek.

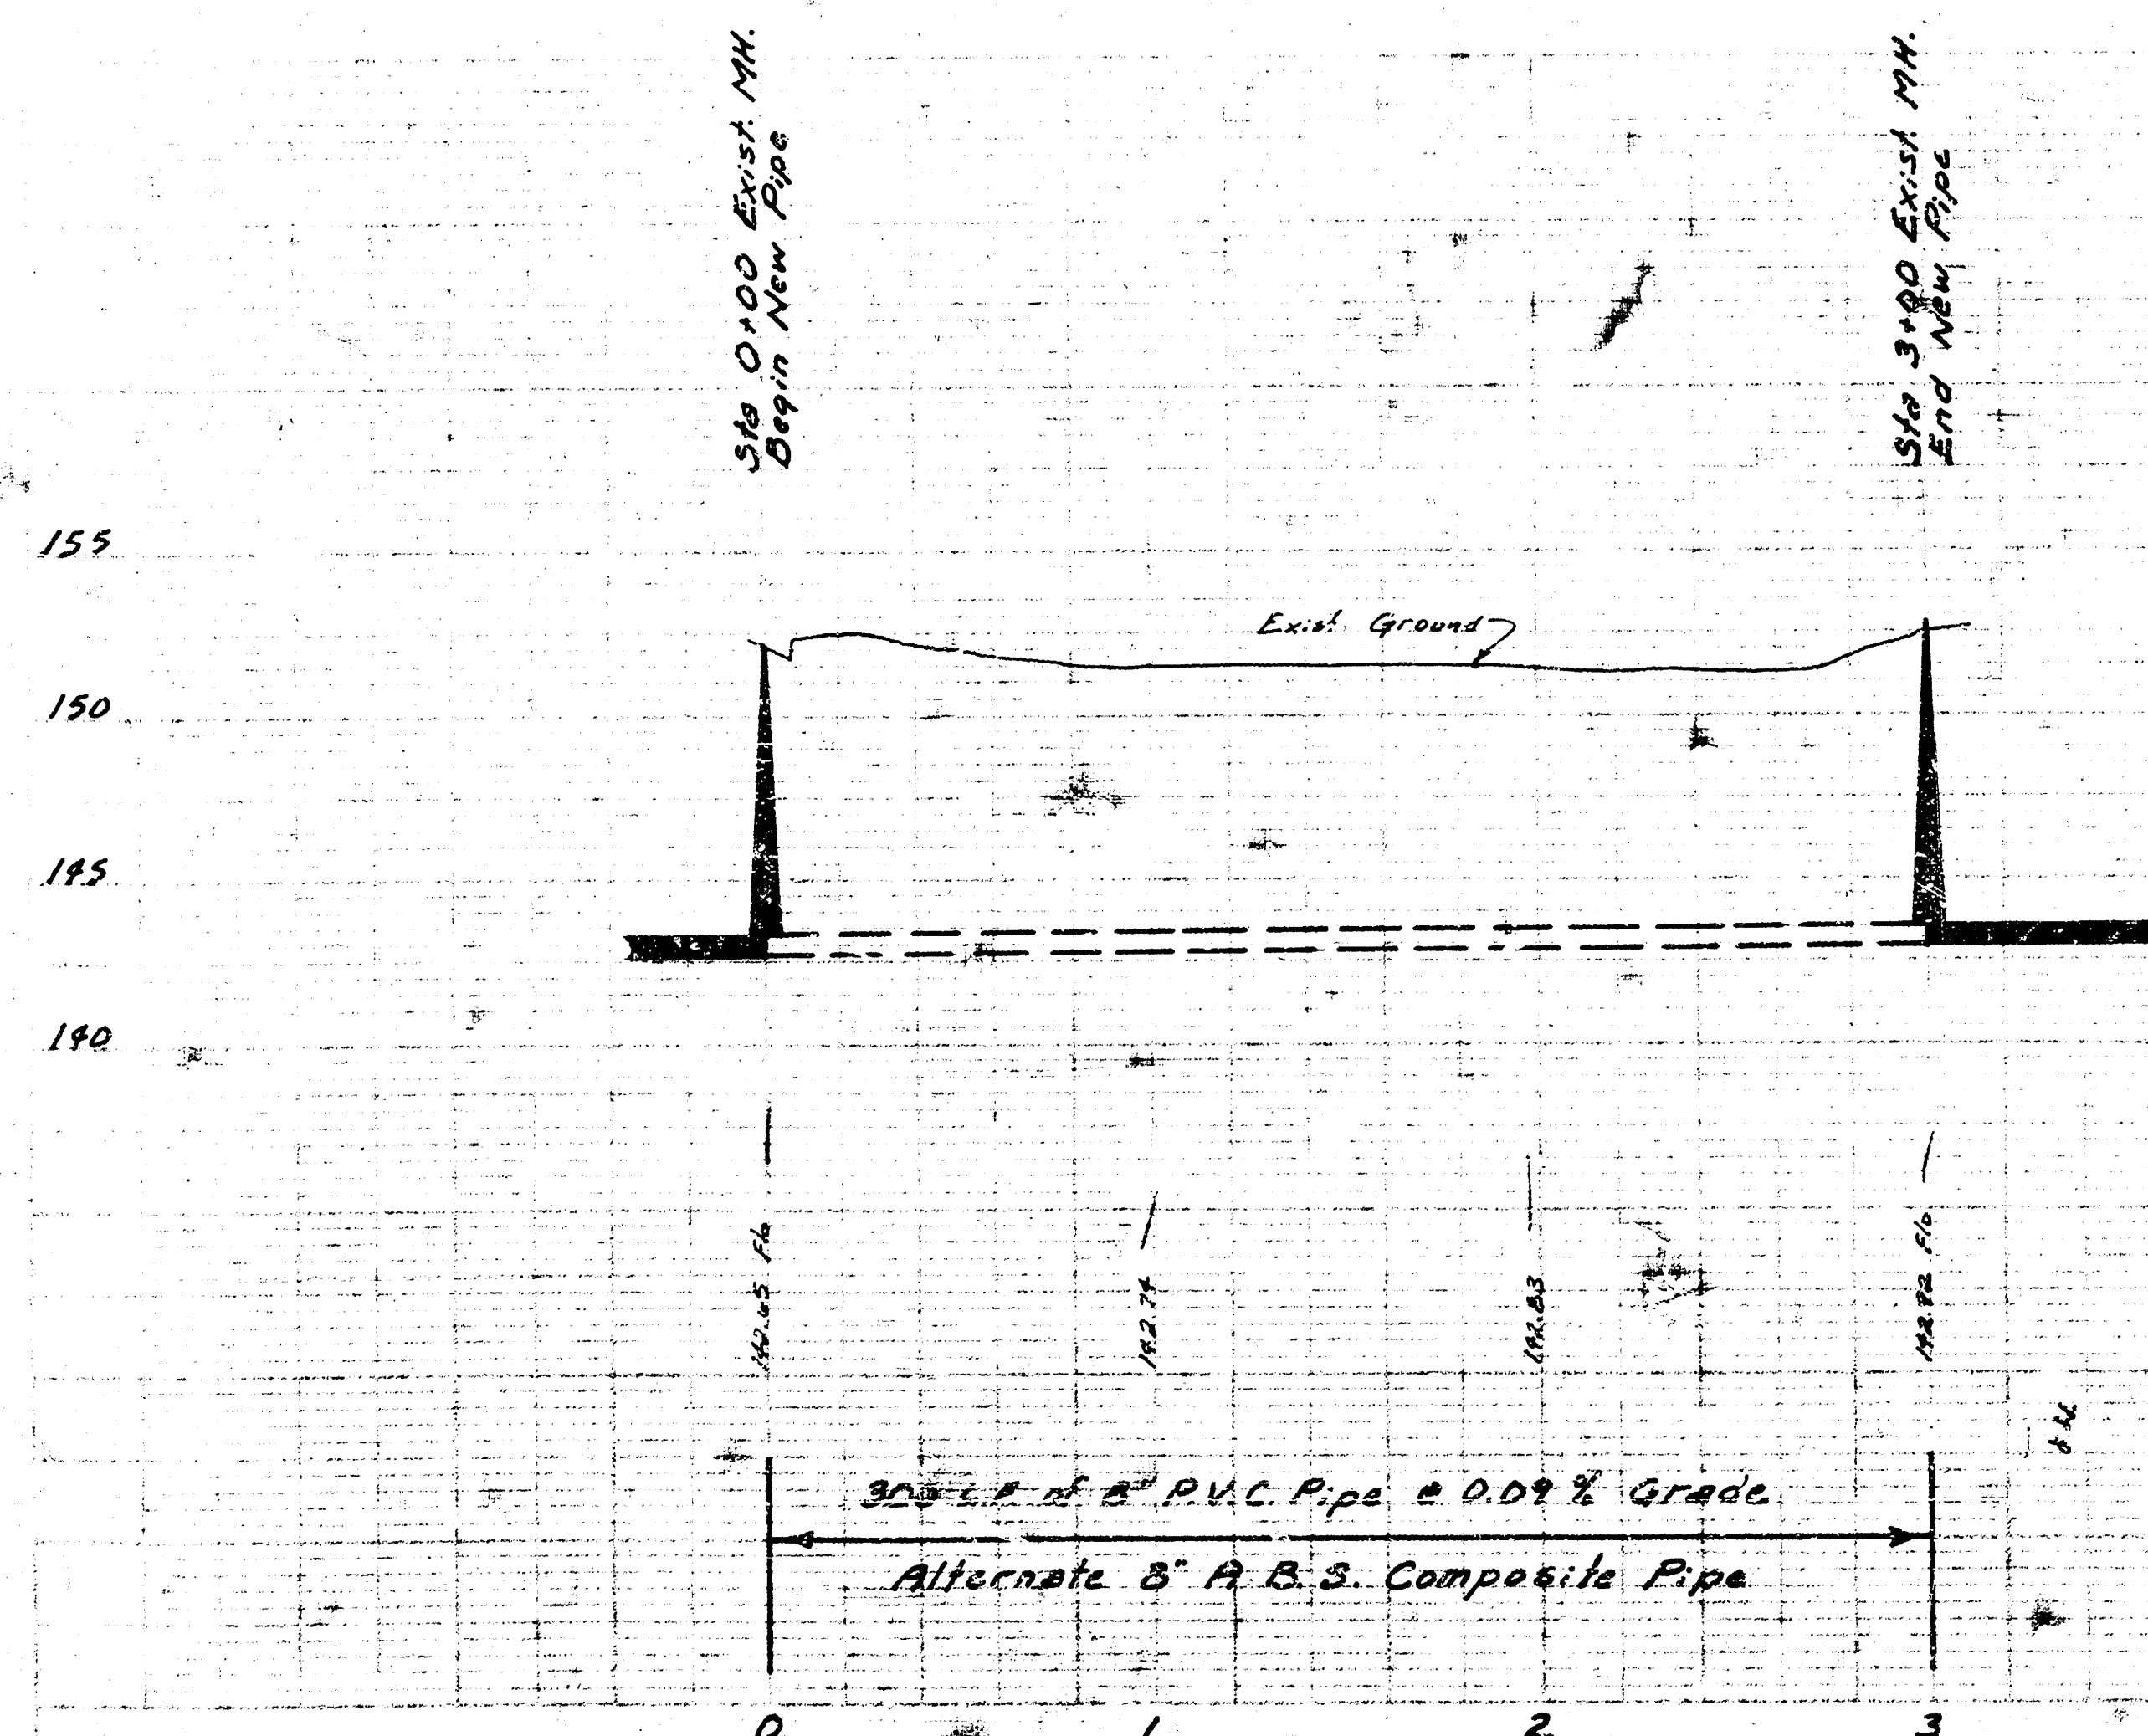

As Built
 8/8
 1/82

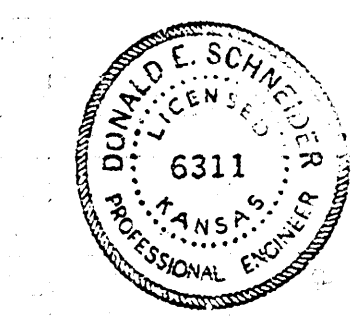

REPAIR OF A PORTION OF LAT 38, DRY CREEK SEWER, S. S. #12 BETWEEN ELPYCO AND BLECKLEY ON THE NORTH SIDE OF ORME CITY OF WICHITA, KANSAS
 R.W. BRUGGEMAN
 DIRECTOR OF ENGINEERING / CITY ENGINEER
 PROJ. NO. 468-76-245-81080-000-000-001