


SCALE PLAN 1" = 40'
PROFILE 1" = 40' HORZ.
1" = 5' VERT.


BM. 178.38 R.R. SPIKE E. FC. P.P. N. SIDE
1ST ST. FIRST POLE W. OF PERSHING

BM. 181.81 R.R. SPIKE E. FC. P.P. S. SIDE
DOUGLAS AVE SECOND P.P. E. OF
TERRACE EXT. S.

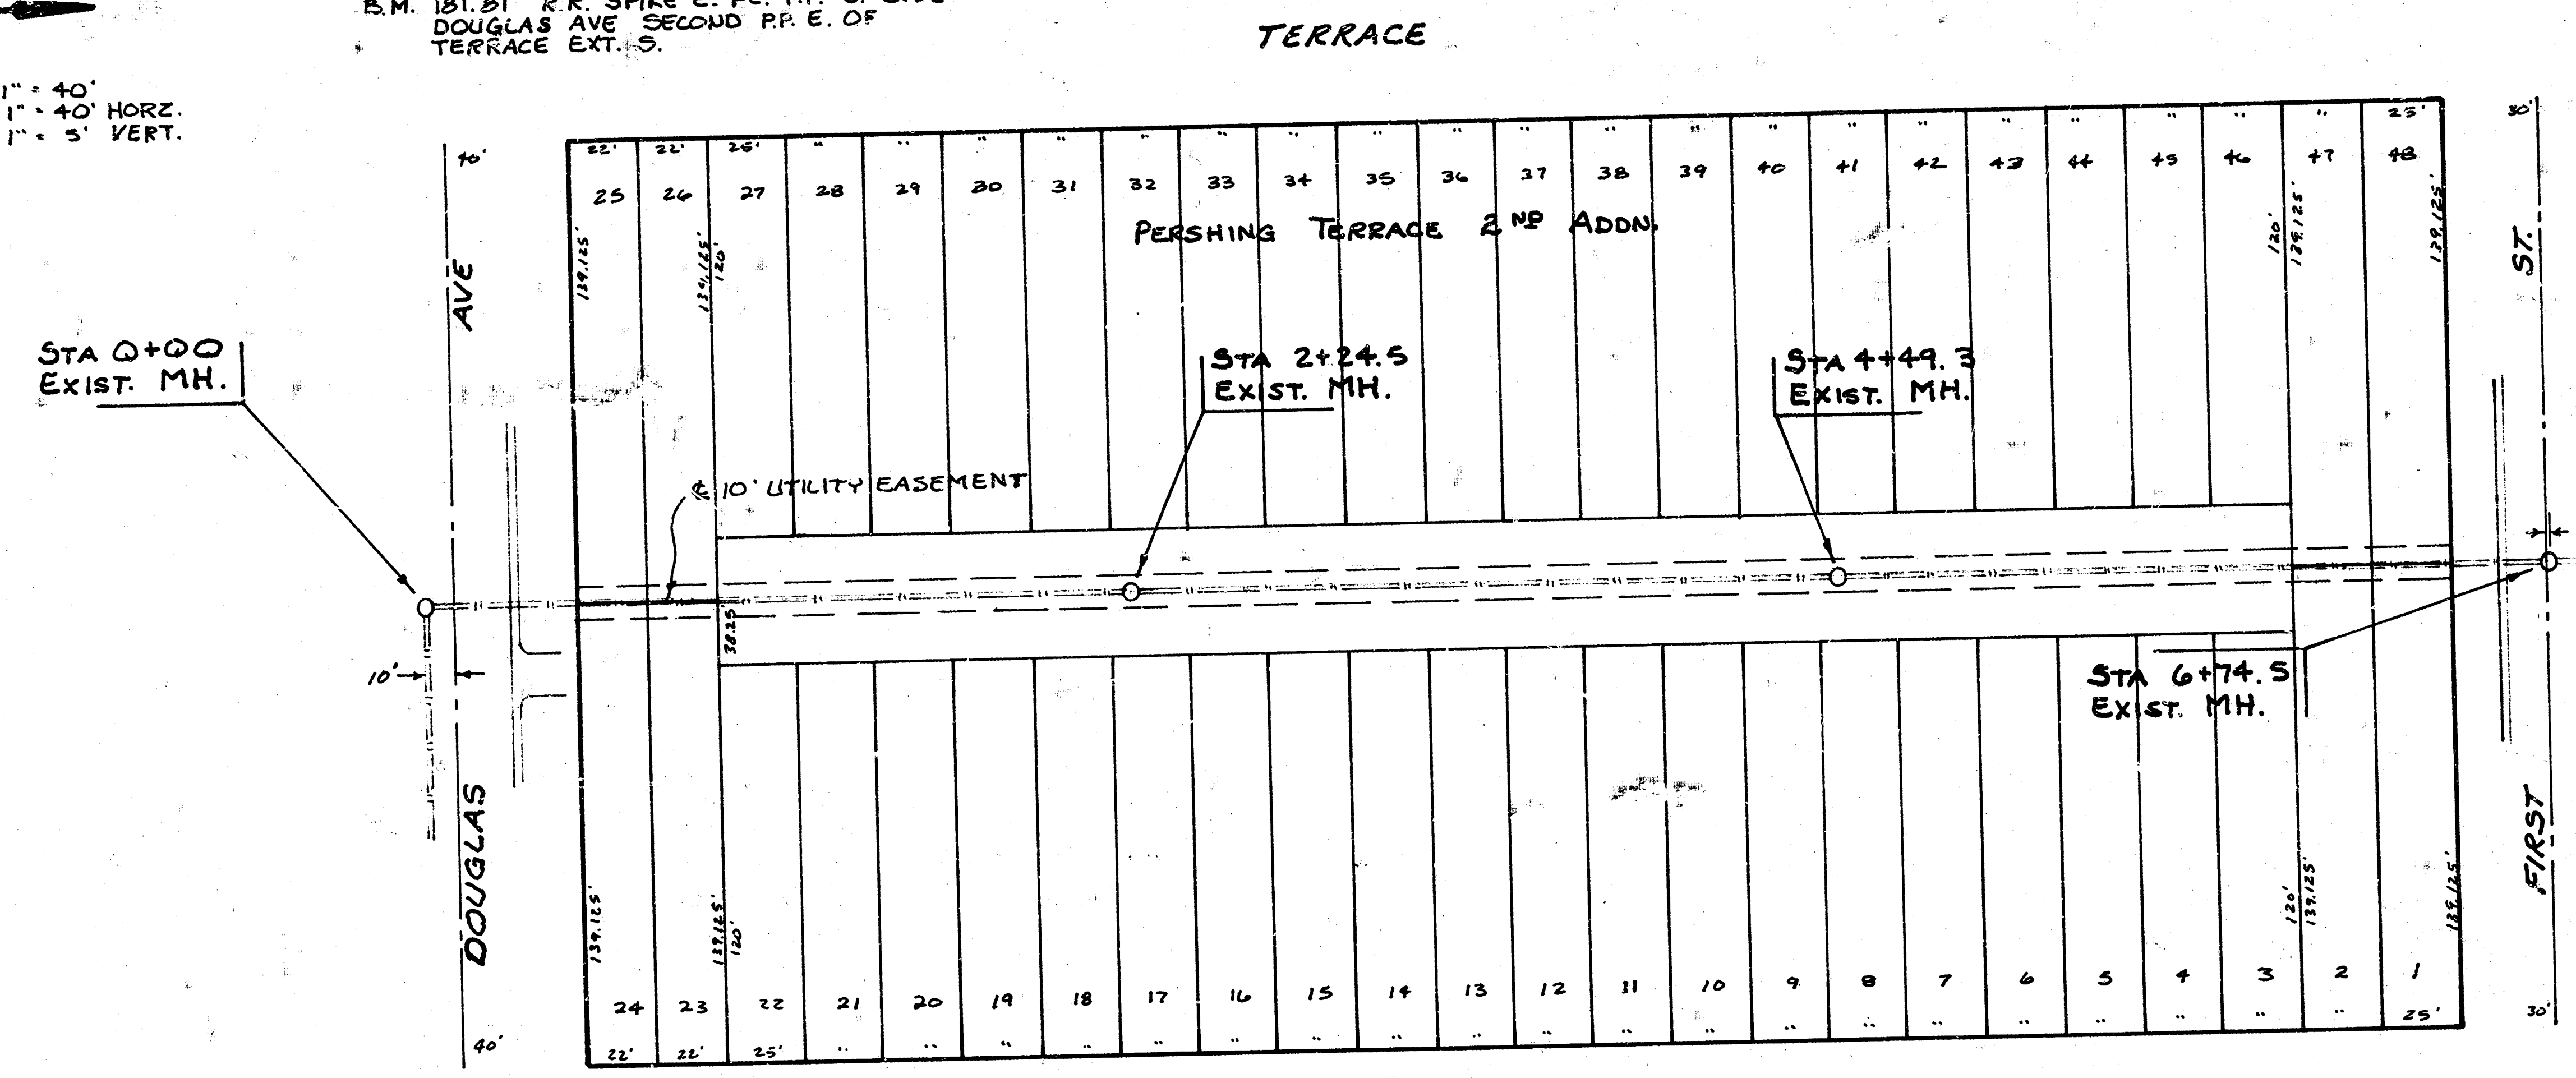

As Built
2-84
~NOTES~

Contractor shall give all property owners and/or tenants directly affected by the construction of this project a minimum advance notice of 7 days prior to starting construction.

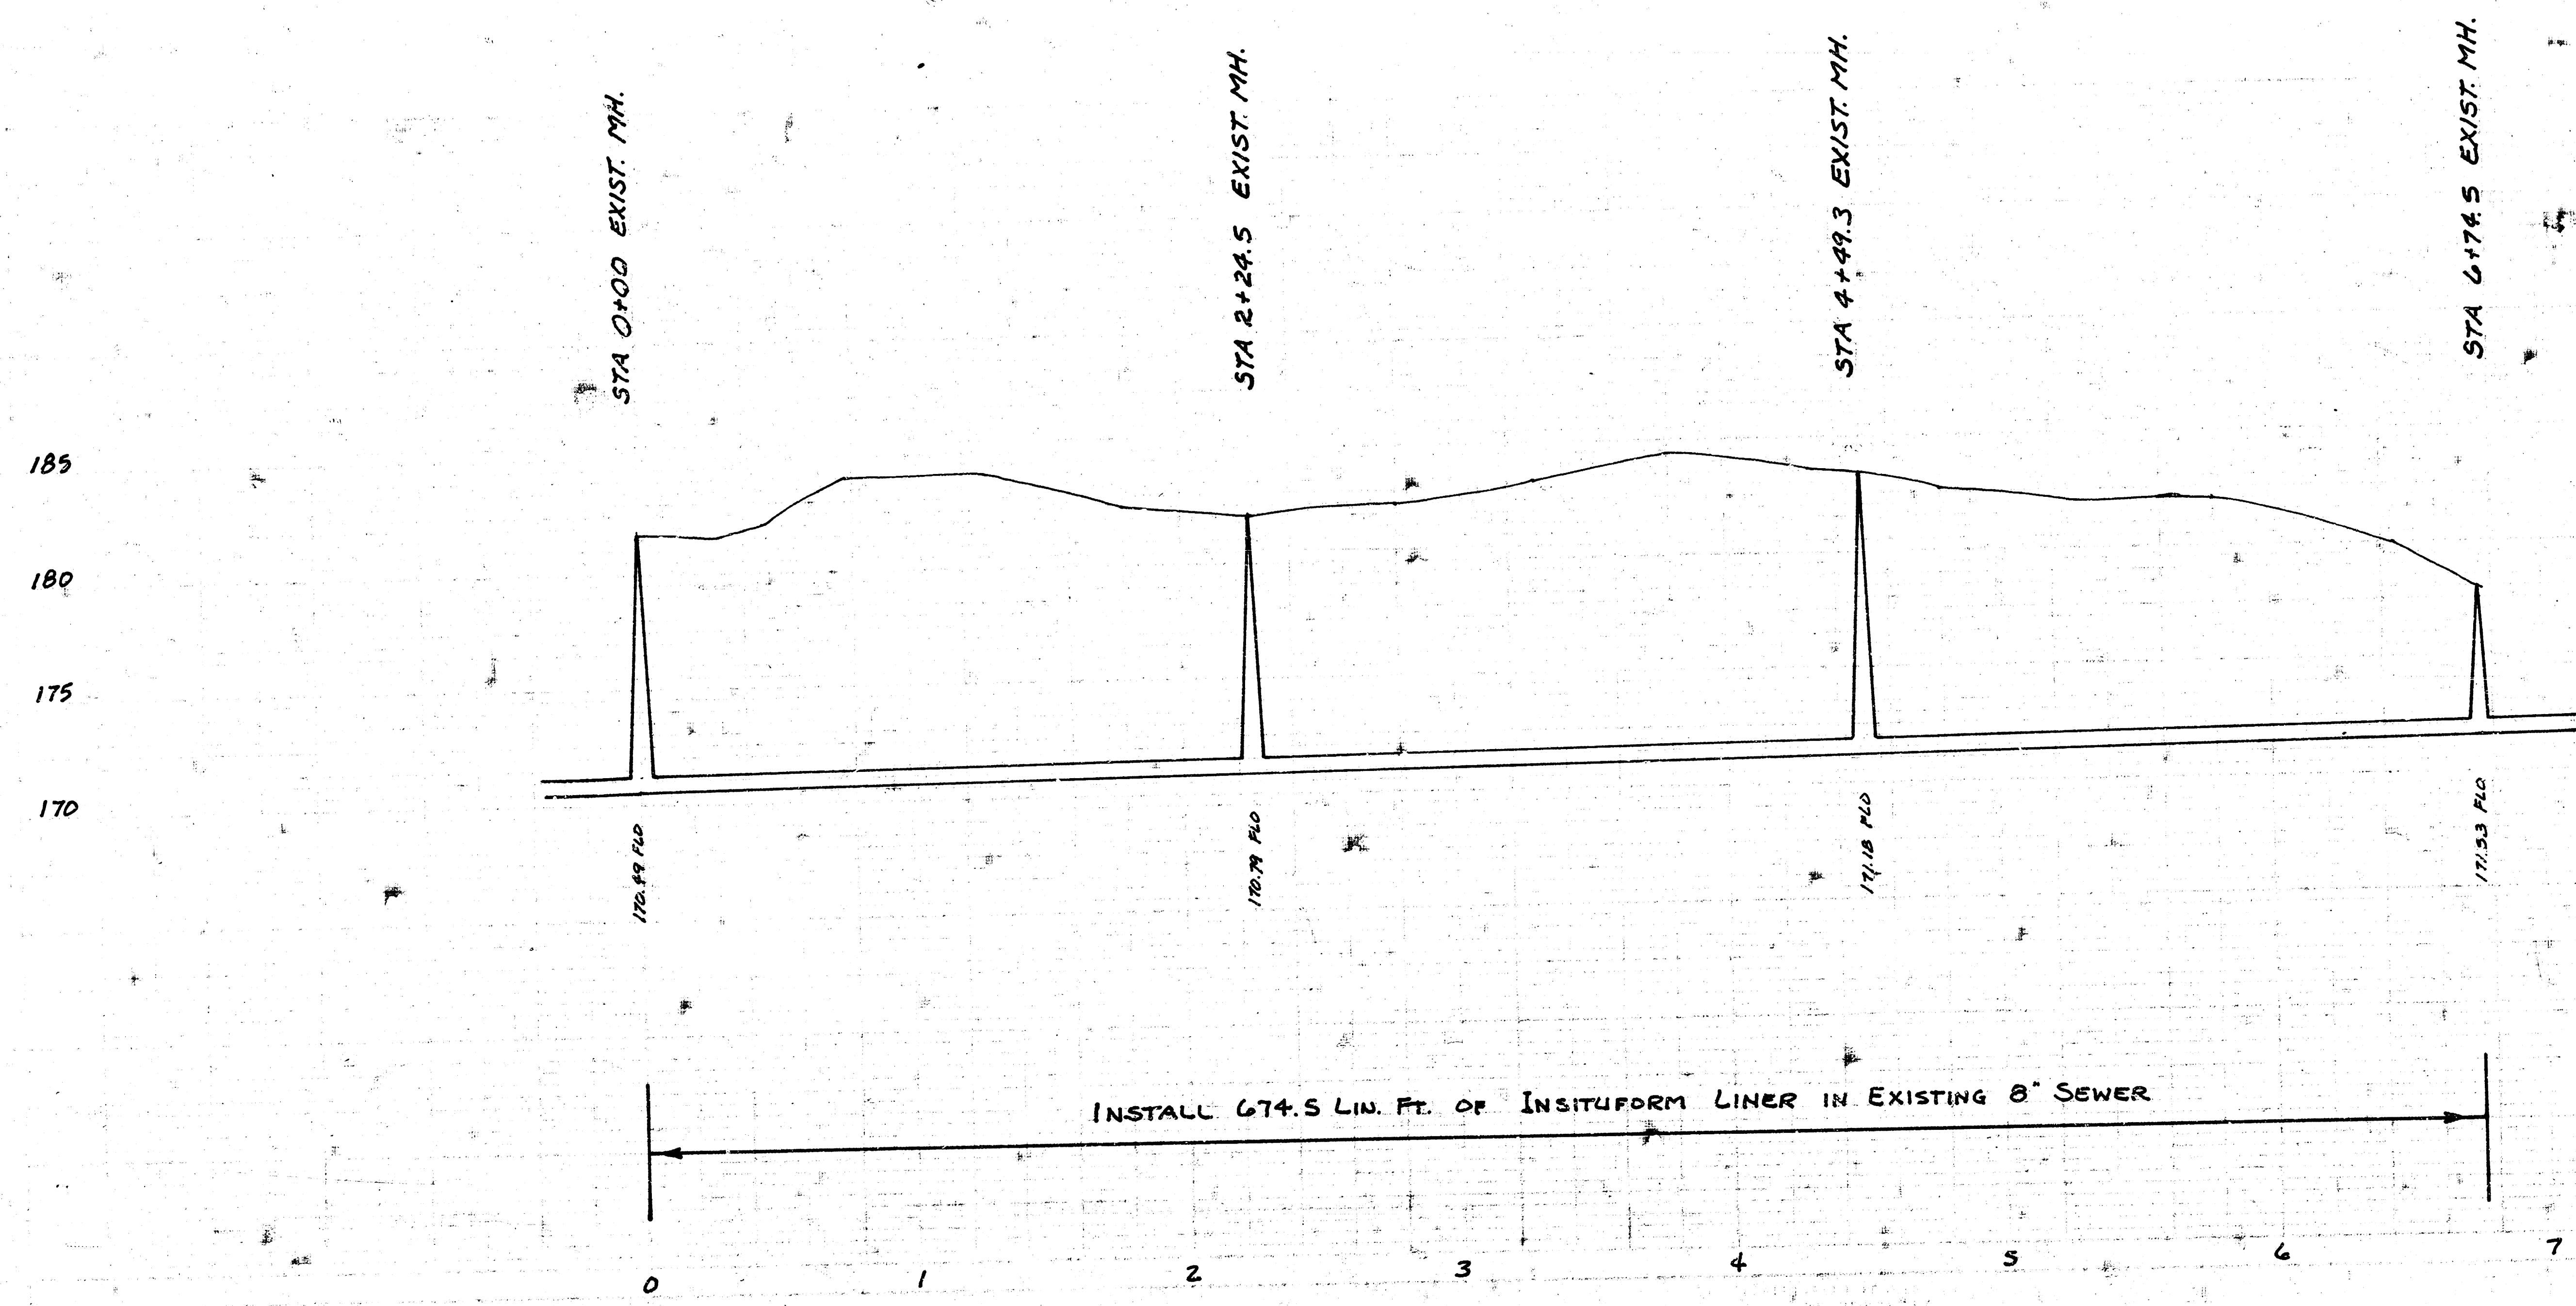

PROJECT DESCRIPTION		
RECONSTRUCT A PORTION OF LAT. 22, DIST. A, S.S. # 12 BETWEEN TERRACE AND PERSHING FROM 1ST TO DOUGLAS		
PROJECT NUMBER		
468-76-245-81302-000-000-001		
BOOK NO. MG-41	APPROVED BY	DATE 9-83
DRAWN BY LCOMIS		REVISED
CITY OF WICHITA DEPARTMENT OF ENGINEERING		
DIRECTOR OF ENG./CITY ENGINEER R. W. BRUGSEMAN		SCALE 1/1

12 0 3 8