



Scale
 Plan Profile 1" = 40'
 Vertical Horizontal 1" = 5'
 1" = 40'


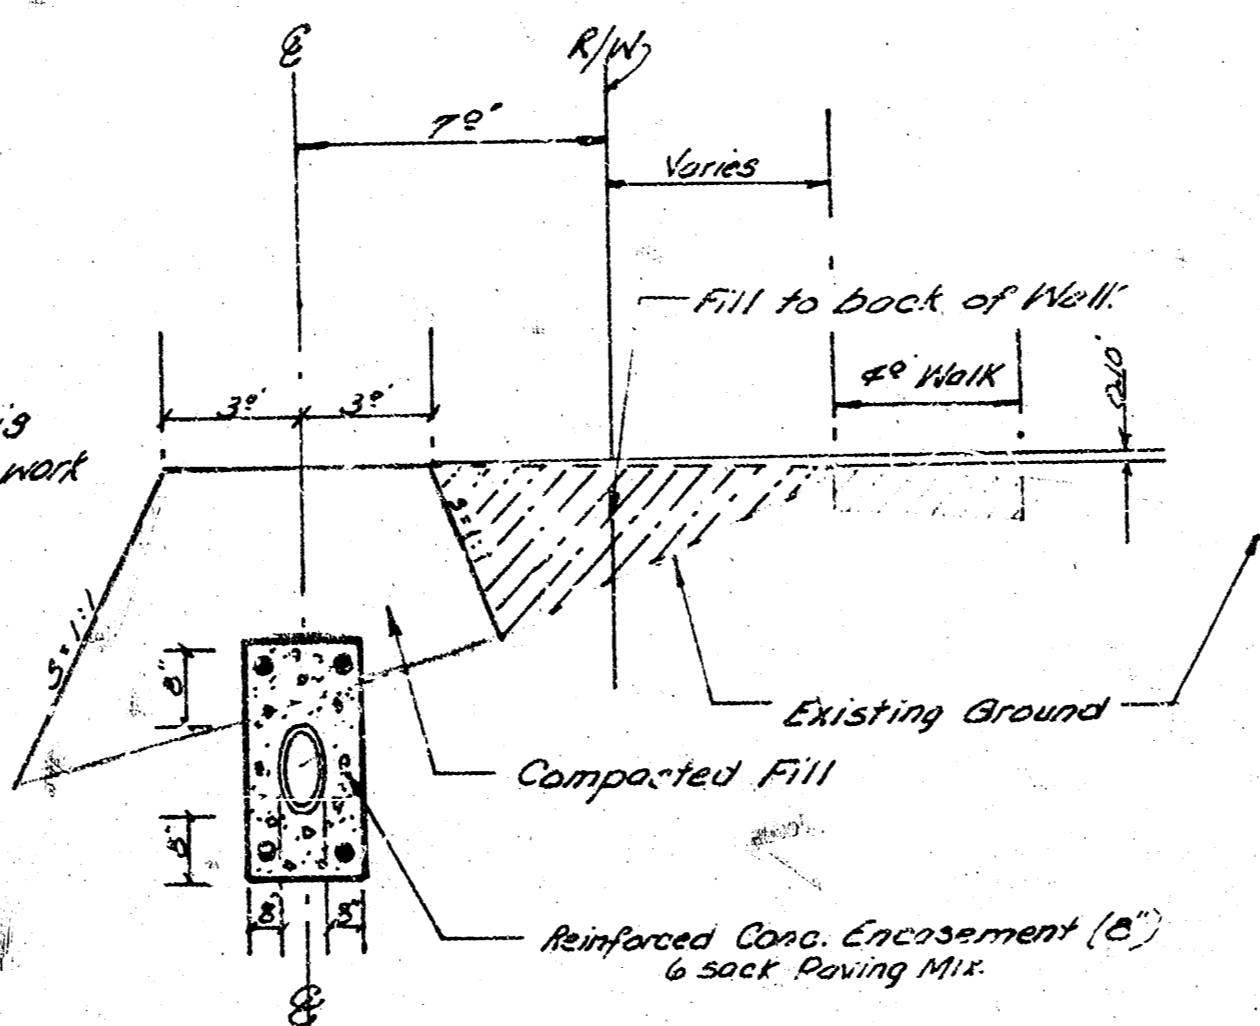


B.M. 94.76 RR Spk. W.S. R.P. & S.H. cor. Lot 2, B.K.D. Wallace Add'n.

Field Engineer to make 'ties' to all property irons, any irons disturbed or destroyed are to be replaced. Ties are not to be removed.

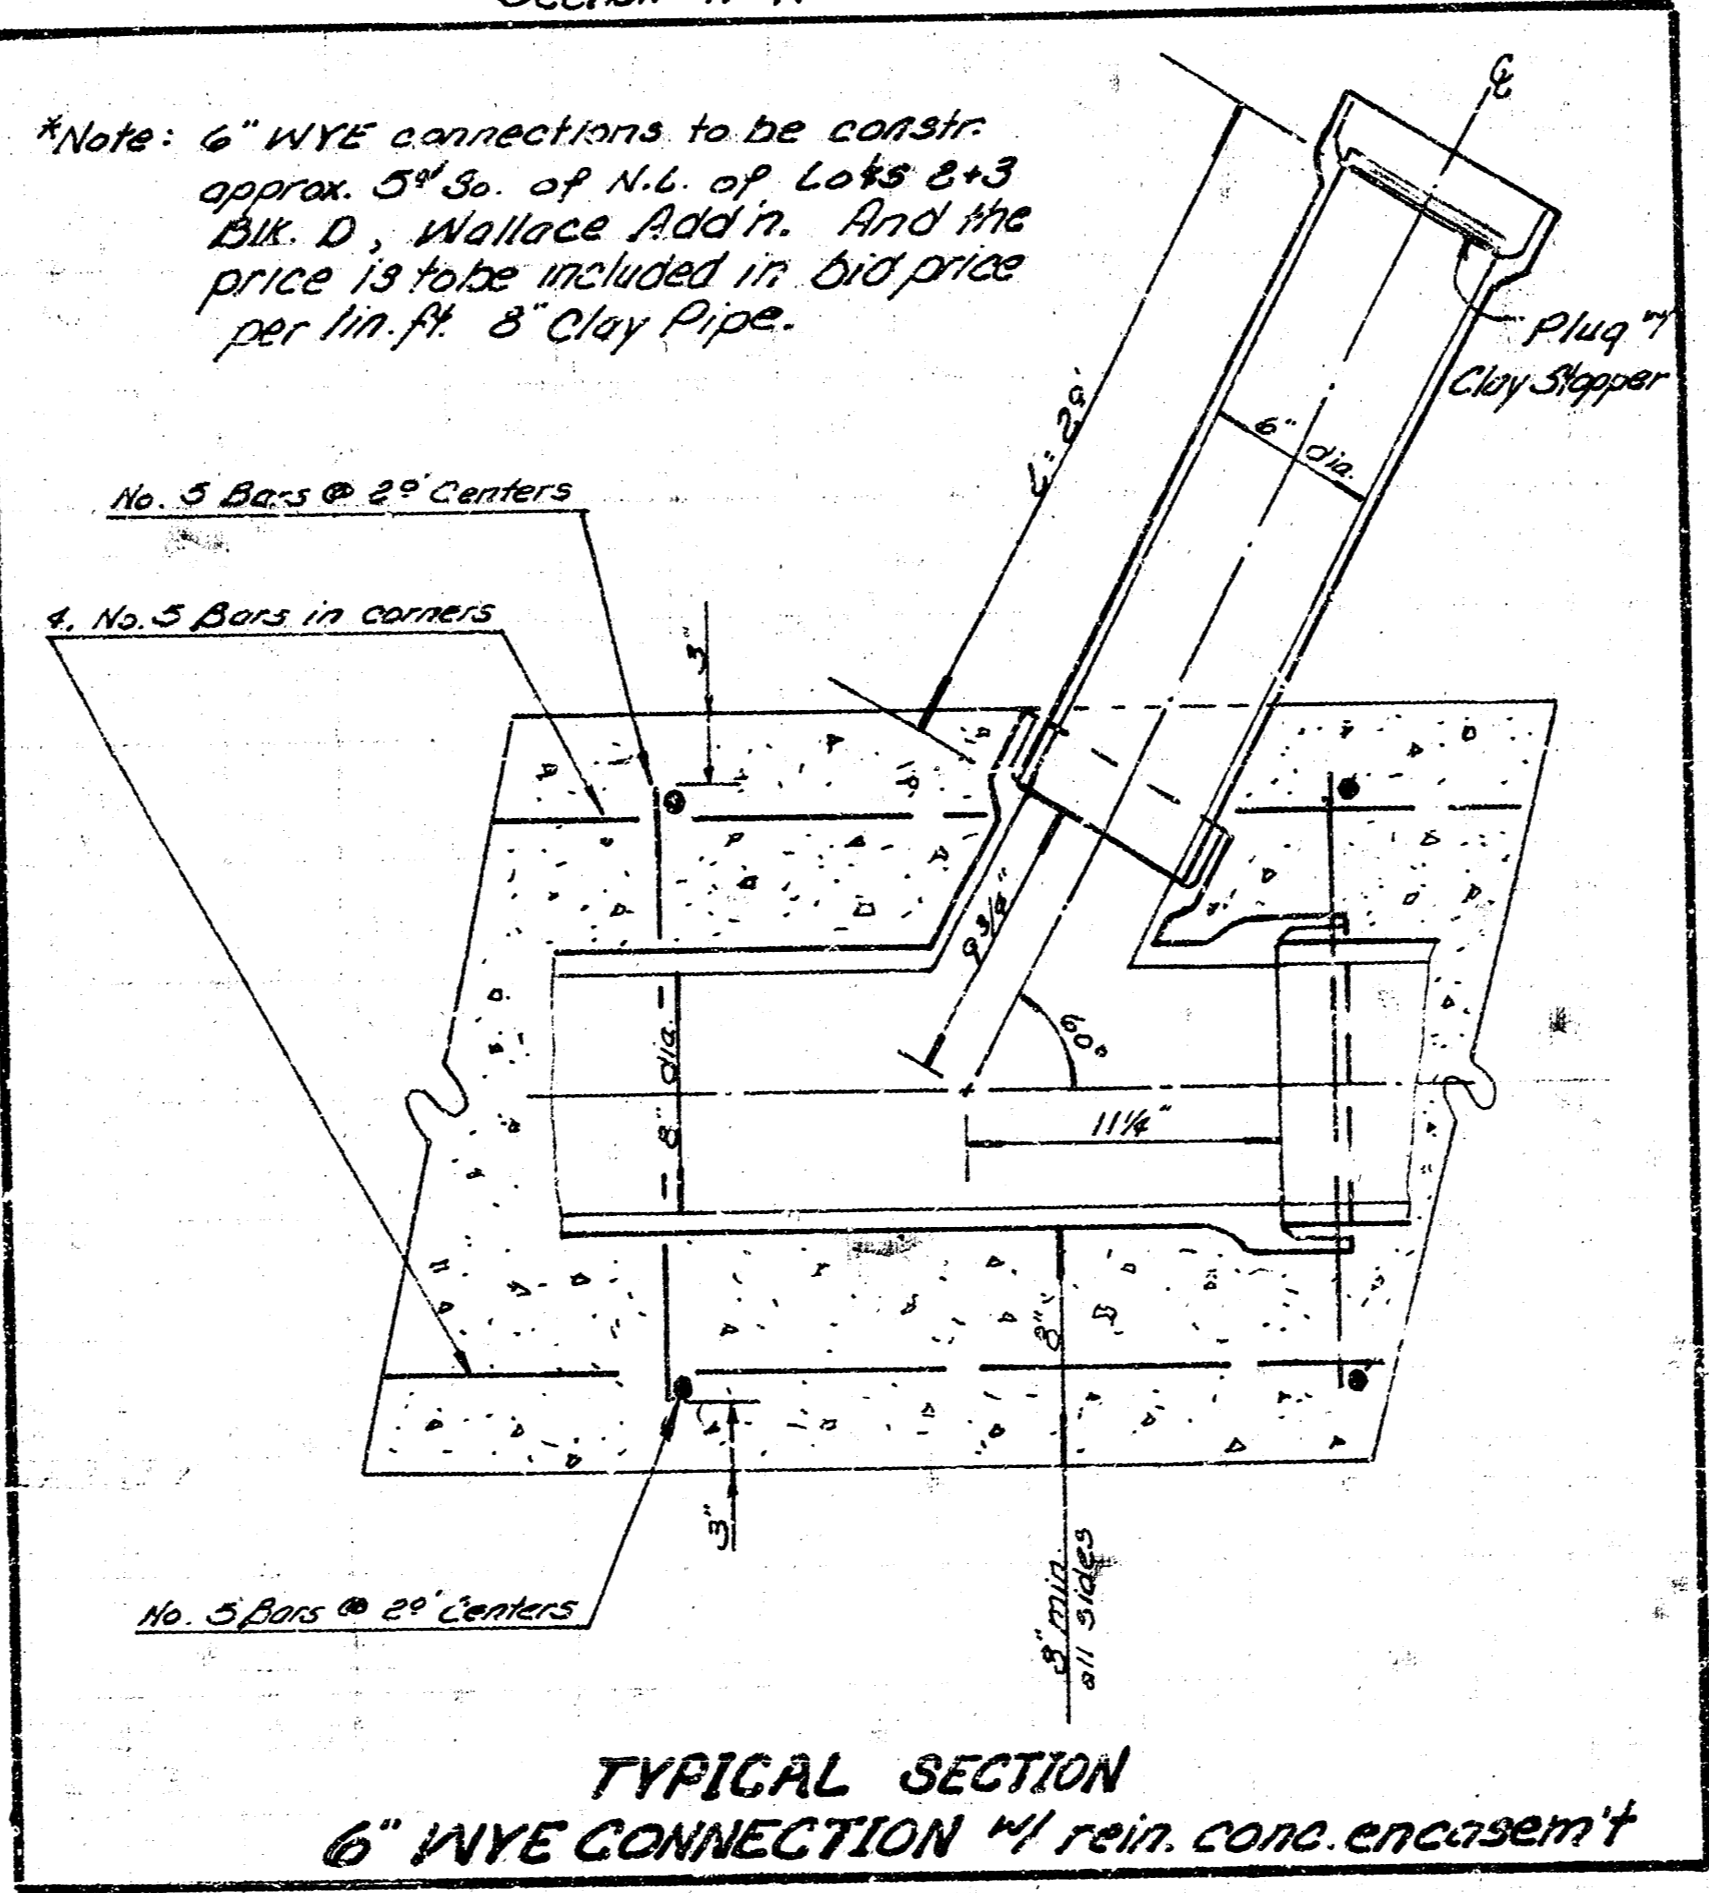

TYPICAL SECTION
 6" WYE CONNECTION w/ rein. conc. encasement
 As built 1-7-77

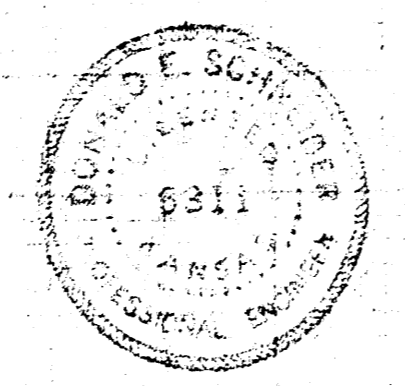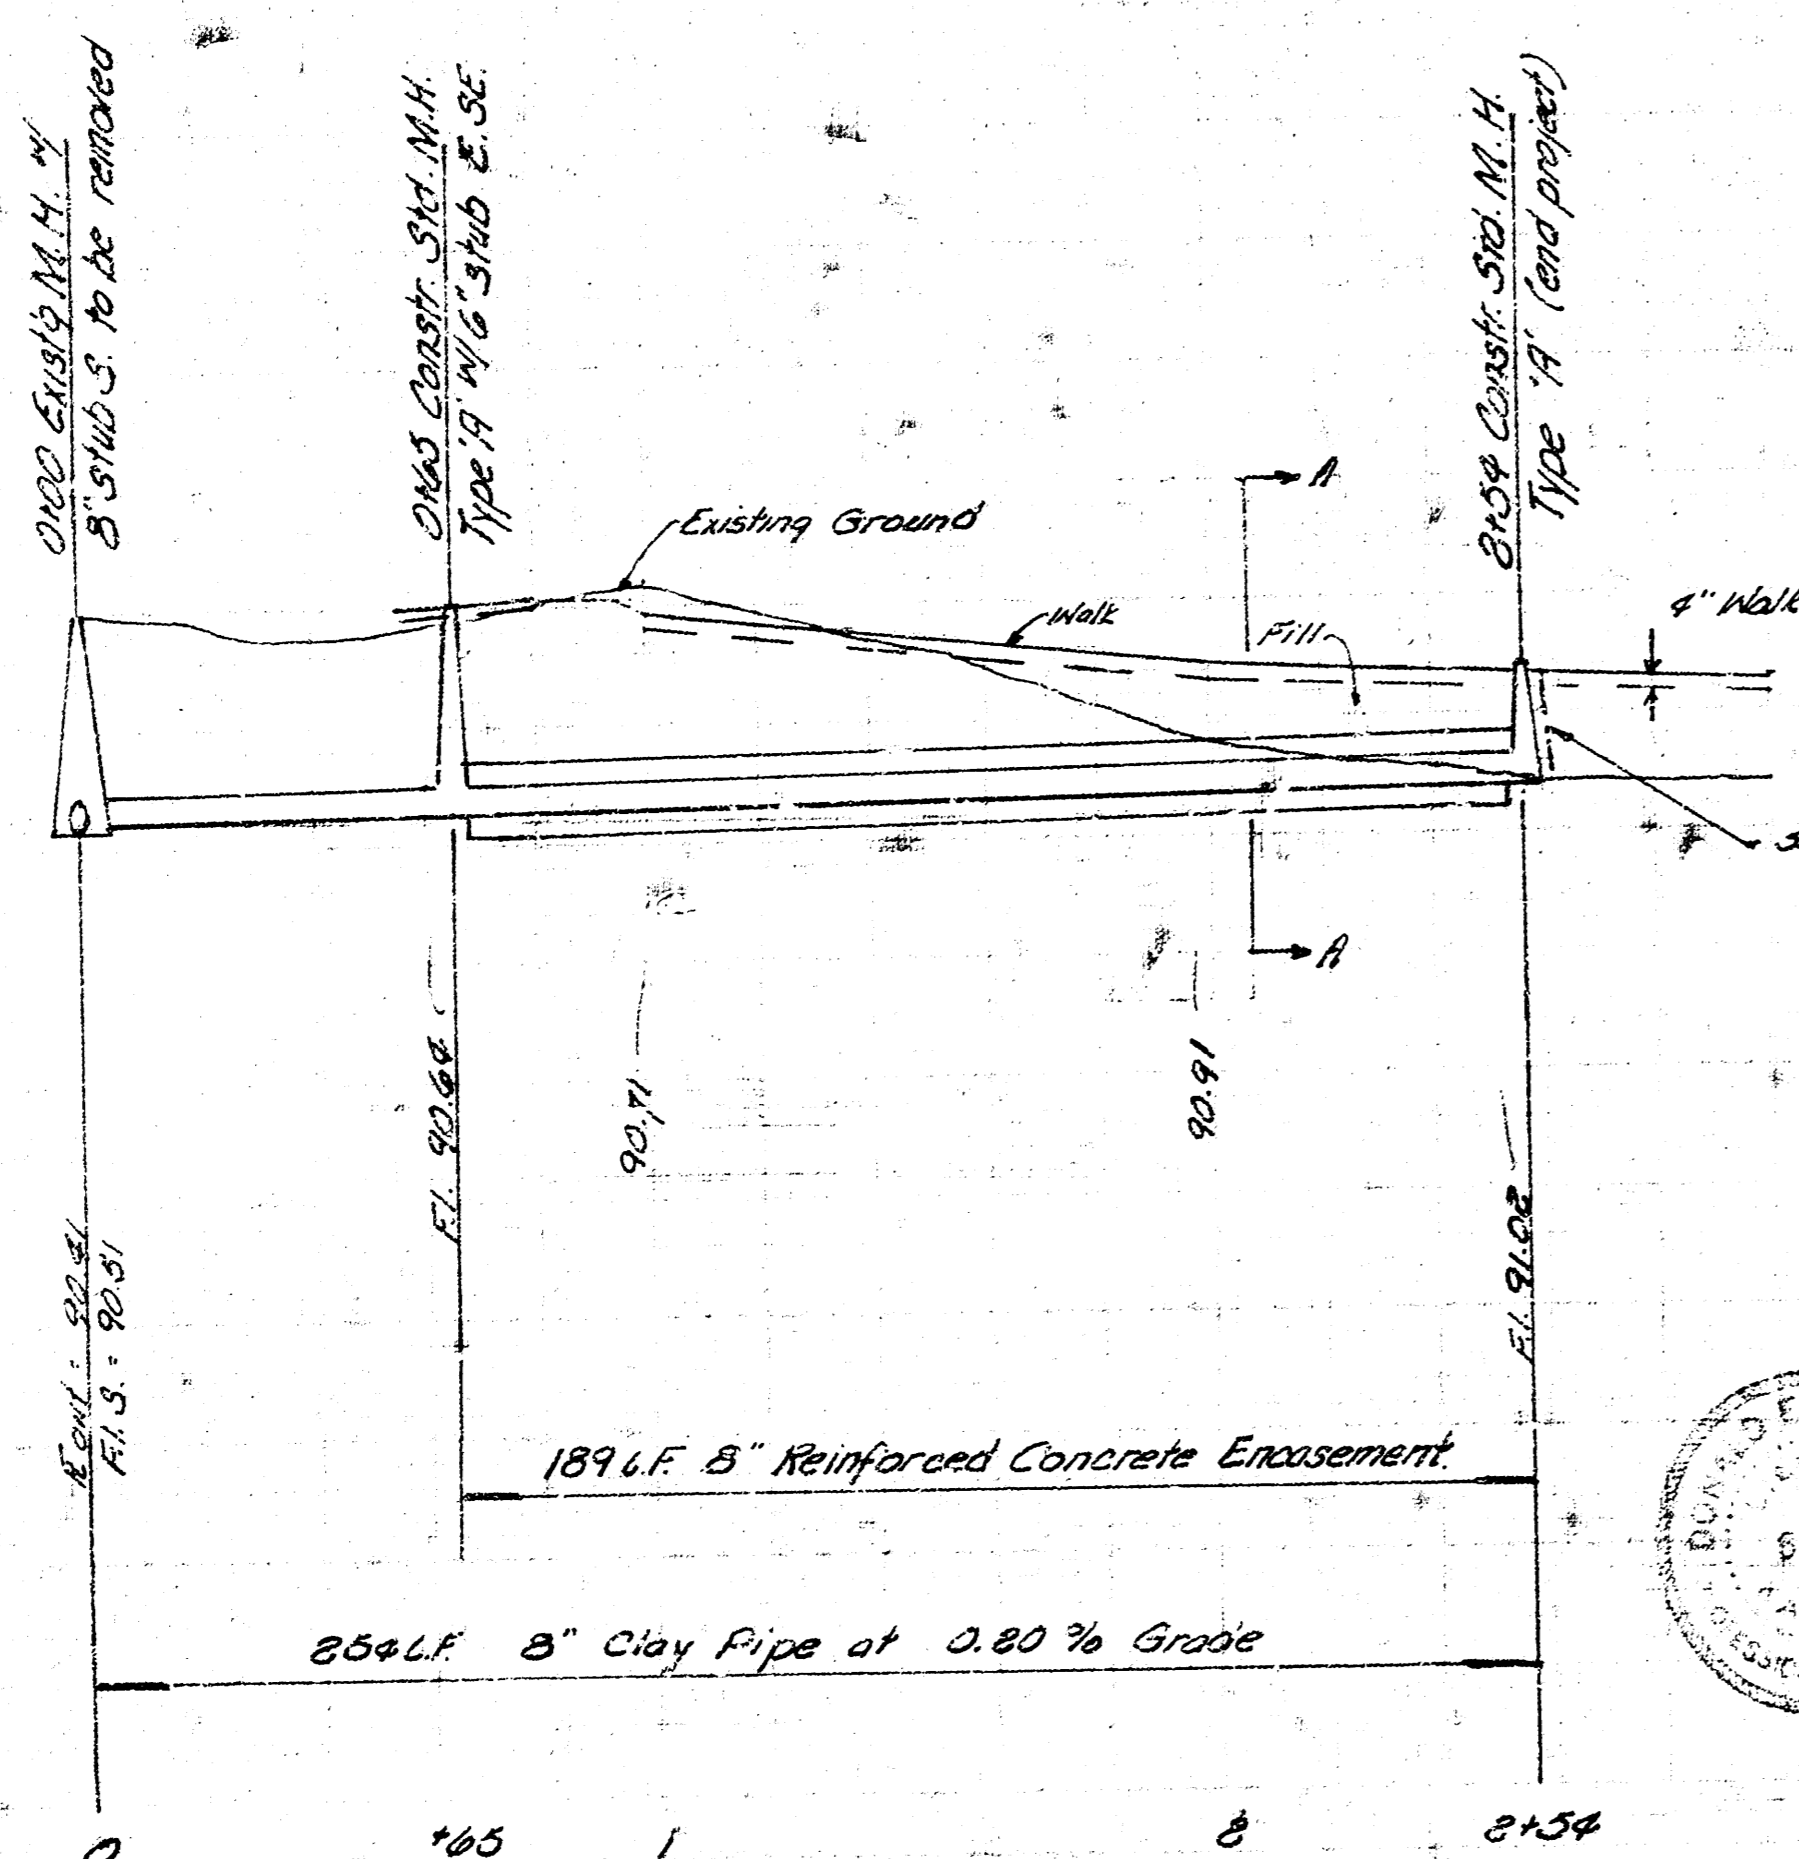

Lateral 23 Dist. AS S.S. #12
 South of Glen Oak Dr. & East of Spruce St. for Lots 2,3 Block 'D'
 WALLACE ADDITION
CITY OF WICHITA, KANSAS
 P. W. LINN CITY ENGINEER
 Date: October 1977 Project Number: DBML576044