



PLAN SCALE 1" = 40'
 PROFILE SCALE 1" = 40' HOR, 1" = 4' VERTICAL

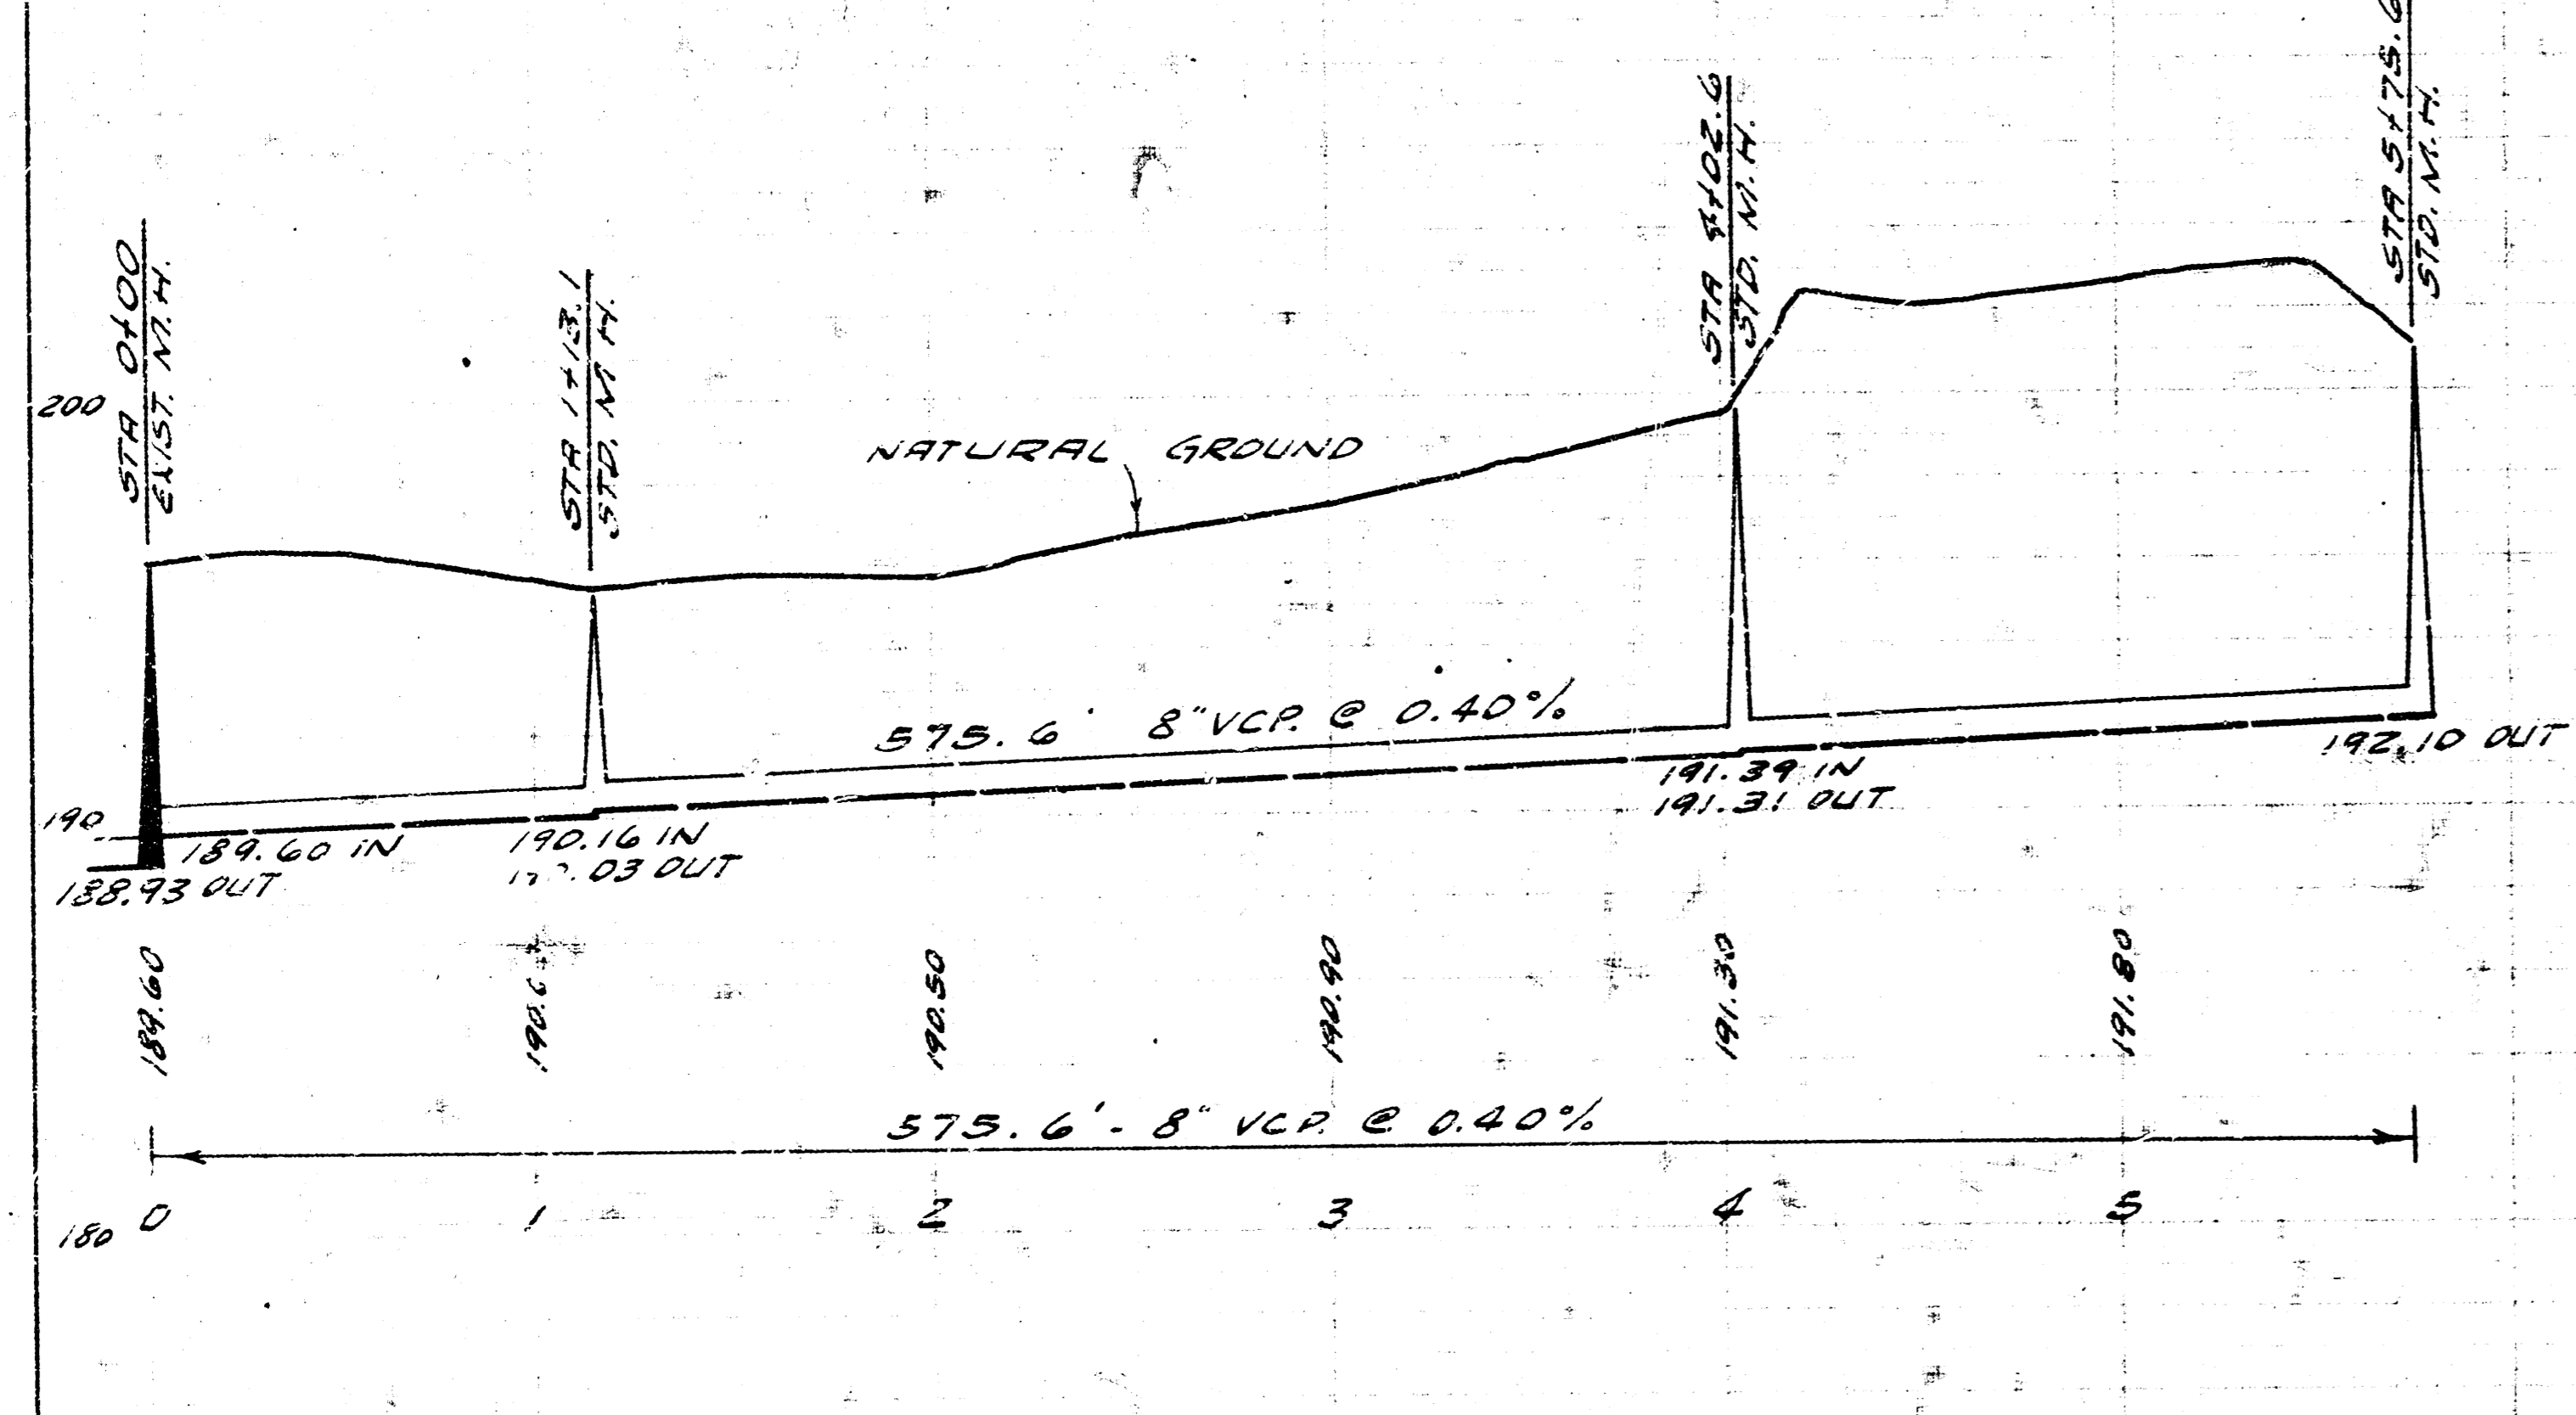


AS BUILT PLANS

EXT. OF LAT. 7 55 23 FOR
 WICHITA UNIVERSITY
 CITY OF WICHITA, KANSAS
 B.E. SMITH CITY ENGINEER
 PRIVATE JOB AUG., 1960

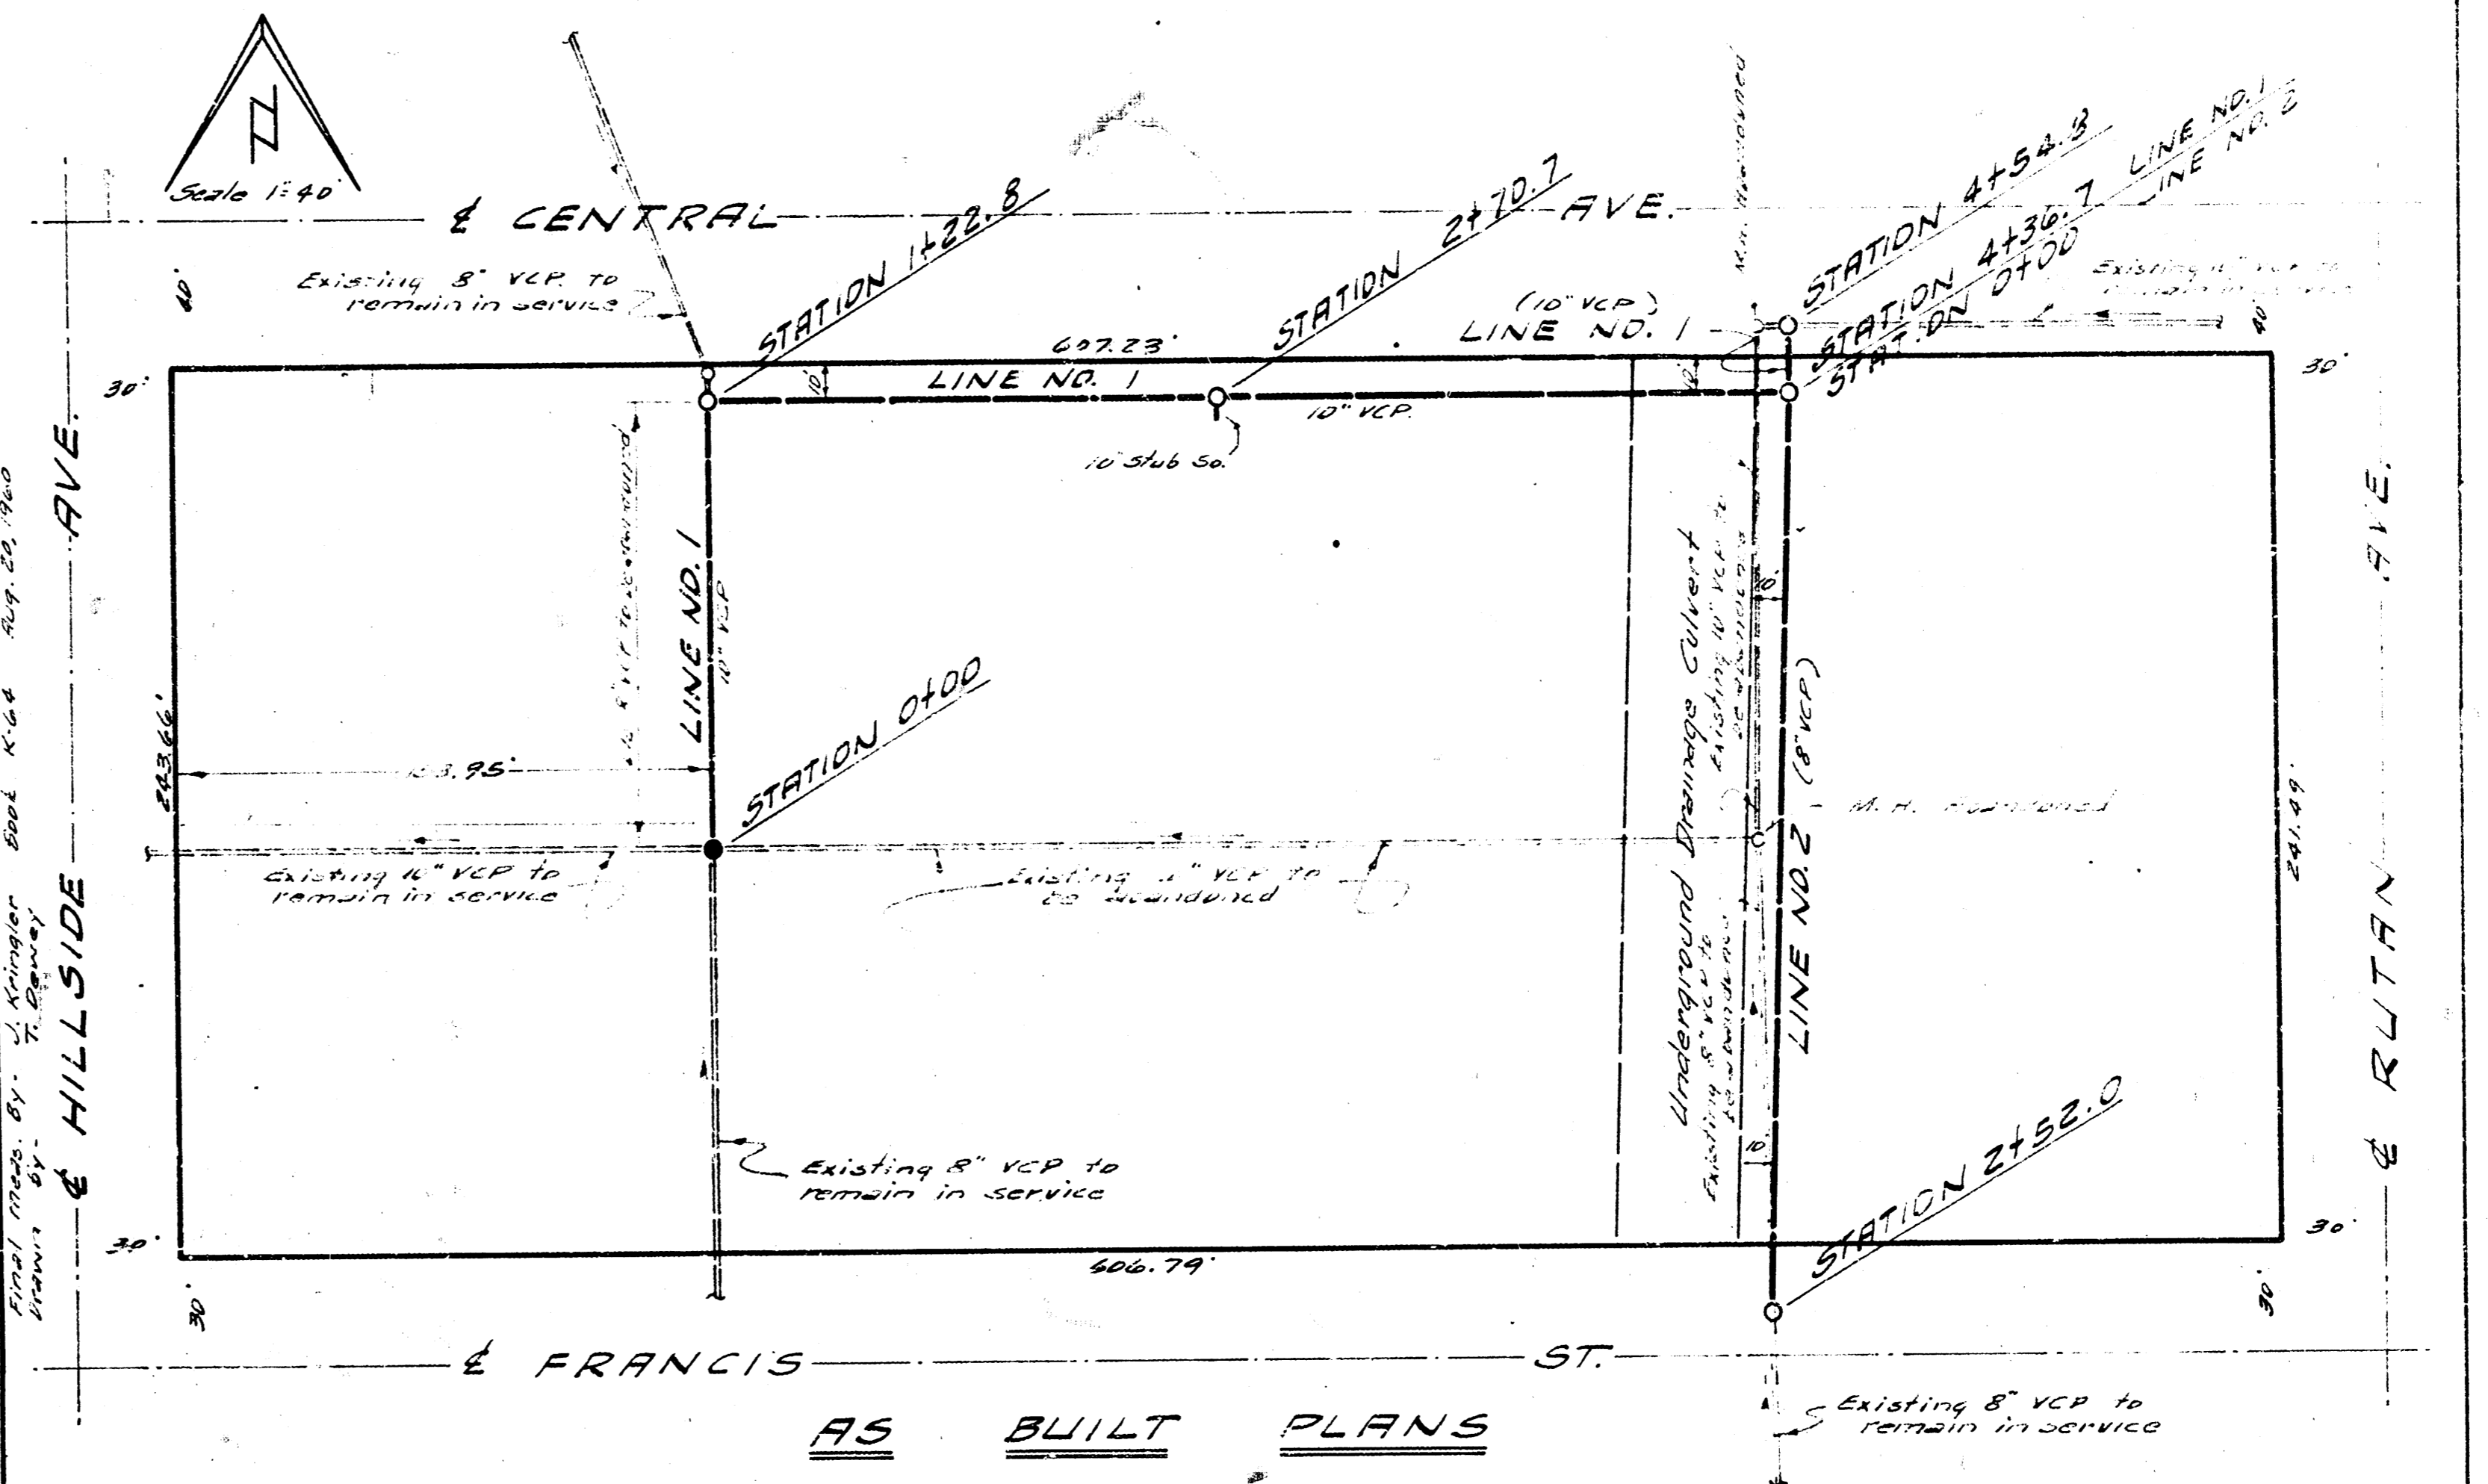

PLAN SCALE 1" = 40'
 PROFILE SCALE 1" = 40' HOR, 1" = 4' VERTICAL

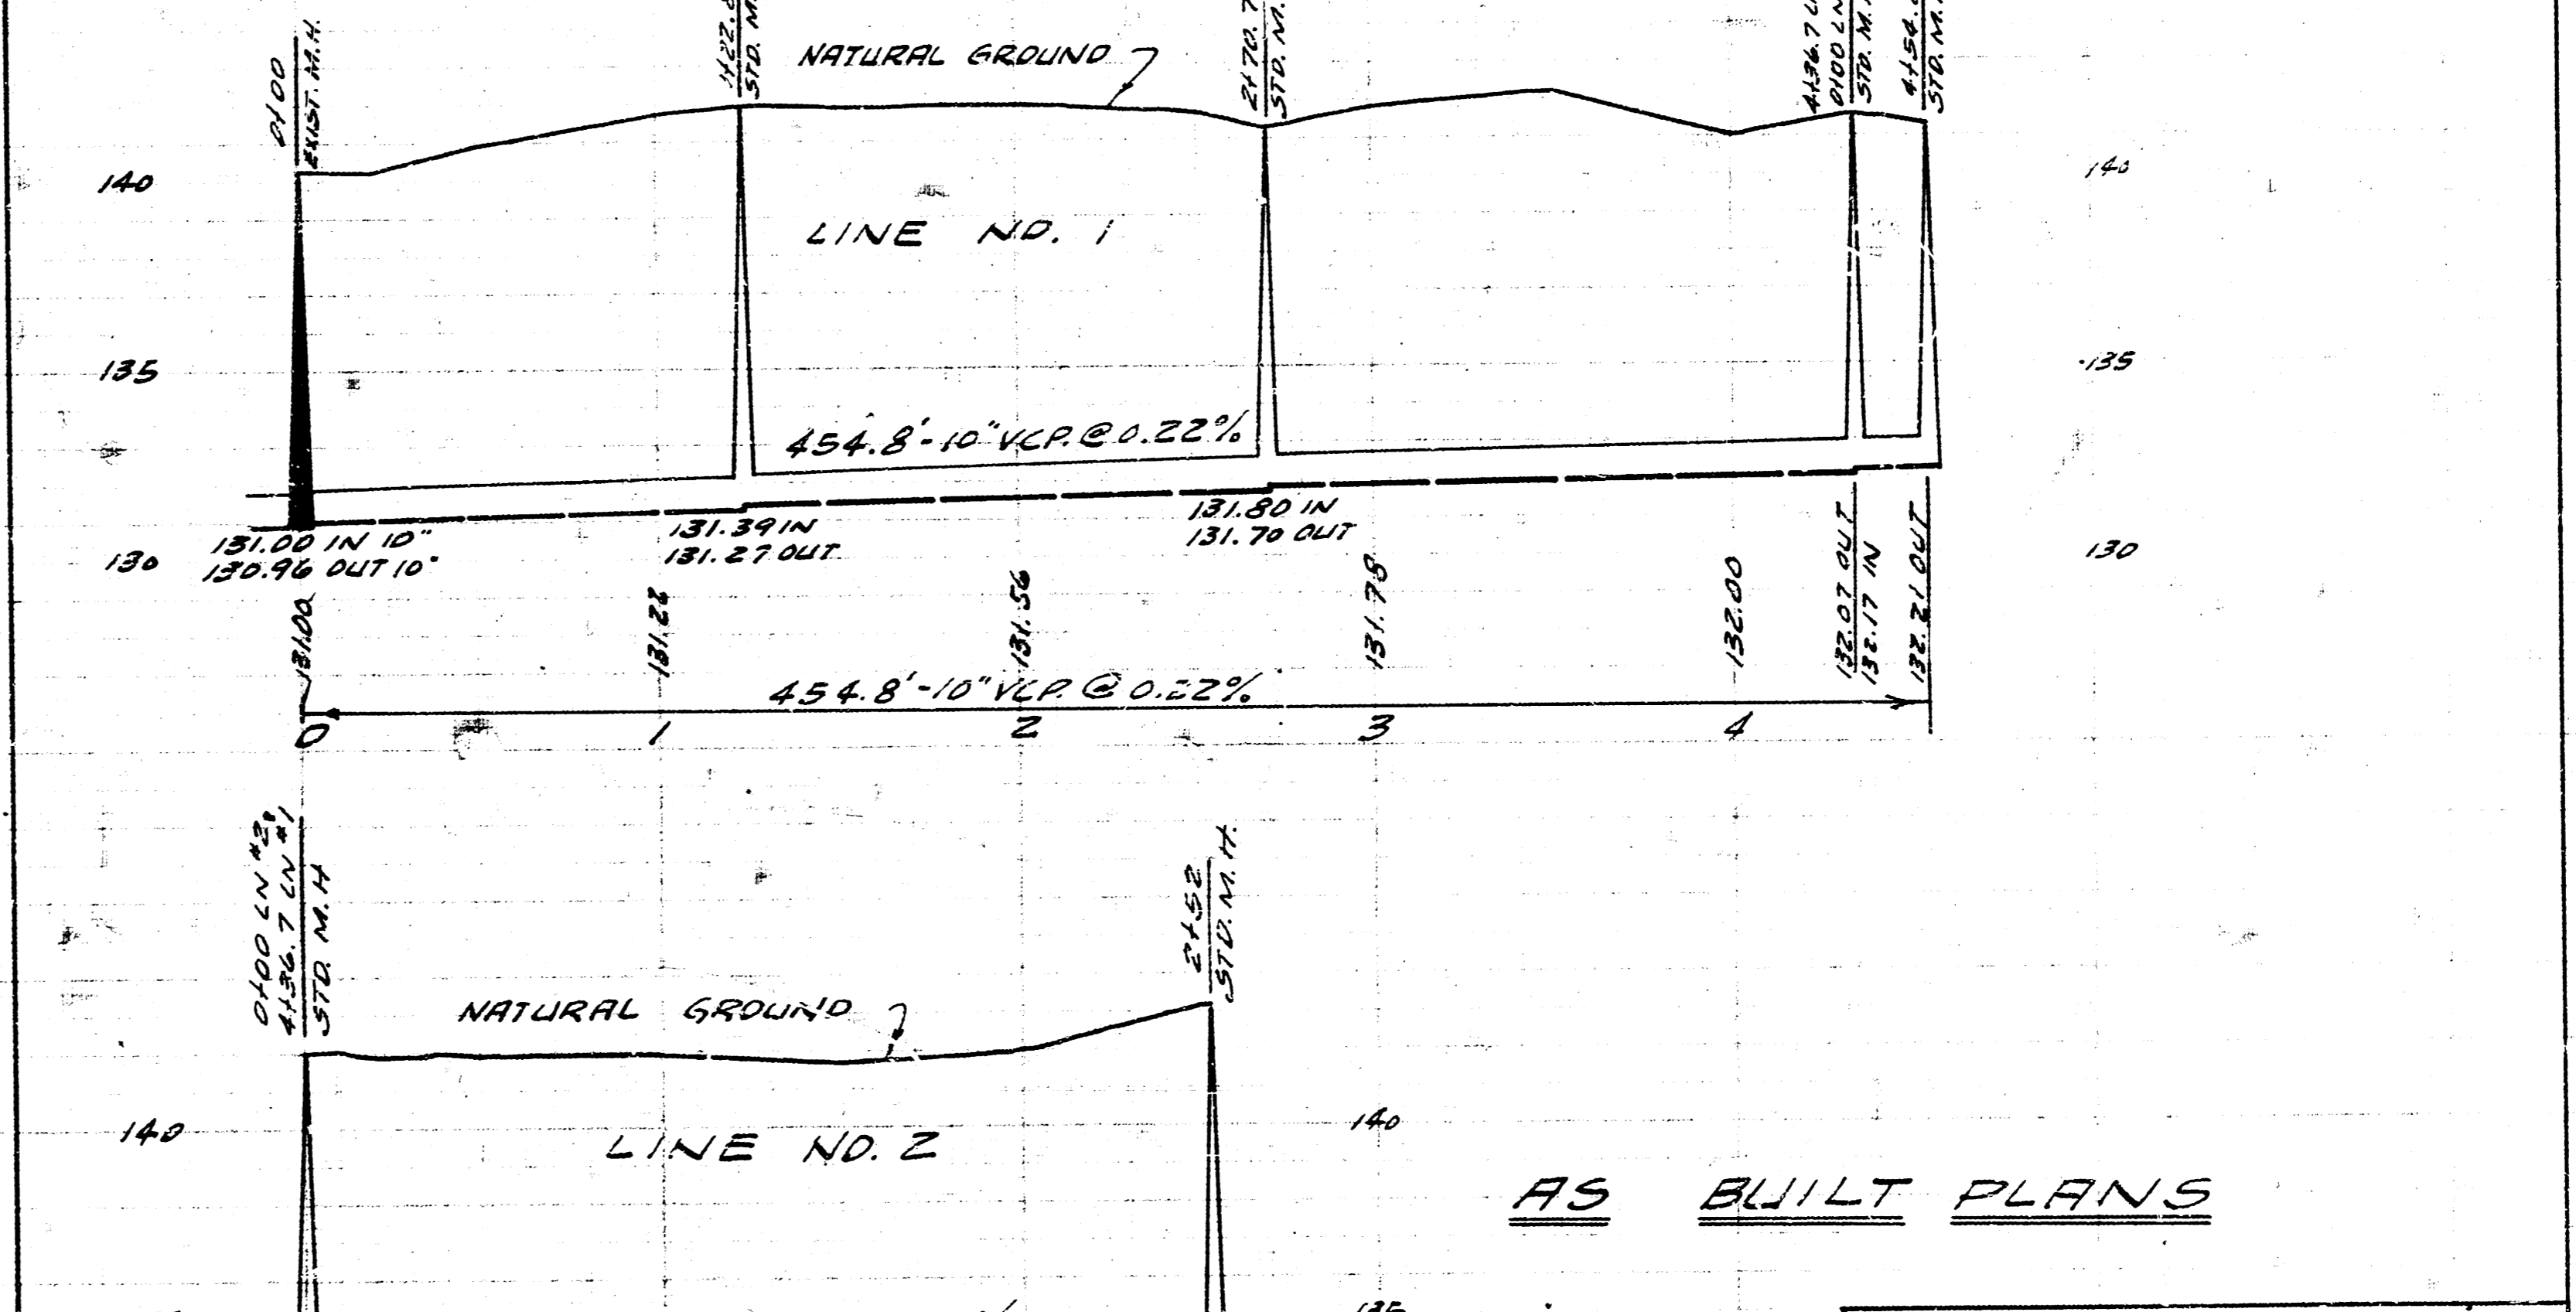

AS BUILT PLANS

RELOCATION OF A PORTION
 OF DIST. C. 55 12
 CITY OF WICHITA, KANSAS
 B.E. SMITH CITY ENGINEER
 PRIVATE JOB AUG., 1960