



B.M. 1517 "D" TOP So. CURB EDGEMONT 6' E. of E.L. RUTAN

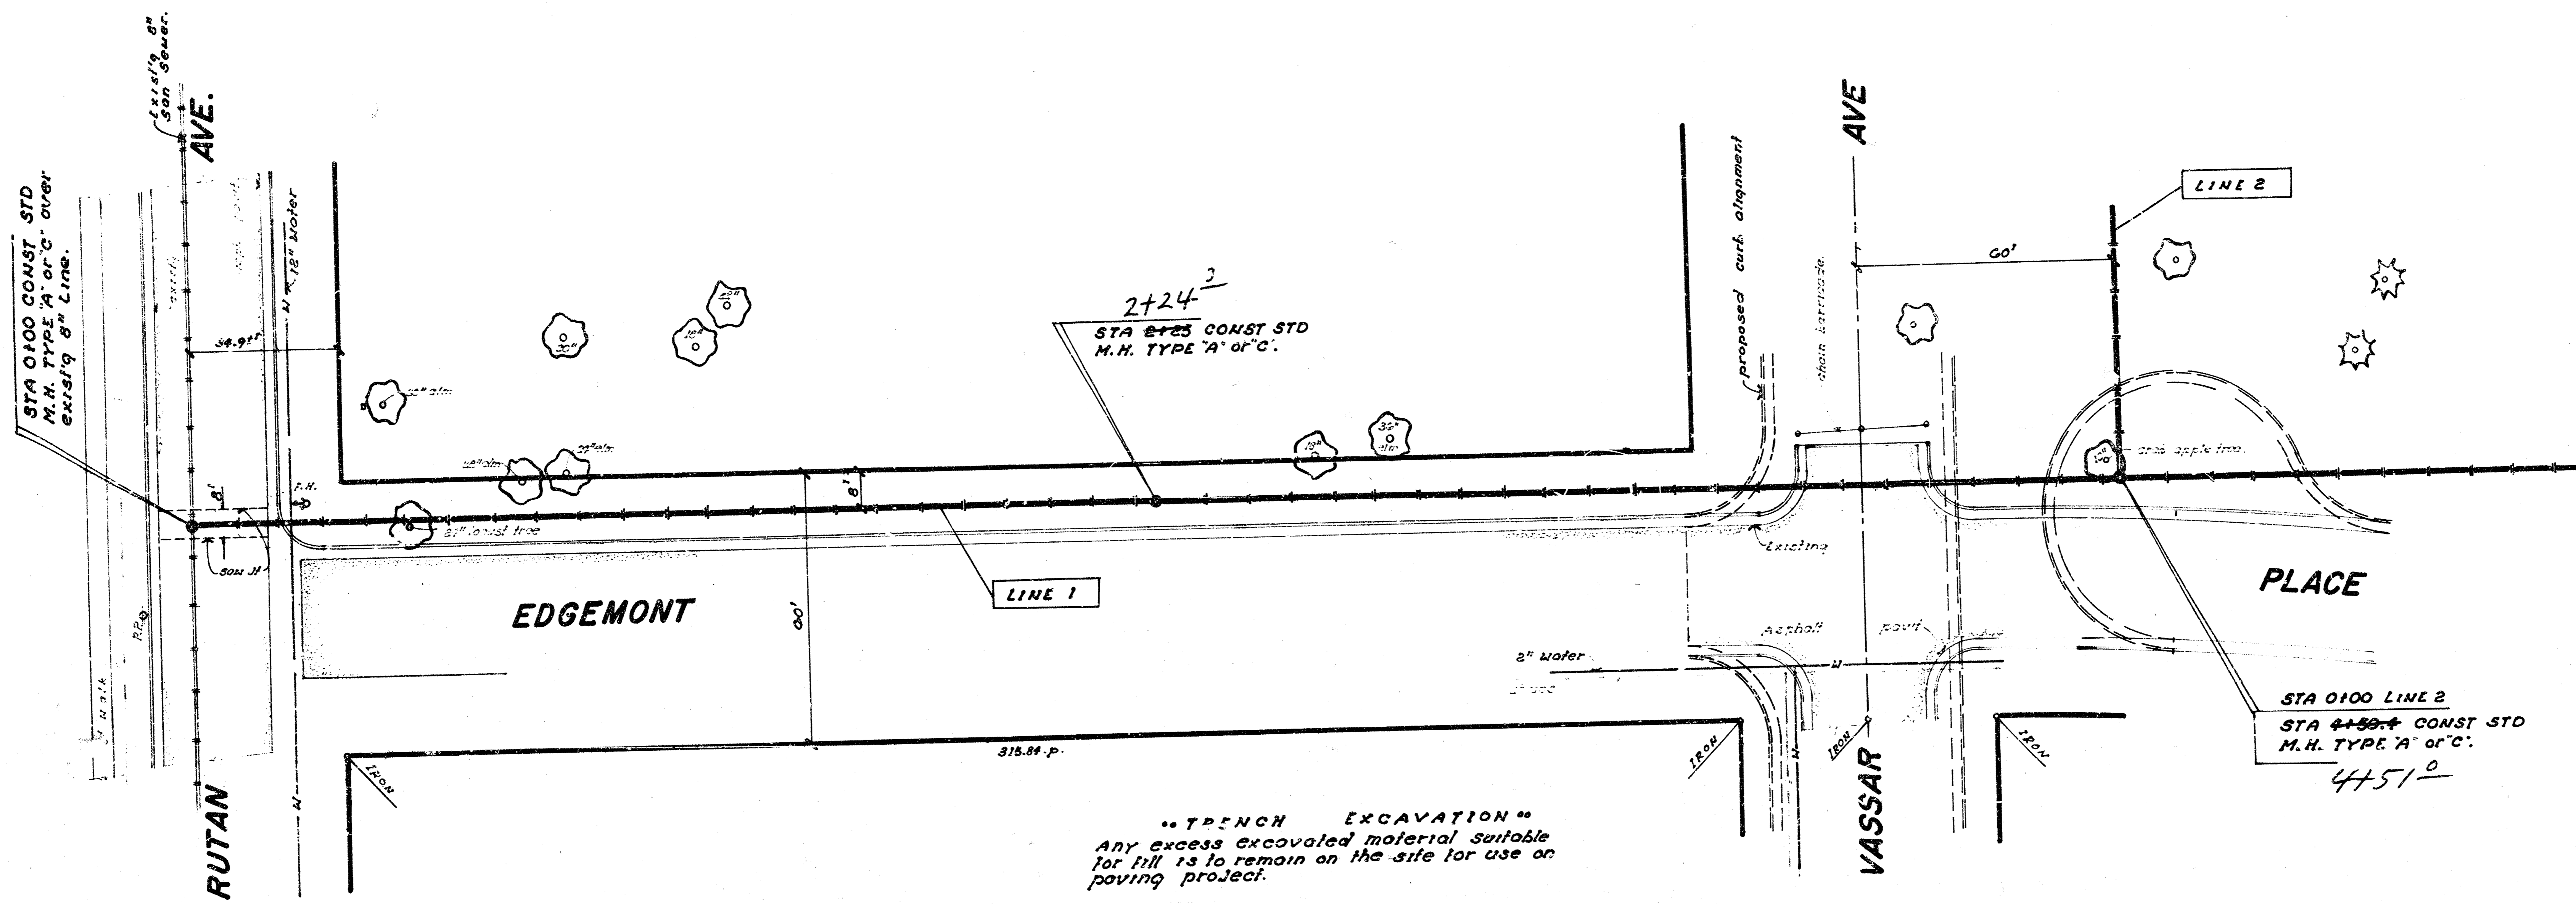


"TRENCH EXCAVATION"
Any excess excavated material suitable for fill is to remain on the site for use on paving project.

plan scale 1" = 20'
profile 1" = 20' Horiz
1" = 5' Vert

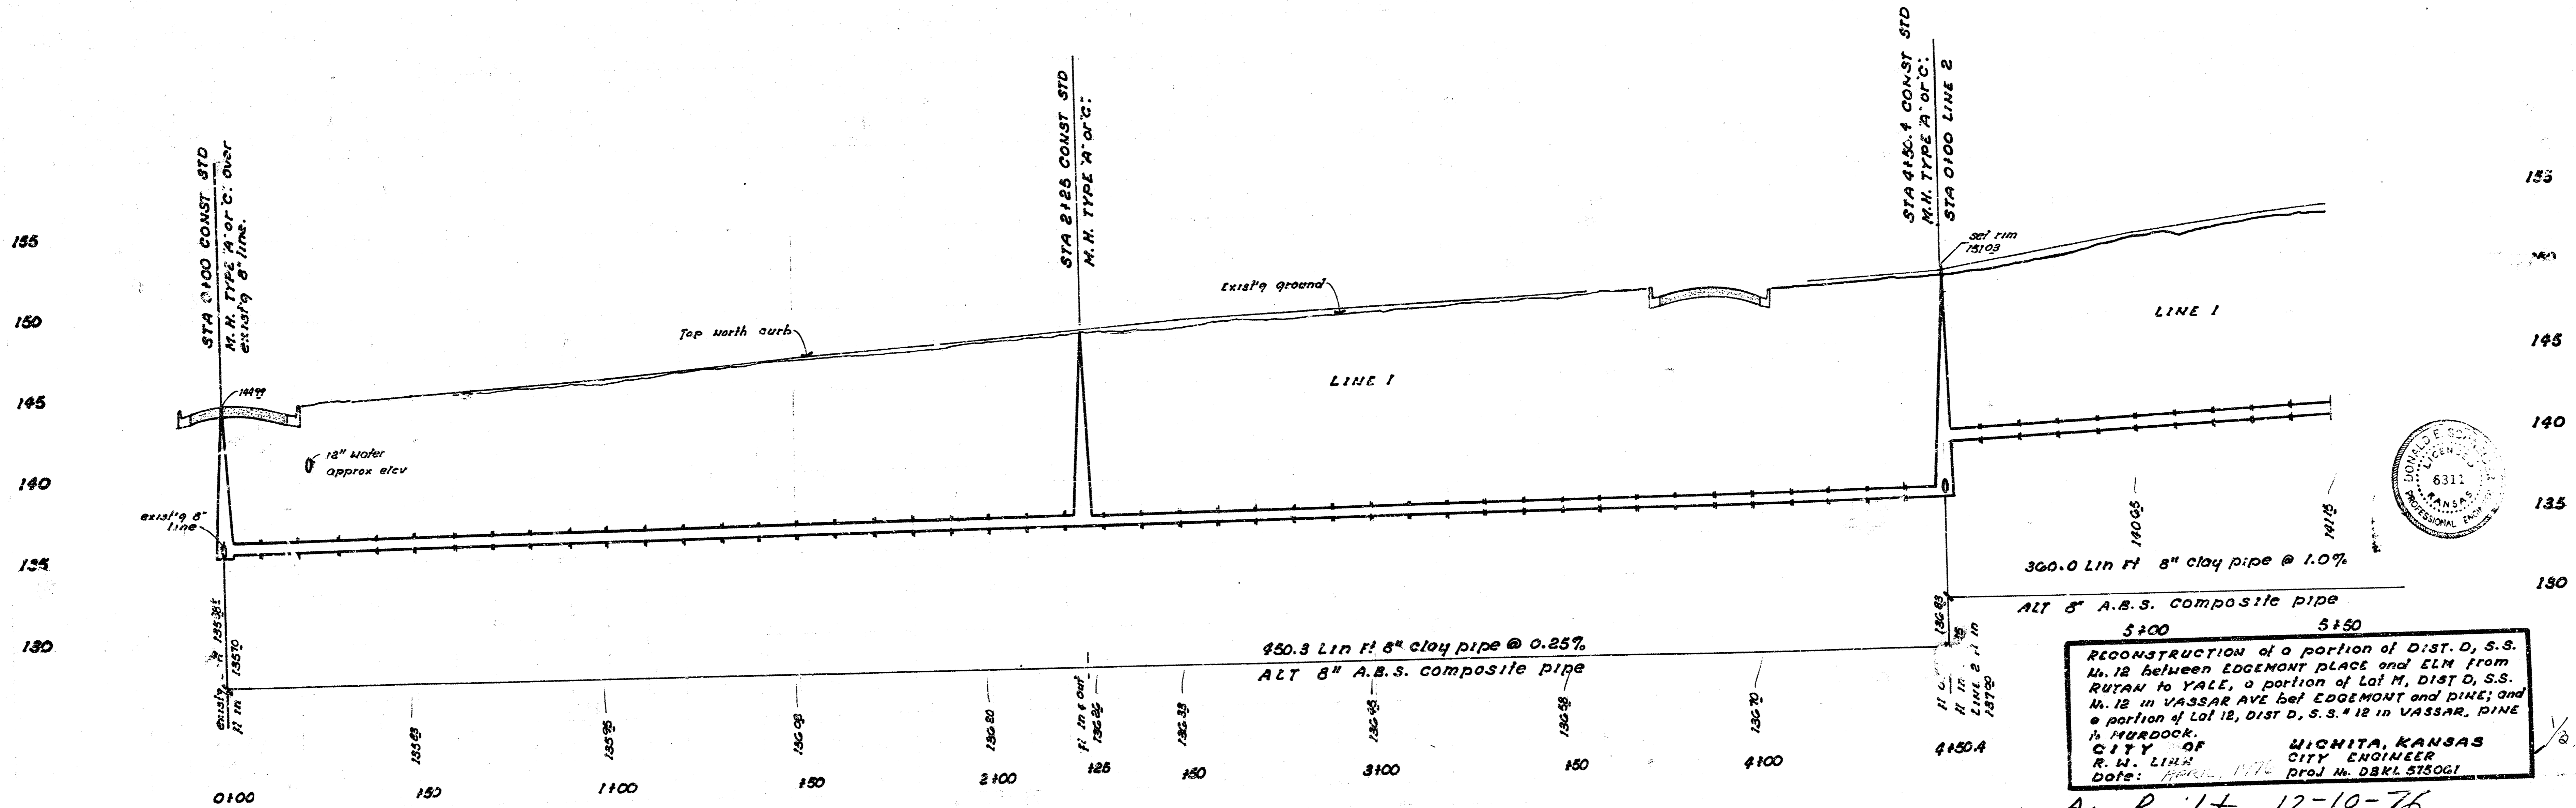


RECONSTRUCTION of a portion of DIST. D, S.S. 14.12 between EDGEMONT PLACE and ELM from RUTAN to YALE, a portion of Lot M, DIST D, S.S. 14.12 in VASSAR AVE bet EDGEMONT and PINE; and a portion of Lot 12, DIST D, S.S. 12 in VASSAR, PINE to HARDOCK.
CITY OF WICHITA, KANSAS
R. W. LINN CITY ENGINEER
Date: March 1976 Proj. No. D&KL 5750G1

As Built 12-10-76


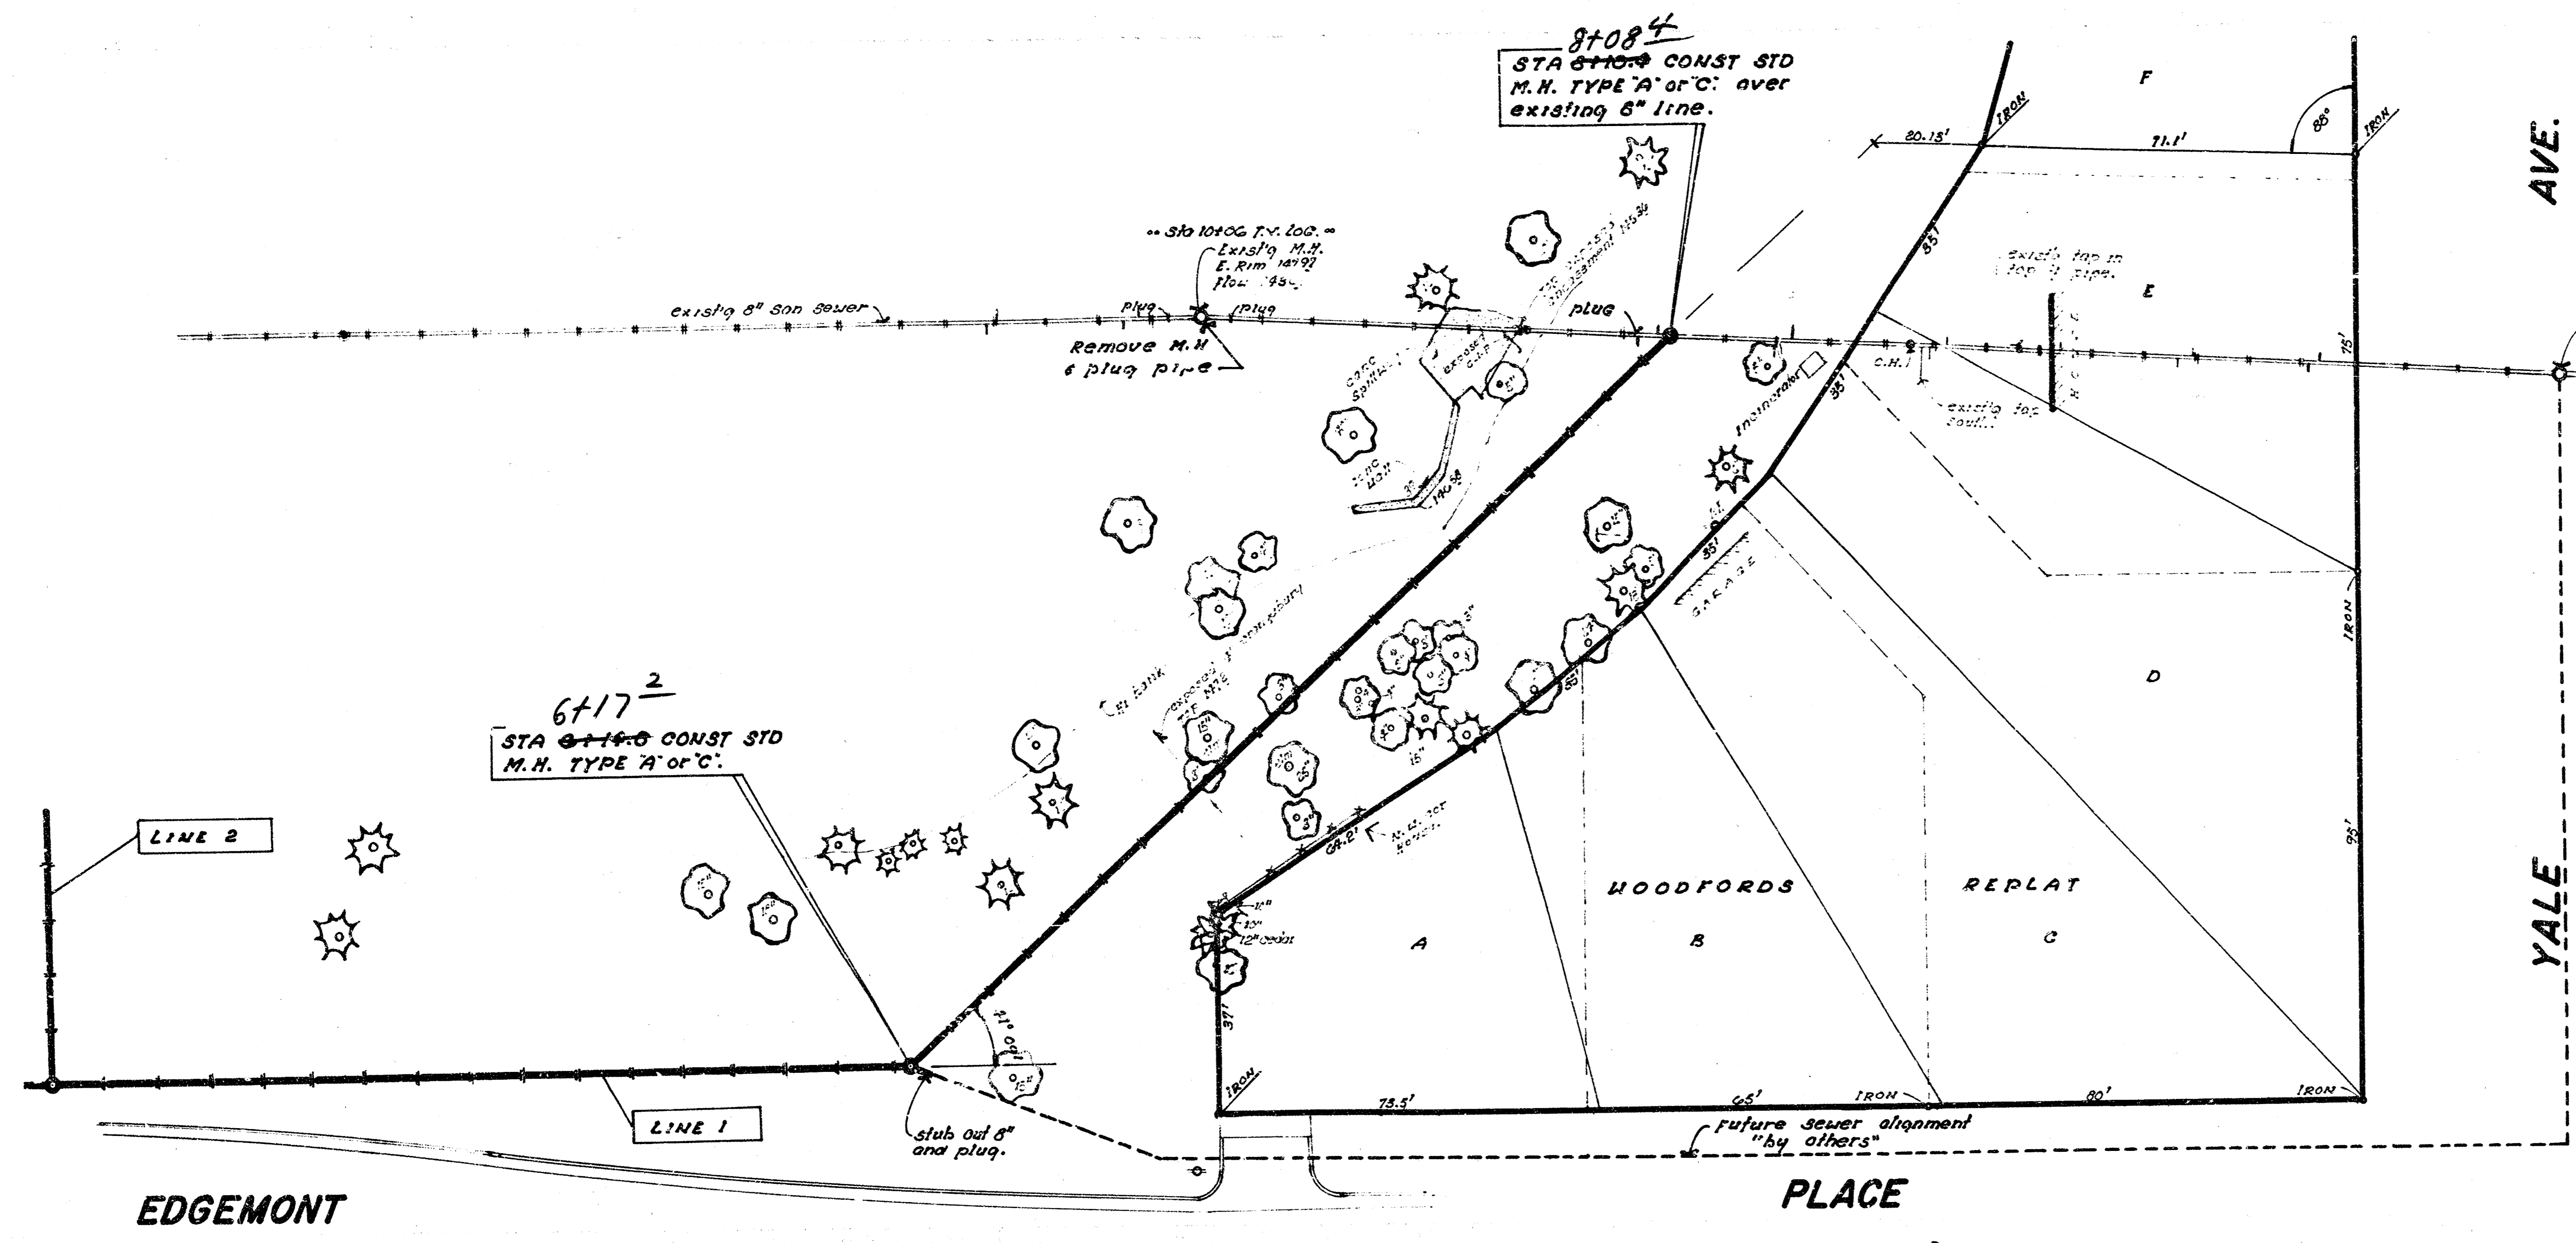


“SERVICE CONNECTIONS”
 NOTE: Contractor to determine the location of existing service connections for houses on lots A thru F WOODFORDS REPLAT. Service lines re connected to be paid as price bid for service connections.

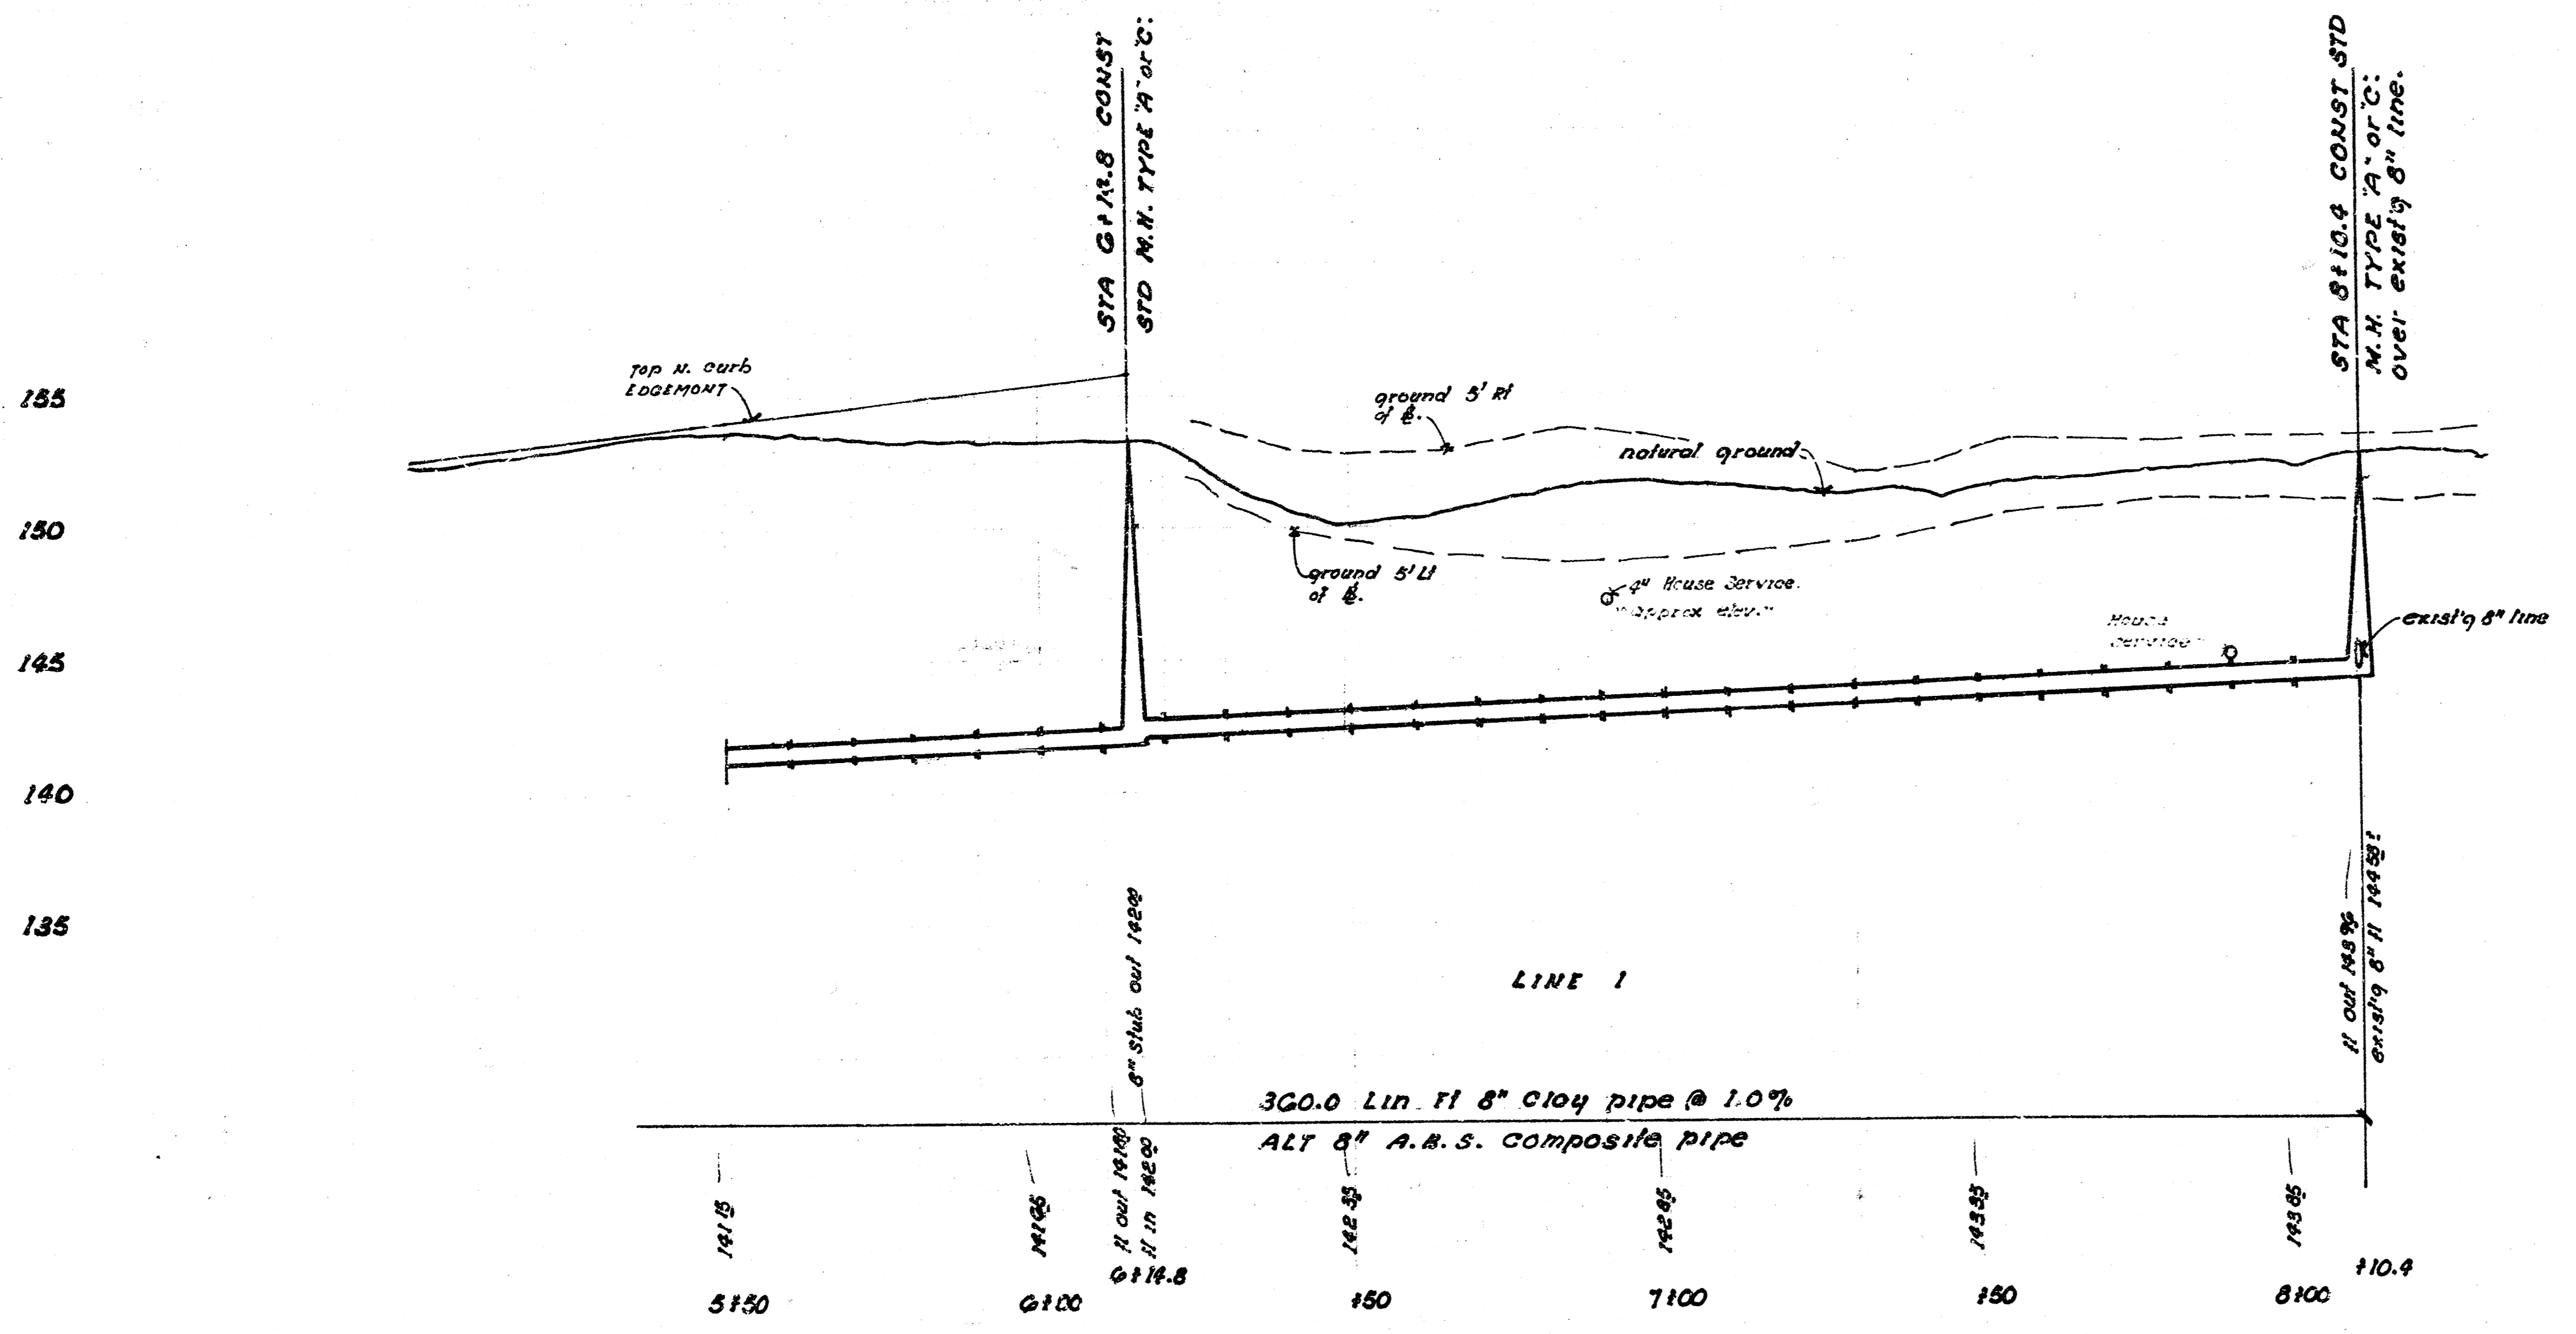

155
 150
 145
 140
 135

2/2

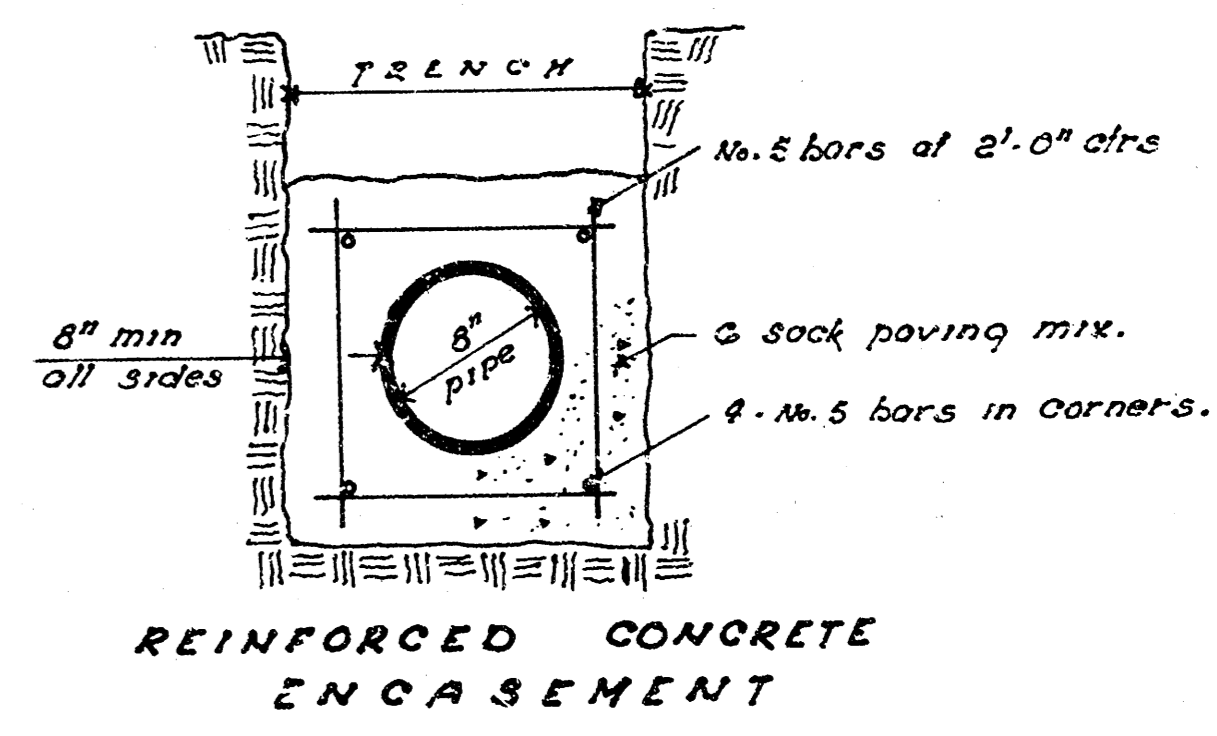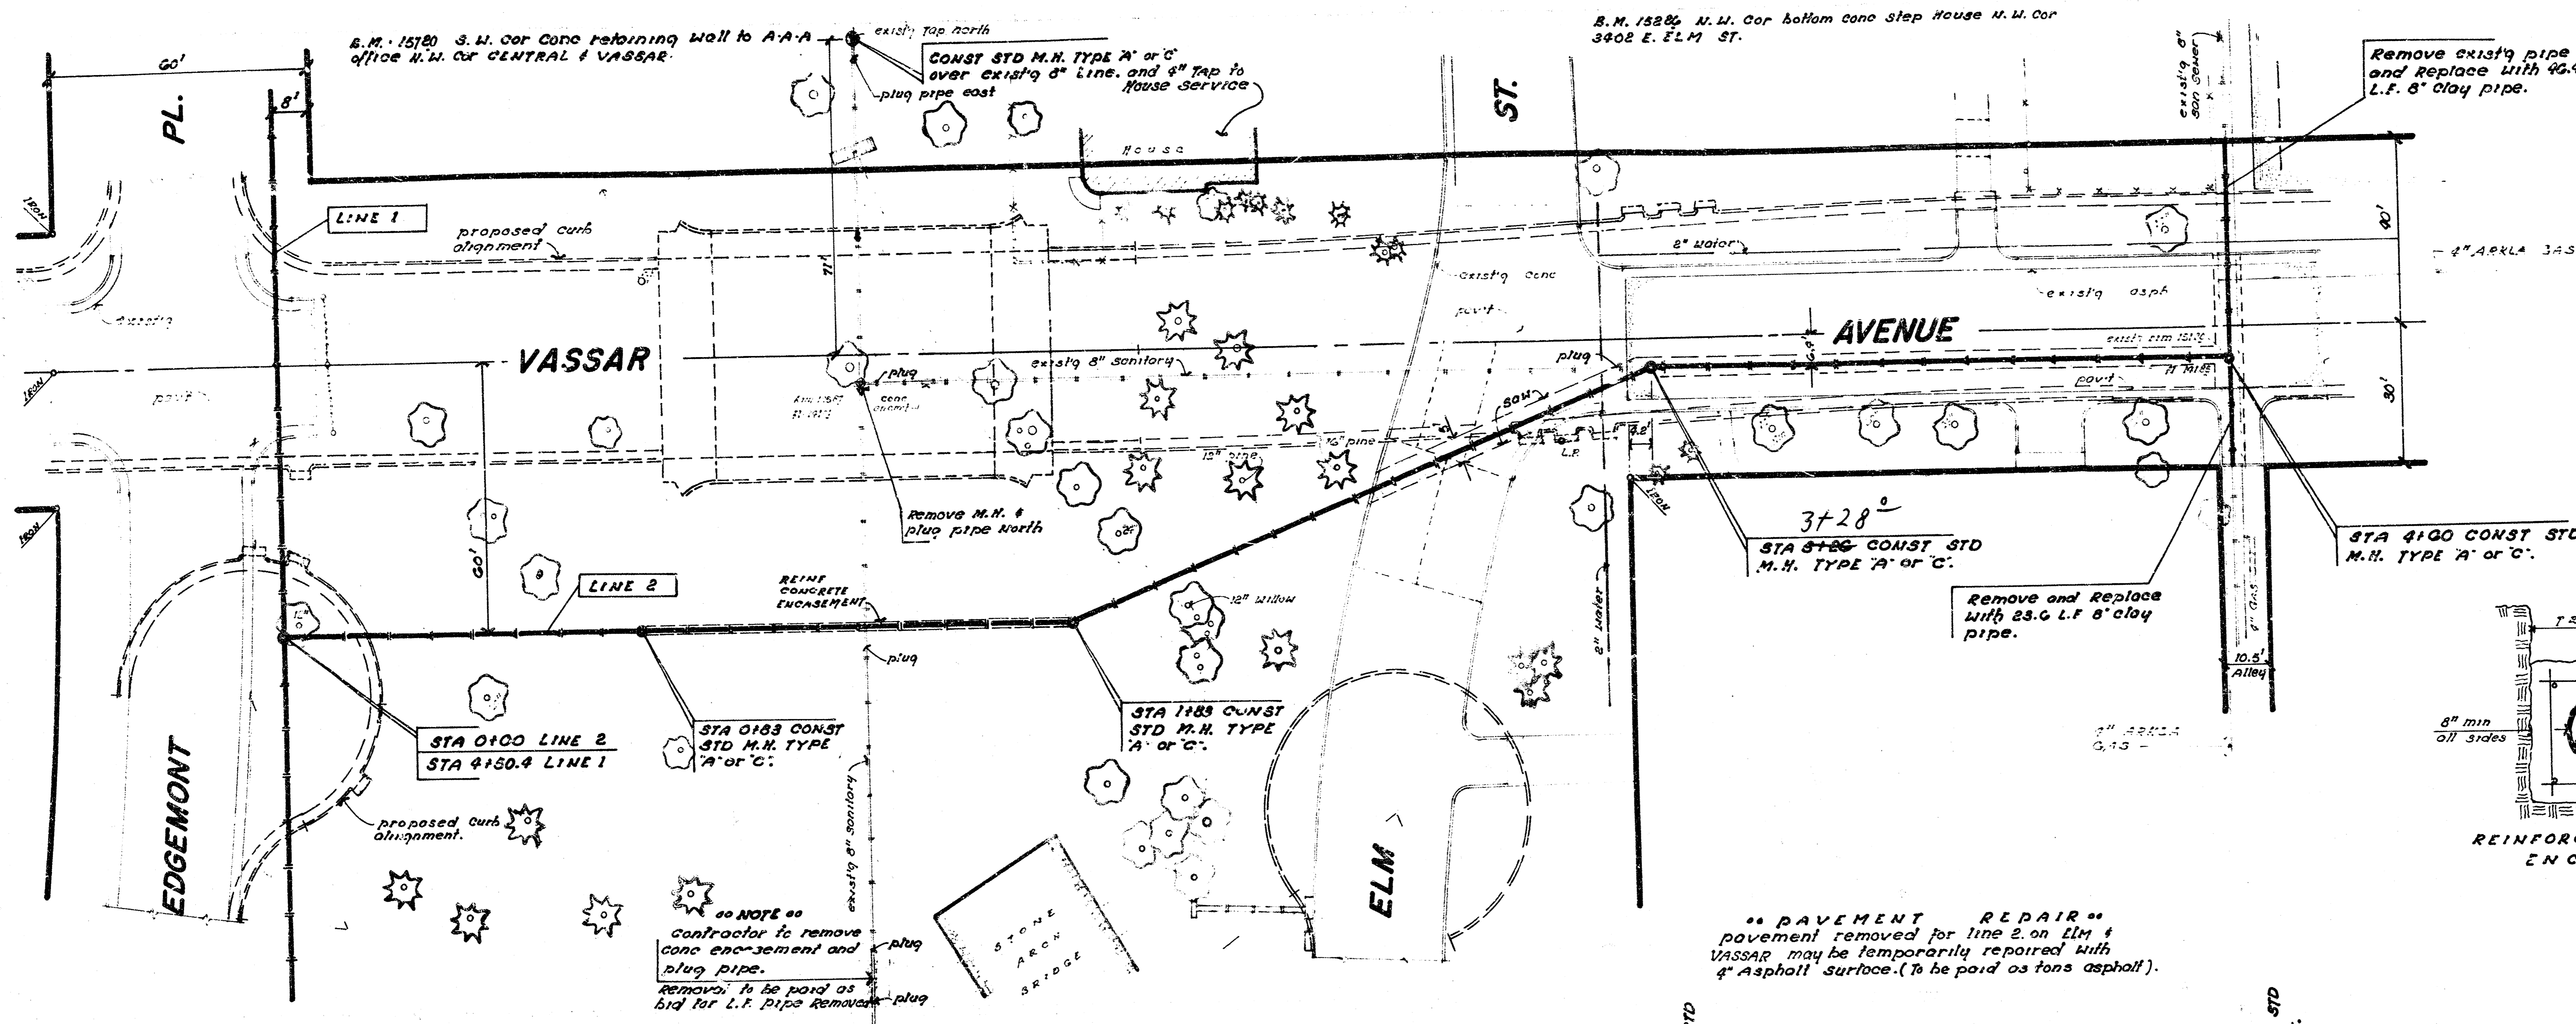

PLAN SCALE 1" = 20'
 profile 1" = 20' Horiz
 1" = 5' Vert

