


NORTH  
 PLAN SCALE 1" = 40'  
 PROFILE SCALE 1" = 40' HORIZ  
 1" = 5' VERT

THE CONTRACTOR SHALL BE RESPONSIBLE FOR OBTAINING NECESSARY PERMITS. THE CONTRACTOR SHALL BE RESPONSIBLE TO RELOCATE ALL UTILITIES TO REMAIN WHICH ARE INTERFERED BY THE WORK. ALL UTILITIES TO BE REMOVED SHALL BE REMOVED BY THE CONTRACTOR. ALL UTILITIES TO BE RELOCATED SHALL BE RELOCATED BY THE CONTRACTOR. ALL UTILITIES TO BE RELOCATED SHALL BE RELOCATED BY THE CONTRACTOR.

BM 15471 D INE COR CONC  
 BASE RR SIGNAL LIGHT  
 EAST SIDE HILLSIDE 250'  
 SOUTH OF 3<sup>rd</sup>



NOTE: CONTRACTOR SHALL GIVE ALL PROPERTY OWNERS AND/OR TENANTS DIRECTLY AFFECTED BY THE CONSTRUCTION OF THIS PROJECT A MINIMUM ADVANCE NOTICE OF 48 HOURS PRIOR TO STARTING CONSTRUCTION.

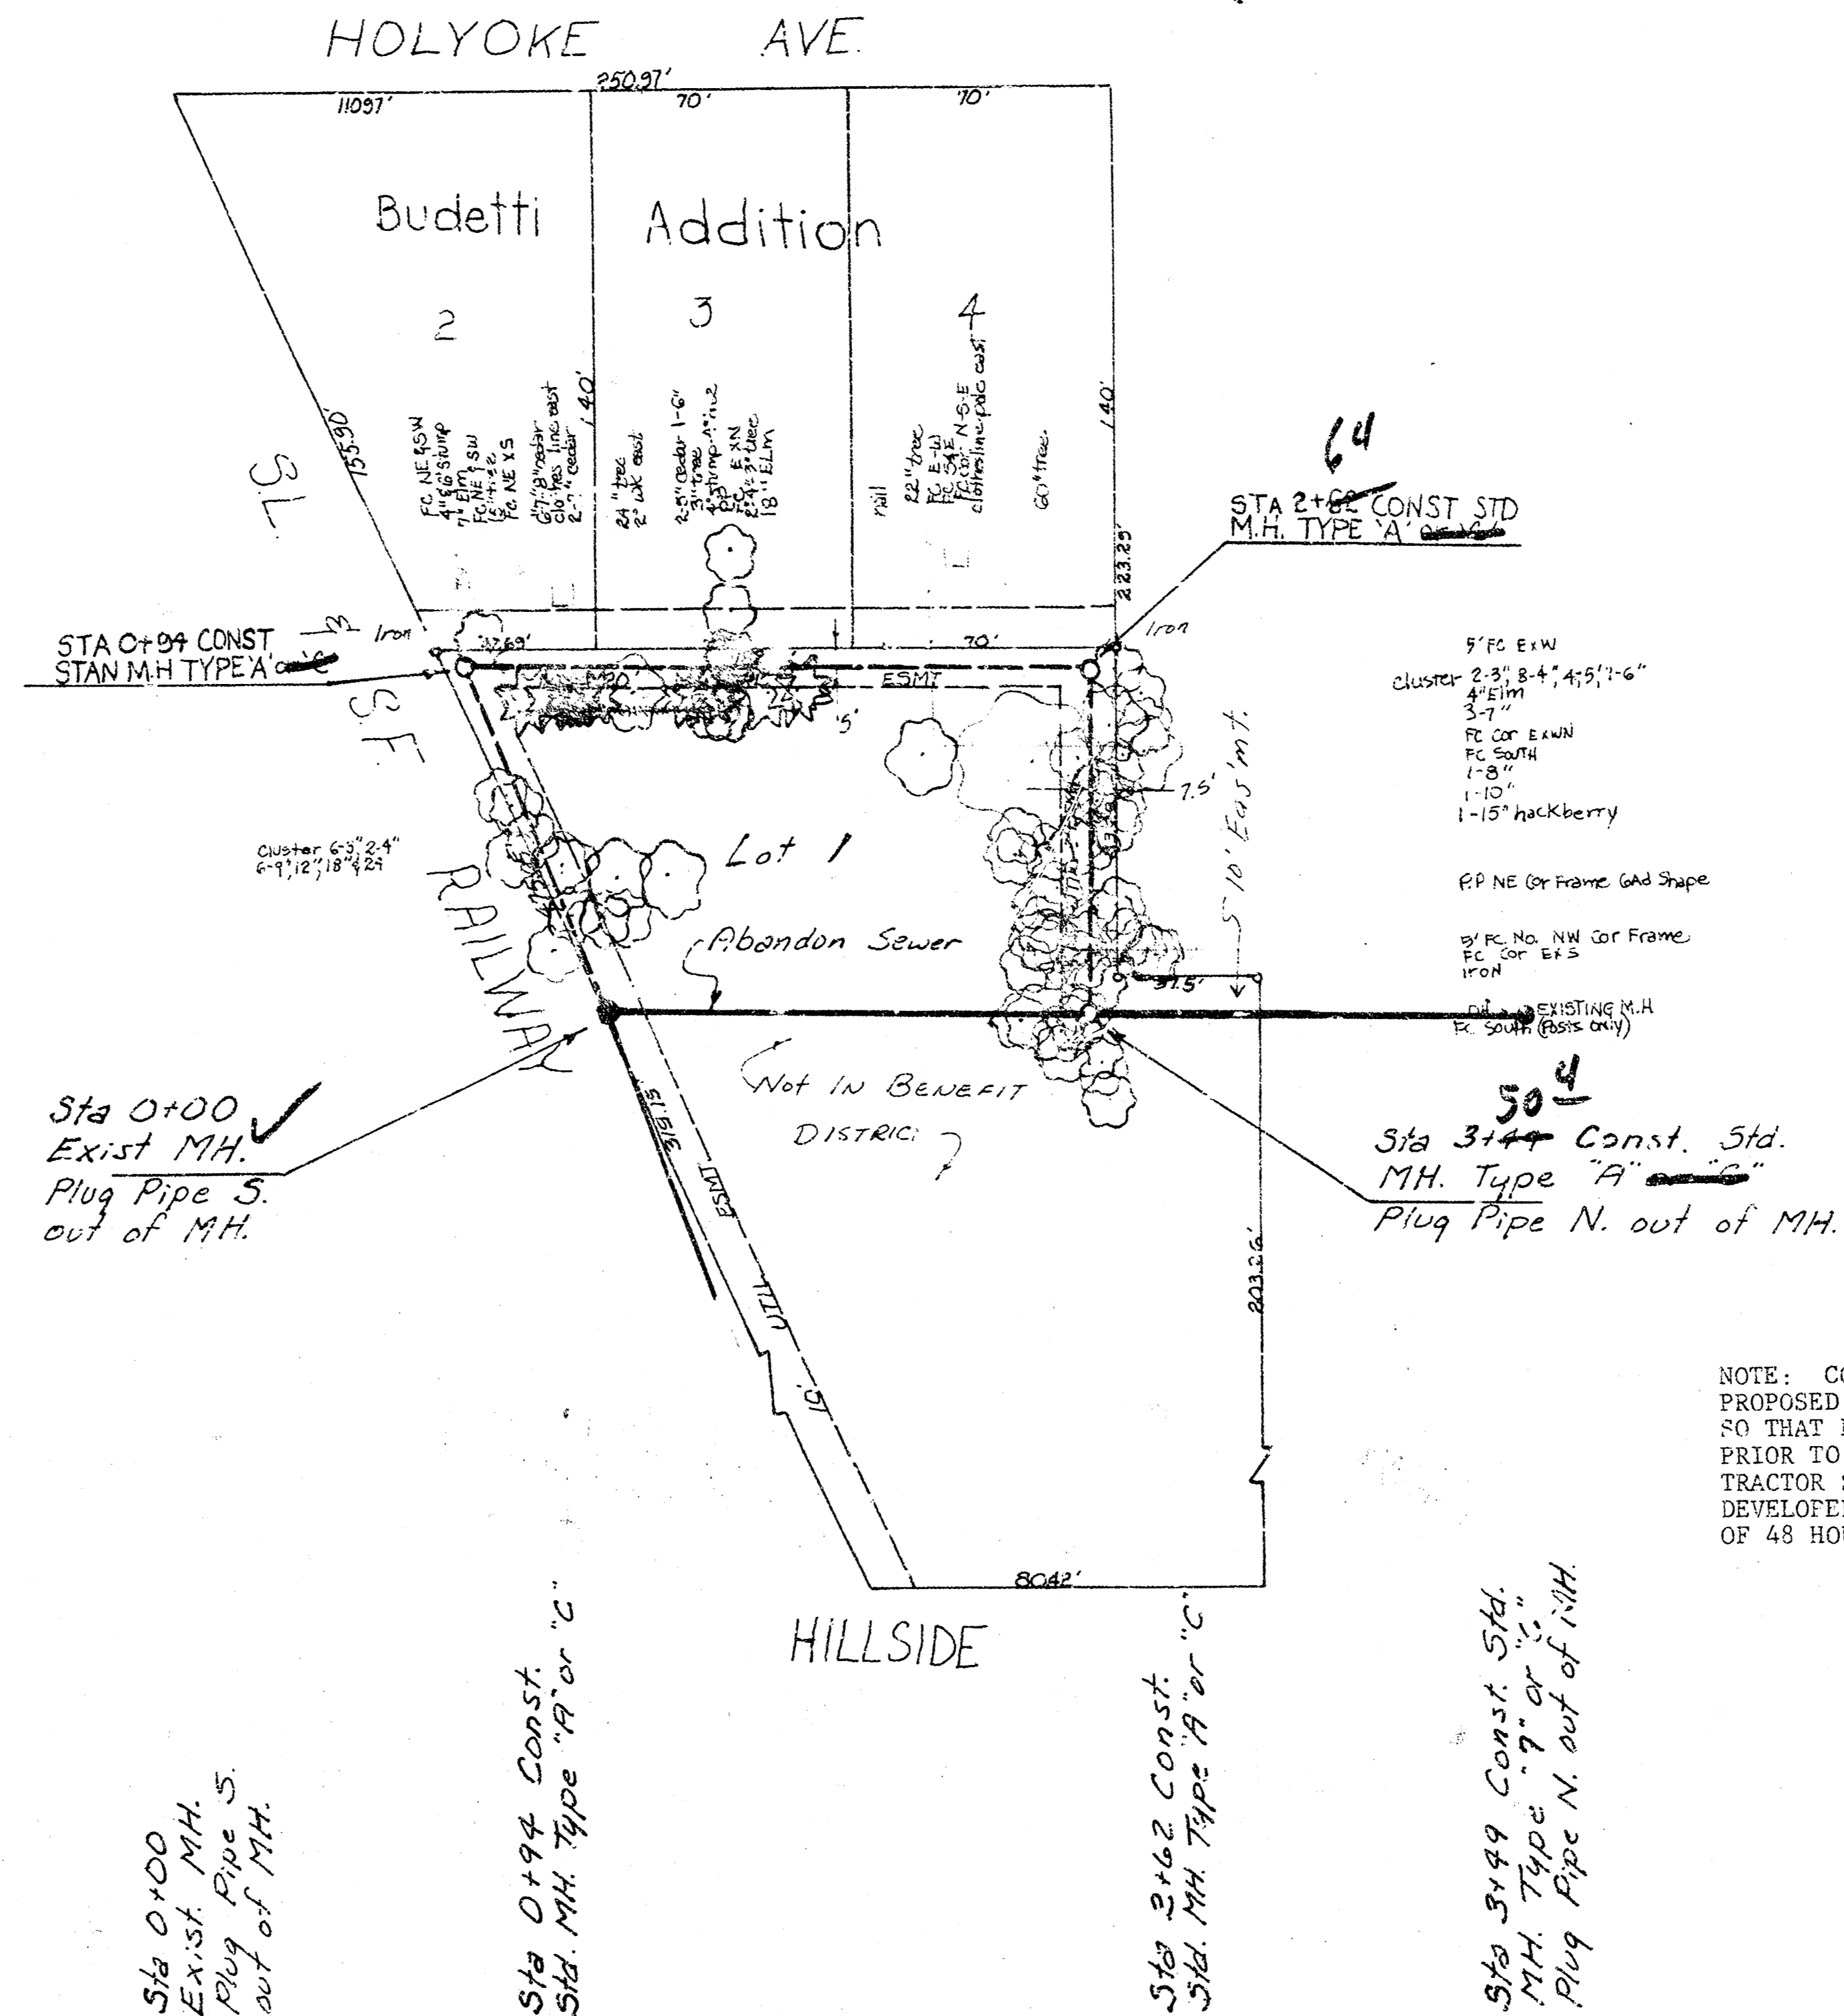

NOTE: CONTRACTOR SHALL EXPOSE TOP OF P.I.P.F. AT PROPOSED MANHOLE LOCATION AT STATION 3 + 49 SO THAT FIELD ENGINEER CAN VERIFY ELEVATIONS PRIOR TO INSTALLATION OF ANY SEWER PIPE. CONTRACTOR SHALL GIVE OWNERS AND/OR TENANTS OF DEVELOPED PROPERTY A MINIMUM ADVANCE NOTICE OF 48 HOURS PRIOR TO STARTING CONSTRUCTION.

160  
155  
150  
145  
140

160  
155  
150  
145  
140

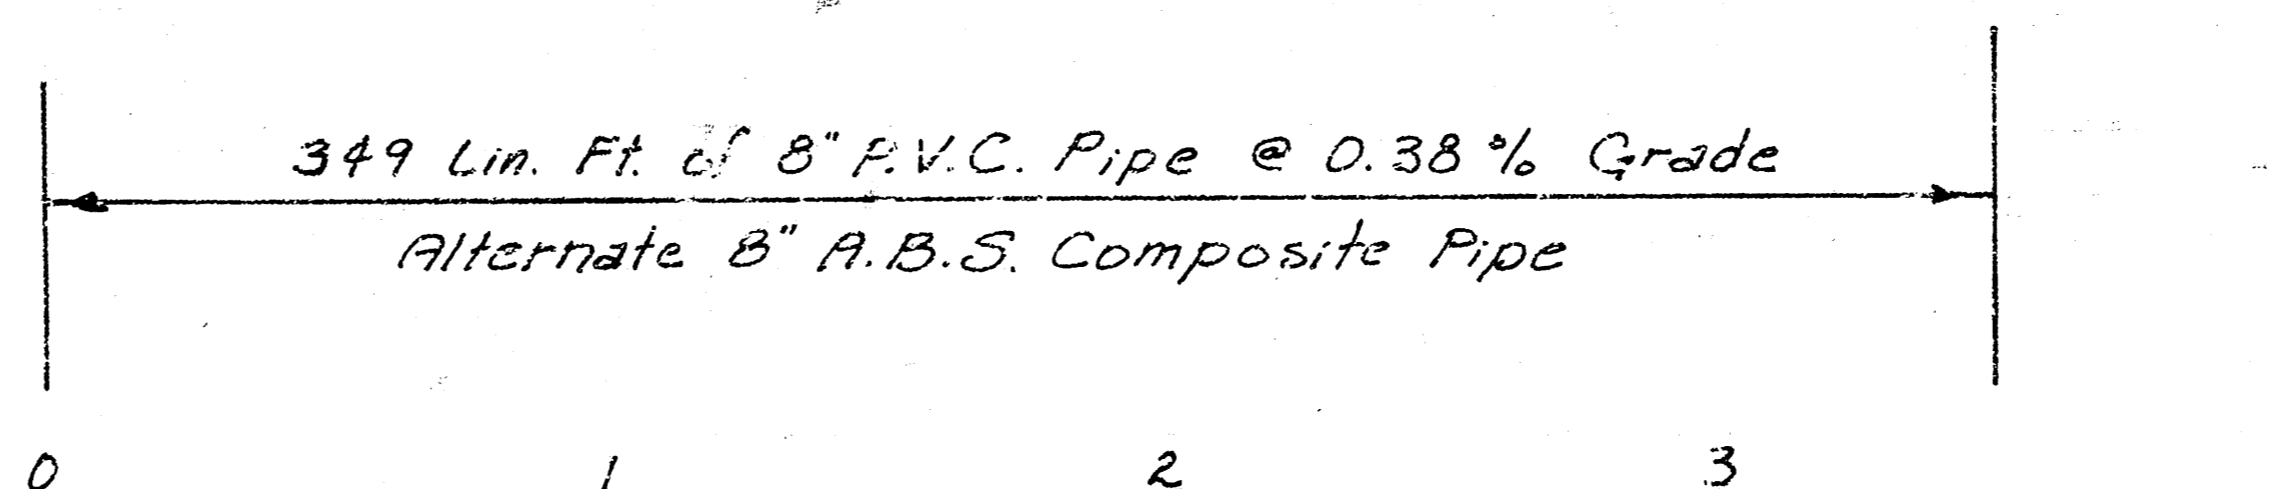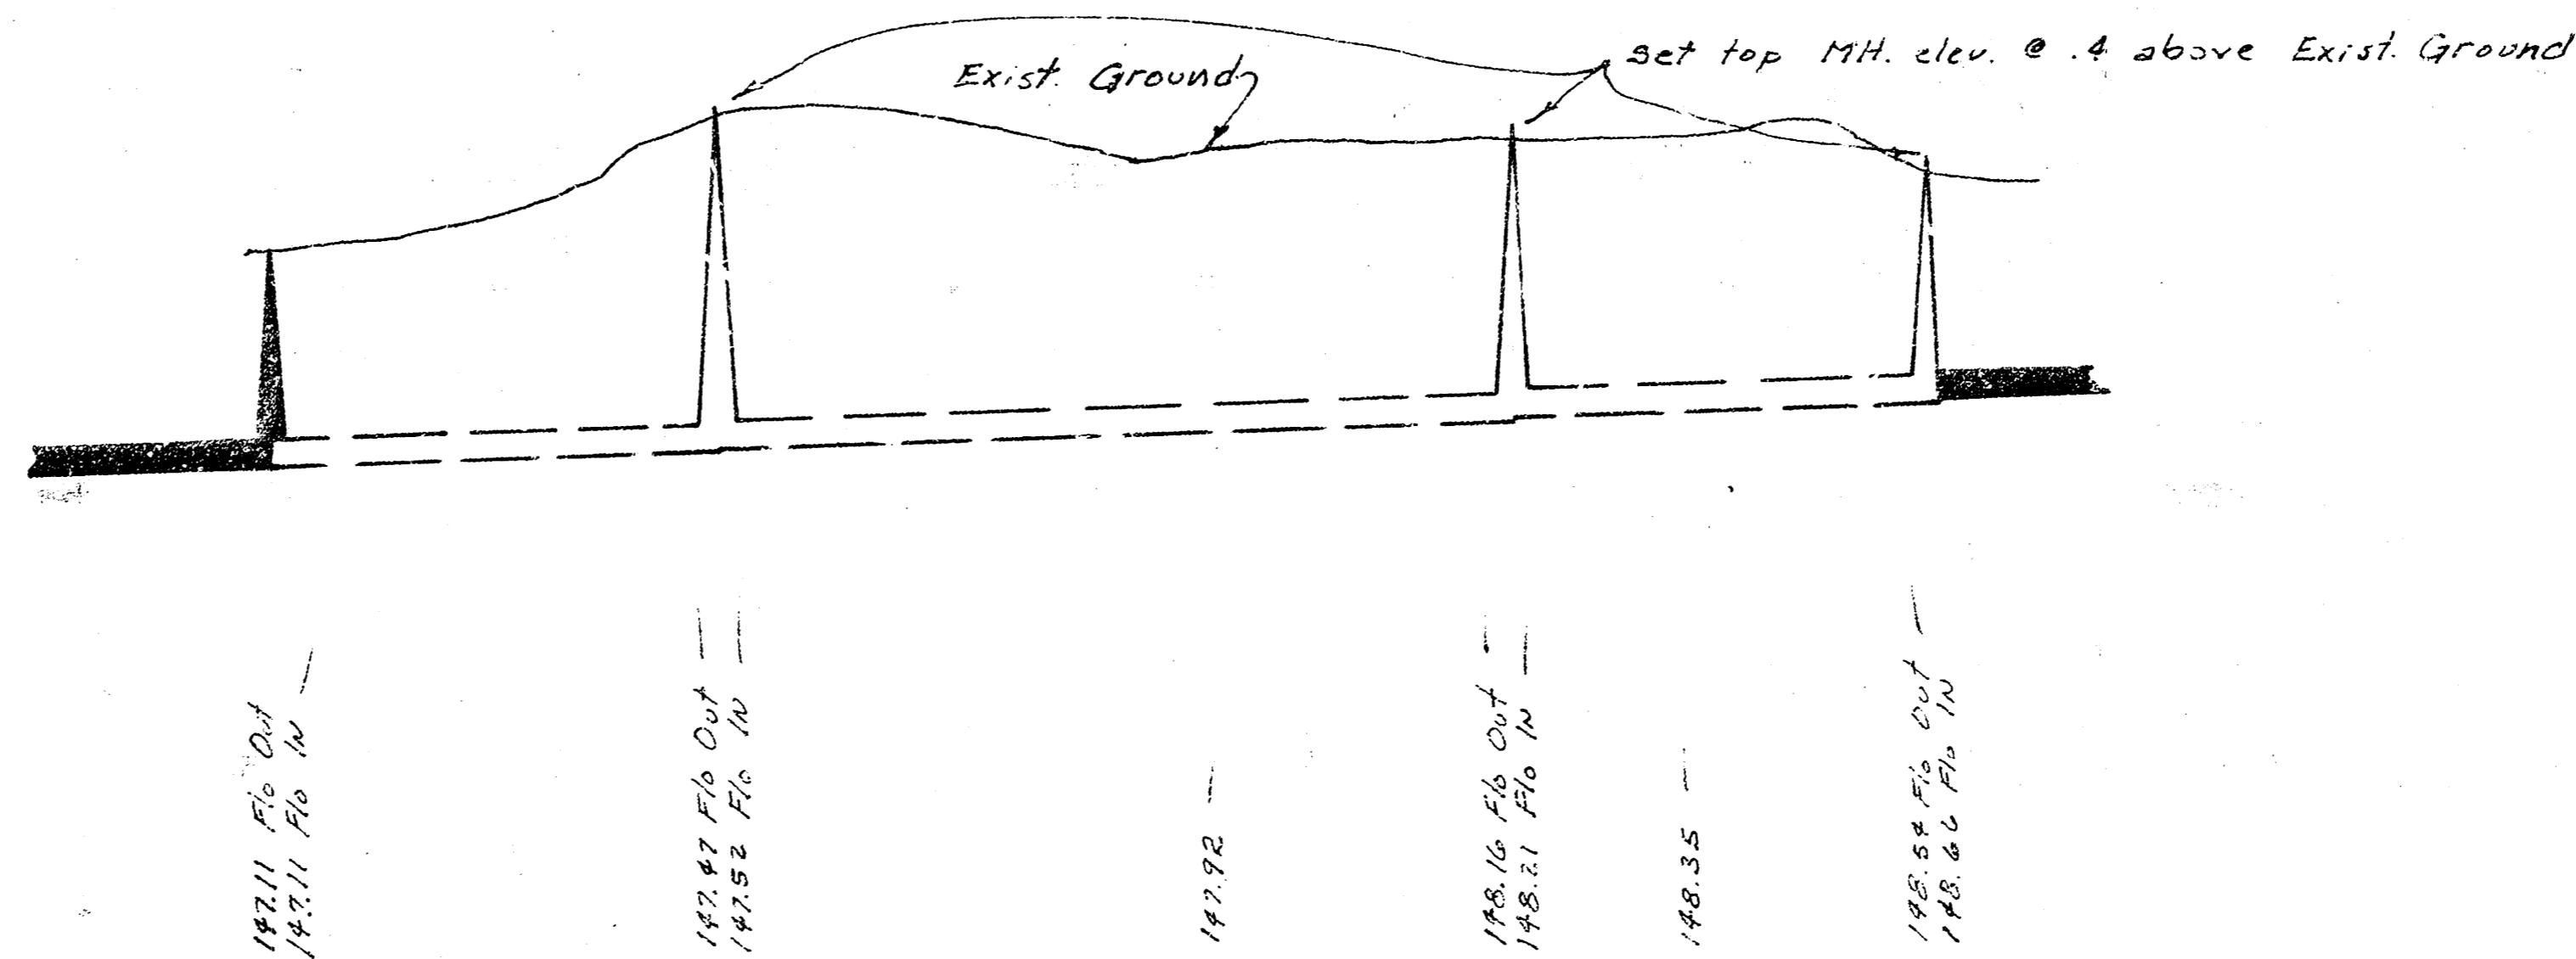

As Built  
 1/4/82  
 JDD

LAT 17, DIST. D, SS. # 12  
 CITY OF WICHITA, KANSAS  
 R.W. BRUGGEMAN  
 DIRECTOR OF ENGINEERING / CITY ENGINEER  
 PROJ. NO. 168-76-245-80994-000-000-001