

ALTER, REPAIR, RECONSTRUCT OR CONSTRUCT A PORTION OF


DISTRICT P
SANITARY SEWER NO. 12

(EAST OF VOLUTSIA BETWEEN 16TH ST. NO. & 17TH ST. NO.)

THE CITY OF WICHITA,

SEDGWICK COUNTY, KANSAS

MICHAEL E. LINDEBAK, P.E., CITY ENGINEER

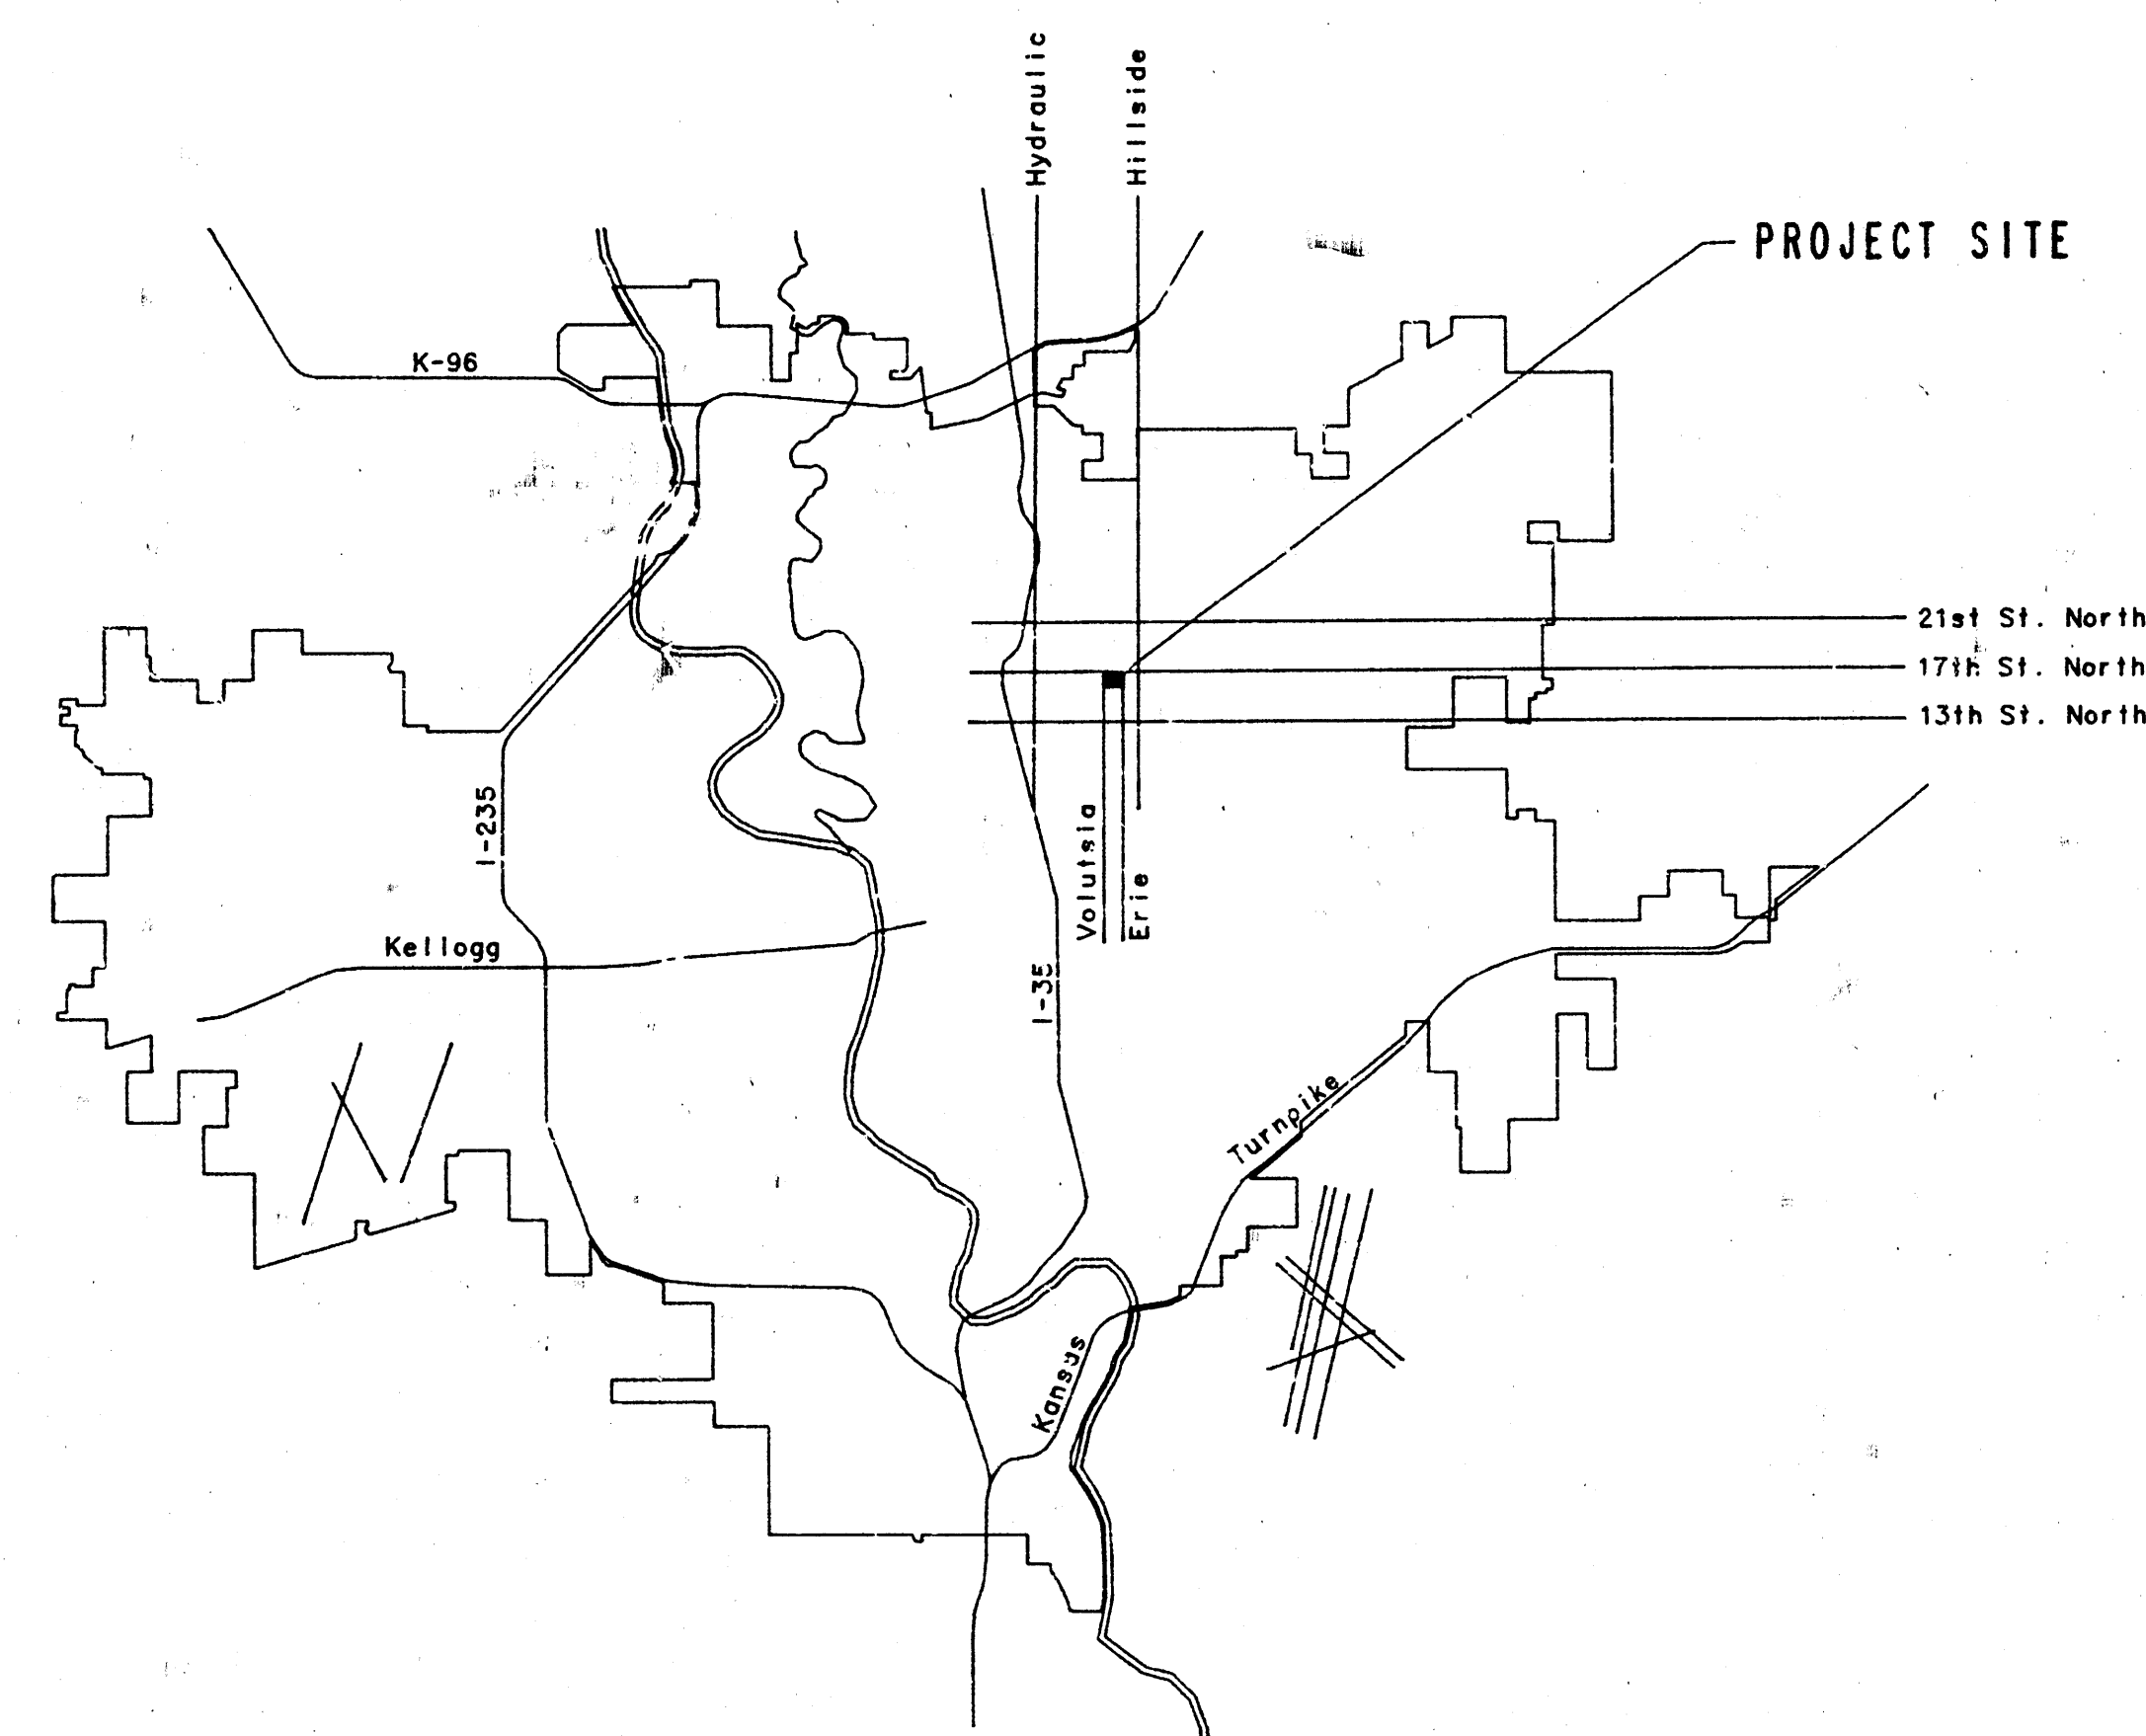

LOCATION MAP

CITY OF WICHITA PROJECT NO. 468-76-245-81472-000-000-001

JULY, 1985

PLANS PREPARED BY


PROFESSIONAL ENGINEERING CONSULTANTS, P.A.

ENGINEERS

WICHITA, KANSAS


As Built
RDL
6-86



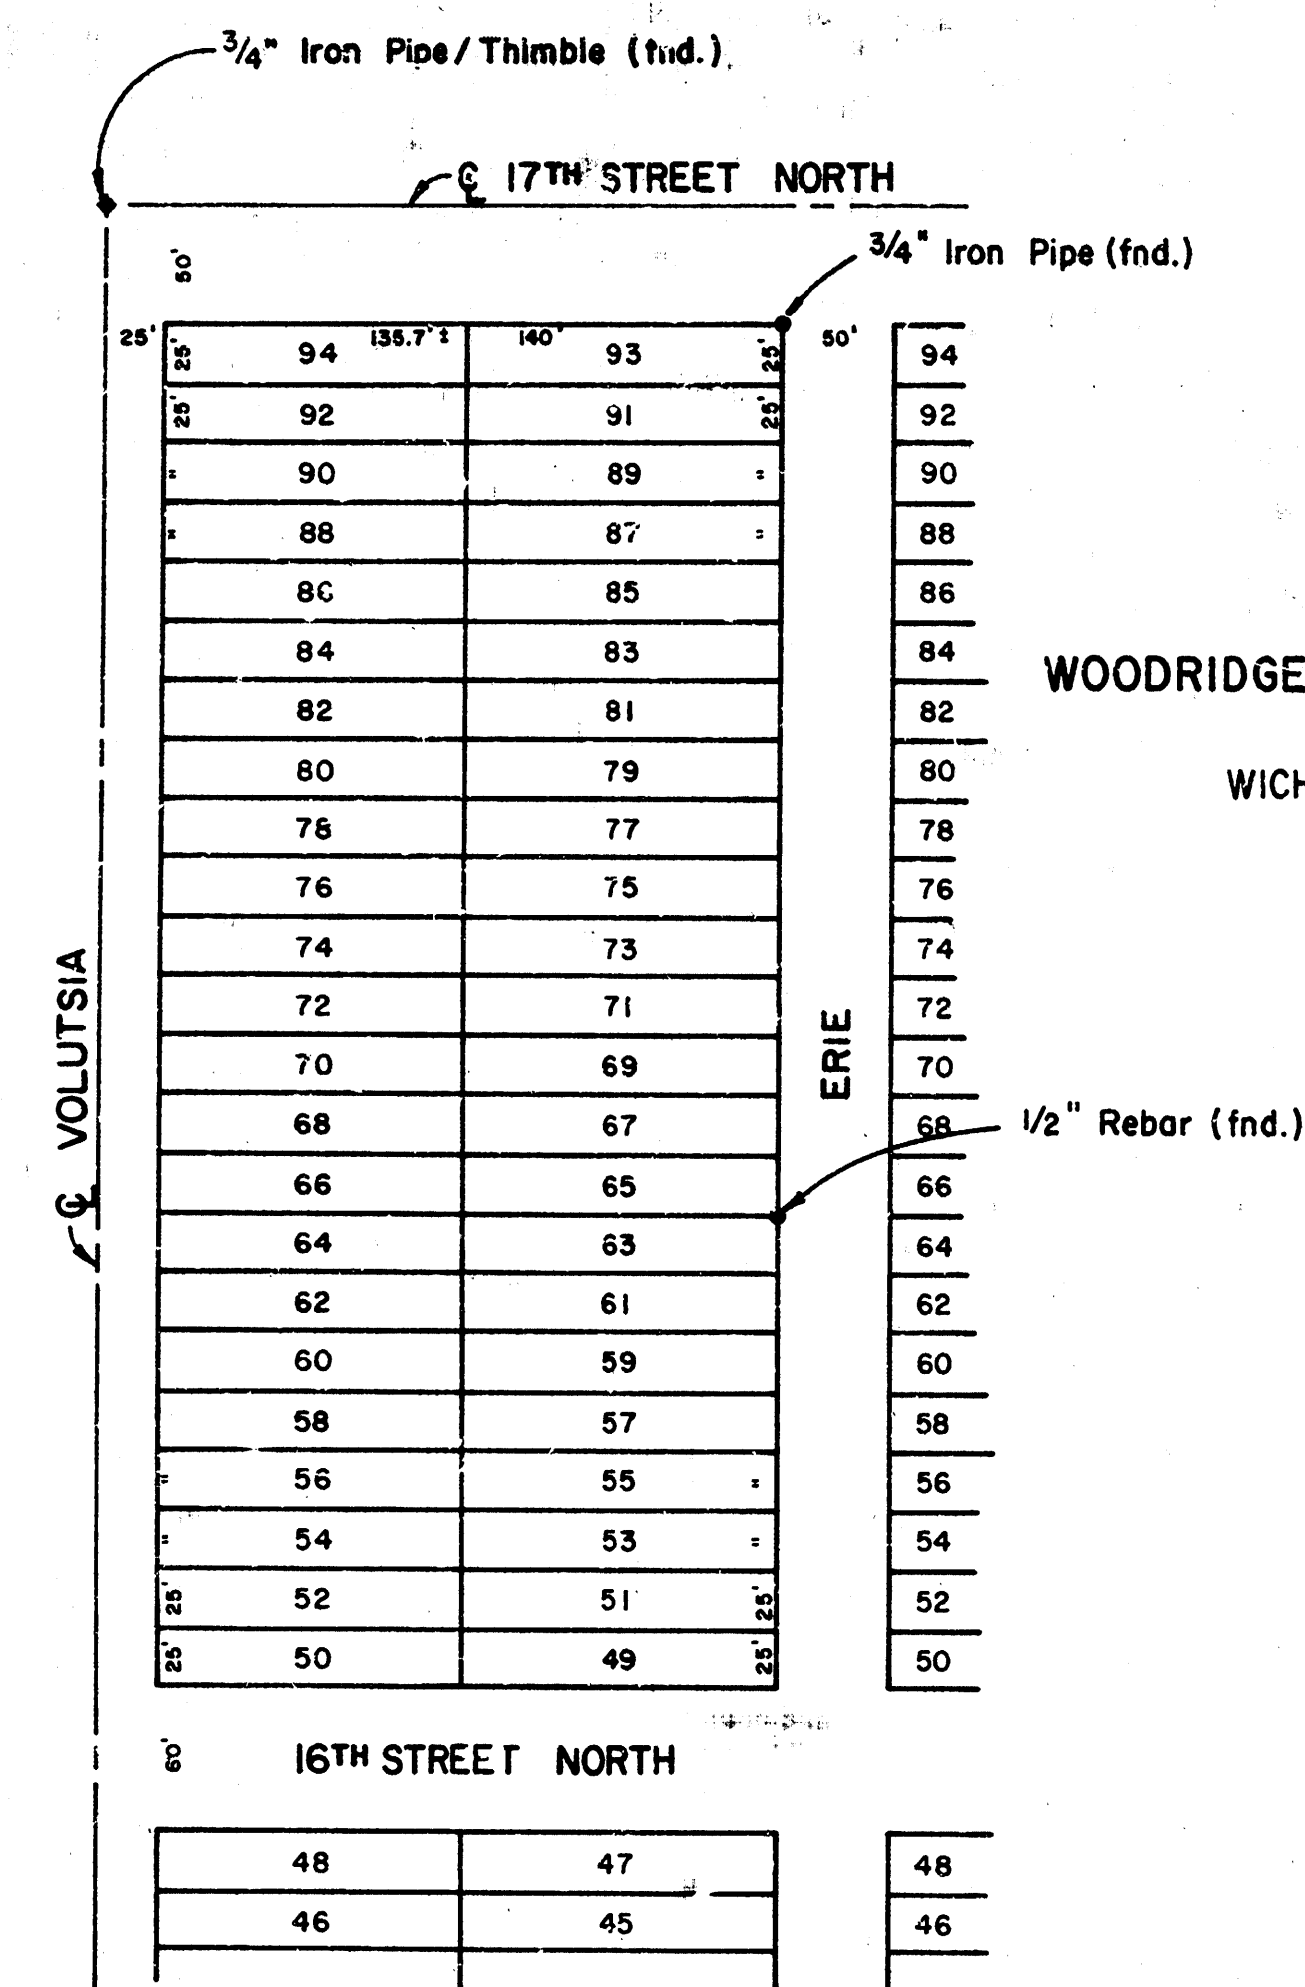

GENERAL NOTES



1. ALL CONSTRUCTION AND MATERIALS TO COMPLY WITH CITY OF WICHITA SPECIFICATIONS AND STANDARDS.
2. ALL ELEVATIONS SHOWN ARE CITY OF WICHITA DATUM (JSGS-1187.4 = CITY DATUM).
3. AT LEAST 48 HOURS PRIOR TO BEGINNING EXCAVATION, IF REQUIRED, (EXCLUDING WEEKENDS AND HOLIDAYS), THE CONTRACTOR SHALL CONTACT THE KANSAS ONE-CALL SYSTEM, A UTILITY LOCATION SERVICE, AT (316) 687-2470 TO REQUEST THE FOLLOWING UTILITY COMPANIES TO LOCATE ANY EXISTING LINES WITHIN THE PROJECT AREA: GAS SERVICE COMPANY, K.G.B.E., THE WICHITA WATER DEPARTMENT, AND AIR CAPITAL CABLEVISION.
4. THE CONTRACTOR MUST ALSO NOTIFY THE TELEPHONE COMPANY AT (316) 571-2115 48 HOURS PRIOR TO BEGINNING EXCAVATION, IF REQUIRED, AND REQUEST THAT ANY LINES WITHIN THE PROJECT AREA BE FLAGGED.
5. THE BURIED UTILITIES AS LOCATED ON THE PLANS ARE APPROXIMATE LOCATIONS ONLY. IT SHOULD BE NOTED THAT OTHER BURIED LINES AND CABLES MAY EXIST WHICH ARE NOT SHOWN ON THESE PLANS. THE CONTRACTOR SHALL EXERCISE EXTREME CAUTION DURING TRENCHING OPERATIONS TO AVOID DAMAGING THESE LINES. ANY LINES DAMAGED SHALL BE REPLACED OR REPAIRED IMMEDIATELY AS DIRECTED BY THE ENGINEER AT THE CONTRACTOR'S EXPENSE.
6. THE CONTRACTOR SHALL RESTORE ALL DITCHES, SWALES, ROAD SHOULDERS, ENTRANCES, AND BANK LINES TO THEIR ORIGINAL SLOPES AND GRADES EXCEPT AS SHOWN OTHERWISE.
7. THE CONTRACTOR SHALL BE RESPONSIBLE FOR PRESERVING PROPERTY IRONS. THE CONTRACTOR SHALL BE REQUIRED TO RE-ESTABLISH ANY PROPERTY IRONS WHICH ARE DAMAGED OR DESTROYED BY HIS CONSTRUCTION OPERATIONS. SUCH IRONS SHALL BE RE-ESTABLISHED BY A LICENSED LAND SURVEYOR OR A LICENSED PROFESSIONAL ENGINEER IN ACCORDANCE WITH STATE LAWS. ALL COSTS FOR THIS WORK SHALL BE SUBSIDIARY TO THE OTHER ITEMS OF WORK.
8. CONTRACTOR SHALL PROVIDE POSITIVE DRAINAGE AWAY FROM ALL MANHOLE COVERS.
9. CONTRACTOR WILL BE REQUIRED TO GIVE ALL PROPERTY OWNERS AND/OR TENANTS DIRECTLY AFFECTED BY THE CONSTRUCTION OF THIS PROJECT A MINIMUM ADVANCE NOTICE OF SEVEN DAYS PRIOR TO STARTING CONSTRUCTION. THE CONTRACTOR SHALL AGAIN NOTIFY RESIDENTS IMMEDIATELY PRIOR TO BEGINNING WORK THAT SEWER SERVICE WILL BE DISRUPTED.
10. TREES THAT CAN BE SAVED SHALL BE SAVED. CONTRACTOR SHALL CONTACT PROPERTY OWNERS PRIOR TO REMOVING ANY TREES, SHRUBS, OR OTHER VEGETATION.
11. ANY HOUSE LATERALS OR LINES WHICH ARE REMOVED FROM SERVICE DURING CONSTRUCTION, SHALL BE RECONNECTED AND RESTORED TO USE BY THE CONTRACTOR AS SOON AS FEASIBLE.
12. ONLY ACTIVE BUILDING SEWER LINES WHICH CONNECT ACTUAL BUILDINGS TO THE SEWER SYSTEM ARE TO BE RECONNECTED TO THE NEW SEWER CONSTRUCTION. BUILDING SEWER LINES AND/OR CONNECTIONS WHICH HAVE BEEN ABANDONED ARE NOT TO BE RECONNECTED TO THE NEW SEWER CONSTRUCTION. IT WILL BE THE SOLE RESPONSIBILITY OF THE CONTRACTOR TO ASCERTAIN WHICH SUCH BUILDING SEWER LINES AND/OR CONNECTIONS ARE ACTIVE AND WHICH SUCH SEWERS AND/OR CONNECTIONS HAVE BEEN ABANDONED. ALL WORK INVOLVED WITH BUILDING SEWER LINE CONSTRUCTION AND/OR BUILDING SEWER CONNECTIONS SHALL CONFORM TO THE APPLICABLE SECTION OF THE STANDARD SPECIFICATIONS.
13. THE CONTRACTOR SHALL BE RESPONSIBLE FOR MAINTAINING CONTINUOUS FLOW OF SEWAGE THROUGH CONSTRUCTION. CONTRACTOR'S PROPOSED METHOD FOR MAINTAINING SEWAGE FLOW SHALL BE APPROVED BY THE ENGINEER. COST OF MAINTAINING FLOW OF SEWAGE THROUGH CONSTRUCTION WILL NOT BE PAID FOR DIRECTLY AND THIS COST SHALL BE CONSIDERED AS SUBSIDIARY TO THE OTHER PAY ITEMS OF WORK.
14. ANY FENCE REMOVED FOR CONSTRUCTION SHALL BE REPLACED IN A CONDITION EQUAL TO, OR BETTER, THAN ORIGINAL AT NO ADDITIONAL COST TO THE OWNER.
15. THE CONTRACTOR SHALL BE RESPONSIBLE FOR THE ACQUISITION OF ANY RIGHT-OF-WAY NECESSARY TO COMPLETE THE WORK.

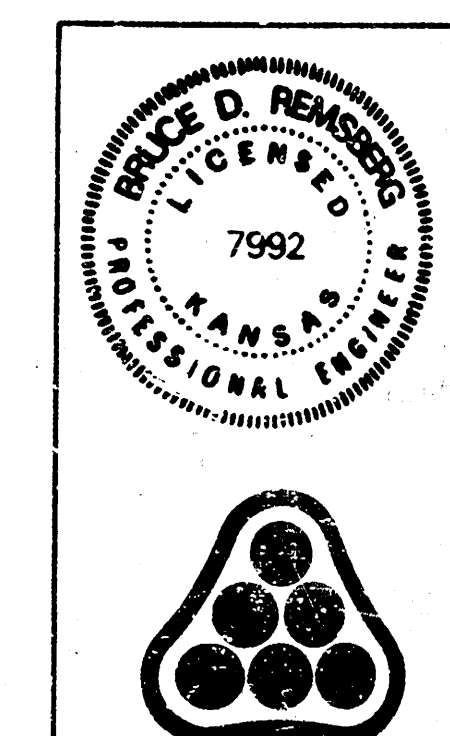

No.	Revision	By	Date
ALTER, REPAIR, RECONSTRUCT, OR CONSTRUCT A PORTION OF DISTRICT P, SANITARY SEWER NO. 12 KEY MAP			
MICHAEL E. LINDEBAK, P.E. CITY ENGINEER CITY OF WICHITA PROJECT NO. 468-76-245-81472-000-000-001			
PROFESSIONAL ENGINEERING CONSULTANTS, P.A.			
ENGINEERS WICHITA, KANSAS			
Designed by	BDR, RFJ	Job No.	34-85301
Drawn by	GM, DM	Date	July, 1985
		Sht.	2 of 3

PLAN	SURVEYED	DATE
	NOTE BOOK	BY
PROFILE	FLATTED	DATE
	NOTE BOOK	BY

PLAN	SURVEYED	DATE
	NOTE BOOK	BY
PROFILE	FLATTED	DATE
	NOTE BOOK	BY

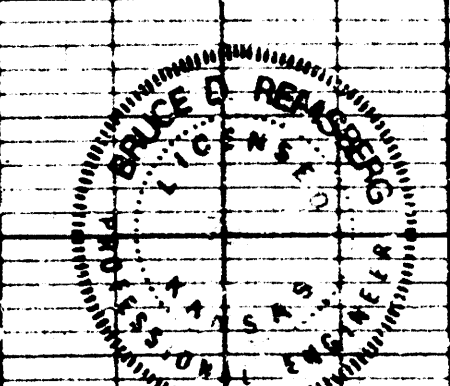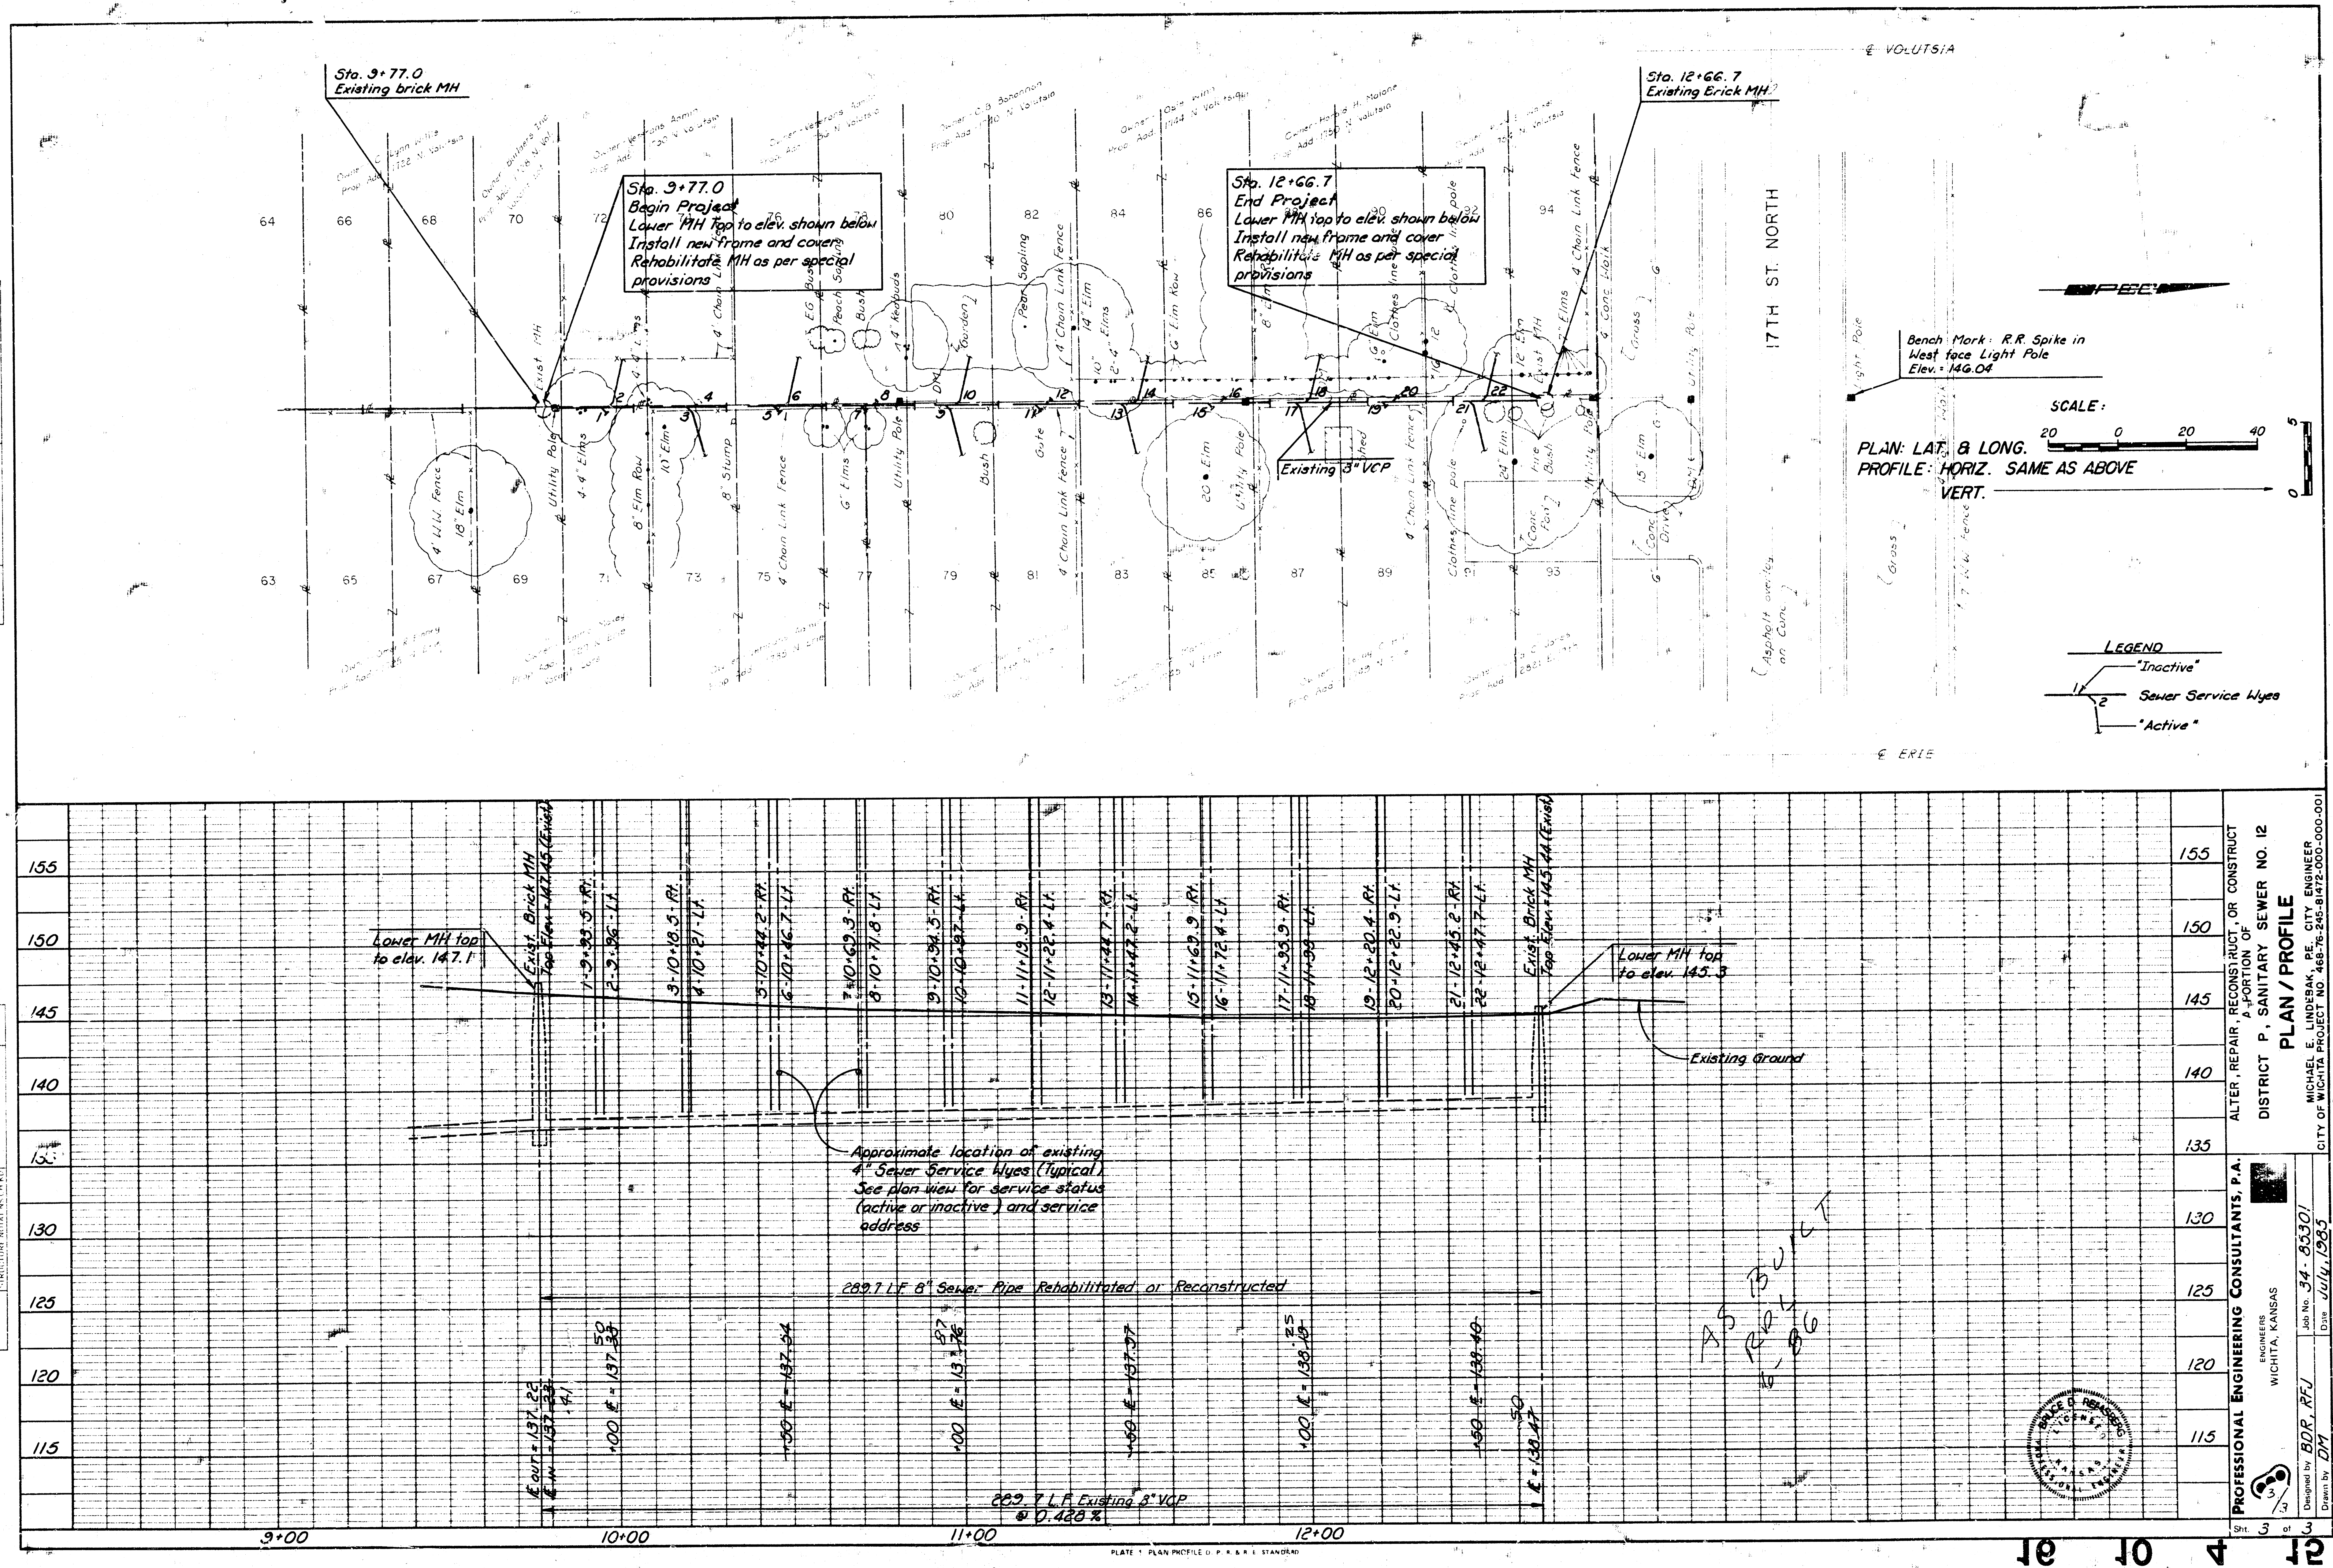

PROFESSIONAL ENGINEERING CONSULTANTS, P.A.
 DISTRICT P, SANITARY SEWER NO. 12
 PLAN / PROFILE
 MICHAEL E. LINDESBAK, P.E., CITY ENGINEER
 CITY OF WICHITA PROJECT NO. 468-16-248-8412-000-001
 Design by BDR, RFJ
 Drawn by DMH
 Date July 4, 1985