


PLAN	CHECKED	DATE
	CHECKED	

PROFILE	CHECKED	DATE
	CHECKED	

Saved: 02-19-2008 2:43:10 PM by BJS
 Plot Scale: 1/20 02-19-2008 3:43:49 PM by BJS
 C:\2007\07448\001\Site Civil\ACCESS ROAD\PRIVATE SWS\07448-001-C-SWS LINE 1

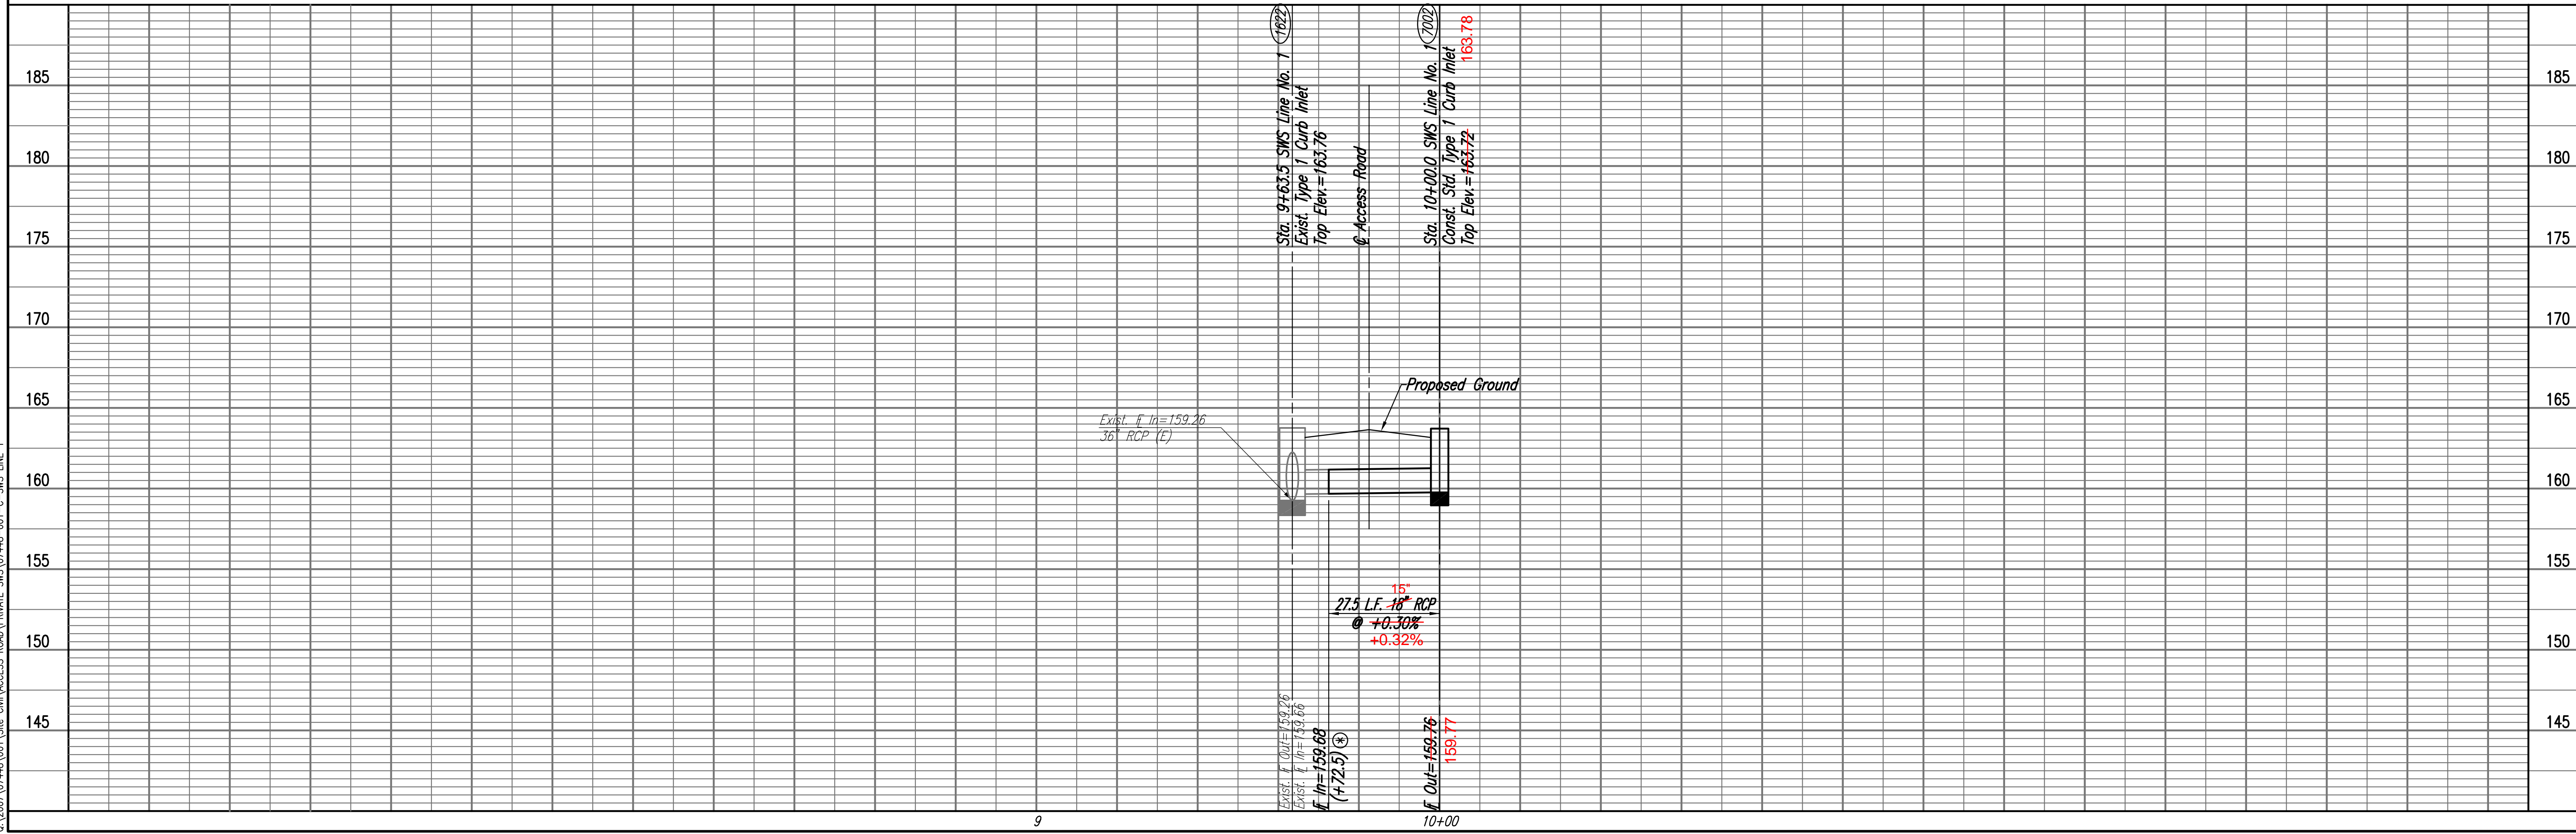


Sta. 9+72.5 SWS Line No. 1=
 Access Road Sta. 14+96.05, 10.0' Lt.
 Remove Exist. Pipe Plug and
 Install 27.5 L.F. 18" RCP (S) ⑦

Exist. SWS Curb Inlet #7
 Top Elev.=163.76
 In=159.66 18" RCP (S)
 In=159.26 36" RCP (E)
 Out=159.26 36" RCP (W)

Sta. 9+63.5 SWS Line No. 1=
 Access Road Sta. 14+96.05, 19.0' Lt.
 Exist. Top Elev.=163.76

Sta. 10+00.0 SWS Line No. 1=
 Access Road Sta. 14+96.05, 17.50' Rt.
 Const. Std. Type 1 Curb Inlet
 L=6'-4", W=4'-4"
 Top Elev.=163.72 163.78
 See Sheet No. 8.

⊗ PRIOR TO BEGINNING CONSTRUCTION, THE CONTRACTOR SHALL EXCAVATE THE EXISTING 18" RCP AT STATION 9+72.5 TO VERIFY PIPE SIZE, TYPE, AND HORIZONTAL AND VERTICAL LOCATION. THE CONTRACTOR SHALL REPORT HIS FINDINGS TO THE ENGINEER SO THAT ANY NECESSARY PLAN MODIFICATIONS MAY BE MADE. ANY ADDITIONAL LABOR OR MATERIALS NECESSARY TO COMPLETE THE CONNECTION SHALL BE CONSIDERED SUBSIDIARY TO THE PROJECT.

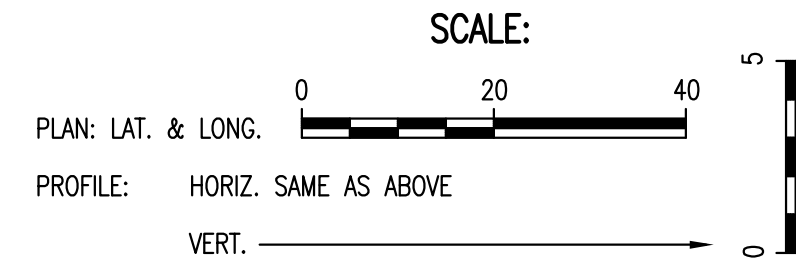

COORDINATE LIST		
POINT	NORTH	EAST
1622	7,412.3378	4,182.1799
7000	7,403.3300	4,182.1743
7001	7,377.3375	4,181.5494
7002	7,375.8379	4,181.5134

①② = COORDINATE POINT NO.

ASBUILT - MAY 1, 2008

NEWMARKET SQUARE-PHASE 2
 PRIVATE STORM WATER SEWER IMPROVEMENTS
SWS LINE NO. 1
 JAMES L. ARMOUR, P.E. - CITY ENGINEER
 CITY OF WICHITA PRIVATE PROJECT NO. 1830 PPS (607861)

Professional Engineering Consultants, P.A.
 303 S. TORRENS WICHITA, KANSAS 67202
 316-262-2091 • FAX 316-262-3003
 Designed By: BMM
 Drawn By: BUS, FAT
 Job No.: 35-07448-001
 Date: August 2007