


**AS-BUILT FEBRUARY 2008**

SCALE: 1" = 40'

0 20 40 80

0 20 40 80

SCALE: HORIZ. 1" = 40'  
SCALE: VERT. 1" = 5'

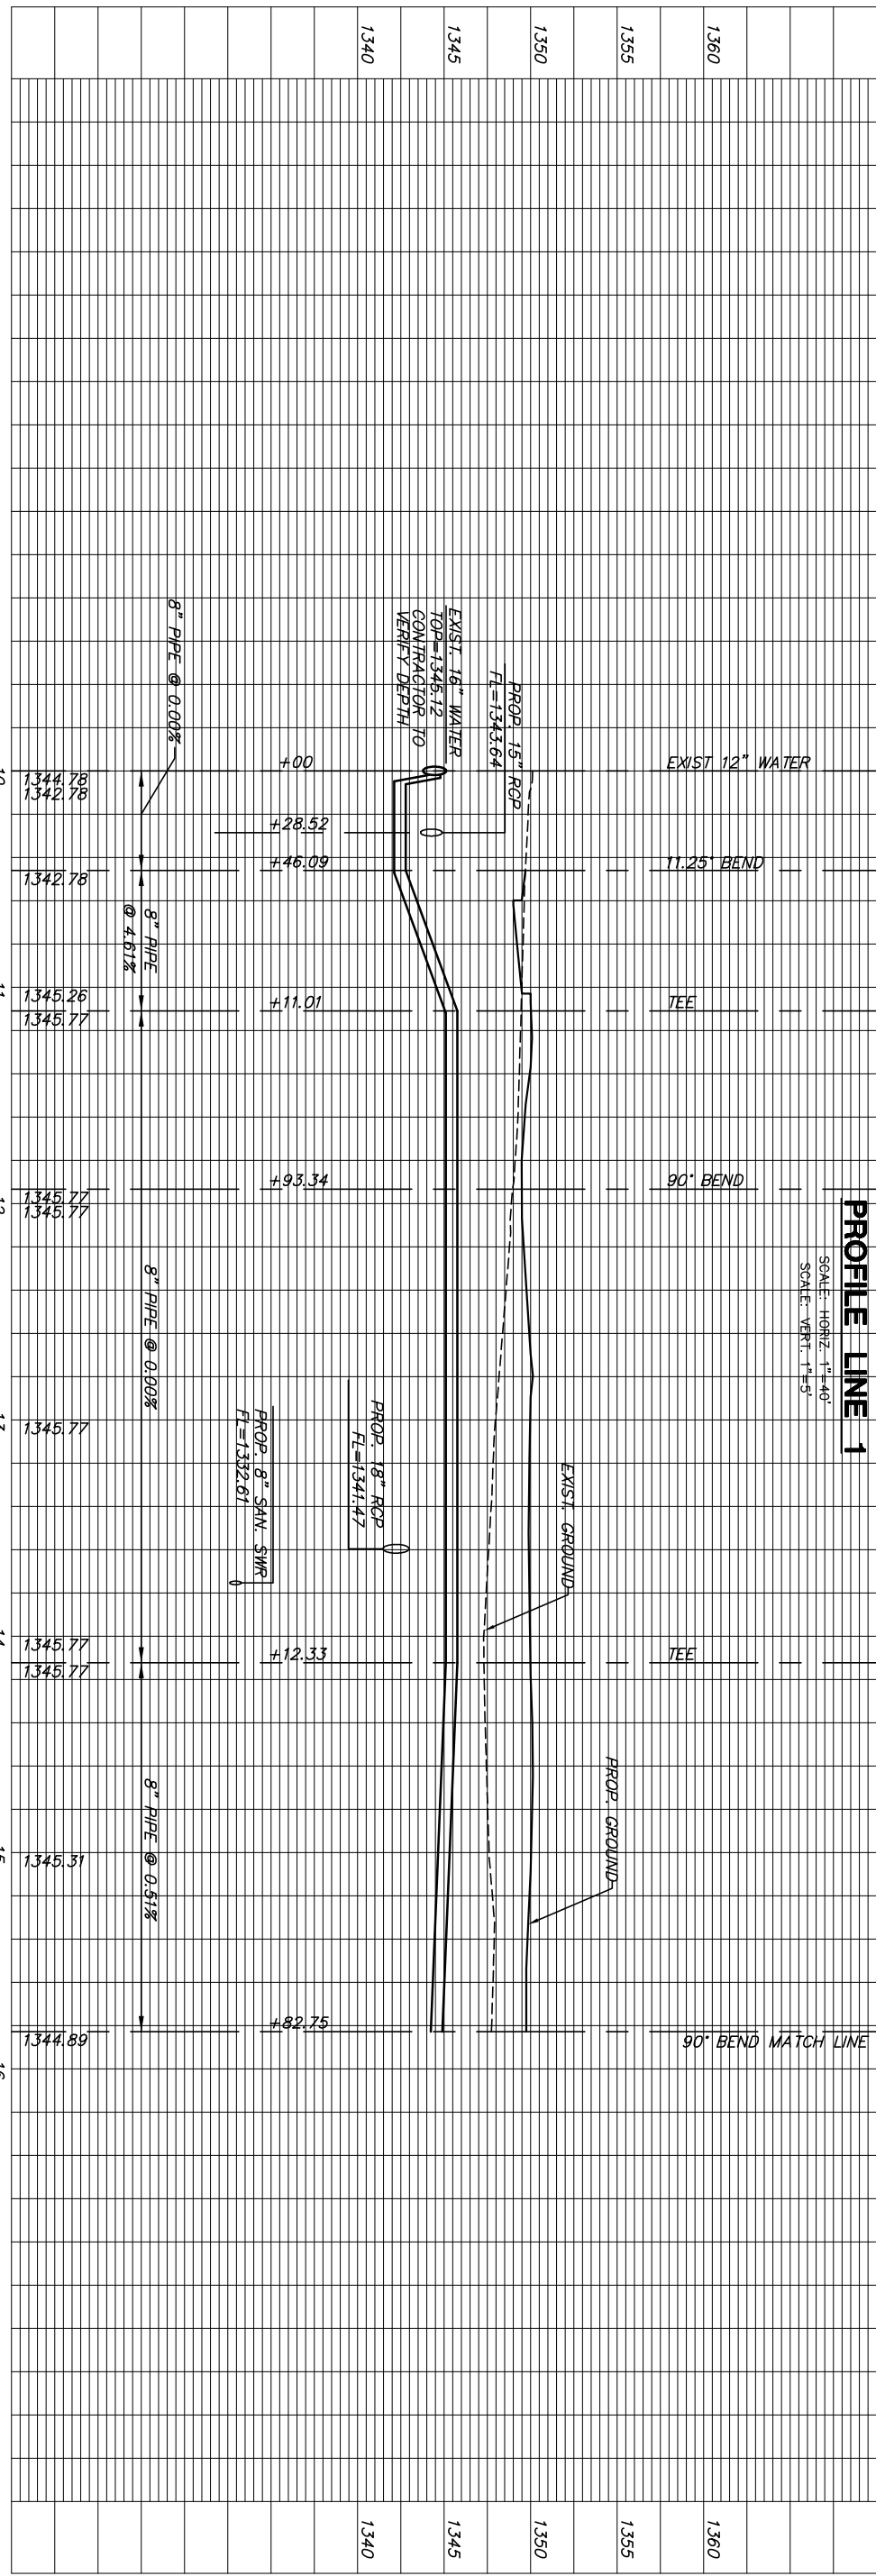

ISSUED	October 2007
REVISION	
SHEET NO.	3 of 8

DESIGN BY	JTC
DRAWN BY	JWC
CHECKED BY	GJA

SHEET TITLE	LINE 1
PROJECT NUMBER	07254 (MKEC)

**WATER DISTRIBUTION PLANS**

# THE GROVE AT WICHITA

LOT 1, BLOCK 1 CAMPUS CREST

**MKEC**  
ENGINEERING  
CONSULTANTS, INC.

411 N. WEBB ROAD  
WICHITA, KS 67206  
316-684-9600