


NOTE: CONST. 6" CONCRETE SLAB AROUND LIFT STATION A MINIMUM OF 10' EACH DIRECTION FROM WET WELL. ELEV. OF SLAB AT WET WELL TO BE 6" ABOVE PROPOSED WALK ELEV. ON YELLOWSTONE DRIVE. TOP OF WET WELL TO BE 6" ABOVE TOP OF SLAB. SLAB TO EXTEND TO WEST R/W LINE OF YELLOWSTONE DRIVE. DOORWAY TO MANHOLE ON LIFT STATION TO BE SET FACING YELLOWSTONE DRIVE.

INSTALL 8" ABS. COMPOSITE PIPE STUB SOUTH AND 10" ABS. COMPOSITE PIPE EAST OUT OF WET WELL MANHOLE


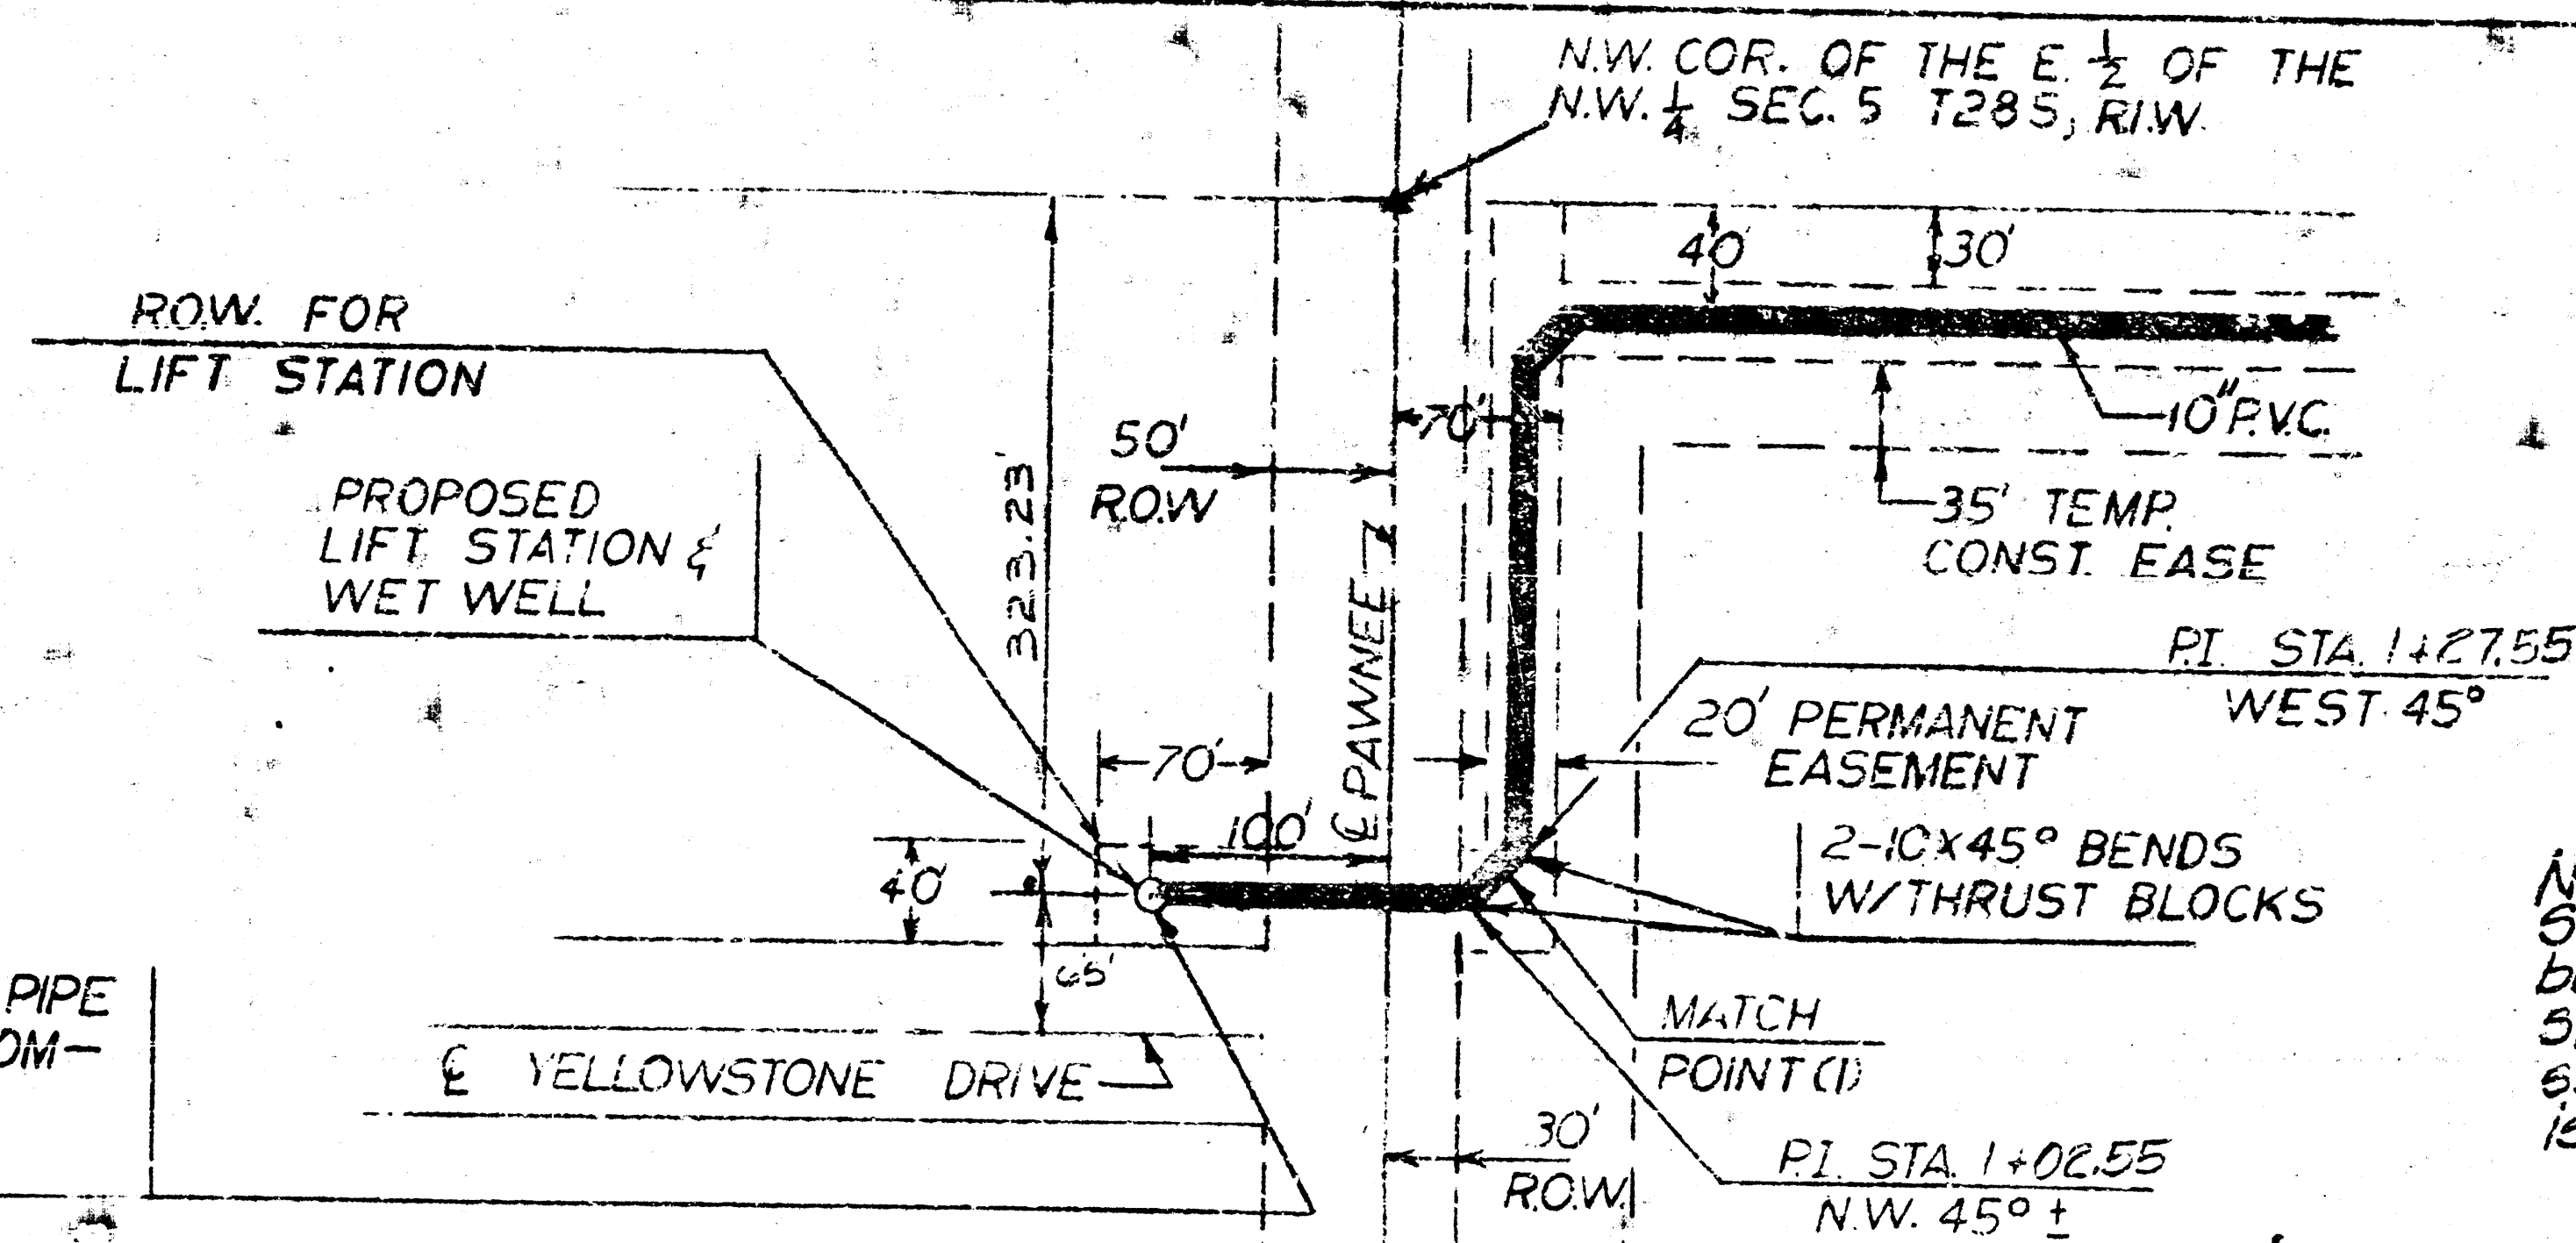


NOTE: P.V.C. FORCE MAIN TO BEGIN 5' NORTH OF WET WELL. FLANGE ADAPTER REQUIRED FOR CAST IRON DISCHARGE FROM WET WELL.

10" PVC SHALL BE 160 P.S.I. SDR 26

Note: Force Main from Sta. 0+39.77 to 4+00 to be installed after Pawnee Street grades have been set and when Lift Station is installed.

Horizontal Scale: 1" = 100'
Vertical Scale: 1" = 10'

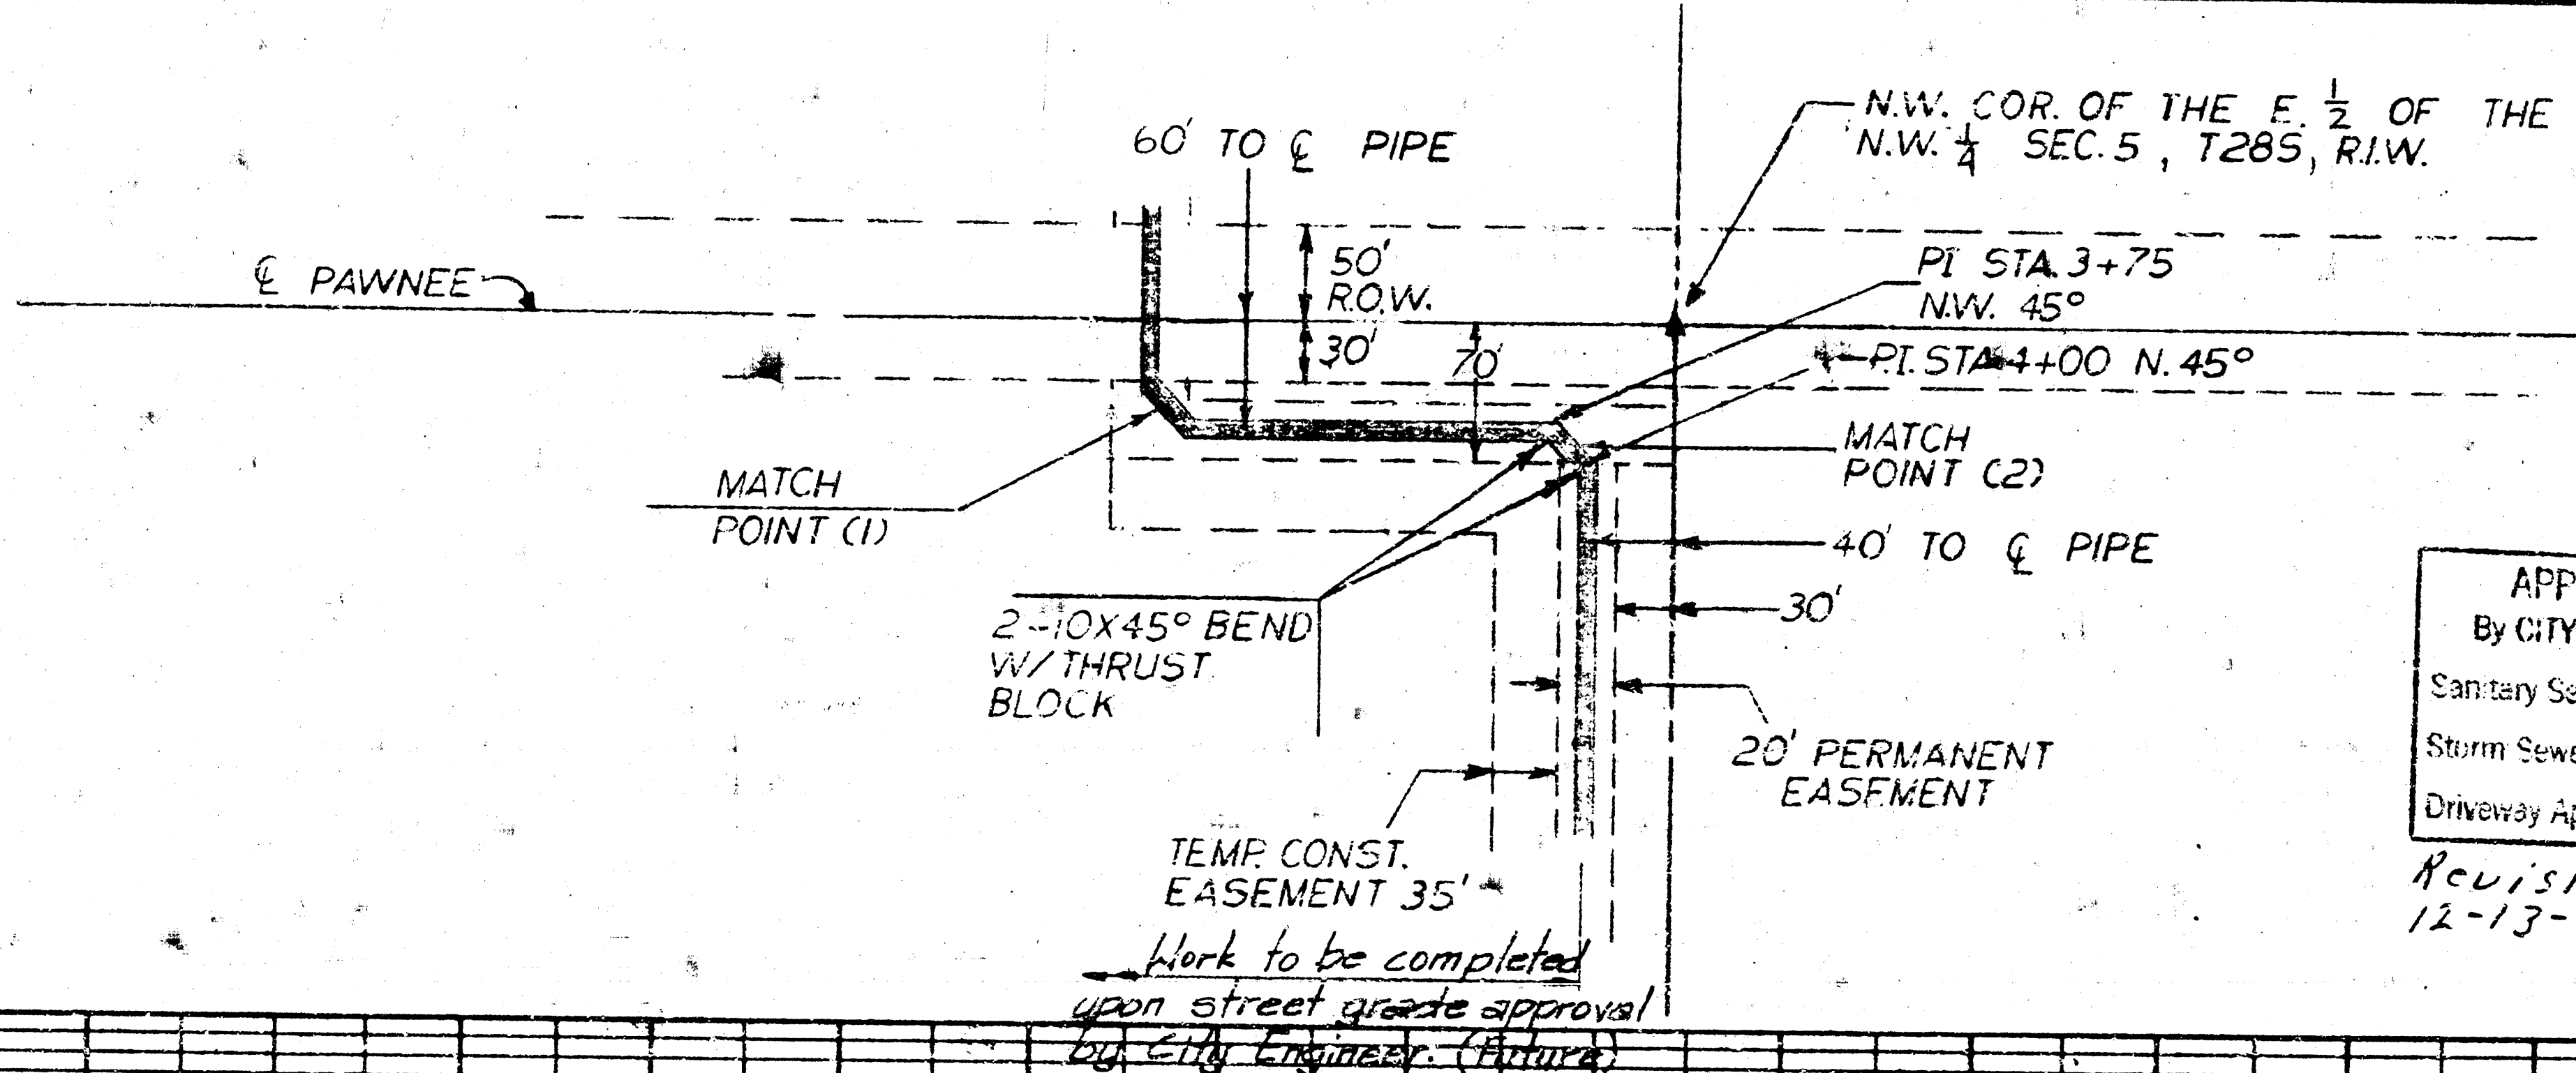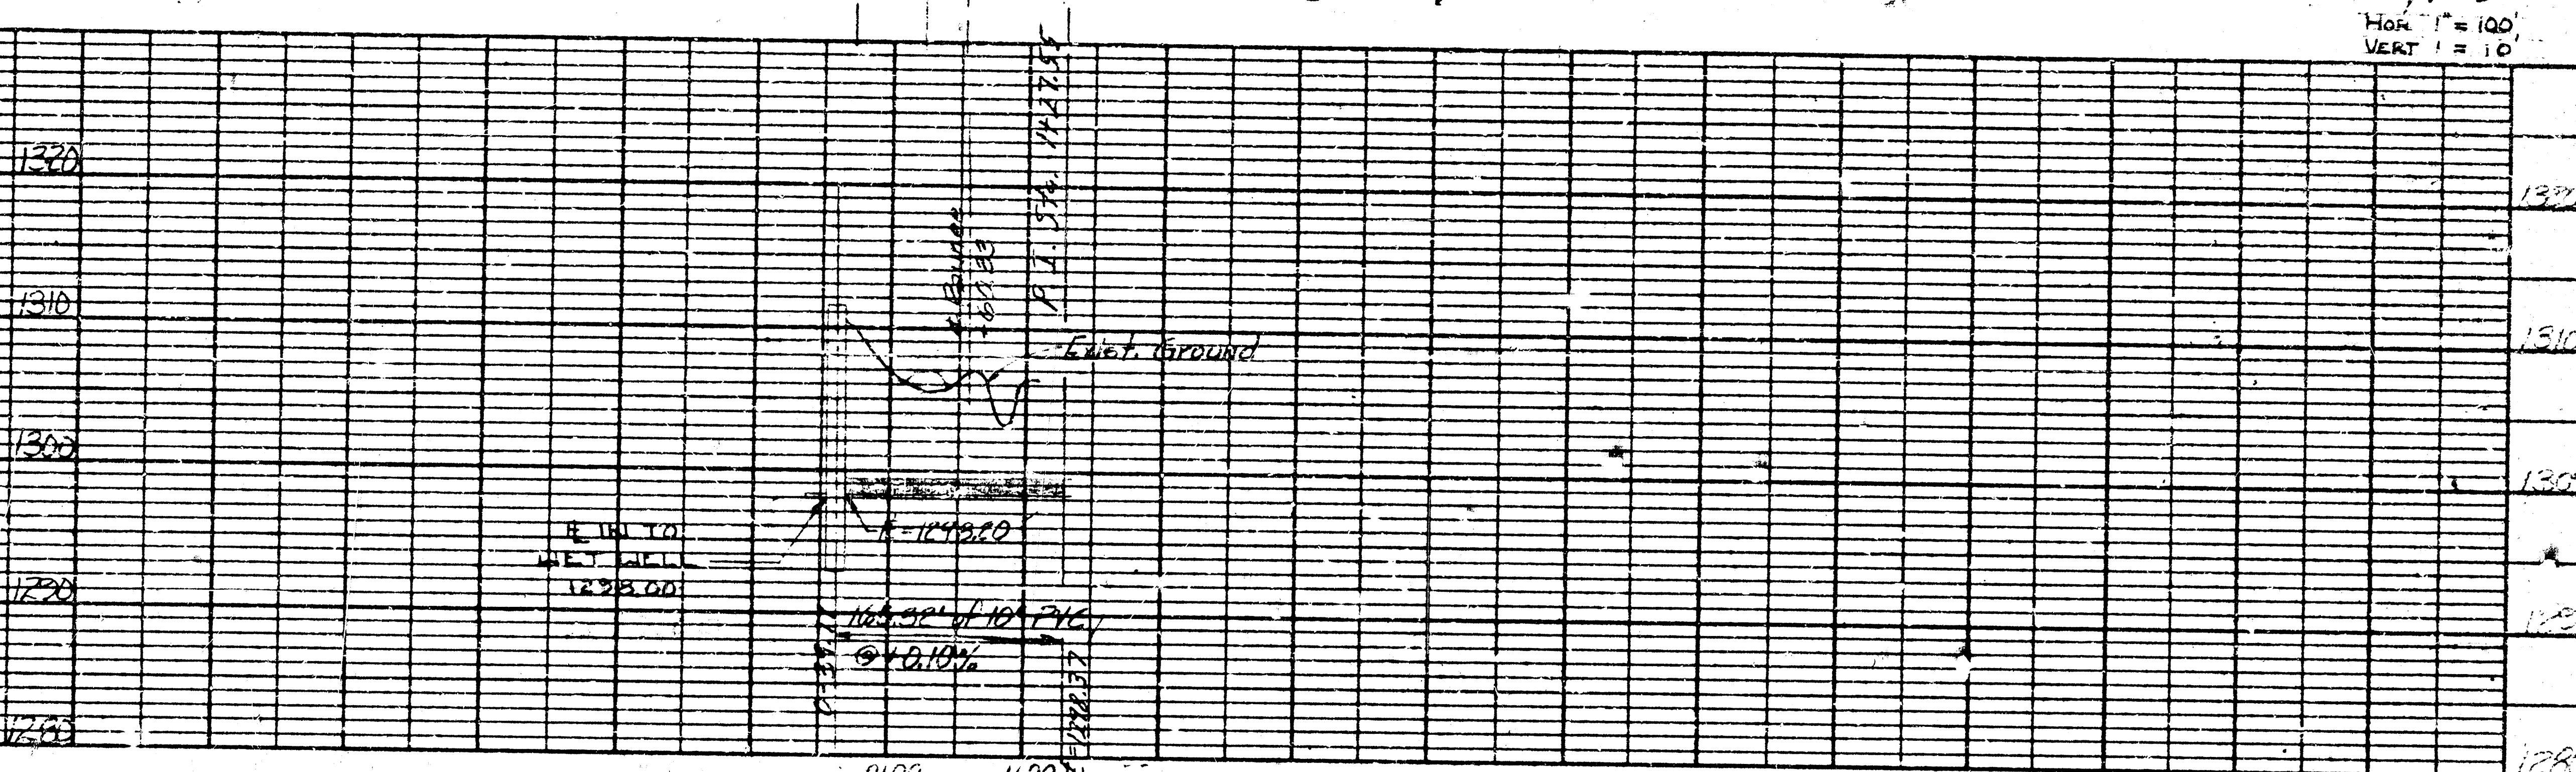


NOTE TO BE ADHERED TO: This project will be constructed under the supervision of the City Engineer. The contractor shall be responsible for obtaining all necessary permits and for the safety of all construction personnel.


11-22-76
APPROVED AS NOTED
By CITY ENGINEER OF WICHITA
Sanitary Sewers: D.E.S.
Storm Sewers: _____
Driveway Approaches: _____

Revisions Approved
12-13-76 D.E.S.

Horizontal Scale: 1" = 100'
Vertical Scale: 1" = 10'

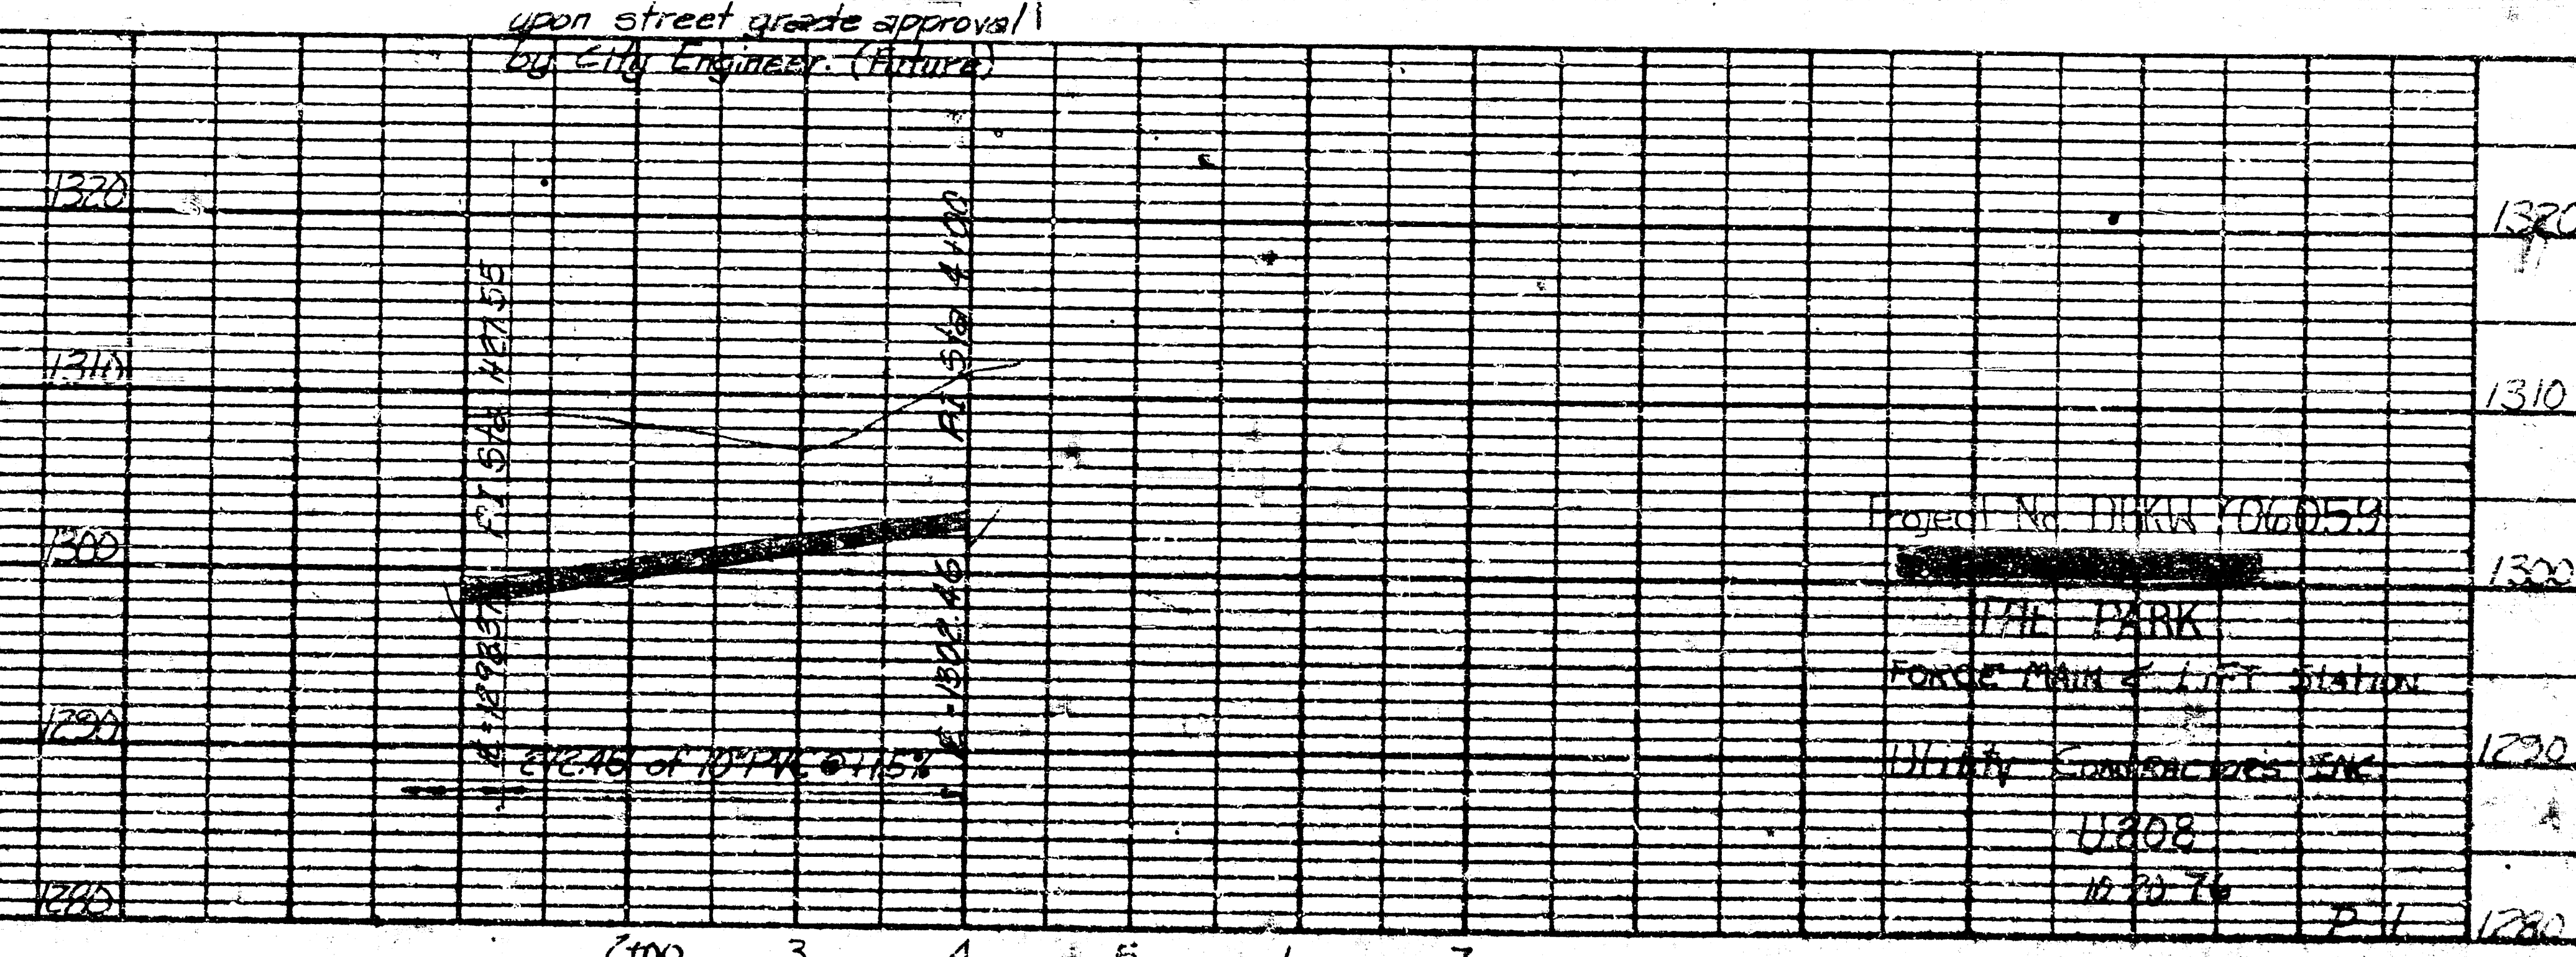

Project No. DUKW 7060159
WILE PARK
FORCE MAIN & LIFT STATION
Utility Construction, Inc.
11/20/76
P.V.

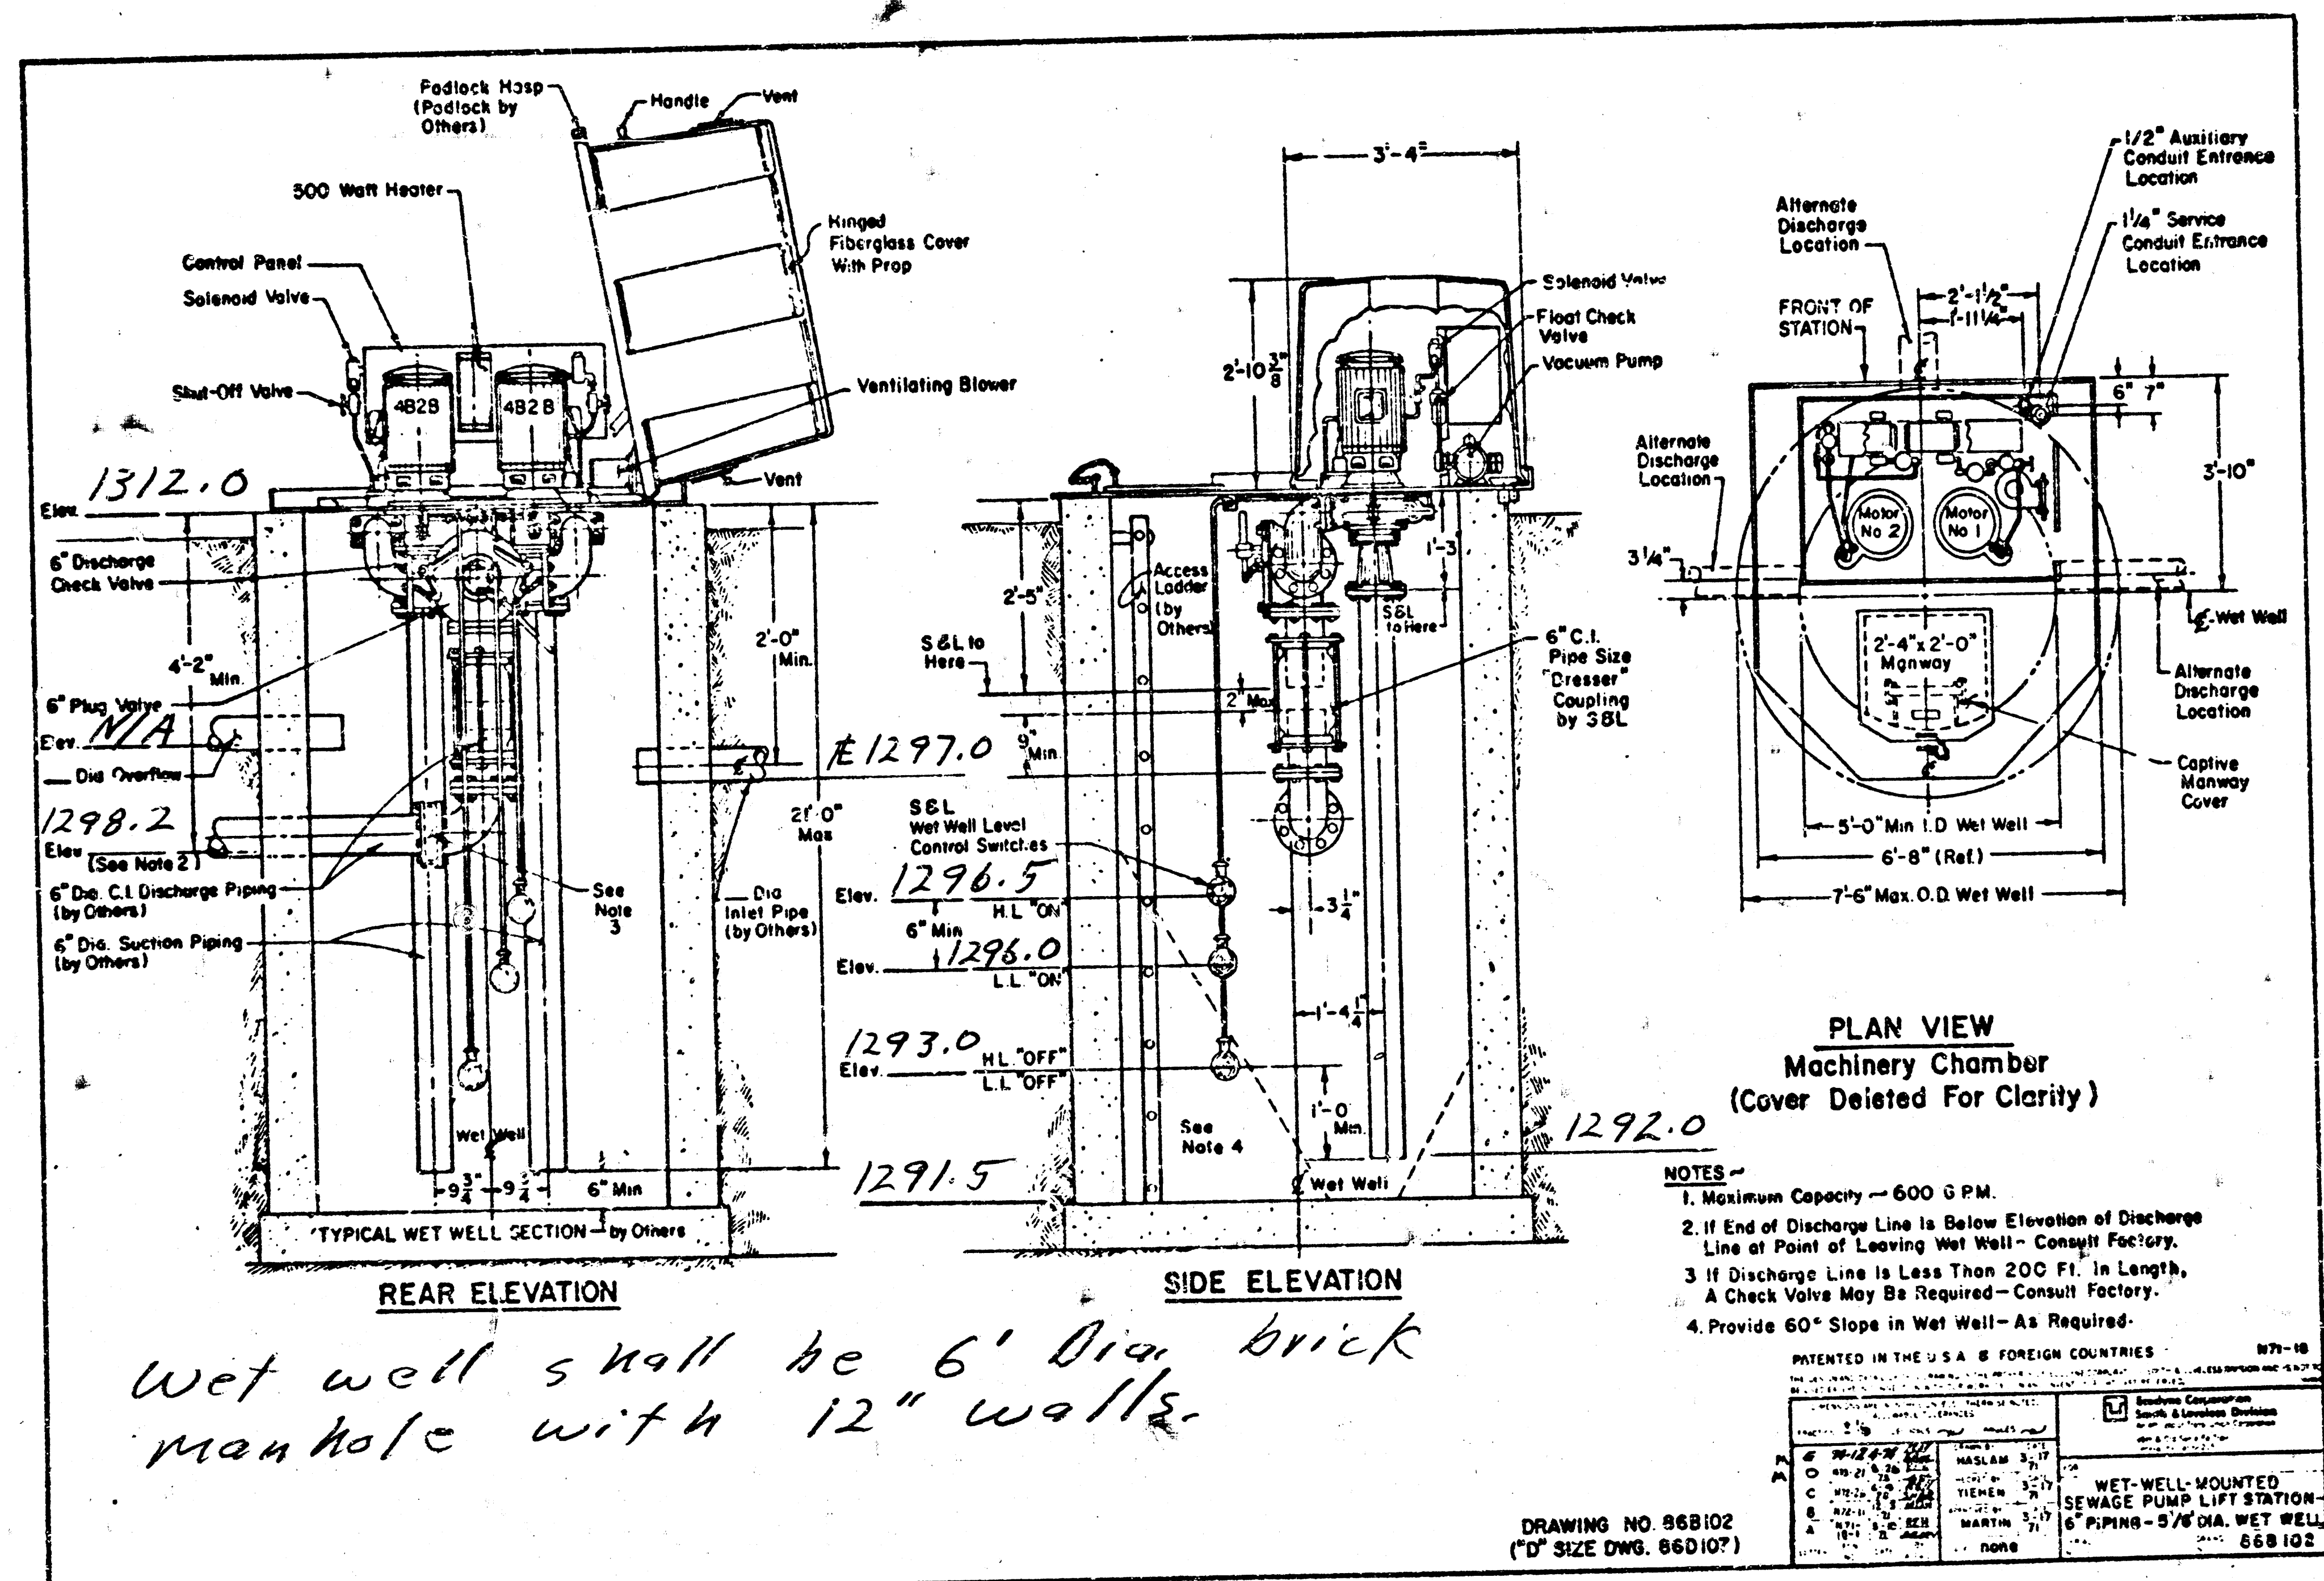

Wet Well Mounted
Outline Drawings
Page 3
January, 1975

Proj: #DBRW 706059
Lift station for The Park

