

# CITY OF WICHITA, KANSAS

## MICHAEL E. LINDEBAK, P.E., CITY ENGINEER

# SANITARY SEWER AND STORM SEWER IMPROVEMENTS

## IN PINEHURST APARTMENTS PRIVATE PROJECT NO. 834PPS INDEX CODE 607861

### LEGAL DESCRIPTION


Lot 2, Block 1, The Ritz, an addition to the City of Wichita, Sedgewick County, Kansas

### GENERAL NOTES

- The Contractor is specifically cautioned that the location and/or elevation of existing utilities as shown on these Construction Drawings are based upon records of the various utility companies. This information is not to be relied upon as being exact or complete. It shall be the responsibility of the respective Contractor to notify ONE-CALL at (316) 687-2470, a minimum of 48 hours in advance of any excavation to request the exact field locations of the existing underground utilities. It shall be the responsibility of the respective Contractor to locate all existing utilities which conflict with the proposed improvements as shown on the Construction Drawings.
- The Contractor must notify the following in case of an emergency:
 

Cablevision	(316) 262-4270 or (316) 263-2061
KGE - Gas	(316) 263-7511
KGE - Electric	(316) 264-1141
Peoples Natural Gas	(316) 942-8350 or (316) 263-8161
Southwestern Bell Telephone Co.	1-(316) 571-2611
City of Wichita Water Department	(316) 268-4908
City of Wichita Sewer Maintenance	(316) 268-4071
- City of Wichita Benchmark:
 

Brass Cap set in Concrete  
Approximately 139' East of Southeast Corner of Teal Cove  
2nd Addition, and approximately 51' North of Centerline of East 37th Street North.  
Elevation: 187.63 (City of Wichita Datum)
- Preliminary Surveys: Savoy, Ruggles & Bohm
- Trench excavation and backfill shall be mechanically tamped and tested. Compaction requirements shall be in accordance with the Sitework Specifications.
- Cost of barricades, lights and all items necessary for safe and efficient movement of traffic shall be considered subsidiary to the construction of the pavement and utilities.
- The Contractor shall use extreme caution in the area of existing trees which are to remain, existing manholes, power poles, fences, pavement and utilities, and shall be responsible for any damages.
- It will be the Contractor's responsibility to inform the Engineer of any control points including street centerline and lot corners that may be destroyed during construction so that these points may be offset. The cost of resetting points that have no seen offset will be paid for by the Contractor. Requests for offsets must be made 48 hours in advance.

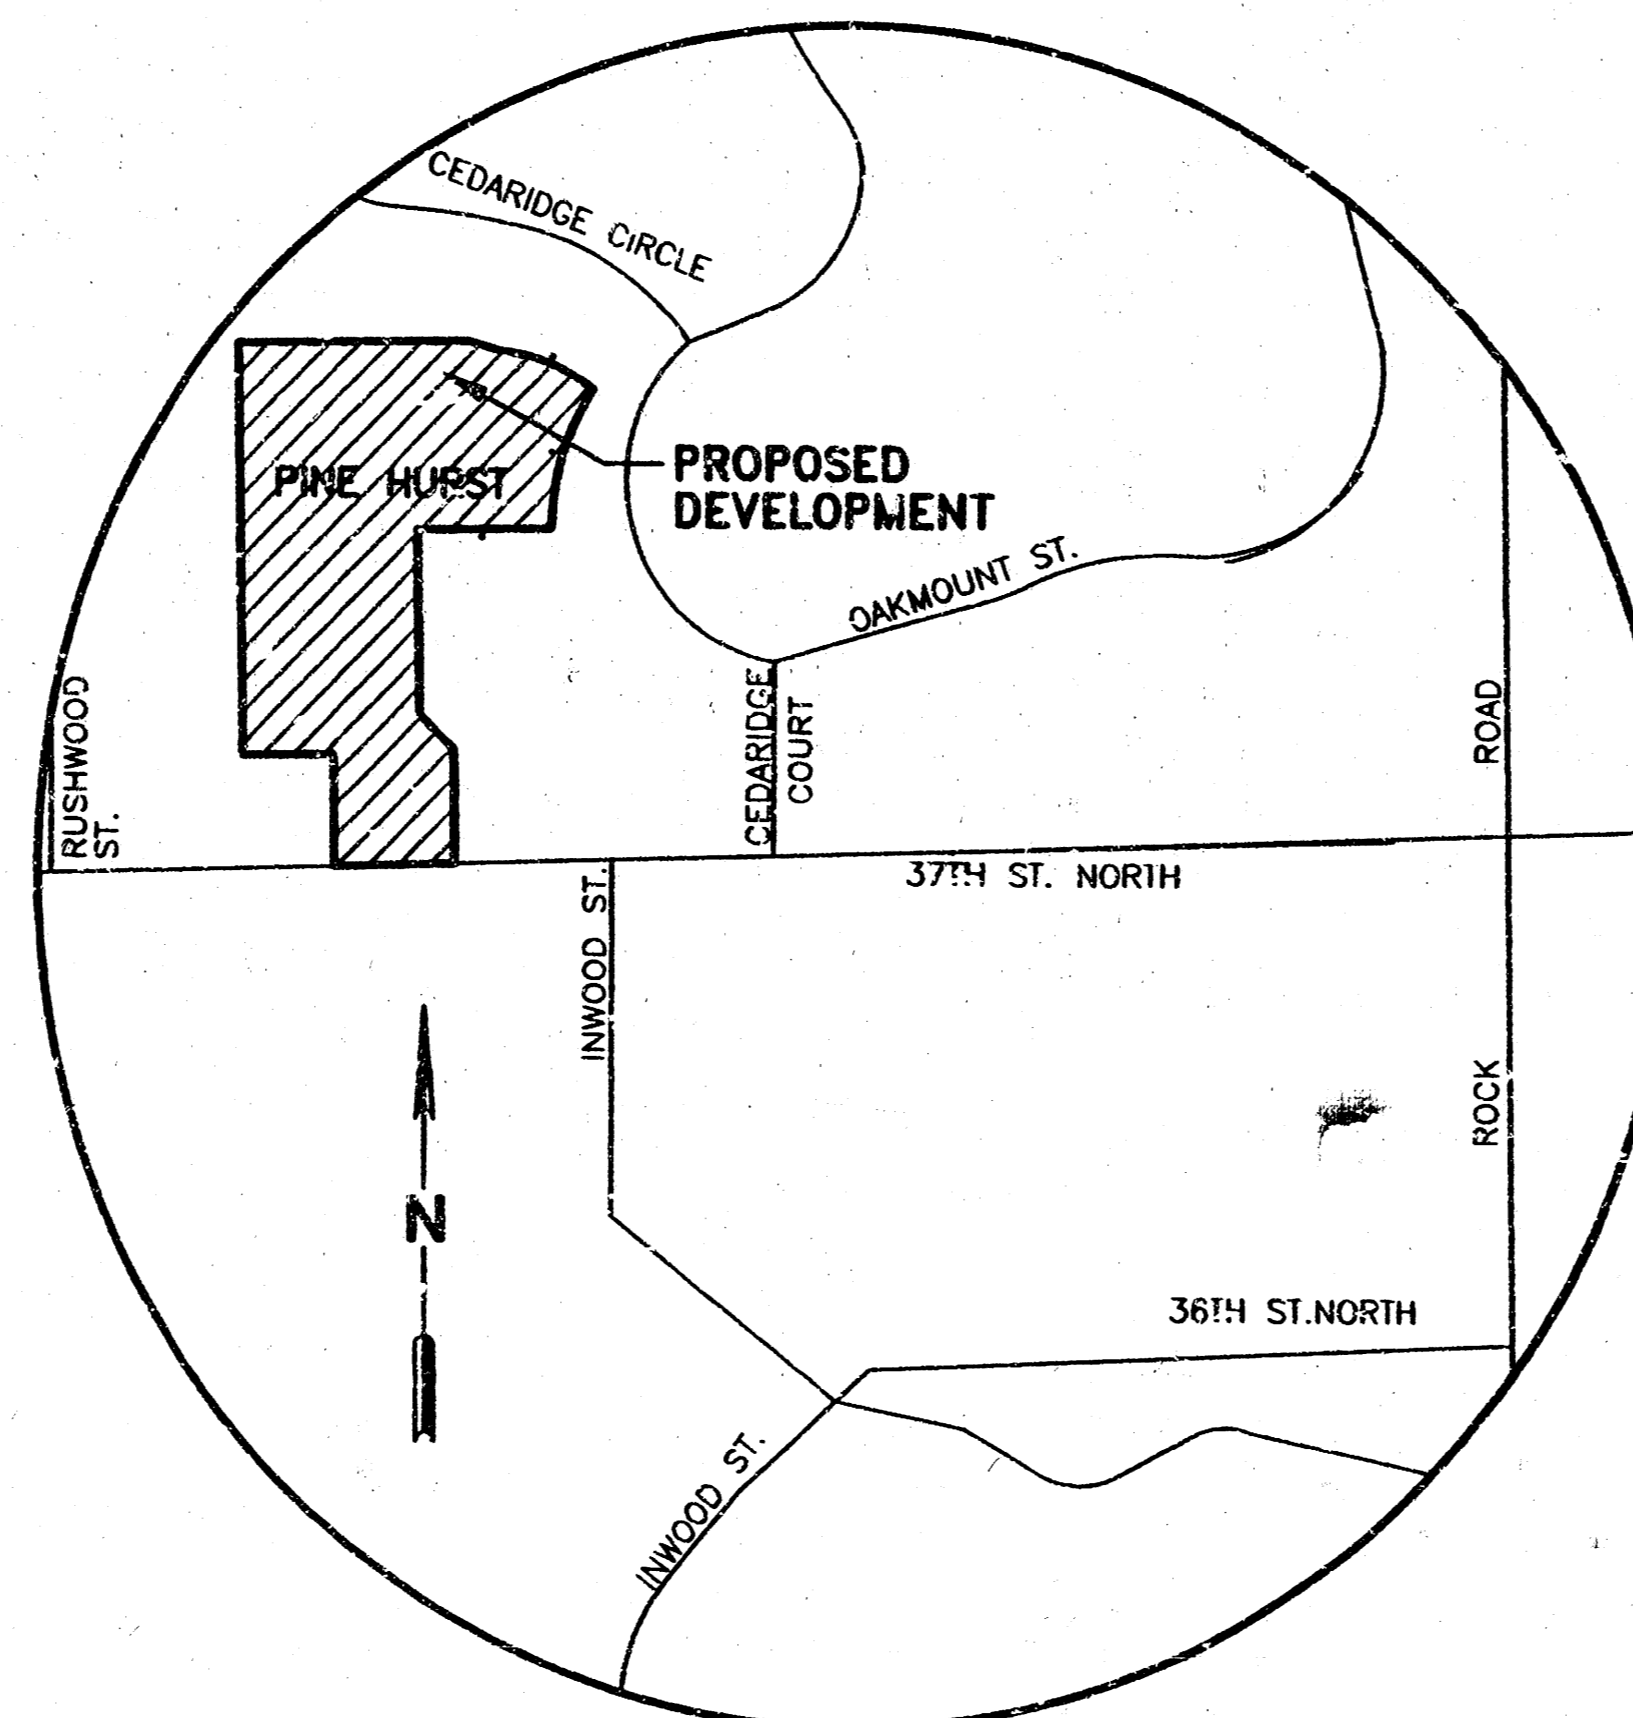

VICINITY MAP

### SHEET INDEX

		NO.
	COVER SHEET	1 of 12
Private Construction	SANITARY PLAN	2 of 12
	SANITARY PROFILES	3 of 12
	SANITARY PROFILES	4 of 12
Private Construction	STORM SEWER PLAN	5 of 12
	STORM SEWER PROFILES	6 of 12
	DOUBLE CURB INLET DETAIL	7 of 12
	STANDARD TYPE "P" MANHOLE DETAIL	8 of 12
	MANHOLE COVER & FRAME DETAIL	9 of 12
	STANDARD TYPE 1-A CURB INLET DETAIL	10 of 12
	DROP INLET DETAIL	11 of 12
	SHALLOW TYPE "P" MANHOLE DETAIL	12 of 12

*U.T. City CONTRACTORS*

*San. Sewer  
Booked  
6-8-99  
P-77  
R.D.L.*

*STORM SEWER  
BOOKED  
6-22-99  
D-824  
McG*

Project Inspected by: BAUGHMAN COMPANY, P.A.  
ASBULLT 11/99 - CLYD BAUGHMAN

APPROVED AS NOTED  
BY CITY ENGINEER OF WICHITA

Sanitary Sewers VRH 9/14/98

Storm Sewers VRH 9/14/98

Driveways/Approaches \_\_\_\_\_

Water Mains \_\_\_\_\_

Paving \_\_\_\_\_

#### NOTE TO CONTRACTORS


**PUBLIC PROPERTY:** Inspection and testing for the Waterline is to be provided by a Licensed Consulting Engineering Firm under contract with the records of the Owner/Developer. Said inspection to be in upon as accordance with the City of Wichita standard construction engineering practices and certified by a Licensed Professional Engineer. No work shall be performed in dedicated easements or public right-of-way by the Contractor without such inspection nor shall any work be commenced without written authorization by the City Engineer. All construction materials shall comply with the City of Wichita Specifications and Standards (on file and available in the City Engineer's Office)

#### ENGINEER'S CERTIFICATE

I hereby certify that these Construction Drawings were prepared by me or under my direct supervision and that I am a Registered Professional Engineer under the laws of the State of Kansas. These Construction Drawings meet the requirements of subdivision approval and the City Engineer's Office design requirements as they apply to construction at the time of this certificate.

*Tony A. Brown*

*9/3/98*  
Date

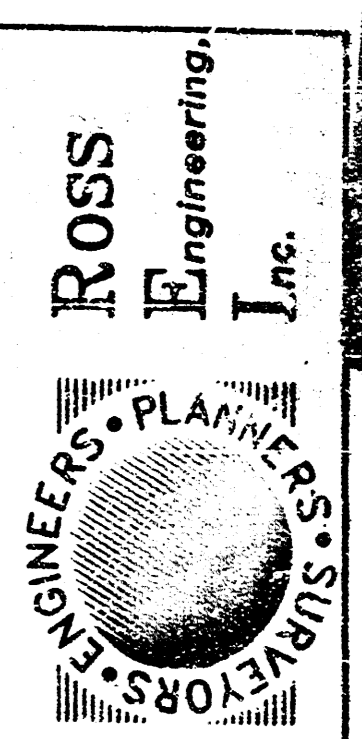

645 M Street  
Suite 201  
Wichita, KS 67208  
Phone: 316-263-7277  
Fax: 316-263-7278

No.	Revisions	Rev. Date


Scale: NONE  
Drawn: JLD  
Checked: JLD  
Approved: JLD

Job: 834-PPS  
Date: 7/12/98  
Page: 9/12

PINEHURST APARTMENTS  
E 37TH STREET N & ROCK ROAD  
WICHITA, KANSAS

COVER SHEET

Sheet No.  
1  
OF  
12

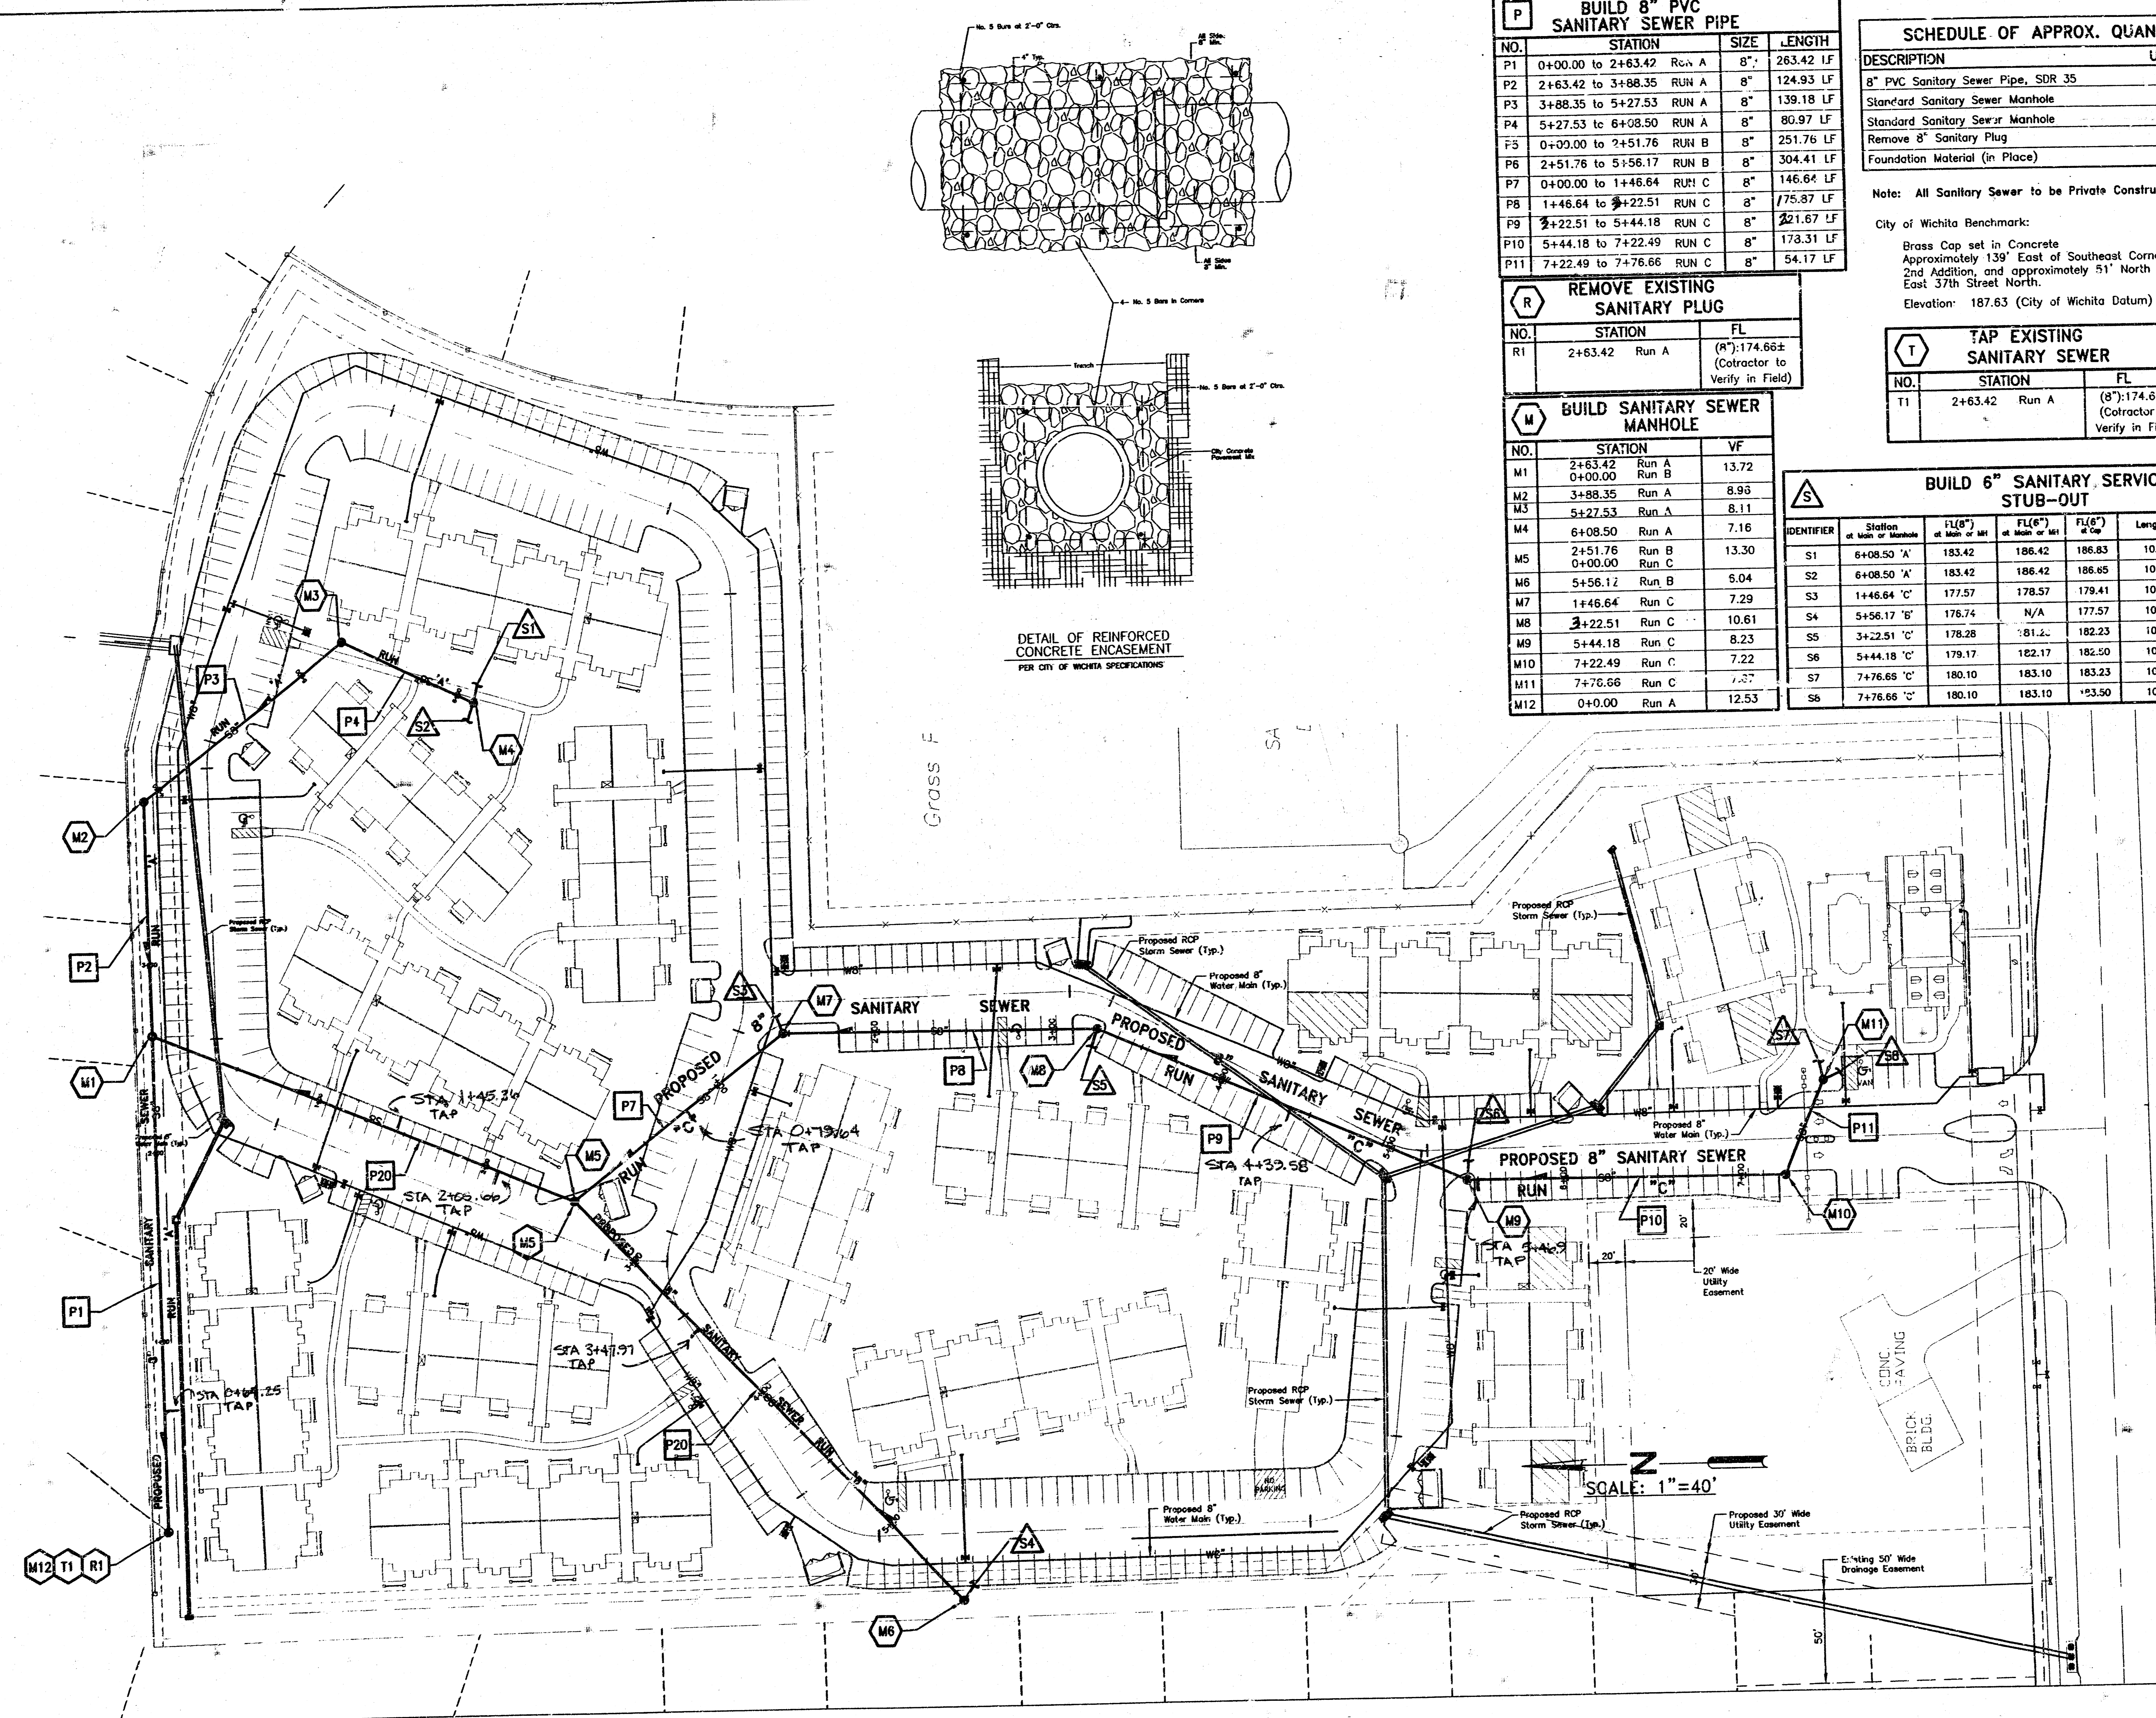

**P BUILD 8" PVC SANITARY SEWER PIPE**

NO.	STATION	SIZE	LENGTH
P1	0+00.00 to 2+63.42	Run A	8" 263.42 LF
P2	2+63.42 to 3+88.35	Run A	8" 124.93 LF
P3	3+88.35 to 5+27.53	Run A	8" 139.18 LF
P4	5+27.53 to 6+08.50	Run A	8" 80.97 LF
P5	0+00.00 to 2+51.76	Run B	8" 251.76 LF
P6	2+51.76 to 5+56.17	Run B	8" 304.41 LF
P7	0+00.00 to 1+46.64	Run C	8" 146.64 LF
P8	1+46.64 to 2+22.51	Run C	8" 175.87 LF
P9	2+22.51 to 5+44.18	Run C	8" 221.67 LF
P10	5+44.18 to 7+22.49	Run C	8" 173.31 LF
P11	7+22.49 to 7+76.66	Run C	8" 54.17 LF

**SCHEDULE OF APPROX. QUANTITIES**

DESCRIPTION	UNITS	QUANT.
8" PVC Sanitary Sewer Pipe, SDR 35	LF	2,330
Standard Sanitary Sewer Manhole	Ea	12
Standard Sanitary Sewer Manhole	VF	112
Remove 8" Sanitary Plug	Ea	1
Foundation Material (in Place)	C.Y.	129

Note: All Sanitary Sewer to be Private Construction  
 City of Wichita Benchmark:  
 Brass Cap set in Concrete  
 Approximately 139' East of Southeast Corner of Teal Cove  
 2nd Addition, and approximately 51' North of Centerline of  
 East 37th Street North.  
 Elevation: 187.63 (City of Wichita Datum)

**R REMOVE EXISTING SANITARY PLUG**

NO.	STATION	FL
R1	2+63.42 Run A	(8") 174.66± (Contractor to Verify in Field)

**T TAP EXISTING SANITARY SEWER**



NO.	STATION	FL
T1	2+63.42 Run A	(8") 174.66± (Contractor to Verify in Field)

**M BUILD SANITARY SEWER MANHOLE**

NO.	STATION	VF
M1	2+63.42 Run A	13.72
M2	0+00.00 Run B	8.90
M3	3+88.35 Run A	8.11
M4	5+27.53 Run A	7.16
M5	6+08.50 Run A	13.30
M6	2+51.76 Run B	5.04
M7	0+00.00 Run C	7.29
M8	1+46.64 Run B	10.61
M9	2+22.51 Run C	8.23
M10	5+44.18 Run C	7.22
M11	7+22.49 Run C	7.37
M12	7+76.66 Run A	12.53

**S BUILD 6" SANITARY SERVICE STUB-OUT**

IDENTIFIER	Station at Man or Manhole	FL (8") at Man or Manhole	FL (6") at Man or Manhole	Length	Slope
S1	6+08.50 'A'	183.42	186.42	186.83	10.0 0.04C16
S2	6+08.50 'A'	183.42	186.42	186.85	10.0 0.02296
S3	1+46.64 'C'	177.57	178.57	179.41	10.0 0.08365
S4	5+56.17 'B'	176.74	N/A	177.57	10.0 0.08337
S5	3+22.51 'C'	178.28	181.28	182.23	10.0 0.09457
S6	5+44.18 'C'	179.17	182.17	182.50	10.0 0.03319
S7	7+76.66 'C'	180.10	183.10	183.23	10.0 0.01324
S8	7+76.66 'C'	180.10	183.10	183.50	10.0 0.03892

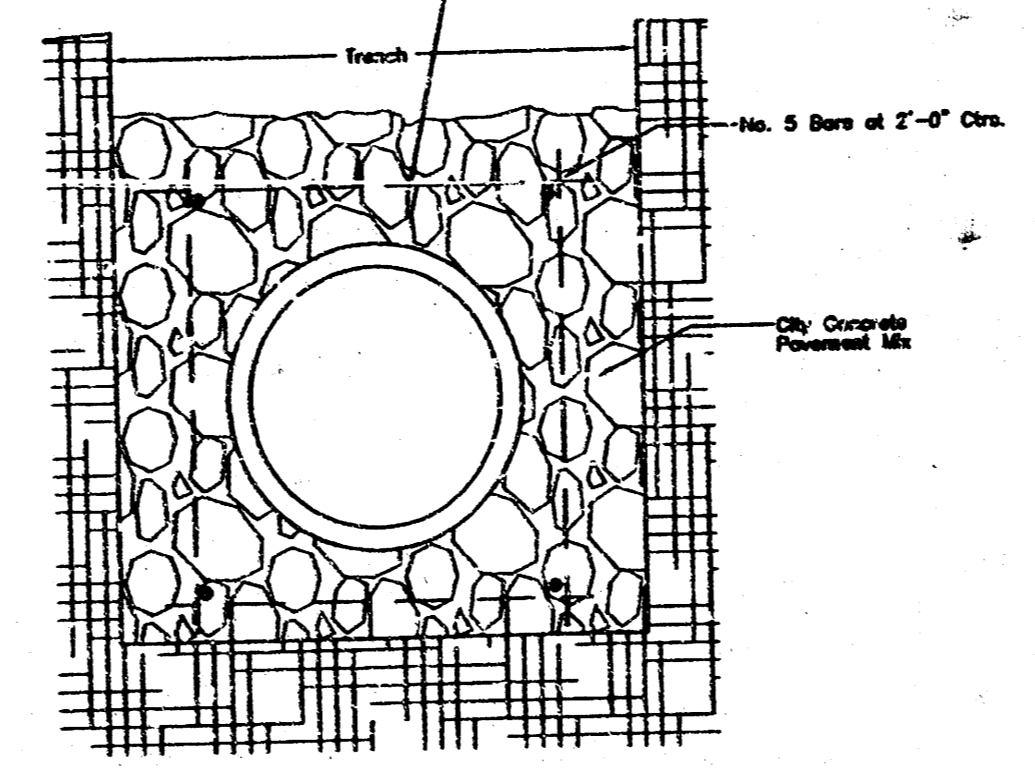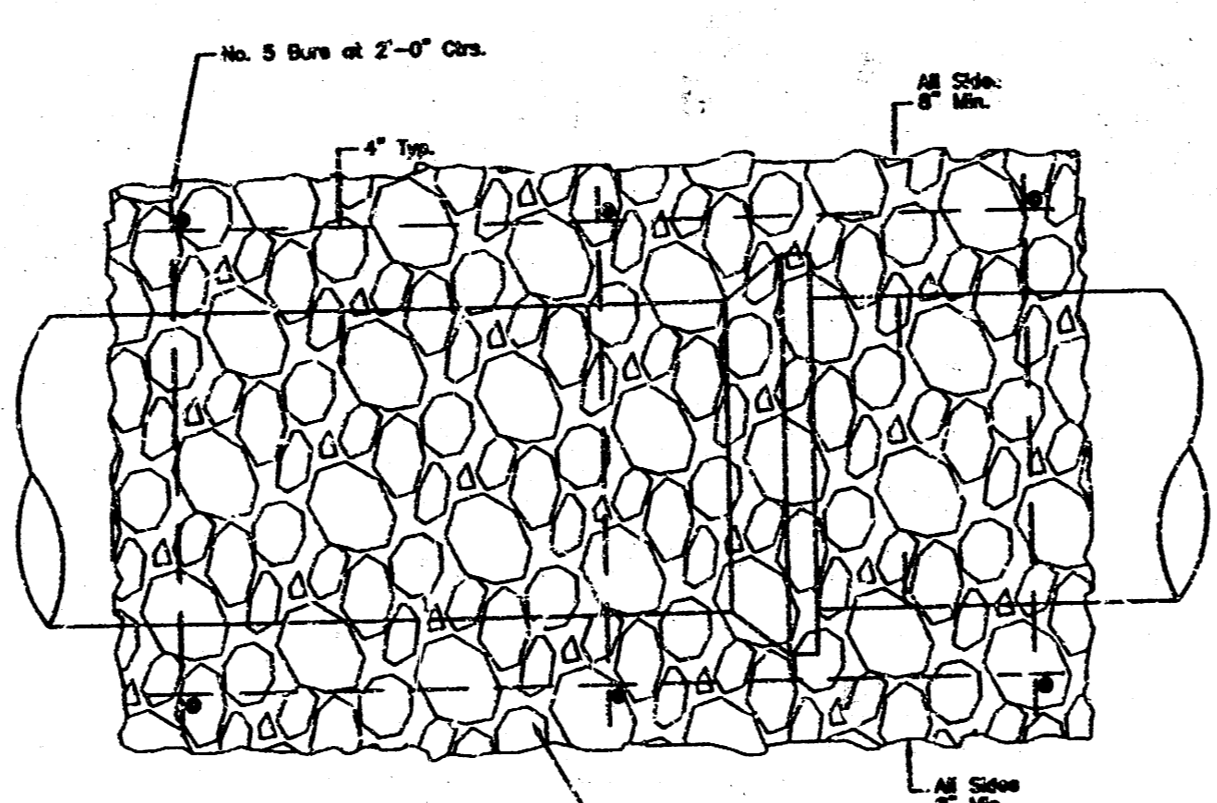

DETAIL OF REINFORCED CONCRETE ENCASUREMENT PER CITY OF WICHITA SPECIFICATIONS

**ROSS ENGINEERS, PLANNERS & ARCHITECTS, P.C.**  
 ENGINEERING

645 N. Street  
 Suite 201  
 Lincoln, NE 68508  
 Phone 402-462-7337  
 Fax 402-462-7337

Scale: 1"=40'  
 Drawn: JED  
 Checked: JVO  
 Approved: JED

Job: 988-SD  
 File: 988055A1  
 Date: 7/13/98  
 Plate: 8/1/98


**PINEHURST APARTMENTS**  
 E. 37TH STREET N. & ROCK ROAD  
 WICHITA, KANSAS

**SANITARY PLAN**  
 Sheet No. 2 OF 12  
 11/14/98

**KERRY A. BROWN**  
 LICENSED PROFESSIONAL ENGINEER  
 KANSAS  
 No. 14851


11/14/98 11:00 AM C:\WORK\988\988055A1.dwg Plot: San 03 08 32 27 1998 SAK



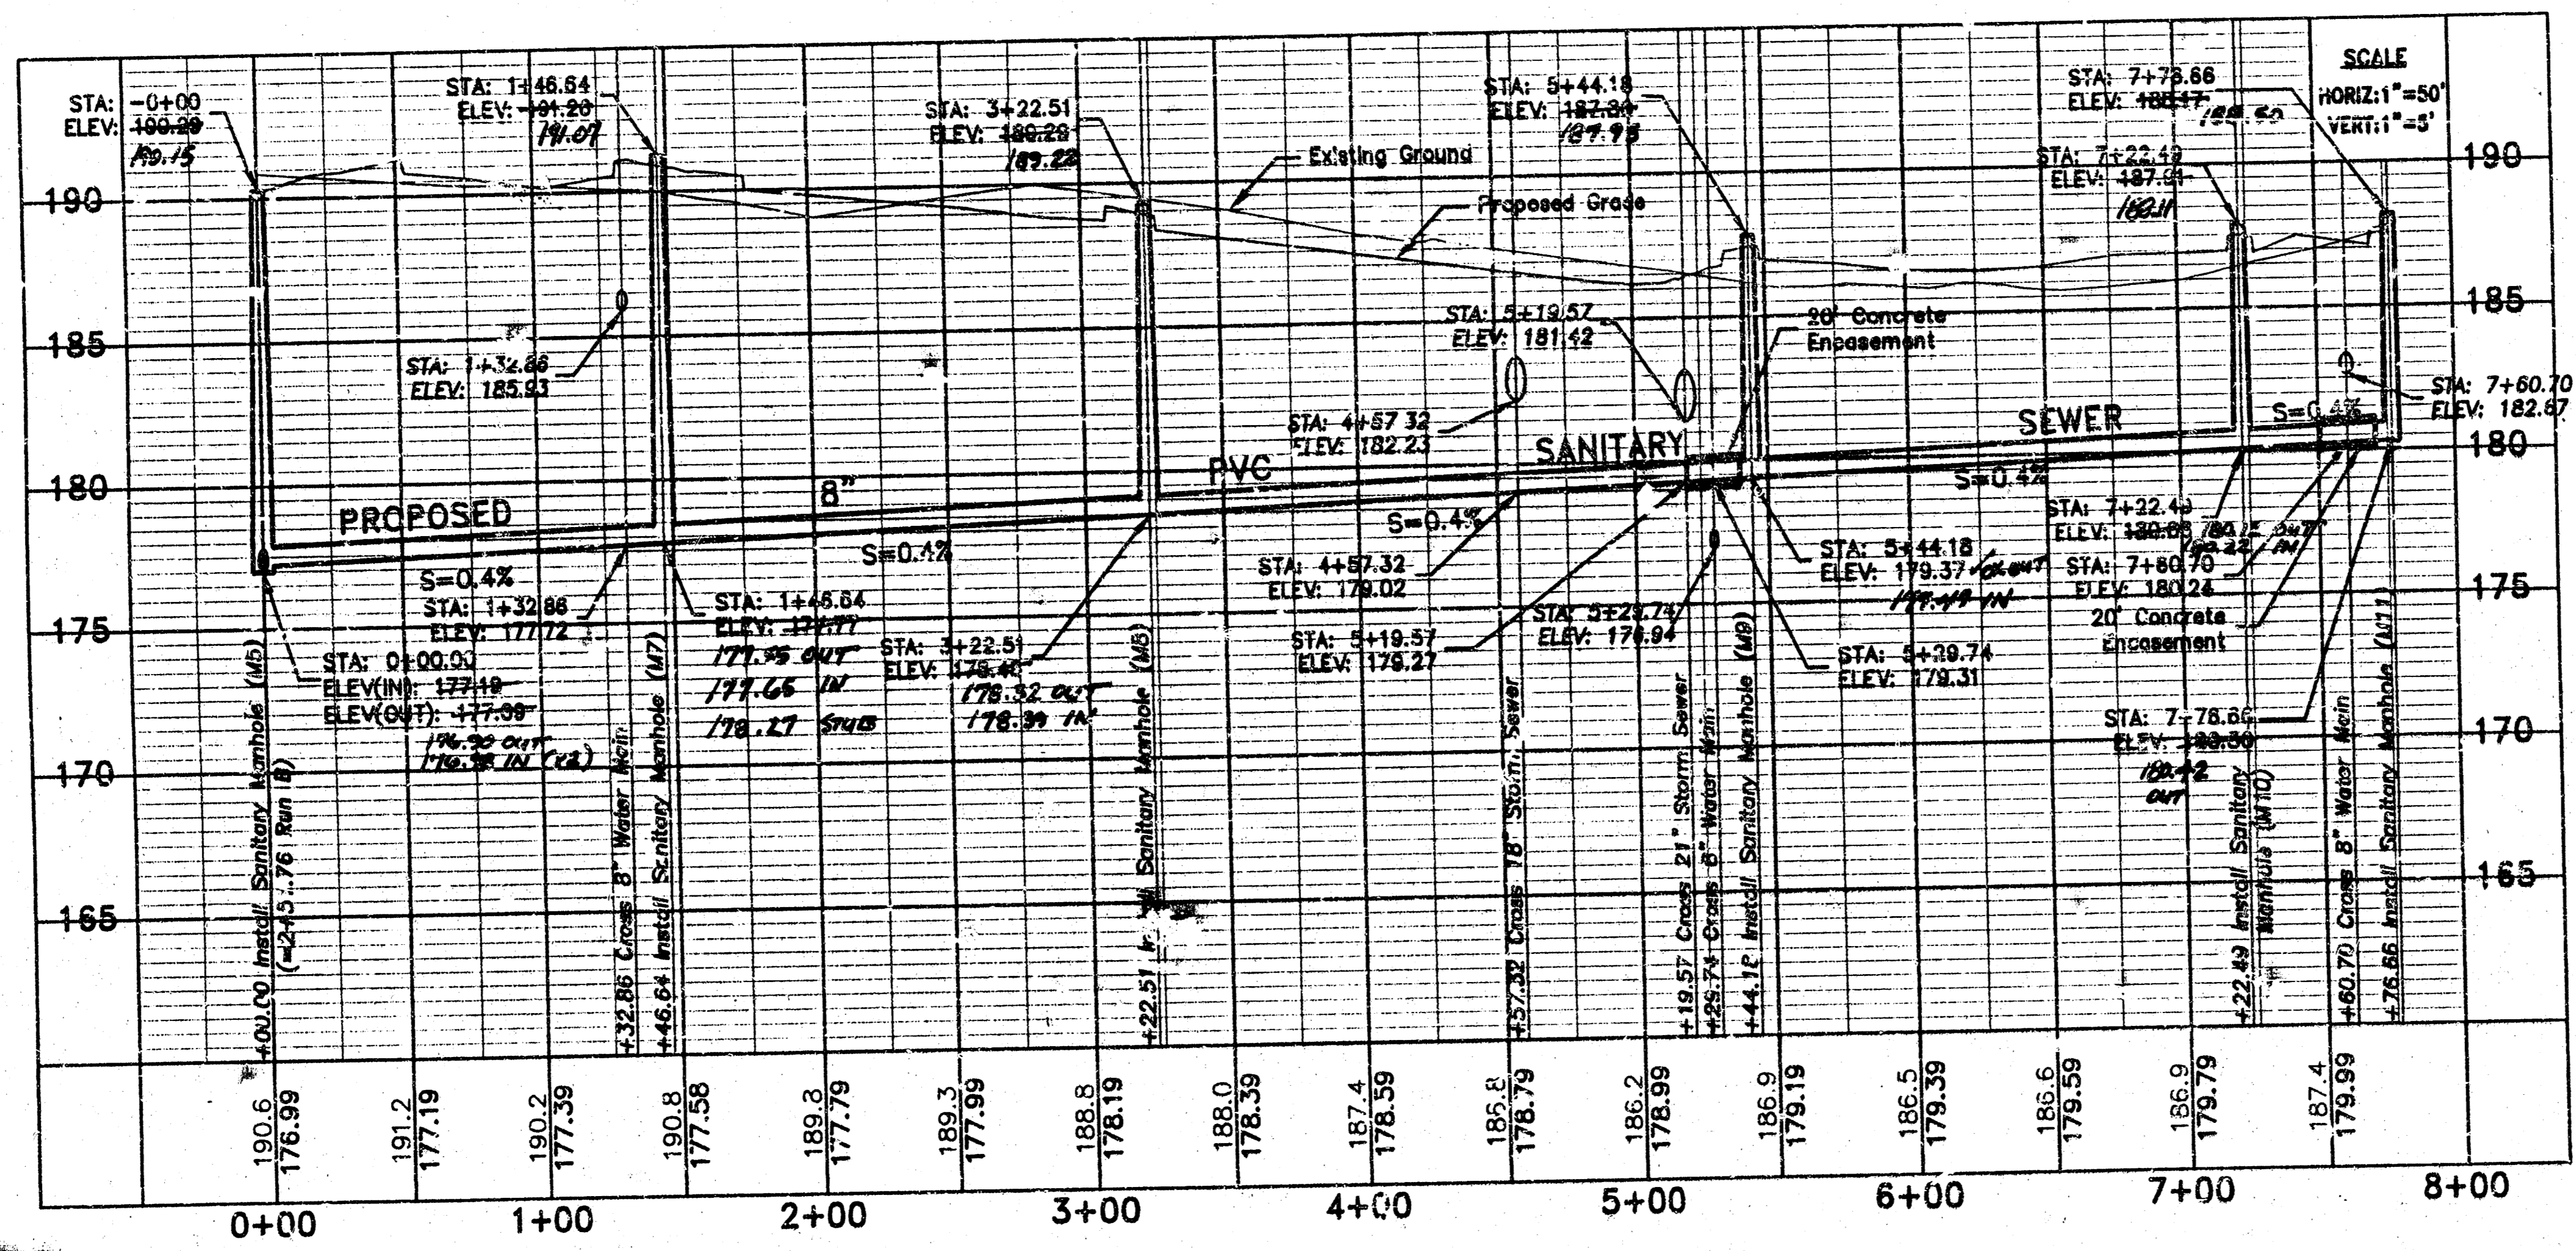

RUN 'C'

ASBUILT 12/08 BY BAUGHMAN COMPANY, P.A.

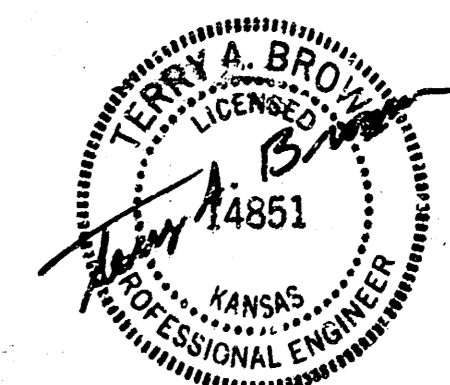

**SANITARY PROFILE**


**PINEHURST APARTMENTS**  
E. 37TH STREET N. & ROCK ROAD  
WICHITA, KANSAS

Job# 988-50  
File 980055A  
Date 7/16/98  
Plate 9/13/98

Scale 1"=50'  
Drawn LFF  
Checked JTC  
Approved

Revisions  
No. Description  
1 ASBUILT

Rev. Date  
12/17/98

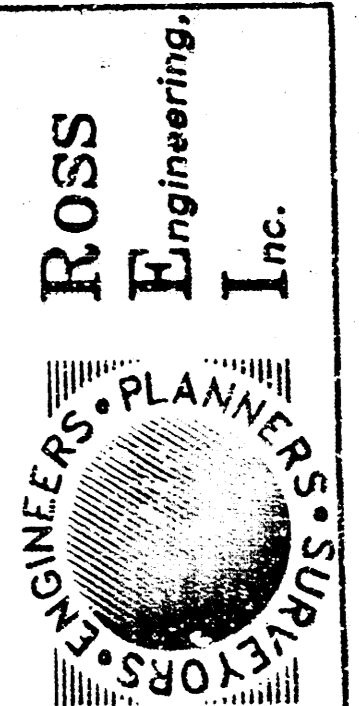

**(T1) TAP EXISTING STORM SEWER STRUCTURE (Public Construction)**

NO.	STATION/OFFSET	DESCRIPTION	TC/RIM	FL
T1	0+00 Run A	17' Curb Inlet	TC: 183.82	FL(30"):171.54 FL(36"):171.02

**(G22) BUILD STORM SEWER STRUCTURE (Private Construction)**

NO.	STATION/RUN	DESCRIPTION	TC/RIM	FL
G1	2+55.07/Run C	Standard Type "1-A" Curb Inlet	TC:188.40	FL(18"):183.52 FL(15"):183.77
G2	0+00.00/Run C	Top Existing Structure Reconstruct Existing Grate Inlet to Combination Curb & Grate Inlet	Rim:187.22	FL(30"):182.37± (Contractor to Verify in Field) FL(18"):182.10 (Twin)
G3	3+88.82/Run A	Standard Type "1-A" Curb Inlet	TC: 186.07	FL(30"):175.14 FL(21"):175.89
G4	5+69.20/Run A 0+00.00/Run B	Standard Type "1-A" Curb Inlet	TC: 186.46	FL(21"):181.28 FL(18"):181.53
G5	7+71.58/Run A	Double-faced 72" Curb Inlet See Detail(Sheet 7)	TC:188.90	FL(18"):183.53
G6	2+77.02/Run B	2' x 4' Drop Inlet	TC:185.50	FL(18"):183.13
G7	1+80.09/RunB	Shallow Type "P" Manhole	Rim:187.25	FL(18"):182.55
G8	1+25.42/Run B	Standard Type "1-A" Curb Inlet	TC:186.16	FL(21"):181.97 FL(18"):182.22
G9	2+52.64/Run A	2' x 4' Drop Inlet	Rim:185.00	FL(30"):173.88
G10	5+25.09/Run C	2' x 4' Drop Inlet	Rim:186.15	FL(15"):184.85
G11	3+13.15/Run C	Shallow Type "P" Manhole	Rim:189.61	FL(15"):184.00

**(P20) BUILD RCP STORM SEWER (Private Construction)**

NO.	DESCRIPTION	SIZE	SLOPE	LENGTH
P1	Inlet G1 to Inlet G2	18"	S=0.00450	250 LF
P2	Inlet G4 to Inlet G3	21"	S=0.02988	177 LF
P3	Inlet G5 to Inlet G4	18"	S=0.01002	196 LF
P5	Inlet G8 to Inlet G4	21"	S=0.00550	122 LF
P6	Manhole G7 to Inlet G8	18"	S=0.00604	51 LF
P7	Inlet G6 to Manhole G7	18"	S=0.00593	94 LF
P8	Inlet G9 to Inlet G3	30"	S=0.00933	134 LF
P9	Inlet G1 to Manhole G11	15"	S=0.00400	55 LF
P10	Manhole G11 to Inlet G10	15"	S=0.00400	208 LF

**(P1) BUILD RCP STORM SEWER (Public Construction)**

NO.	DESCRIPTION	SIZE	SLOPE	LENGTH
P4	Inlet T1 to Inlet G9	30"	S=0.00933	252 LF


**SCHEDULE OF APPROX. QUANTITIES (Private Construction)**

DESCRIPTION	UNITS	QUANT.
30" RCP Storm Sewer Pipe	LF	134
21" RCP Storm Sewer Pipe	LF	299
18" RCP Storm Sewer Pipe	LF	395
15" RCP Storm Sewer Pipe	LF	250
Standard Type "1-A" Curb Inlet	Ea	4
Double-faced 72" Curb Inlet (See Detail)	Ea	1
2' x 4' Drop Inlet	Ea	3
Shallow Type "P" Storm Sewer Manhole	Ea	2
Storm Sewer Manhole	VF	10.3
Top Existing Inlet	Ea	1
Reconstruct Grate Inlet into Curb Inlet	Ea	1

**SCHEDULE OF APPROX. QUANTITIES (Public Construction)**


DESCRIPTION	UNITS	QUANT.
30" RCP Storm Sewer Pipe	LF	252
Top Existing Inlet	Ea	1




City of Wichita Benchmark:  
Brass Cap set in Concrete  
Approximately 139' East of Southeast Corner of Teal Cove  
Elevation: 187.63 (City of Wichita Datum)  
2nd Addition, and approximately 51' North of Centerline of East 37th Street North.

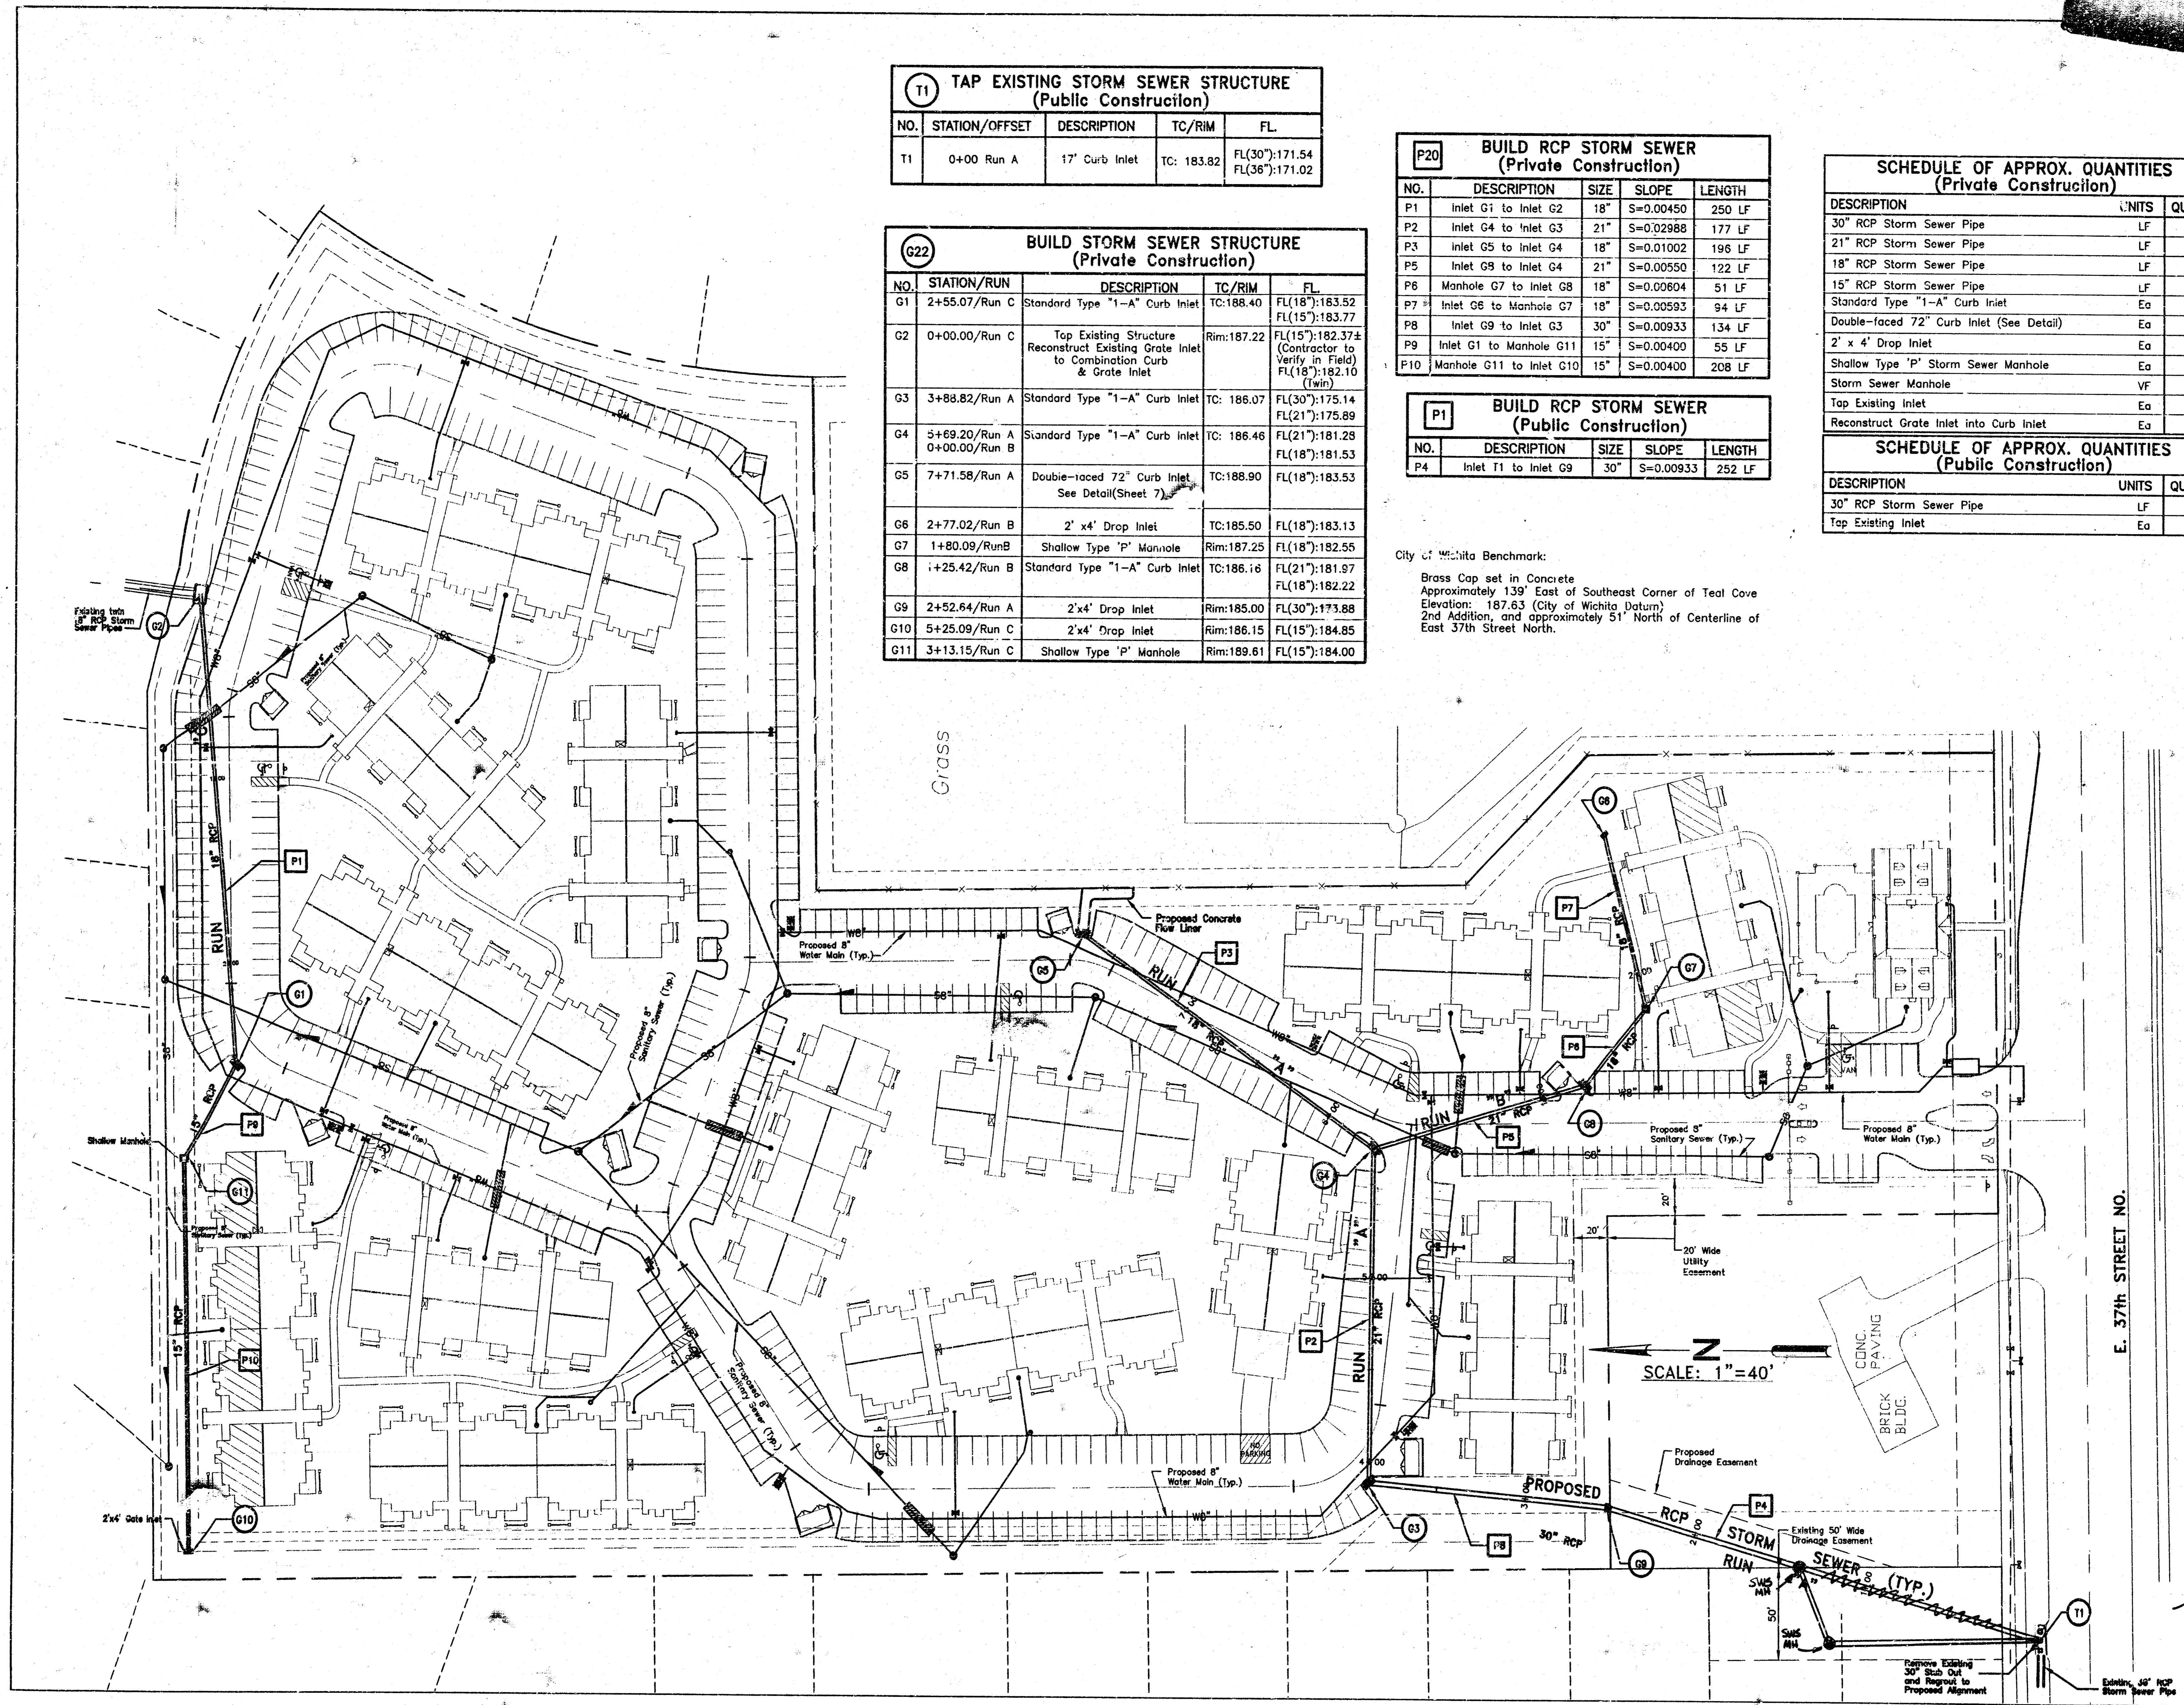

E. 37th STREET NO.


SCALE: 1"=40'

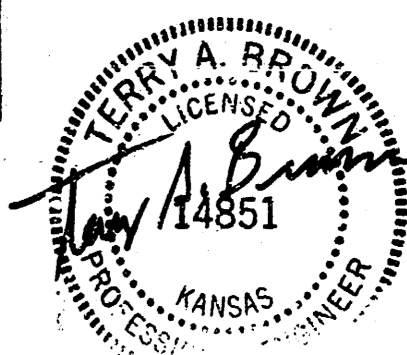

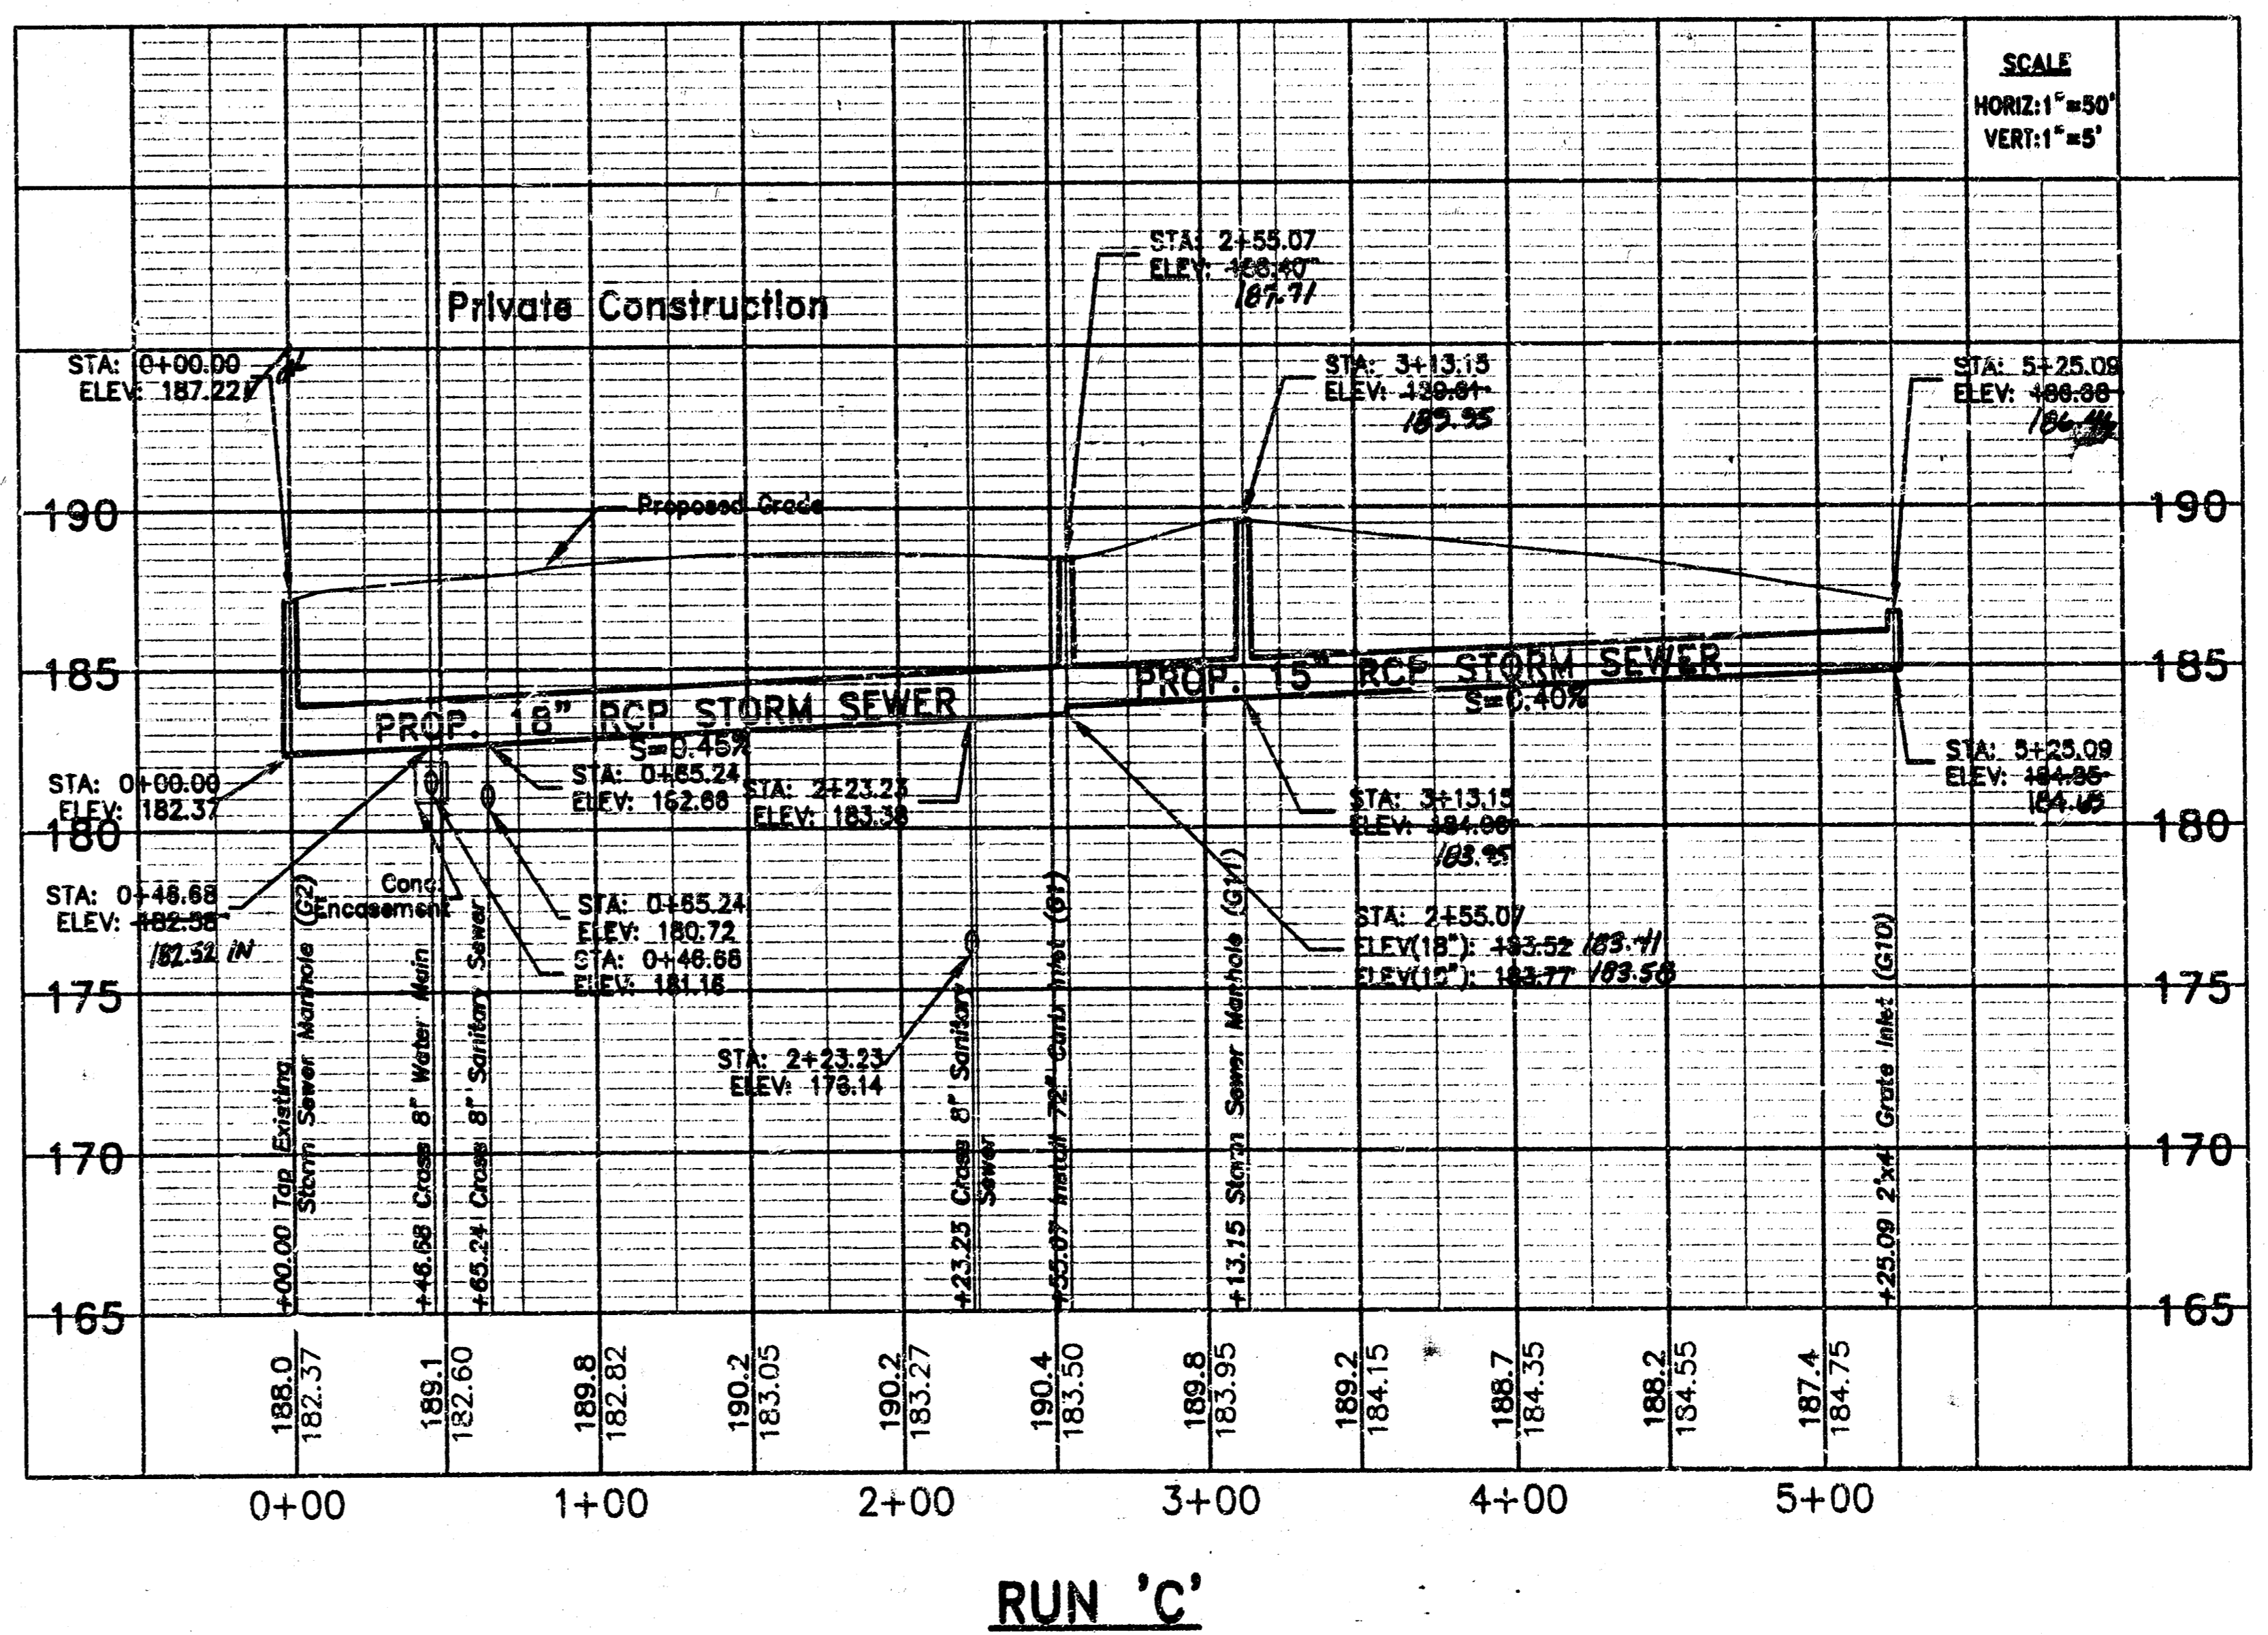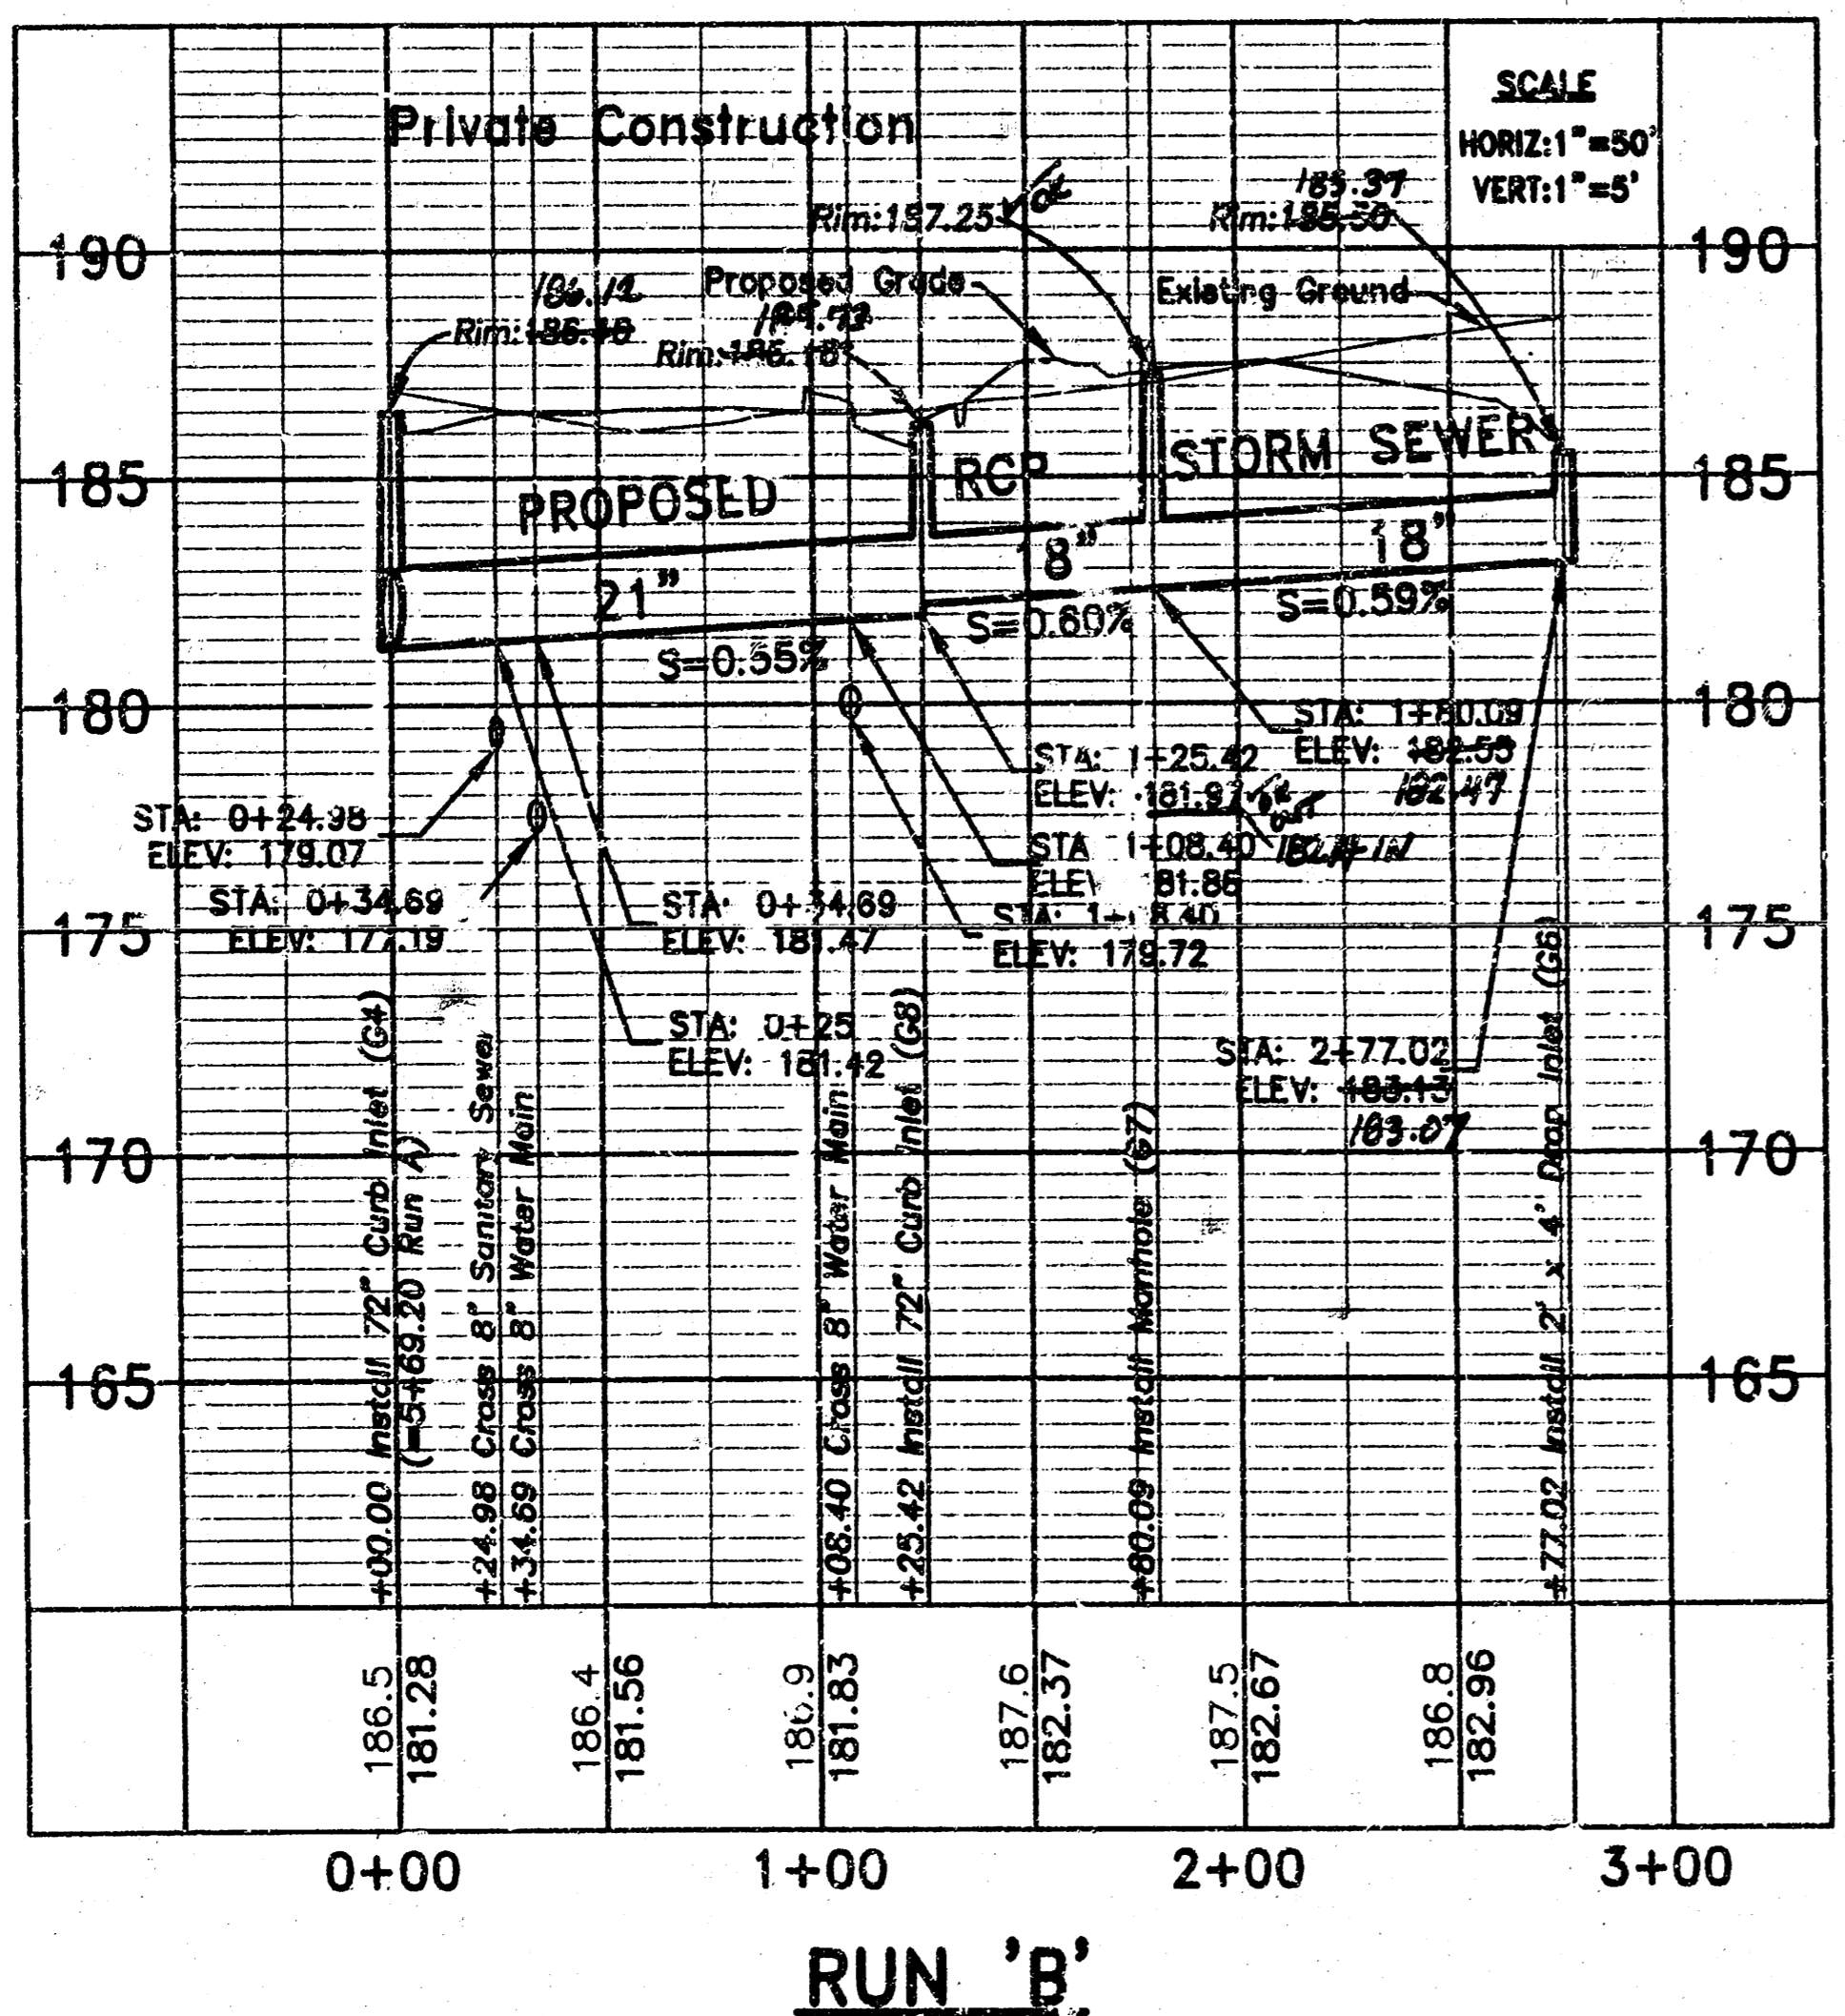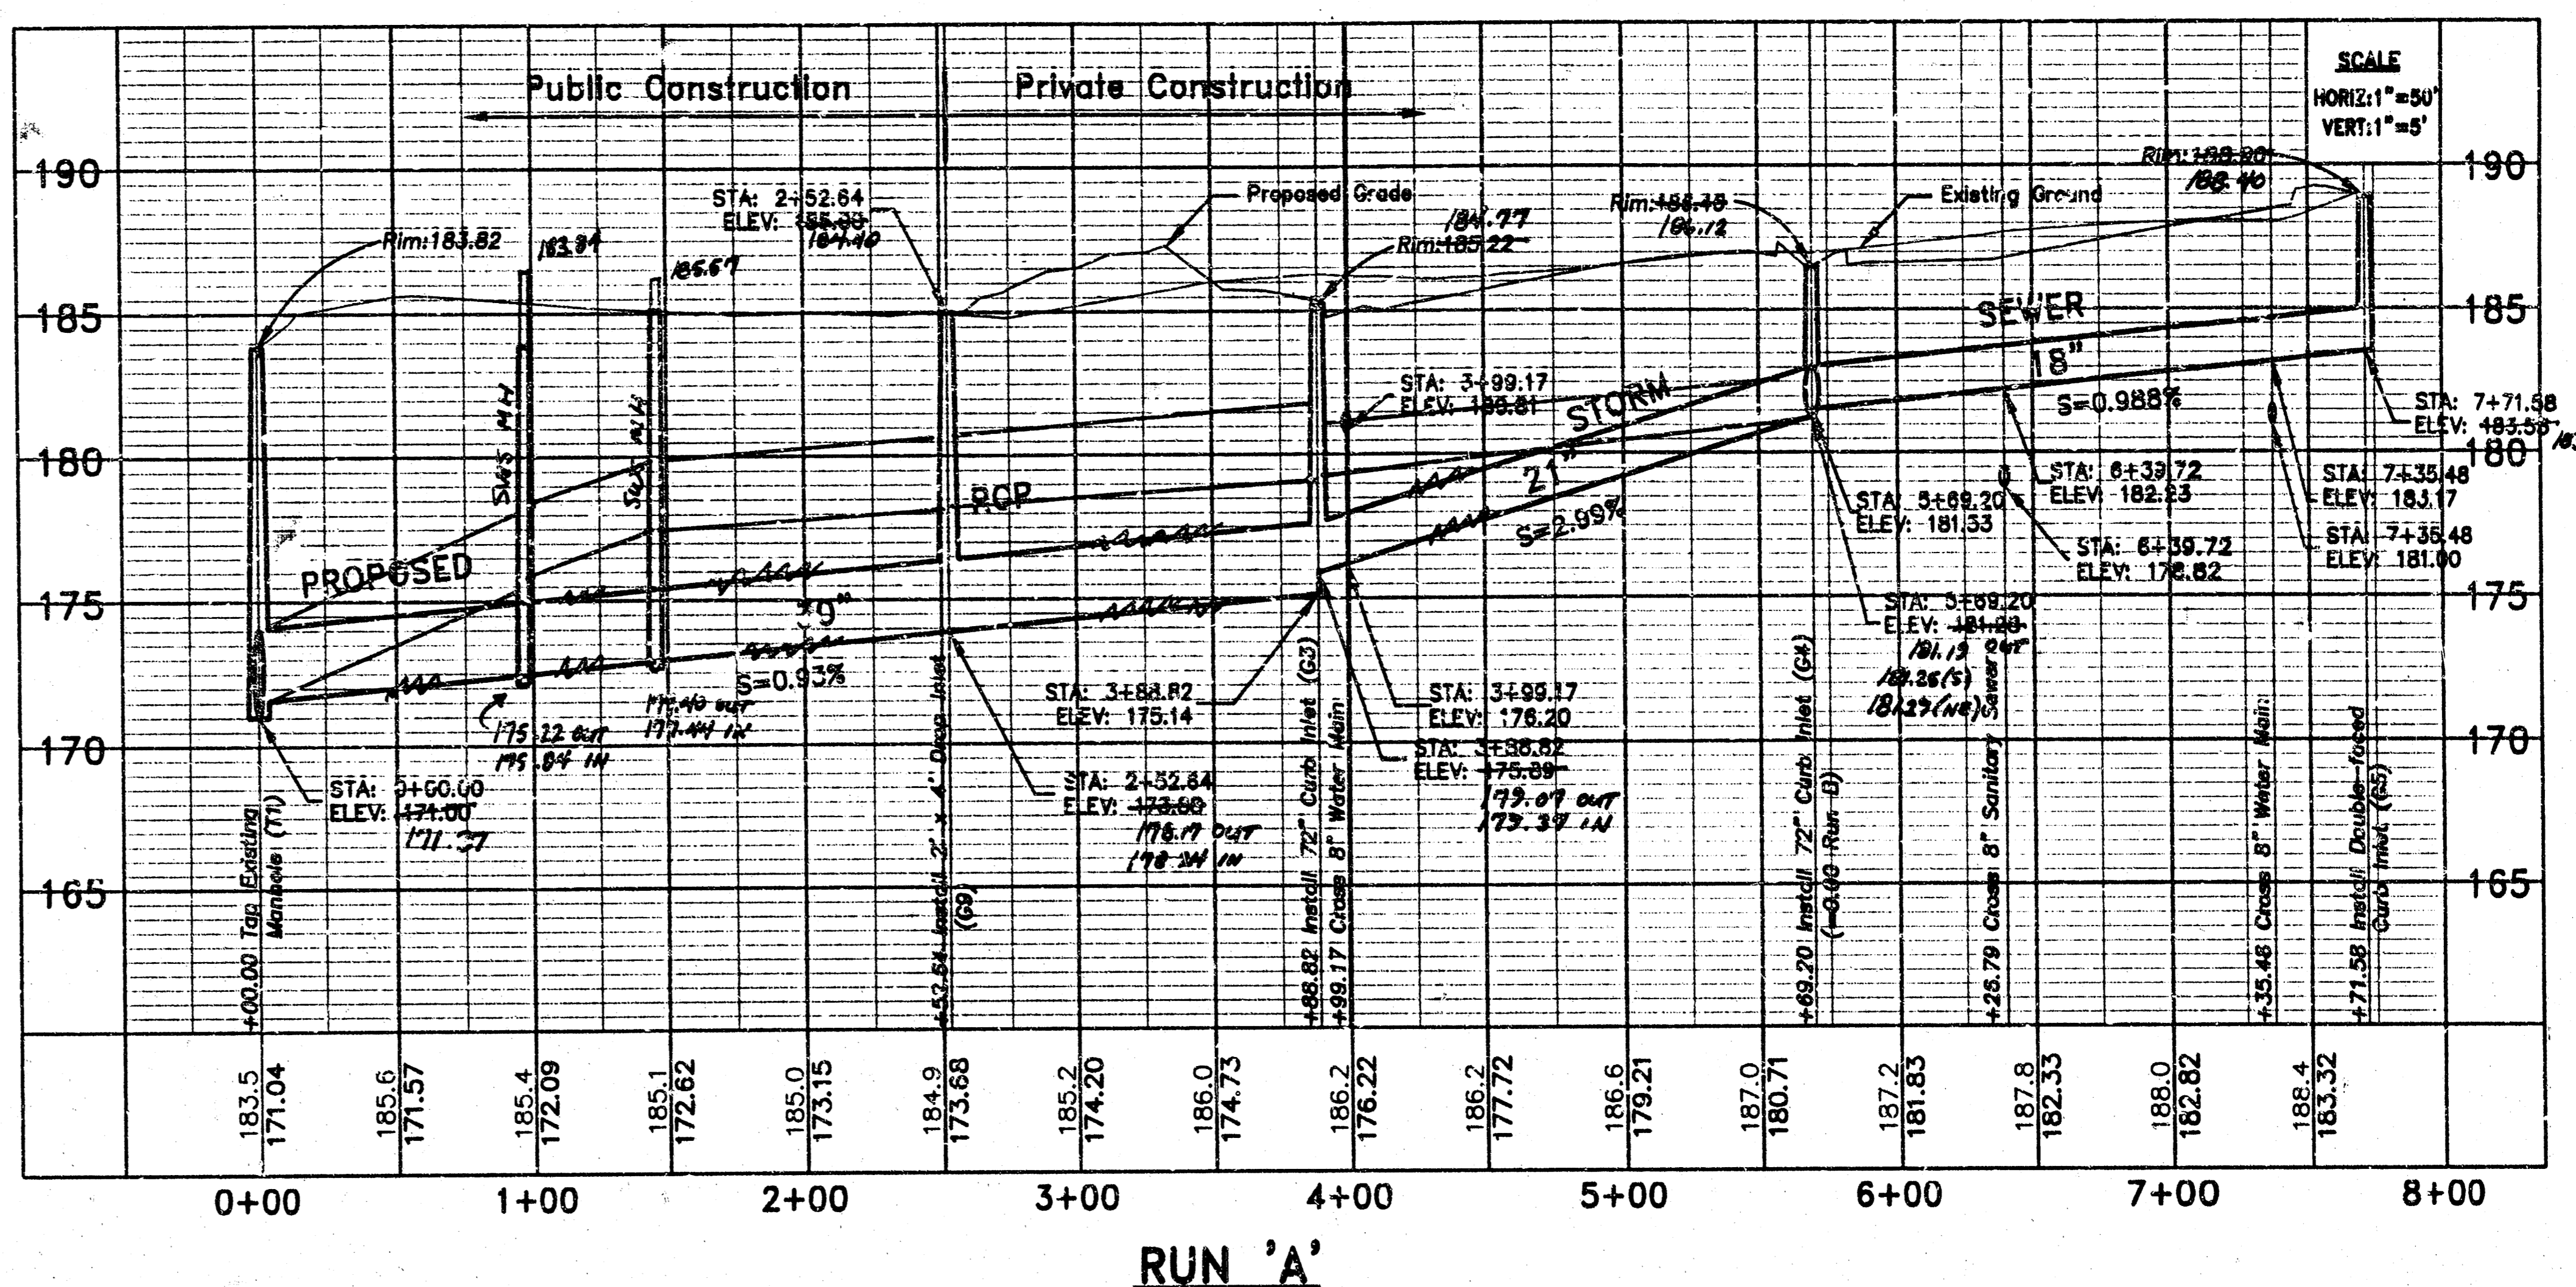

ASSEMBLED BY  
BAUGHMAN COMPANY, P.A.

ERRY A. BROWN  
LICENSED  
Professional Engineer  
KANSAS  
No. 10000

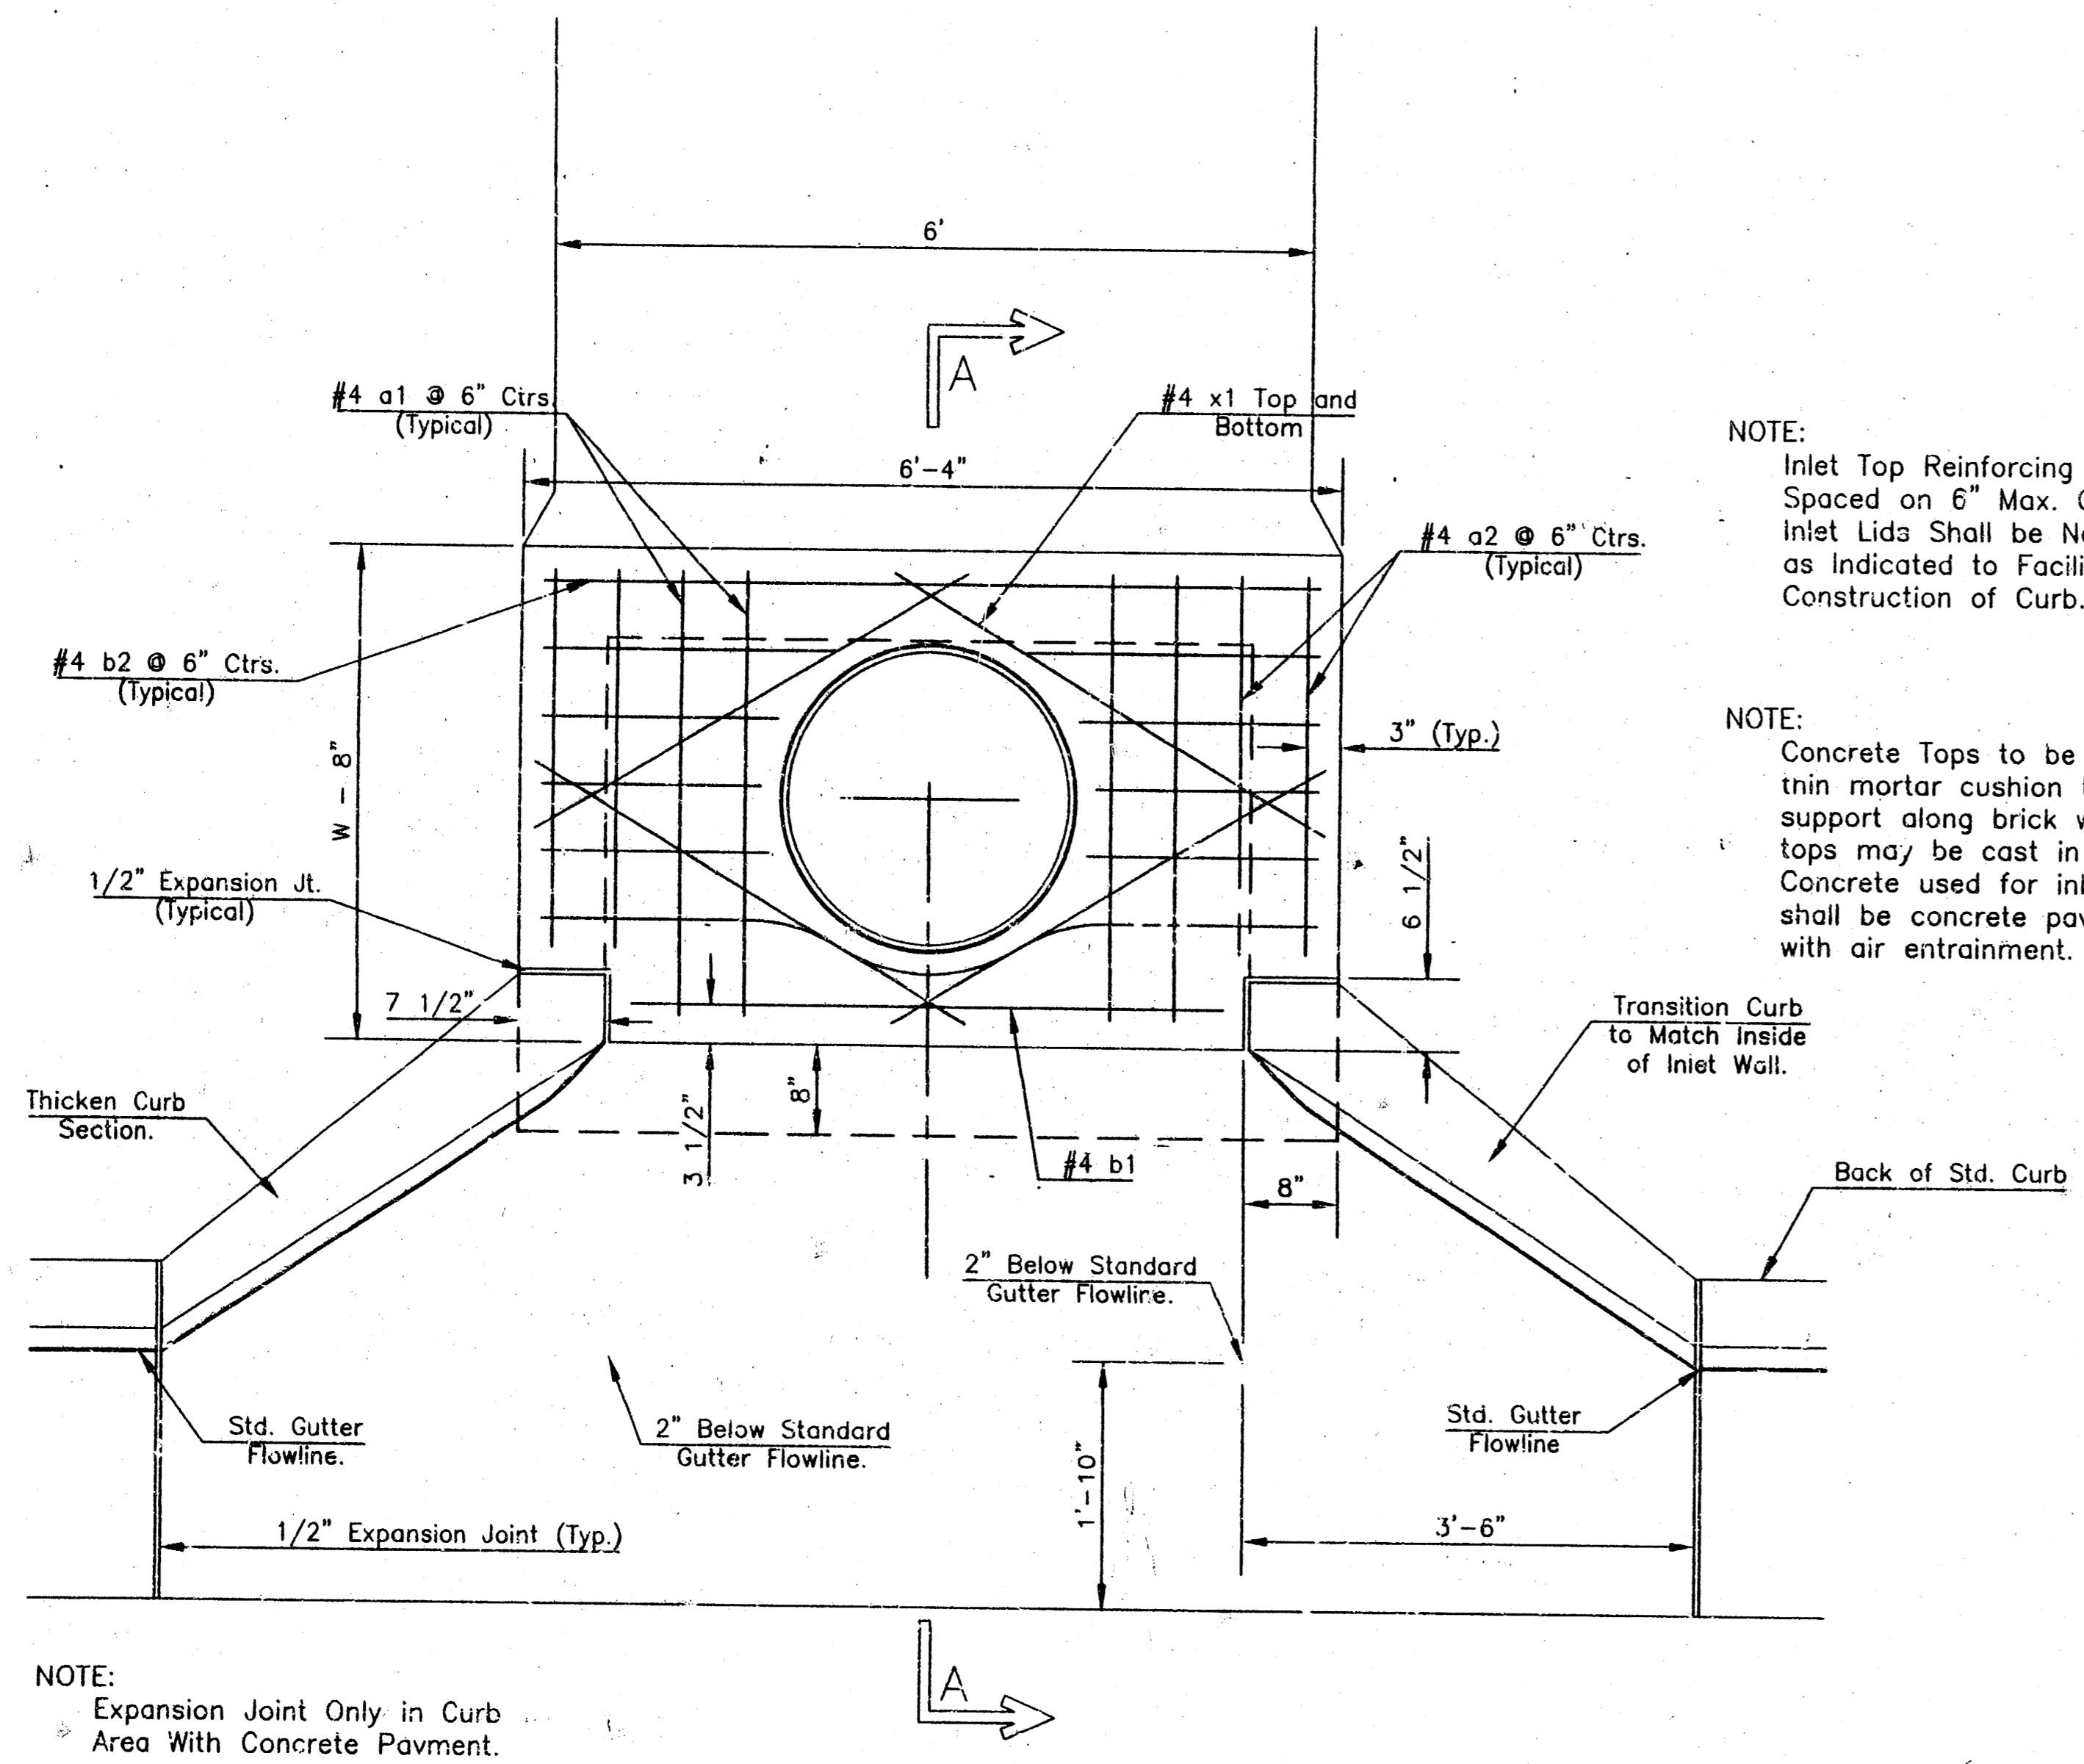


NOTE:  
Inlet Top Reinforcing shall be Spaced on 6" Max. Centers. Inlet Lids Shall be Notched Out as Indicated to Facilitate Construction of Curb.


NOTE:  
Concrete Tops to be installed on thin mortar cushion to insure full support along brick walls. Concrete tops may be cast in place or precast. Concrete used for inlet construction shall be concrete pavement mix with air entrainment.

NOTE:  
Expansion Joint Only in Curb Area With Concrete Pavment.

PLAN  
**DOUBLE CURB INLET DETAIL**  
NO SCALE

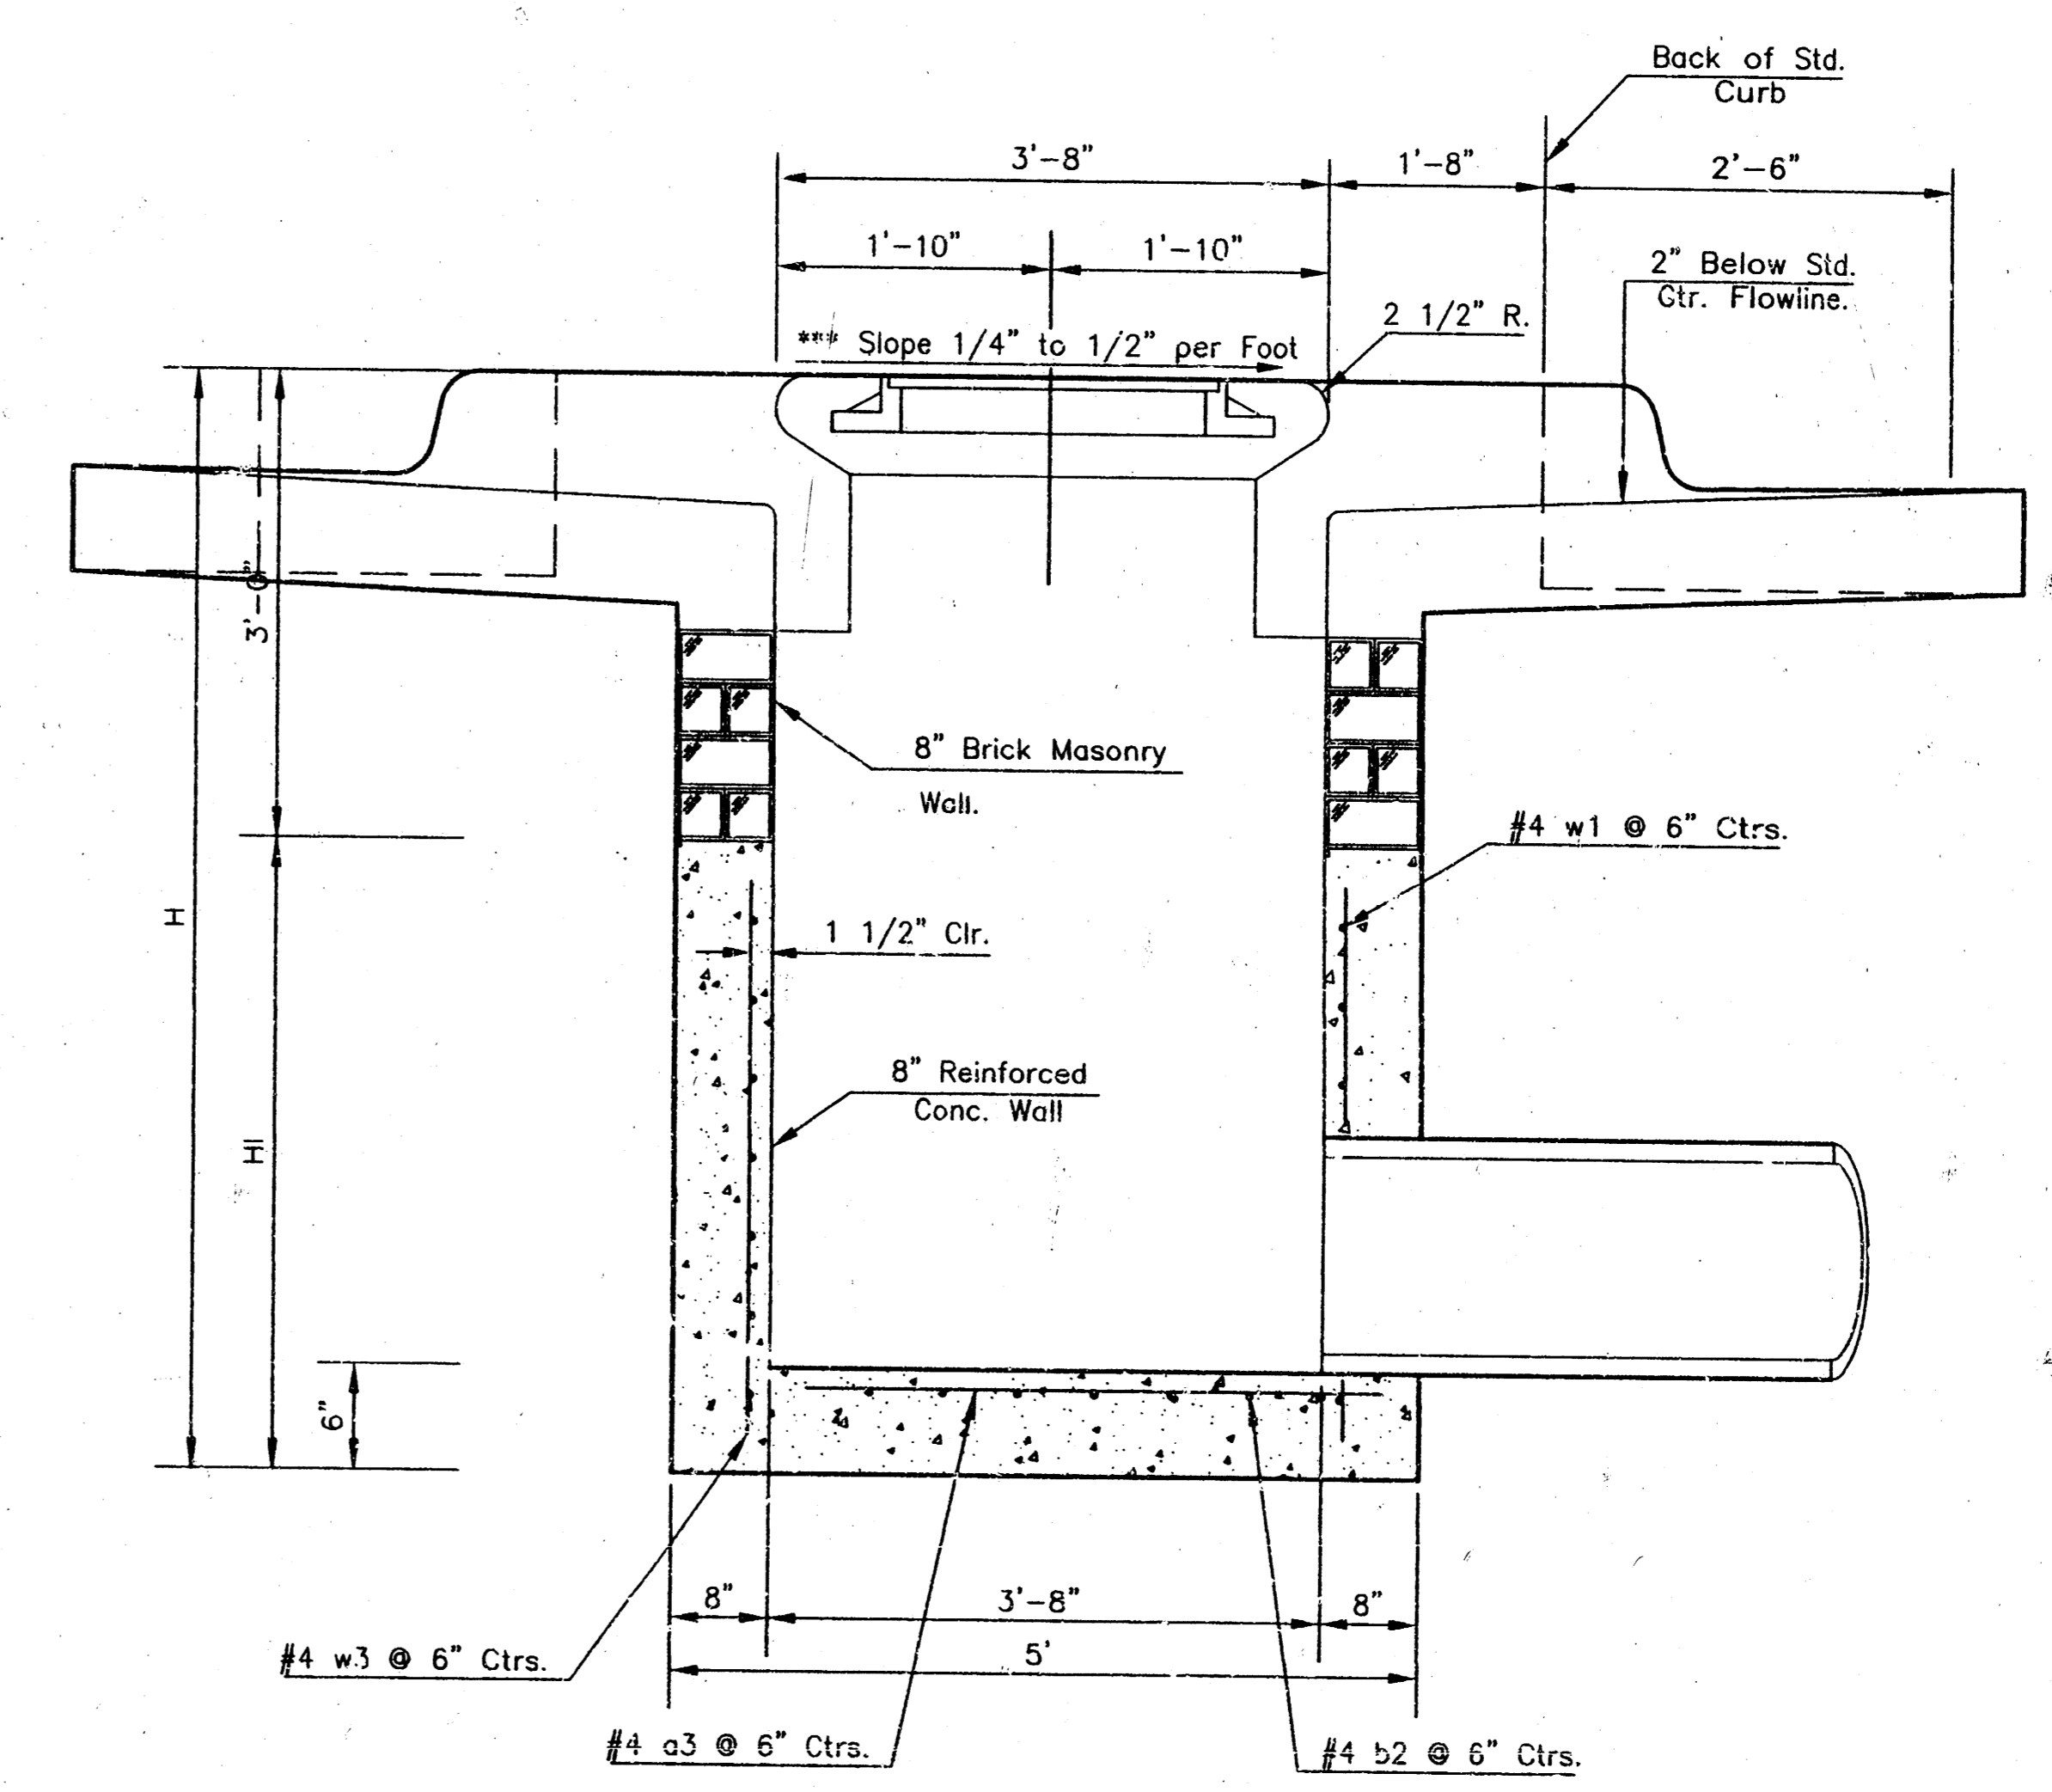

SECTION A-A  
\*\*\*NOTE: Slope of Inlet tops to Match Sidewalk or Parking Slopes within Limits Indicated.

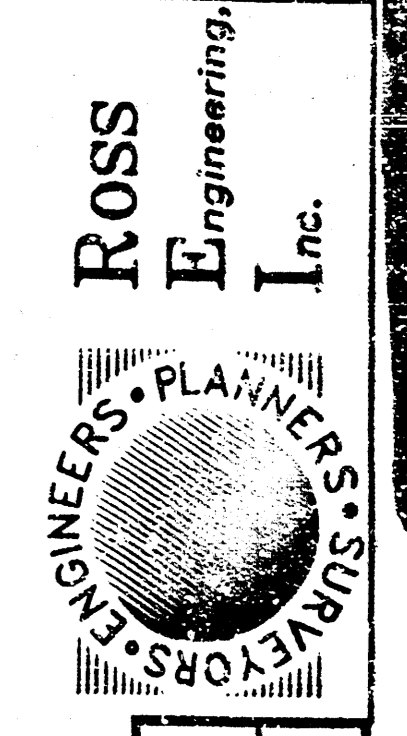


ROSS  
Engineering,  
Inc.  
445 N. Street  
Suite 201  
Lincoln, NE 68508  
Phone 402-474-7677  
FAX 402-474-7698

No.	Revisions	Rev. Date

Scale: 1"=6'  
Drawn: JLD  
Checked: JLD  
Approved: JLD


Job # 888-SD  
File 8880351  
Date 7/13/98  
Date 8/2/98

**PINEHURST APARTMENTS**  
E. 37TH STREET N. & ROCK ROAD  
WICHITA KANSAS

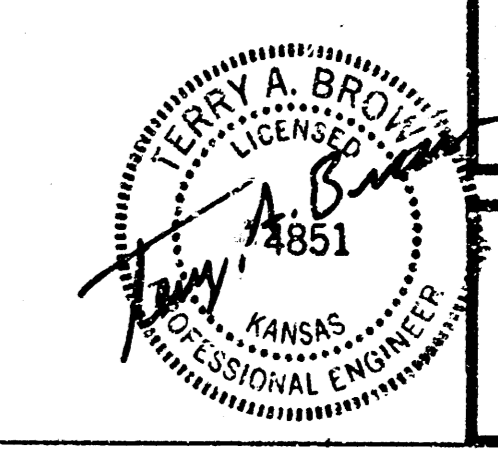

**DOUBLE CURB INLET DETAIL**  
Sheet No. 7 OF 12

# SEWER APPURTENANCES DETAILS

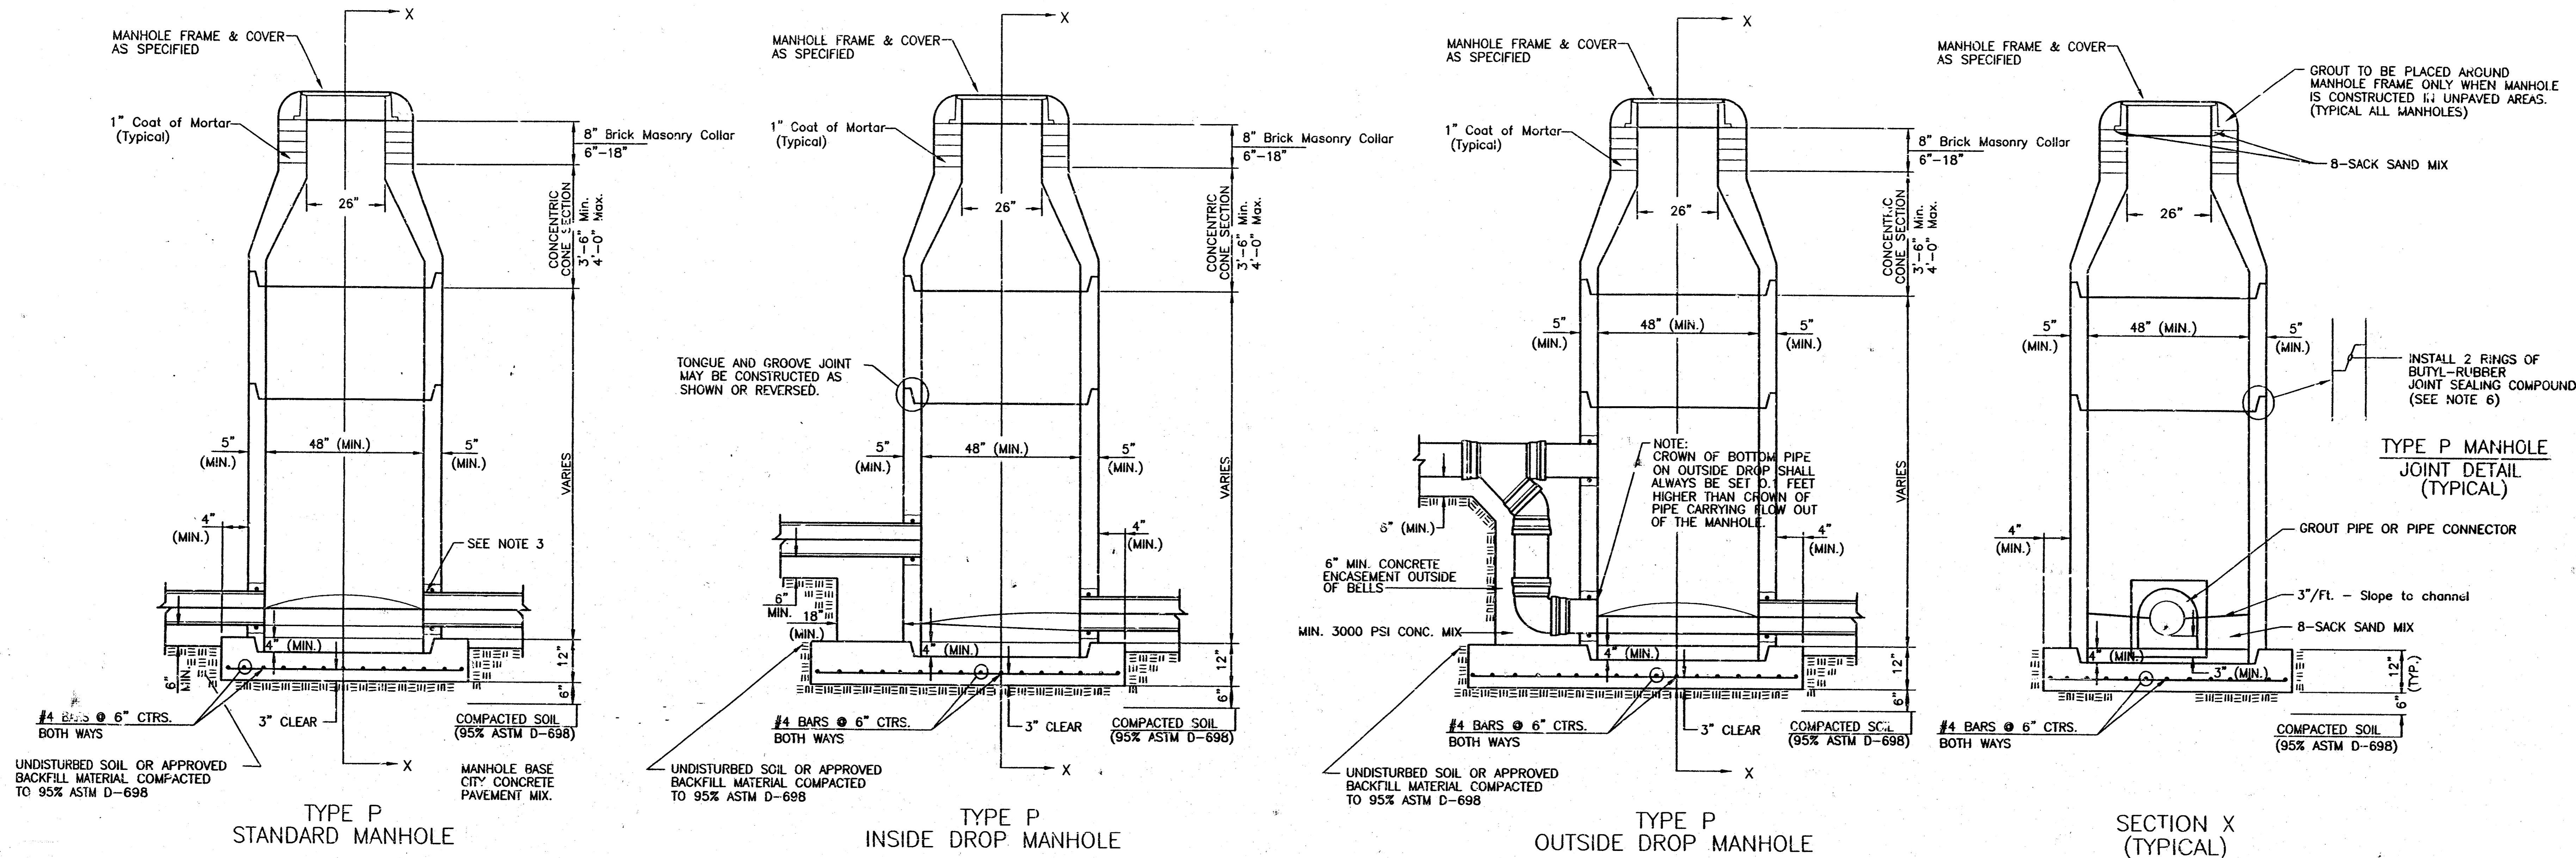

- GENERAL NOTES**
- PRECAST MANHOLE NOTES**
- ALL PRECAST CONCRETE MANHOLE SECTIONS SHALL CONFORM TO THE LATEST REVISIONS OF A.S.T.M. C478 AS MODIFIED BY THE SPECIFICATIONS.
  - NON-SHRINK GROUT SHALL BE NON-METALLIC TYPE.
  - APPROVED FLEXIBLE WATERSTOP GASKETS SHALL BE INSTALLED TO JOIN THE SEWER TO THE MANHOLE WALL WHEN A.B.S. COMPOSITE PIPE OR P.V.C. PIPE IS USED. FOR OTHER TYPES OF PIPE THE SEWER SHALL BE GROUTED IN PLACE WITH NON-SHRINK GROUT. THE SEWER PIPE SHALL BE SUPPORTED WITH CONCRETE ENCASEMENT A MINIMUM OF 3 FEET FROM THE MANHOLE WALL AND TO THE FIRST JOINT FOR V.C.P. SUCH THAT THE JOINT REMAINS FLEXIBLE.
  - ALL INSIDE SURFACES OF THE CONCRETE MANHOLE WHICH WOULD BE EXPOSED TO SEWER GAS SHALL BE COATED WITH 2 COATS THEMEC SERIES 66 HI-BUILD EPOXYLINE, DRY THICKNESS OF 8 MILS (MIN.).
  - EXTERIOR MANHOLE WALLS SHALL BE COATED WITH 1 COAT MOBILARMA 653 BITUMINOUS COATING.
  - JOINT SEALING COMPOUND SHALL BE KENT SEAL NO. 2 OR APPROVED EQUAL.
  - PRECAST MANHOLES SHALL BE SET AT LEAST 4 INCHES INTO THE MANHOLE BASE.
  - TOP OF MANHOLE FLOOR SLAB SHALL BE AT LEAST 3 INCHES BELOW THE FLOW LINE OF THE OUTLET PIPE TO INSURE SUFFICIENT MINIMUM THICKNESS OF SHAPED INVERT.
  - LIFTING HOLES SHALL BE FILLED WITH NON-SHRINK GROUT AND THE INTERIOR SURFACE COATED AS SPECIFIED.
  - MORTAR USED IN MASONRY CONSTRUCTION SHALL CONTAIN 8 SACKS OF CEMENT PER CUBIC YARD. CONCRETE USED IN MANHOLE BASES SHALL CONFORM TO THE REQUIREMENTS OF CONCRETE FOR CONCRETE PAVEMENT CONSTRUCTION AS SPECIFIED IN THE CITY STANDARD PAVING SPECIFICATIONS USING CITY CONCRETE PAVEMENT MIX WITHOUT AIR ENTRAINING ADMIXTURE. MORTAR SHALL BE PLACED AROUND THE MANHOLE RING AS SHOWN ON THE DRAWINGS WHEN MANHOLES ARE CONSTRUCTED IN UNPAVED AREAS. MANHOLES CONSTRUCTED WHERE PIPE SIZES ARE SMALLER THAN 24" SHALL HAVE AN INSIDE DIAMETER OF 4" MANHOLES CONSTRUCTED WHERE PIPE SIZES ARE 24" OR LARGER SHALL HAVE AN INSIDE DIAMETER OF 5". COMPLETED MANHOLE SHALL BE WITHOUT LEAKS AND WATER-TIGHT.
  - REINFORCING STEEL SHALL BE INSTALLED IN THE MANHOLE BASES AND SHALL CONSIST OF NO. 4 BARS PLACED ON 6" CENTERS IN BOTH DIRECTIONS. THE MANHOLE BASE REINFORCEMENT SHALL BE PLACED AT LEAST 3" ABOVE THE BOTTOM OF THE MANHOLE BASE. ALL COSTS FOR FURNISHING AND INSTALLING REINFORCING STEEL SHALL BE INCLUDED IN THE UNIT PRICE BID FOR THE MANHOLE.
  - OPENINGS SHALL BE CUT INTO THE MANHOLE WALL WHEN OUTSIDE DROPS ARE CONSTRUCTED ON EXISTING MANHOLES. SUCH OPENINGS CUT INTO EXISTING MANHOLES SHALL BE AS SMALL AS PRACTICAL TO FACILITATE INSTALLING AND GROUTING THE NEW PIPE IN PLACE. WATERSTOP GASKETS SHALL BE USED WITH P.V.C. AND A.B.S. COMPOSITE PIPE. THE NEW PIPE SHALL BE GROUTED INTO THE OPENING USING AN APPROVED NONSHRINK GROUT FOR THE FULL MANHOLE WALL THICKNESS. THE EXTERIOR OF THE COMPLETED CONNECTION SHALL BE SEALED WITH AN APPROVED BITUMINOUS COATING SUCH THAT THE CONNECTION WILL BE WATER TIGHT. FLOOR OF MANHOLE AS SHOWN IN DRAWING TO FORM NEW FLOW CHANNEL FOR THE NEW CONNECTION AS INDICATED BY THE DRAWING. THIS WORK, INCLUDING MODIFICATION OF MANHOLE FLOOR, SHALL BE PAID FOR AT THE UNIT PRICE BID FOR OUTSIDE DROP STACK CONSTRUCTED ON EXISTING MANHOLE.
  - THE FLOORS OF ALL MANHOLES SHALL BE SHAPED WITH FLOW CHANNELS SUCH THAT THE MANHOLES WILL BE SELF-CLEANING AND FREE OF AREAS WHERE SOLIDS COULD BE DEPOSITED AS SEWAGE FLOWS THROUGH THE MANHOLE FROM ALL INLET PIPES TO THE GULLET PIPE. FLOW CHANNELS SHALL BE FORMED TO MATCH THE BOTTOM HALVES OF THE INFLOWING PIPES AND THE OUTFLOWING PIPE AS SHOWN BY THE DRAWINGS EXCEPT FOR INSIDE DROP MANHOLES. FLOW CHANNELS FOR INSIDE DROP MANHOLES SHALL BE CONSTRUCTED AS INDICATED BY THE DRAWING. MANHOLE FLOORS SHALL HAVE SLOPES OF 3 INCHES PER FOOT IN THE AREAS OUTSIDE OF THE FLOW CHANNELS SLOPED TOWARD THE FLOW CHANNELS. PIPES LAID THROUGH MANHOLES SHALL HAVE THE TOP HALF REMOVED TO NEAT LINES FOR THE FULL INSIDE DIAMETER OF THE MANHOLE. MANHOLE FLOORS SHALL THEN BE SHAPED AROUND THE BOTTOM HALF OF THE PIPE WHICH FORMS THE FLOW CHANNEL.
  - PIPES INSTALLED WITHIN THE EXCAVATION MADE FOR THE MANHOLE SHALL BE CRADLED WITH CONCRETE TO THE LIMITS OF THE MANHOLE EXCAVATION. WHEN CLAY PIPE IS USED, THE CRADLE SHALL EXTEND TO THE FIRST JOINT OUTSIDE THE MANHOLE. THE CRADLE SHALL BE TERMINATED AT THE CLAY PIPE JOINT IN A MANNER WHICH WILL MAINTAIN THE FLEXIBILITY OF THE JOINT. COST OF CRADLE WITHIN MANHOLE EXCAVATION OR TO CLAY PIPE JOINTS ADJACENT TO MANHOLE SHALL BE INCLUDED IN THE UNIT PRICE BID FOR THE MANHOLE.
  - MANHOLE COVER CASTINGS AND MANHOLE FRAME CASTINGS SHALL CONFORM TO THE REQUIREMENTS AS INDICATED IN THE STANDARD SPECIFICATIONS AND AS SHOWN IN THE STANDARD DETAIL DRAWING.
  - THE VERTICAL DROP IN INSIDE DROP MANHOLES SHALL NOT EXCEED 2' FOR INFLOWING PIPES SIZED 12" OR SMALLER AND 3' FOR INFLOWING PIPES LARGER THAN 12". THE CROWNS OF INFLOWING PIPES SHALL NEVER BE SET LOWER THAN THE CROWN OF THE OUTFLOWING PIPE.
  - STANDARD MANHOLES AND STANDARD INSIDE DROP MANHOLES SHALL BE BID AS STANDARD MANHOLES FOR THE TYPE AND DIAMETER INDICATED. OUTSIDE DROP MANHOLES SHALL BE BID AS STANDARD OUTSIDE DROP MANHOLES FOR THE TYPE AND DIAMETER INDICATED. ALL MANHOLE DIAMETERS WILL BE 4" UNLESS INDICATED OTHERWISE.
  - A BRICK MASONRY COLLAR SHALL BE INSTALLED BETWEEN THE CAST IRON FRAME AND THE CONCENTRIC CONE. THE COLLAR WILL HAVE 8" WALLS AND A VERTICAL HEIGHT OF 6" MINIMUM AND 18" MAXIMUM. A 1" COAT OF MORTAR WILL BE PLASTERED ON THE OUTSIDE OF THE COLLAR. THE USE OF PRE-CAST CONCRETE SPACERS FOR MANHOLE TOP ADJUSTMENT IS ALSO ALLOWED.


<p>THE CITY OF WICHITA CITY ENGINEER'S OFFICE CITY HALL - SEVENTH FLOOR 455 NORTH MAIN STREET WICHITA, KANSAS 67202 (316) 261-1200 (316) 261-1114 FAX</p>	<p>STANDARD TYPE 'P' MANHOLES</p>	
	<p>M. E. LINDEBAK P.E. - CITY ENGINEER</p>	
<p>PROJECT NUMBER 834PPS</p>	<p>INDEX CODE 607861</p>	
<p>DATE MAR 96</p>	<p>SHEET 8 OF 12</p>	

J:\CAD\DWG\1985\5858\5858.DWG Thu Sep 03 11:27:15 1998 SKK

# MANHOLE FRAME AND COVER DETAIL


ADOPTED AS STANDARD DESIGN BY  
CITY OF WICHITA, KANSAS

MANHOLE COVER  
Weight = 180 Lbs.

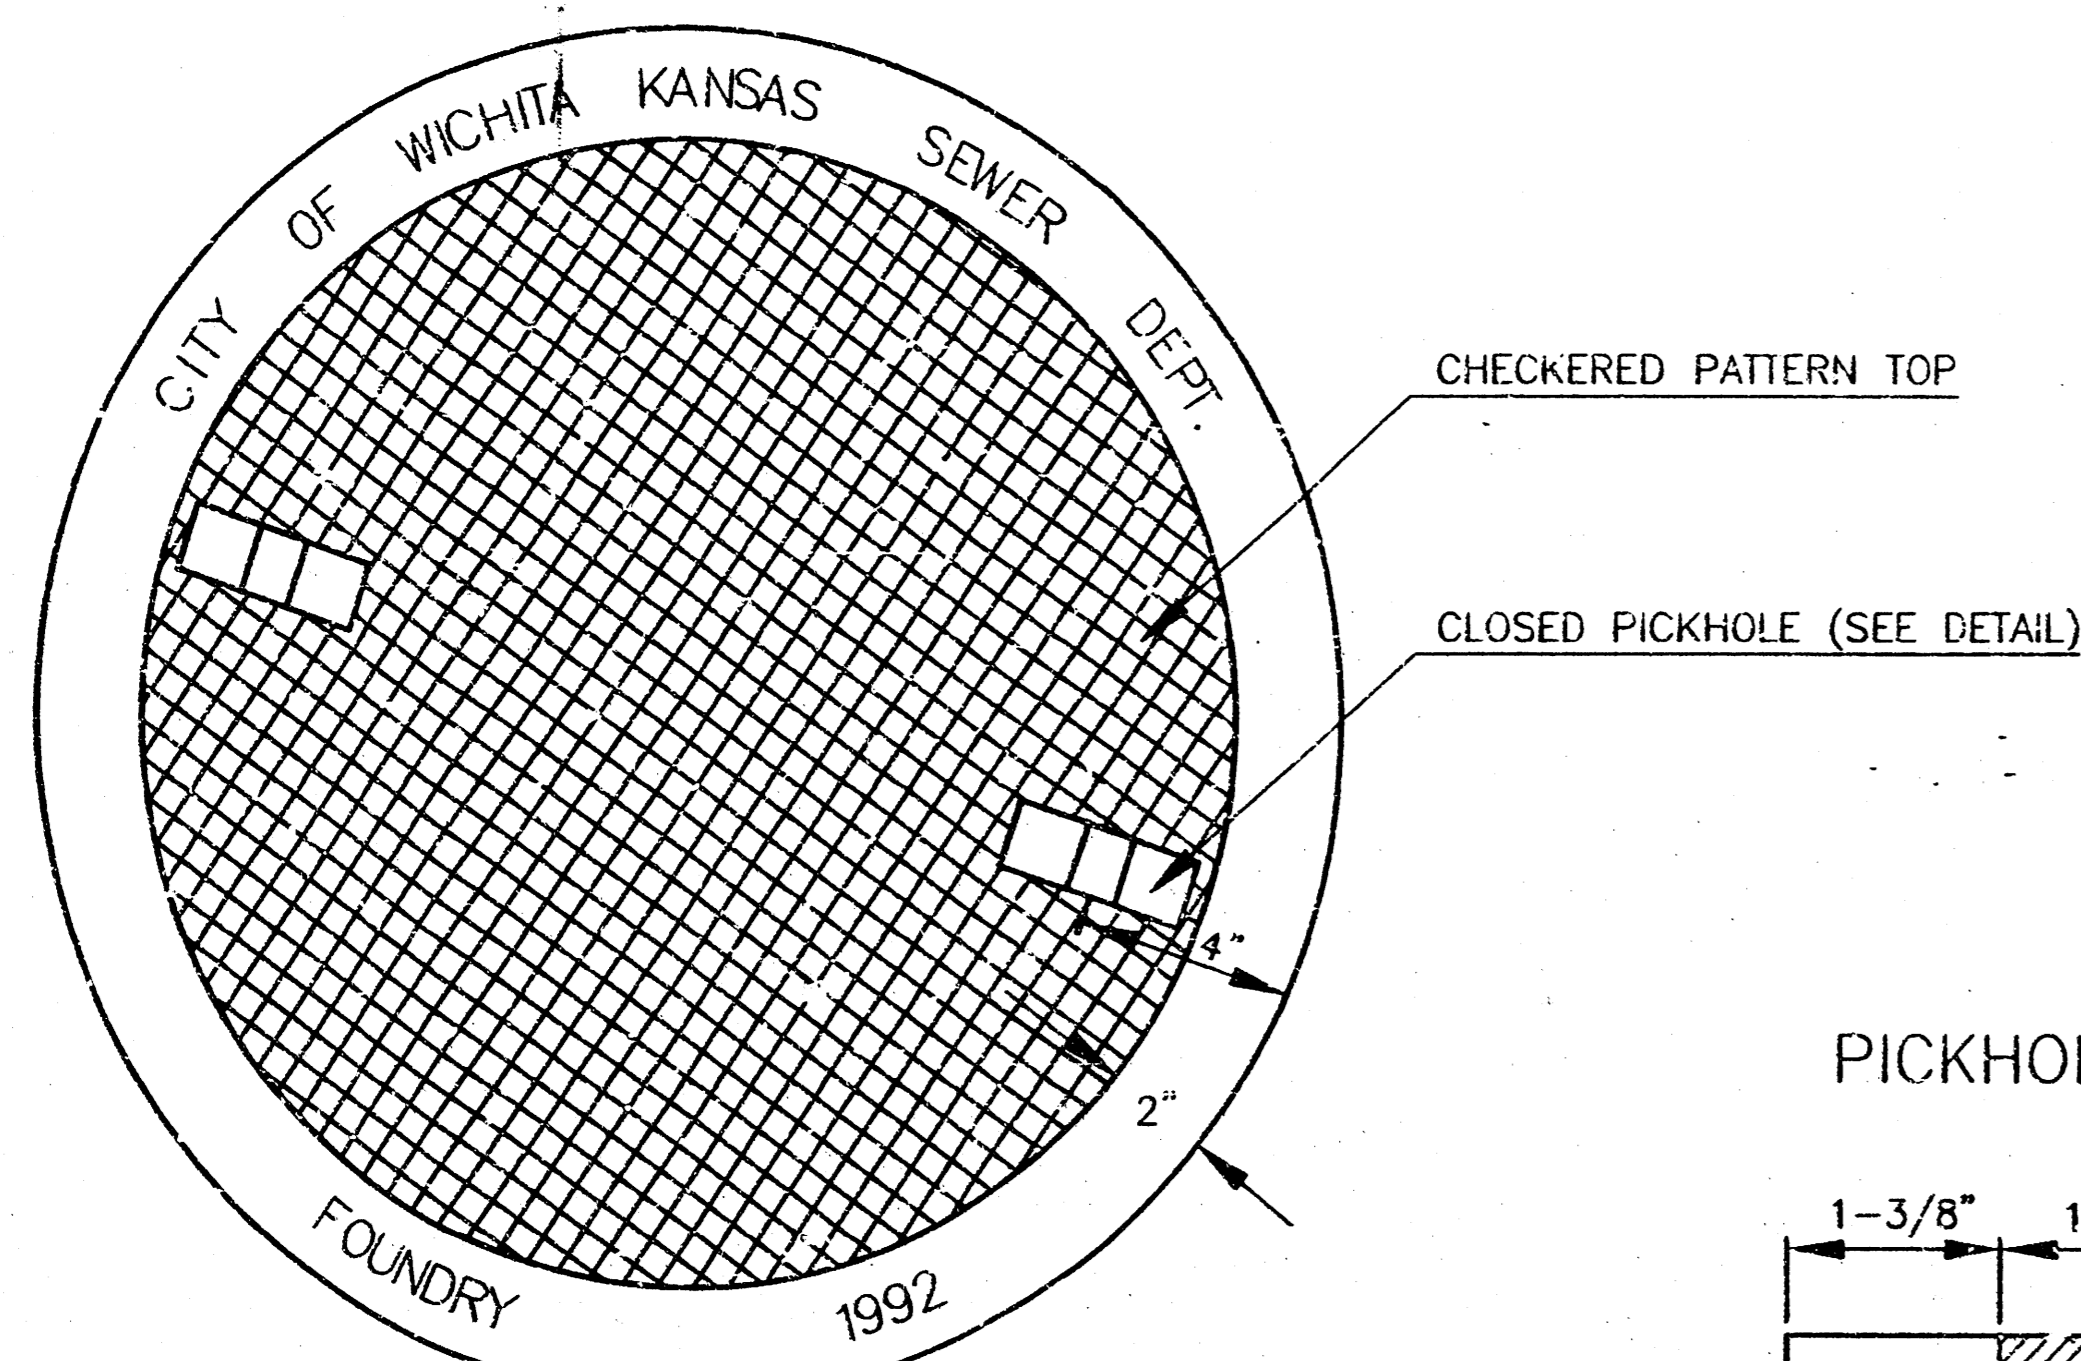


TOP VIEW


PICKHOLE DETAIL

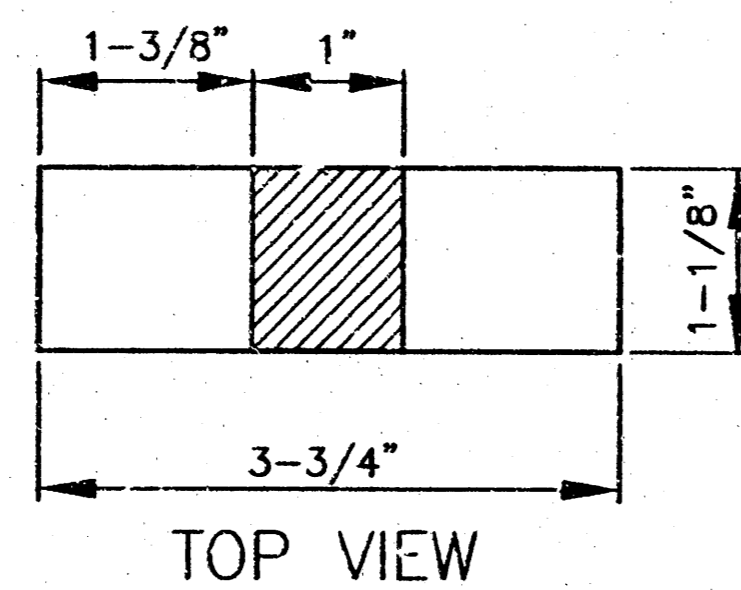


TOP VIEW

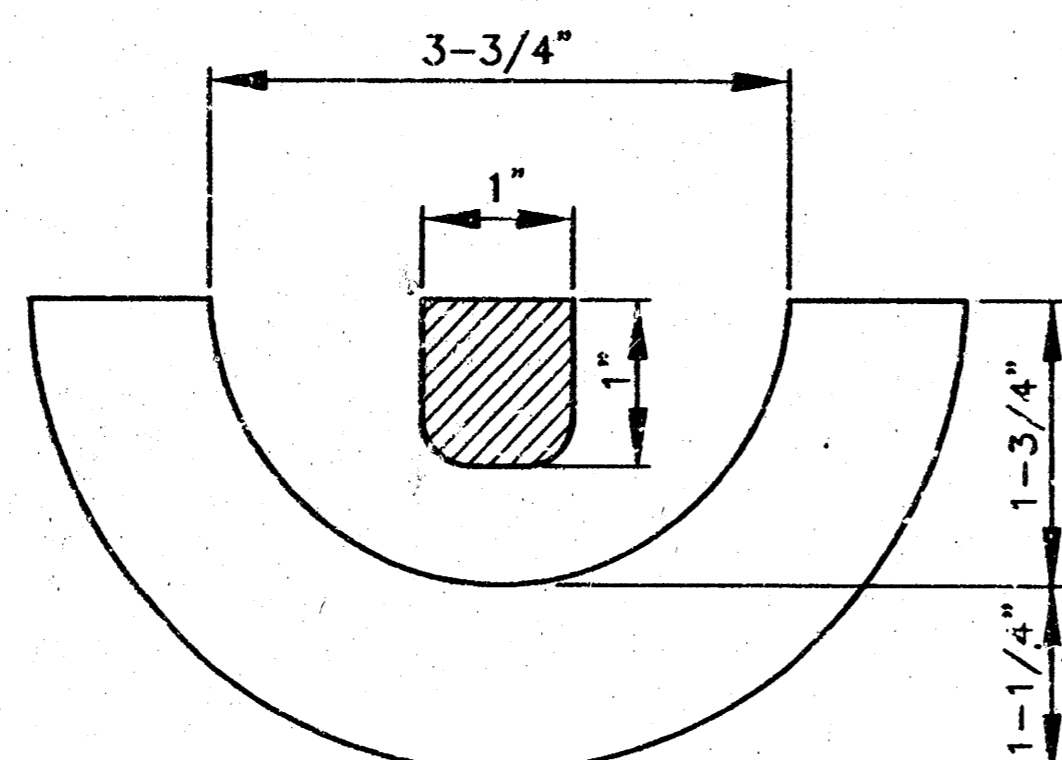

SECTION VIEW

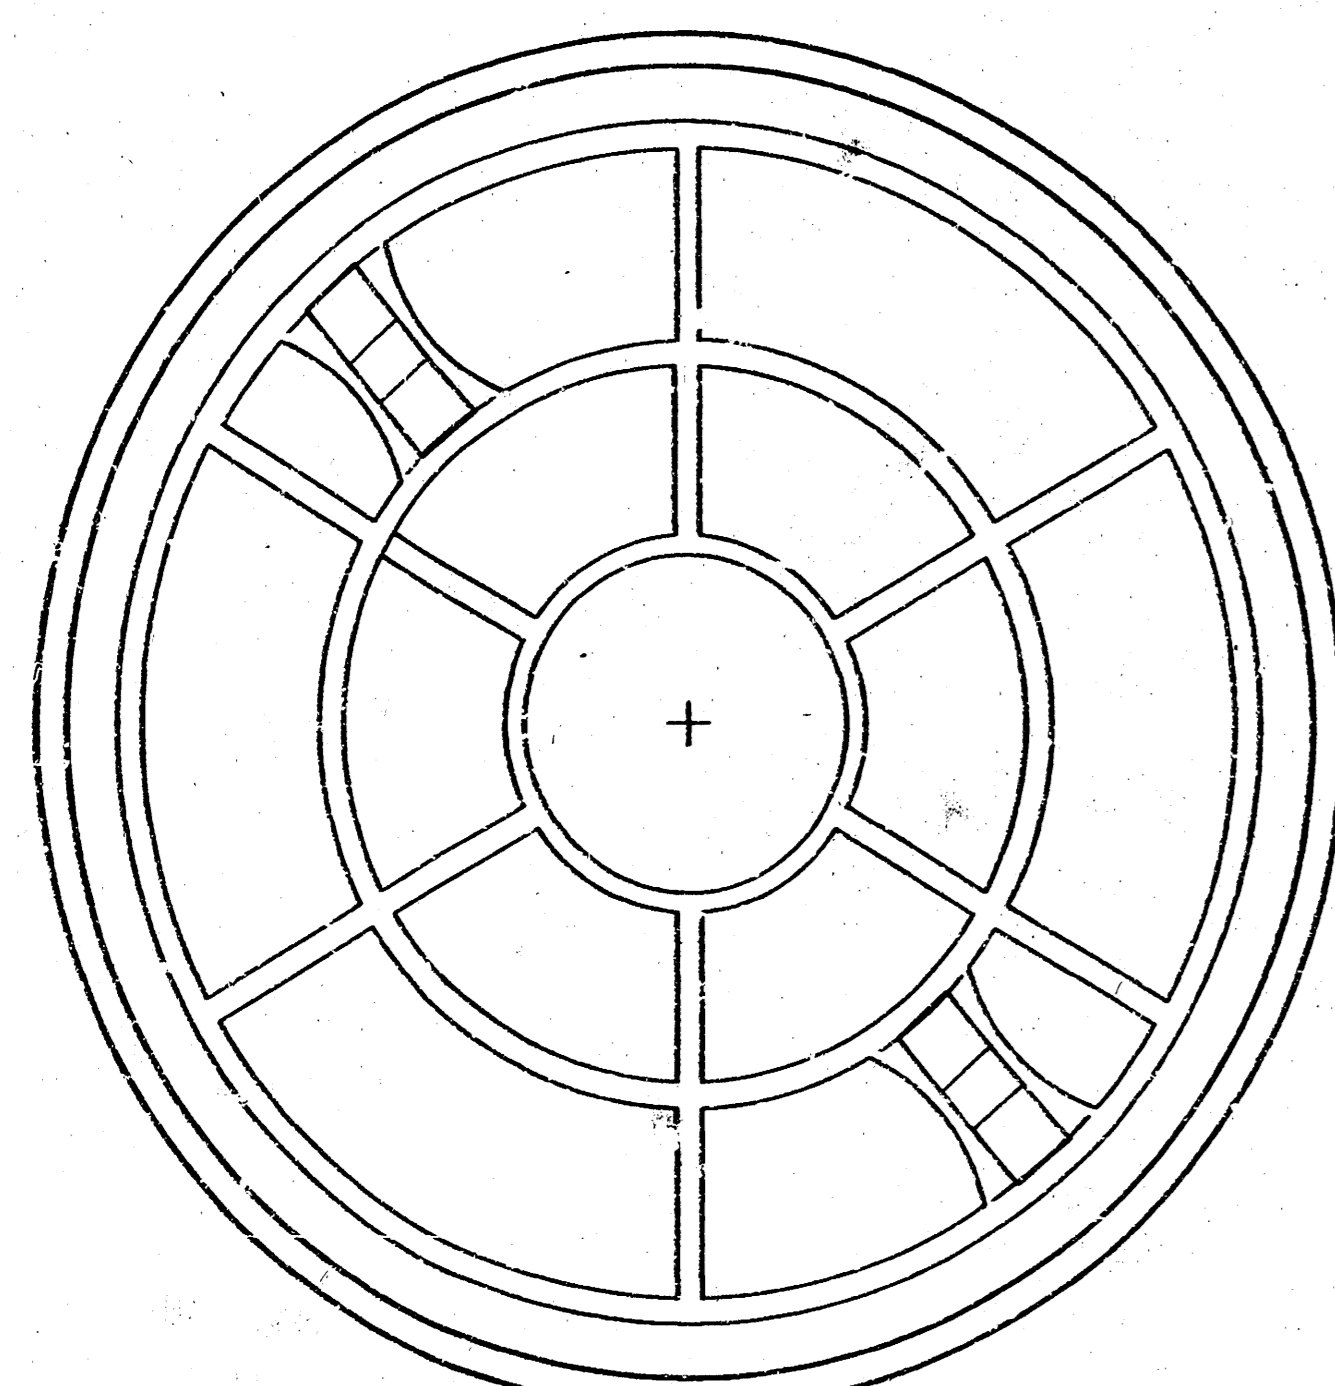


BOTTOM VIEW

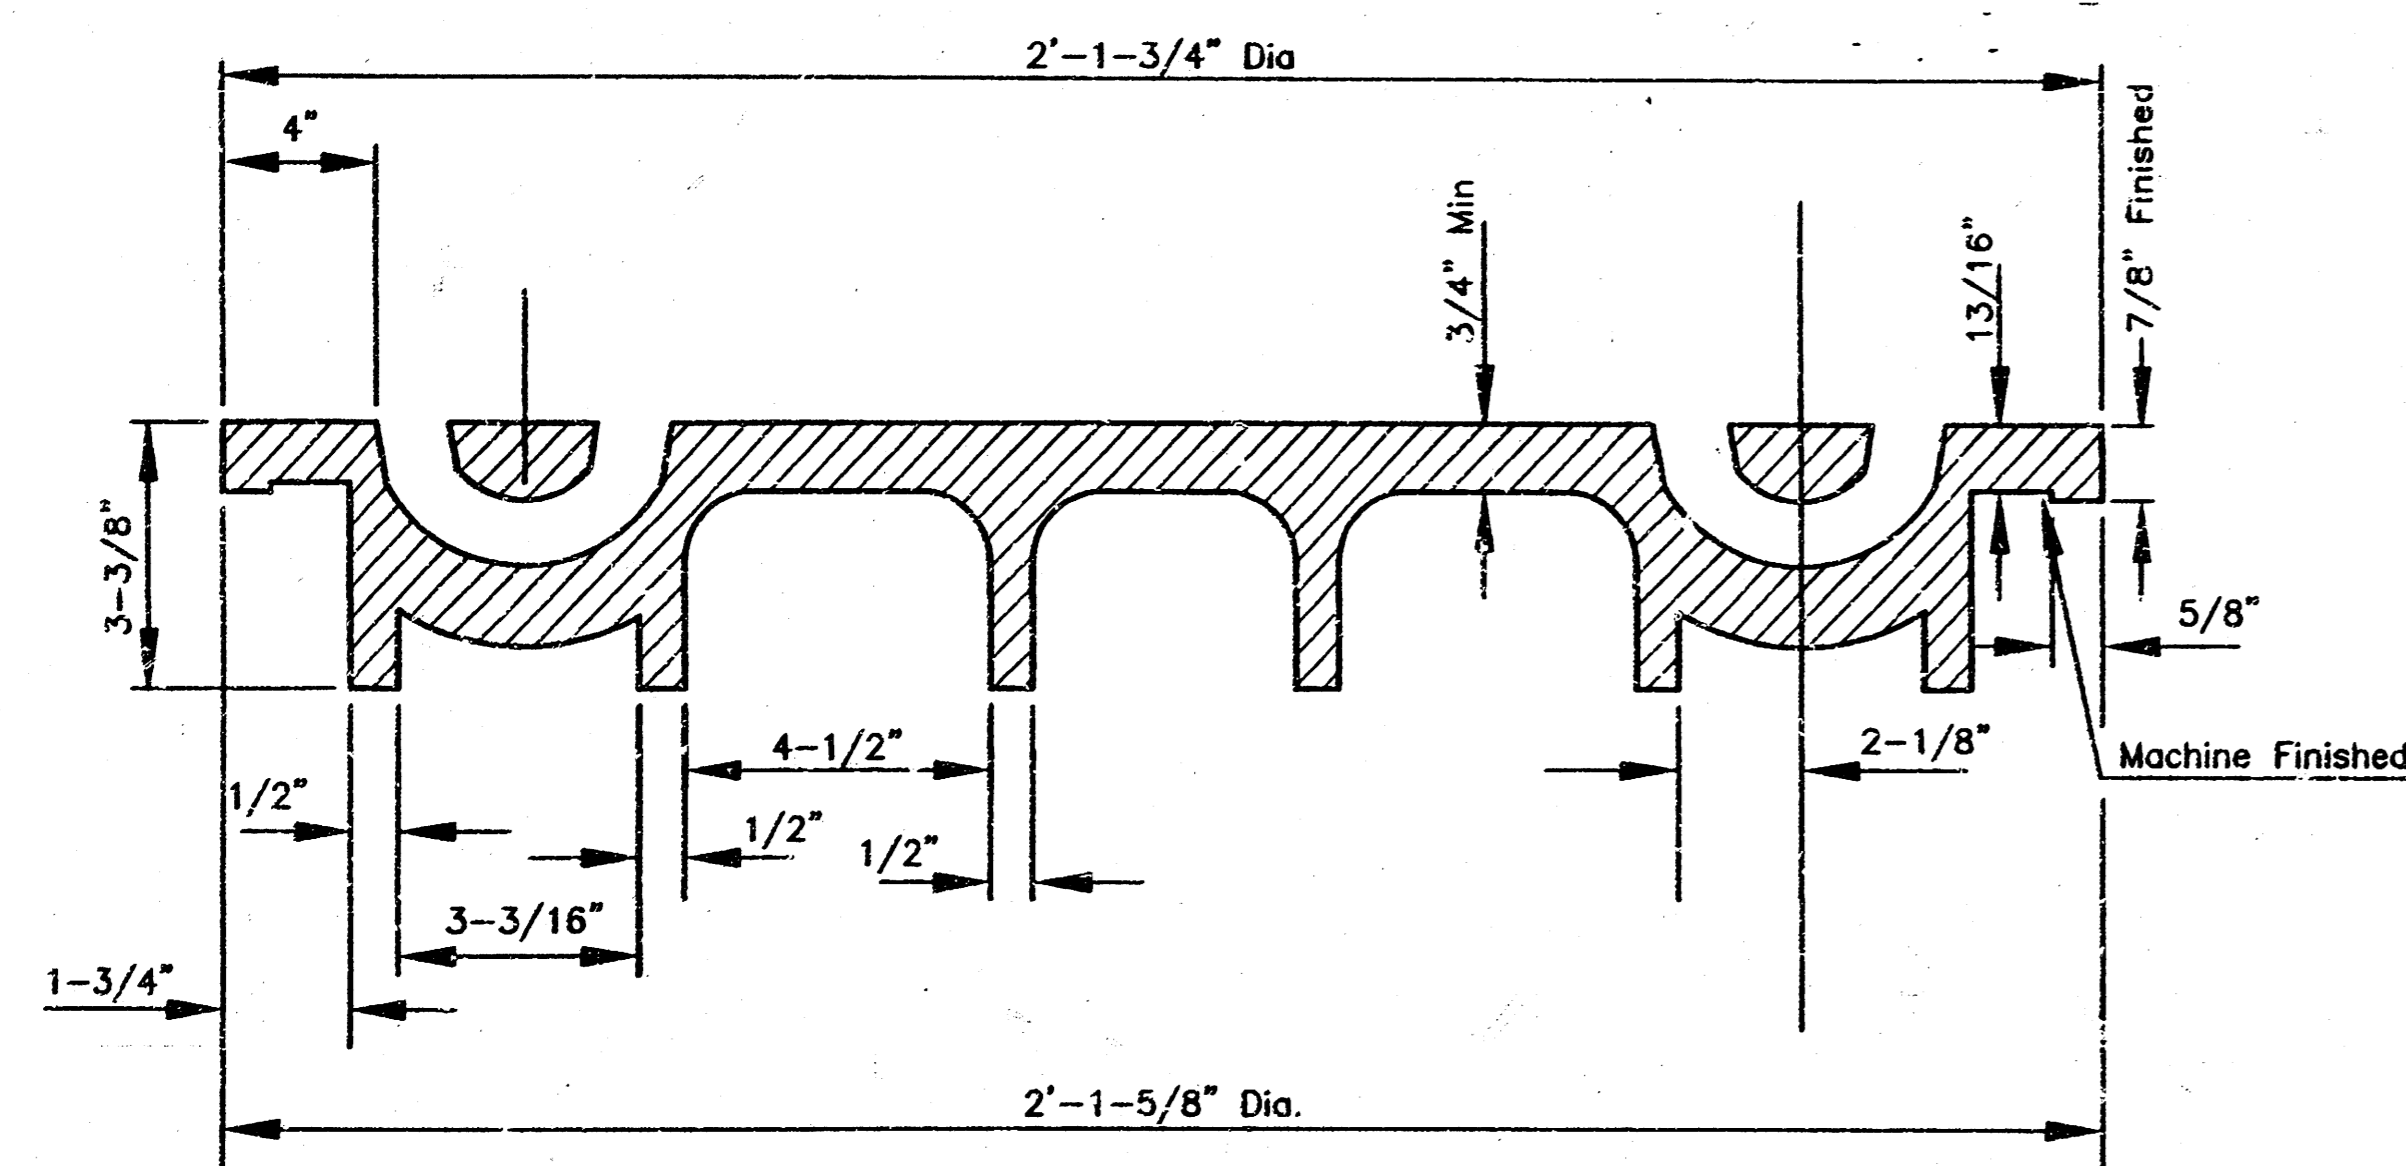

SECTION VIEW


MANHOLE FRAME  
Weight = 240 Lbs.

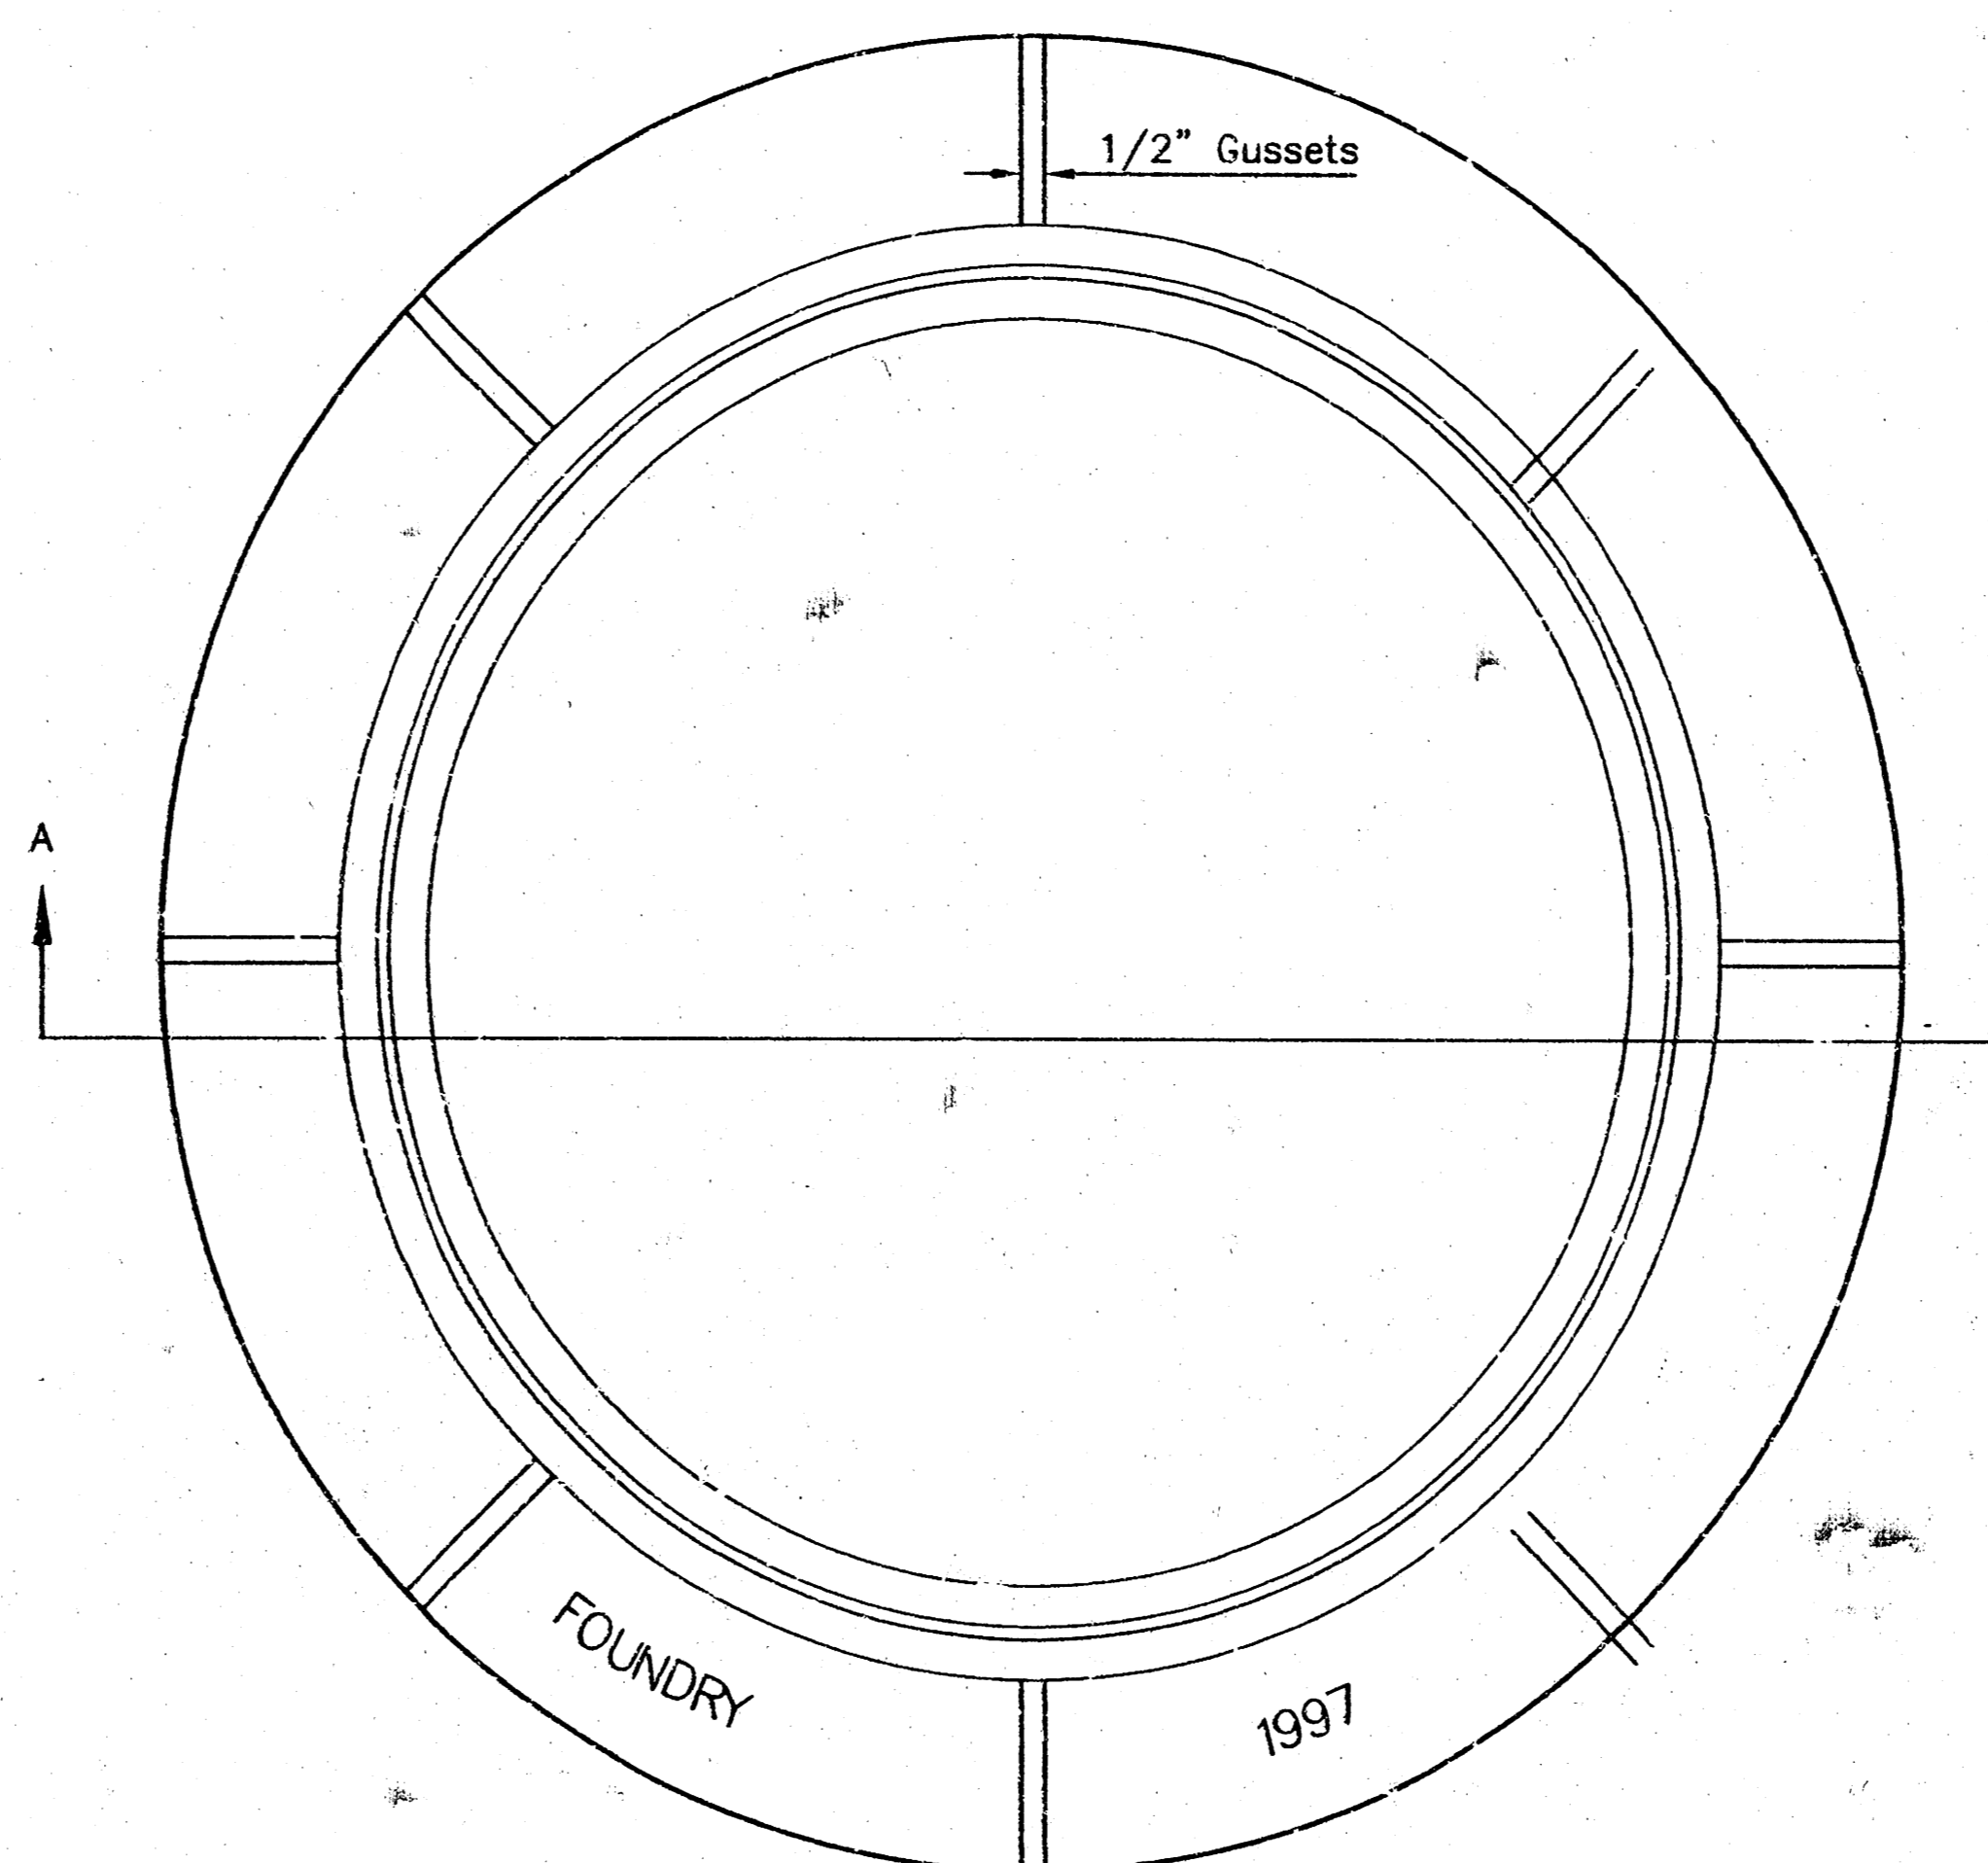


TOP VIEW

GENERAL NOTES

1. MANHOLE CASTINGS SHALL BE MANUFACTURED USING GOOD QUALITY GRAY IRON CONFORMING TO CLASS 30 OF A.S.T.M. DESIGNATION A-48. DIMENSIONS AND WEIGHTS SHOWN ON THE DETAILED DRAWINGS SHALL BE CONSIDERED AS MINIMUM REQUIREMENTS AND ANY DEVIATIONS FROM THE DIMENSIONS SHOWN MUST BE SPECIFICALLY APPROVED. THE FINISHED CASTINGS SHALL BE OF UNIFORM QUALITY, FREE FROM BLOWHOLES, POROSITY, HARD SPOTS, SHRINKAGE DISTORTIONS OR OTHER DEFECTS.
2. MANHOLE CASTINGS SHALL WEIGH A MINIMUM OF 180 POUNDS ON THE SOLID COVER AND 240 POUNDS ON THE MANHOLE RING. THIS IS A TOTAL OF 420 POUNDS ON A RING AND COVER SET. CASTINGS WEIGHING LESS THAN THE MINIMUM SPECIFICATIONS WILL NOT BE ACCEPTED.
3. MANHOLE CASTINGS SHALL BE MANUFACTURED SUCH THAT A COVER MANUFACTURED BY ANY ONE FOUNDRY WILL FIT INTERCHANGEABLY INTO A FRAME MANUFACTURED BY ANOTHER FOUNDRY AND STILL MEET ALLOWABLE CLEARANCES AND NON-ROCKING REQUIREMENTS. THIS WILL REQUIRE MANUFACTURING OF THE MATCHING FACES ON THE COVER AND THE FRAME TO CLOSE TOLERANCES.
4. THE OUTSIDE CIRCUMFERENCE OF THE VERTICAL FACE OF THE COVER AND THE INSIDE CIRCUMFERENCE OF THE VERTICAL FACE IN THE FRAME RECESS SHALL BE MANUFACTURED TO TOLERANCES SUCH THAT THE CLEARANCE BETWEEN THE COVER AND FRAME WILL NOT EXCEED 1/8" AT ANY POINT AROUND THE CIRCUMFERENCE OF THE COVER. THE SEATING SURFACES BETWEEN THE COVER AND FRAME SHALL BE MACHINED SUCH THAT THESE SEATING SURFACES SHALL MAKE FULL CONTACT FOR THEIR FULL CIRCUMFERENCE TO PRECLUDE THE COVER FROM ROCKING IN THE FRAME.
5. THE MANHOLE FRAME AND COVER SHALL BE MARKED WITH LETTERING INDICATING THE NAME OF THE MANUFACTURER AND THE YEAR WHEN THE COVER OR FRAME WAS CAST. THE COVER SHALL BE FURTHER IDENTIFIED WITH REGARDS TO OWNERSHIP USING LETTERS AT LEAST 1 INCH IN HEIGHT. THIS IDENTIFICATION SHALL BE "CITY OF WICHITA SEWER DEPARTMENT". THE WORD DEPARTMENT MAY BE ABBREVIATED. THE TEXTURE OF THE TOP SURFACE OF THE COVER SHALL BE MANUFACTURED IN A CHECKERED PATTERN DESIGN AS INDICATED ON THE DRAWINGS. SMOOTH BLOCKOUTS SHALL BE UTILIZED TO HIGHLIGHT THE LETTERING ON THE COVER SURFACE. THE TOTAL AREA OF SMOOTH SURFACE BLOCKOUT SHALL NOT EXCEED THE AREA AS INDICATED ON THE DRAWING. POSITIONING OF SMOOTH BLOCKOUTS AND LETTERING MAY VARY FROM THAT SHOWN ON THE DETAILED DRAWING.

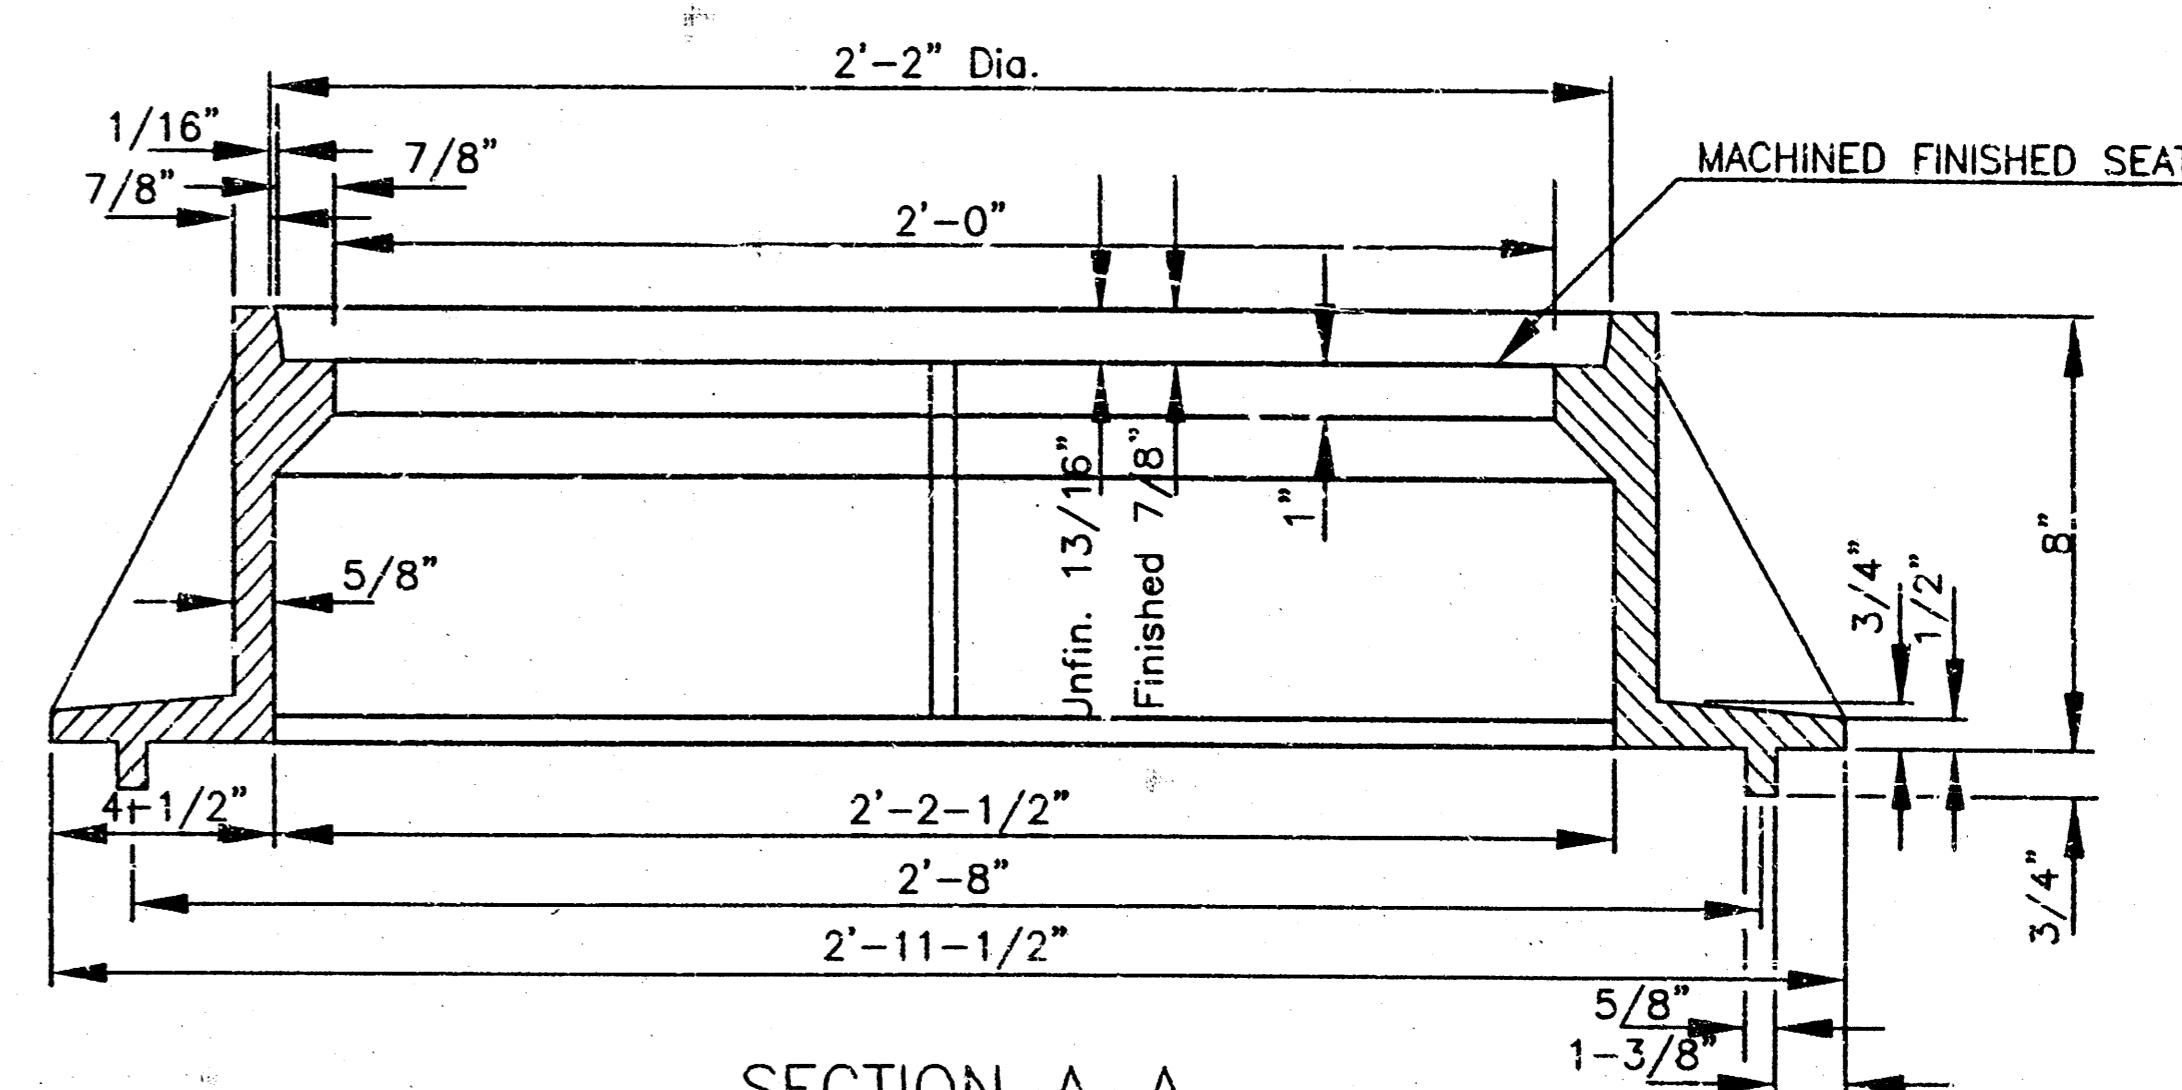


SECTION A-A  
MUD RING

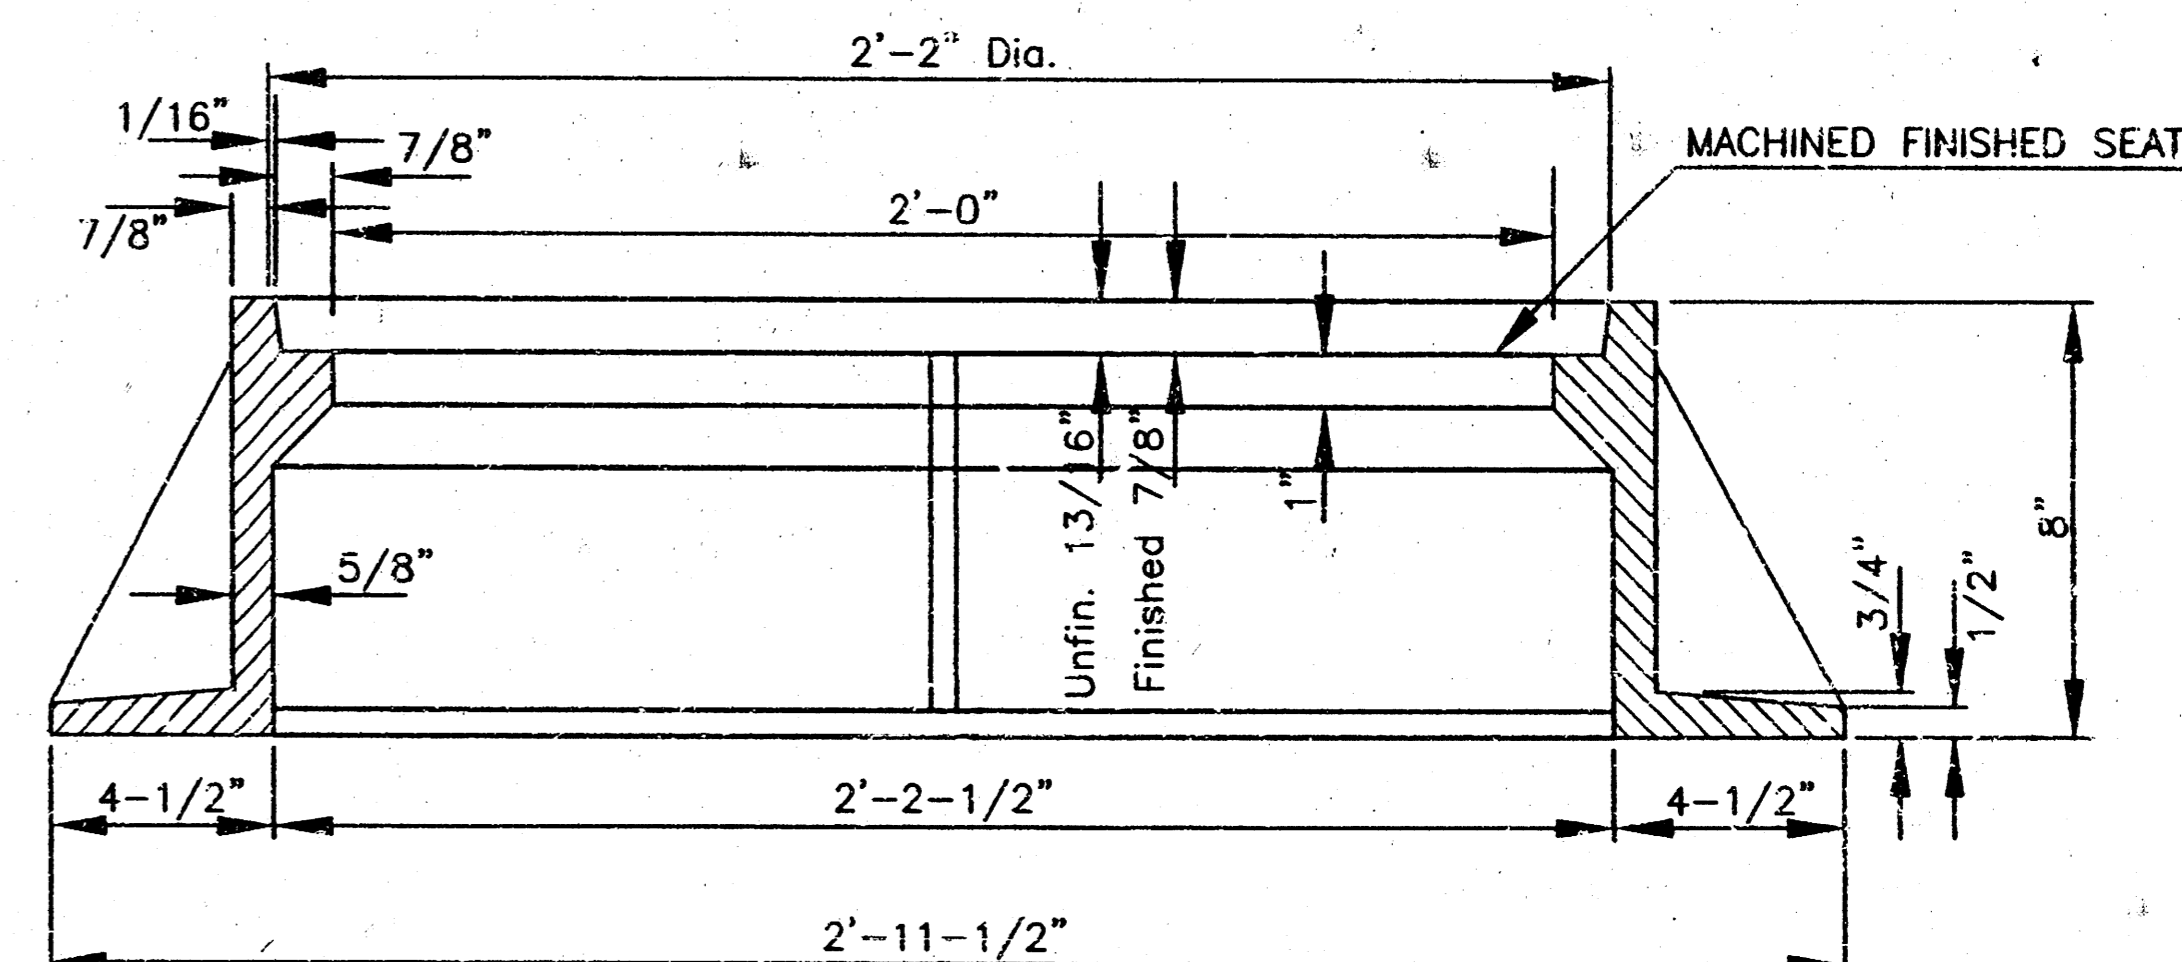


SECTION A-A

<p>THE CITY OF WICHITA</p> <p>CITY ENGINEER'S OFFICE CITY HALL - SEVENTH FLOOR 426 NORTH MAIN STREET WICHITA, KANSAS 67202 (316) 243-5901 (316) 243-2114 FAX</p>	<p>MANHOLE FRAME AND COVER</p>	
	<p>M. E. LINDEBAK P.E. - CITY ENGINEER</p>	
<p>PROJECT NUMBER 834995</p>	<p>INDEX CODE 607851</p>	
<p>DATE MAR 96</p>	<p>SHEET 9 OF 12</p>	

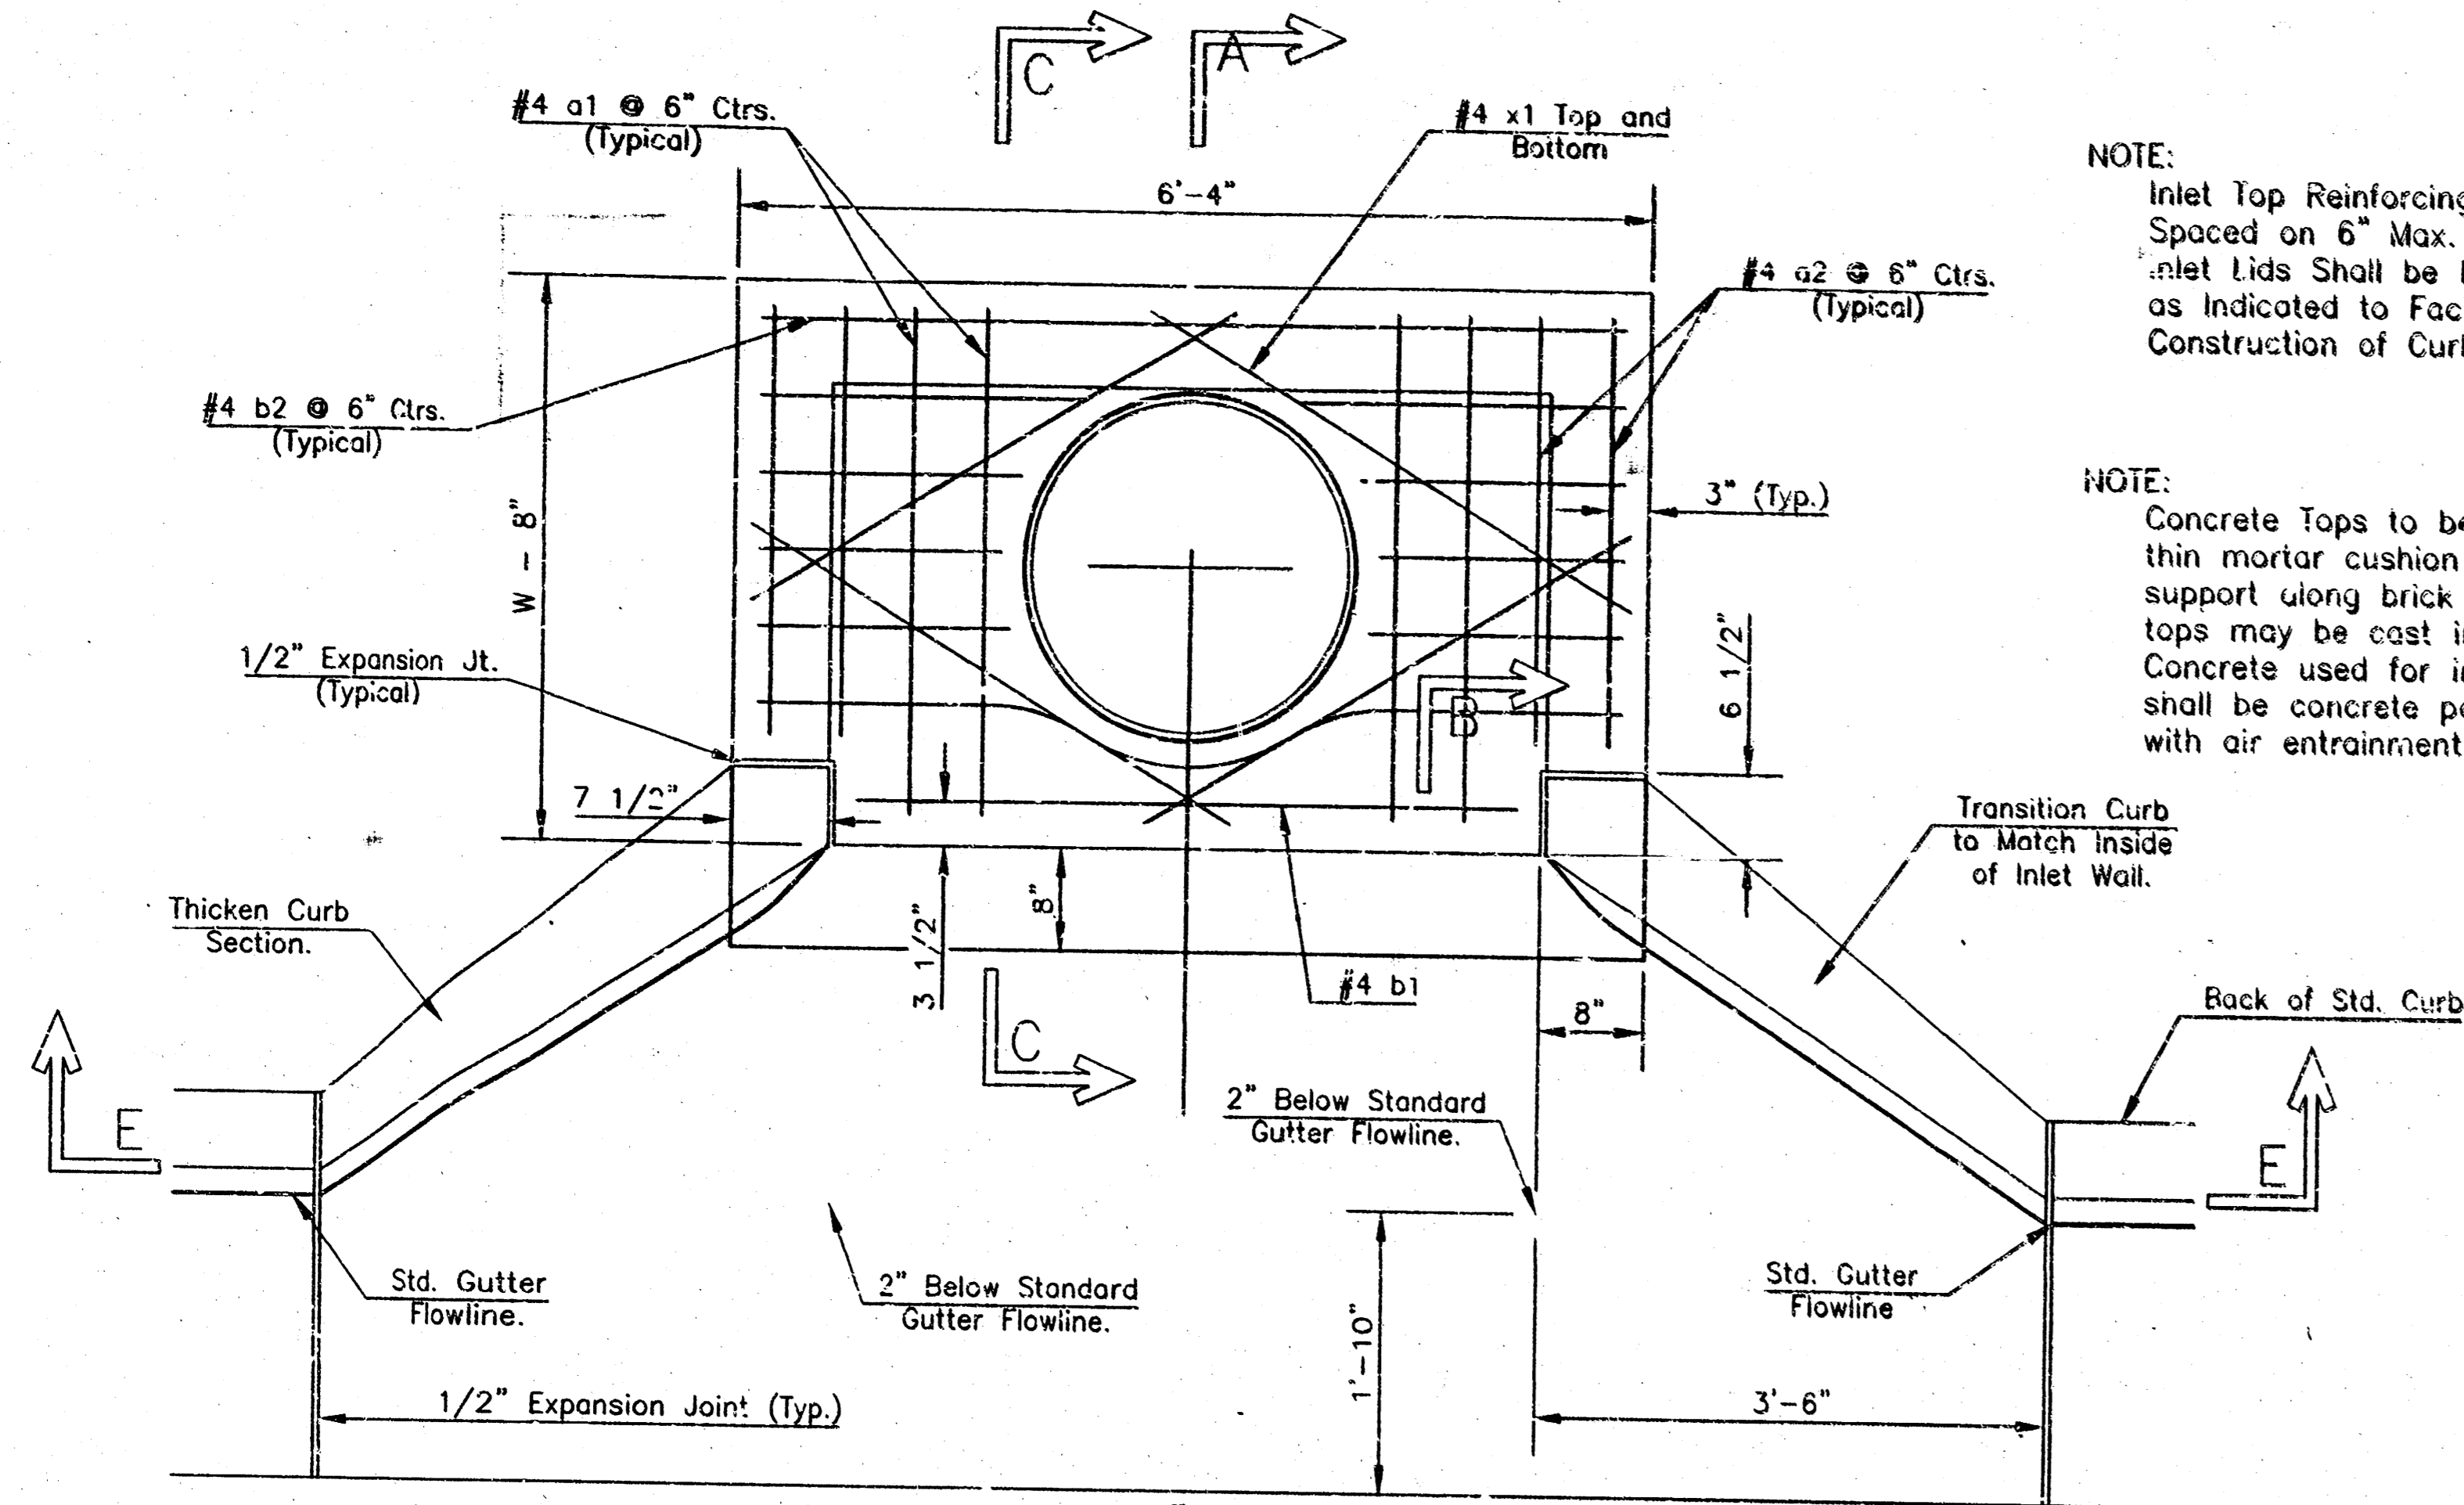


NOTE: Expansion Joint Only in Curb Area With Concrete Pavement.

PLAN

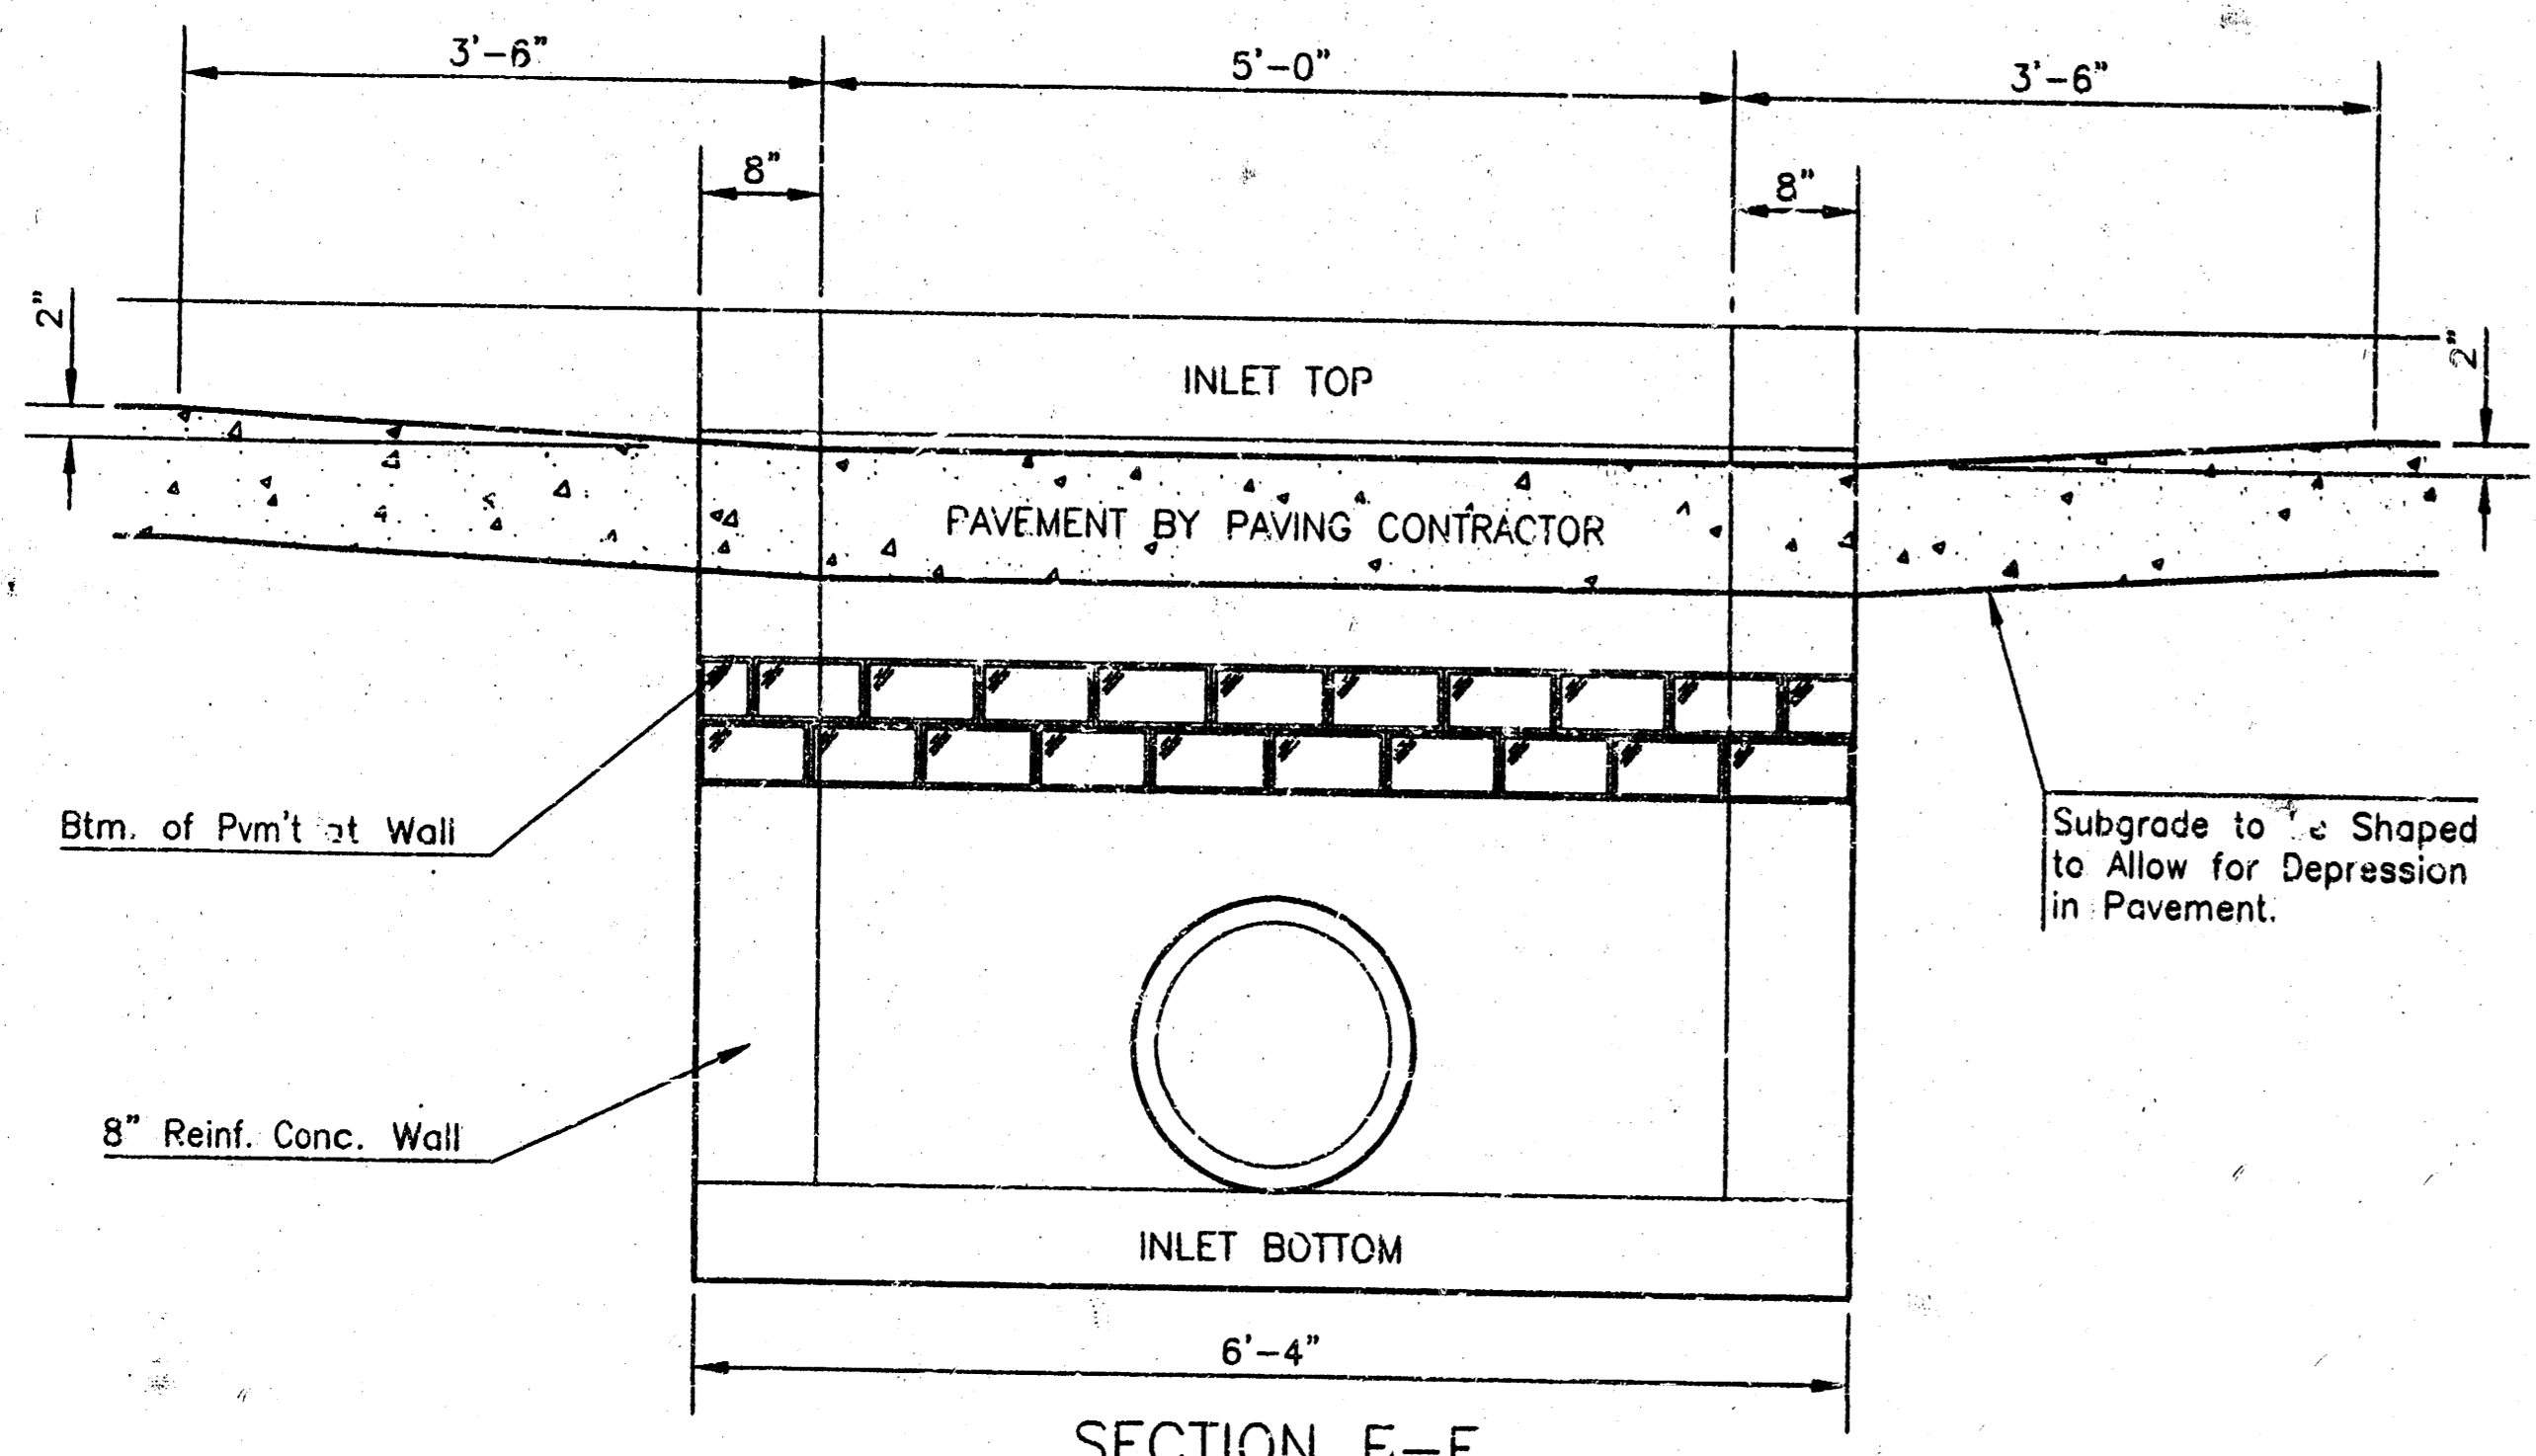

SECTION E-E

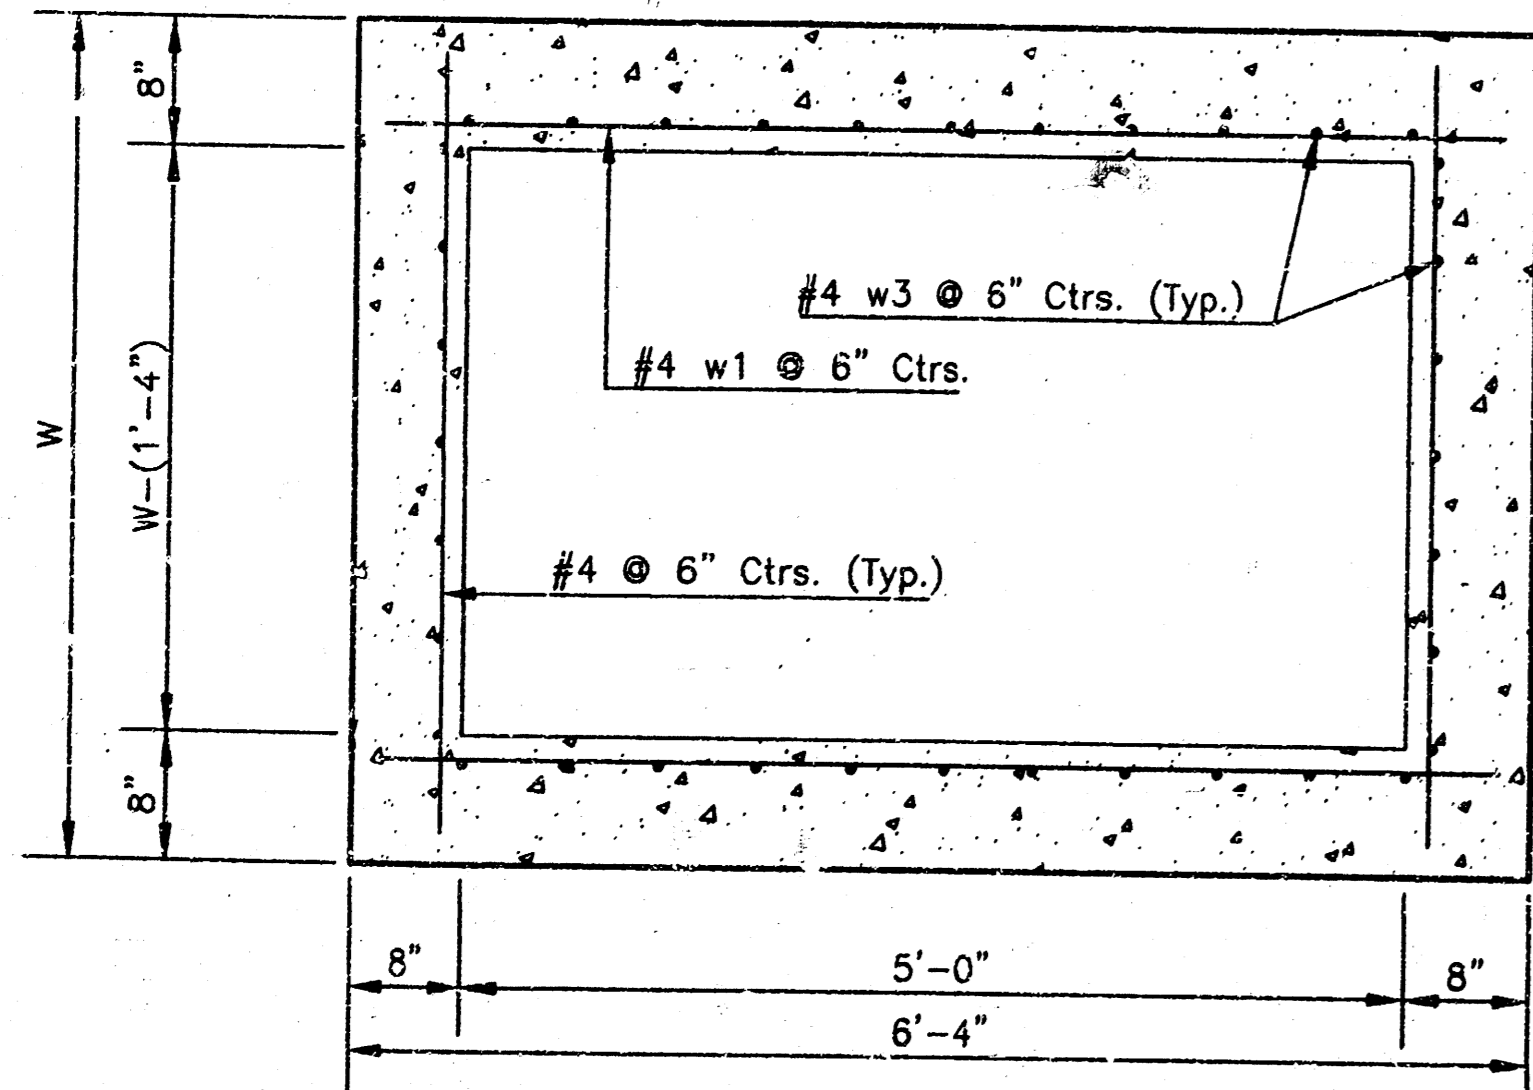

SECTION D-D

NOTE: Contractor shall have the option of constructing 8" brick masonry walls between the concrete inlet base and top on this inlet when W=6'-4" and H=7'-0" or less.


Additional curb and gutter construction necessary to connect set-back inlet to pavement will be paid for at the unit price bid for each inlet hookup.

Inlet invert shall be shaped with 8 sack sand mix concrete to create flow channels and to increase hydraulic efficiency such that the inlet will be self-cleaning between inlet and/or outlet pipes.

The ends of all pipes installed in inlets shall be cut off flush with the inside face of the inlet wall.


NOTE: Inlet Top Reinforcing shall be Spaced on 6" Max. Centers. Inlet Lids Shall be Notched Out as Indicated to Facilitate Construction of Curb.

NOTE: Concrete Tops to be installed on thin mortar cushion to insure full support along brick walls. Concrete tops may be cast in place or precast. Concrete used for inlet construction shall be concrete pavement mix with air entrainment.

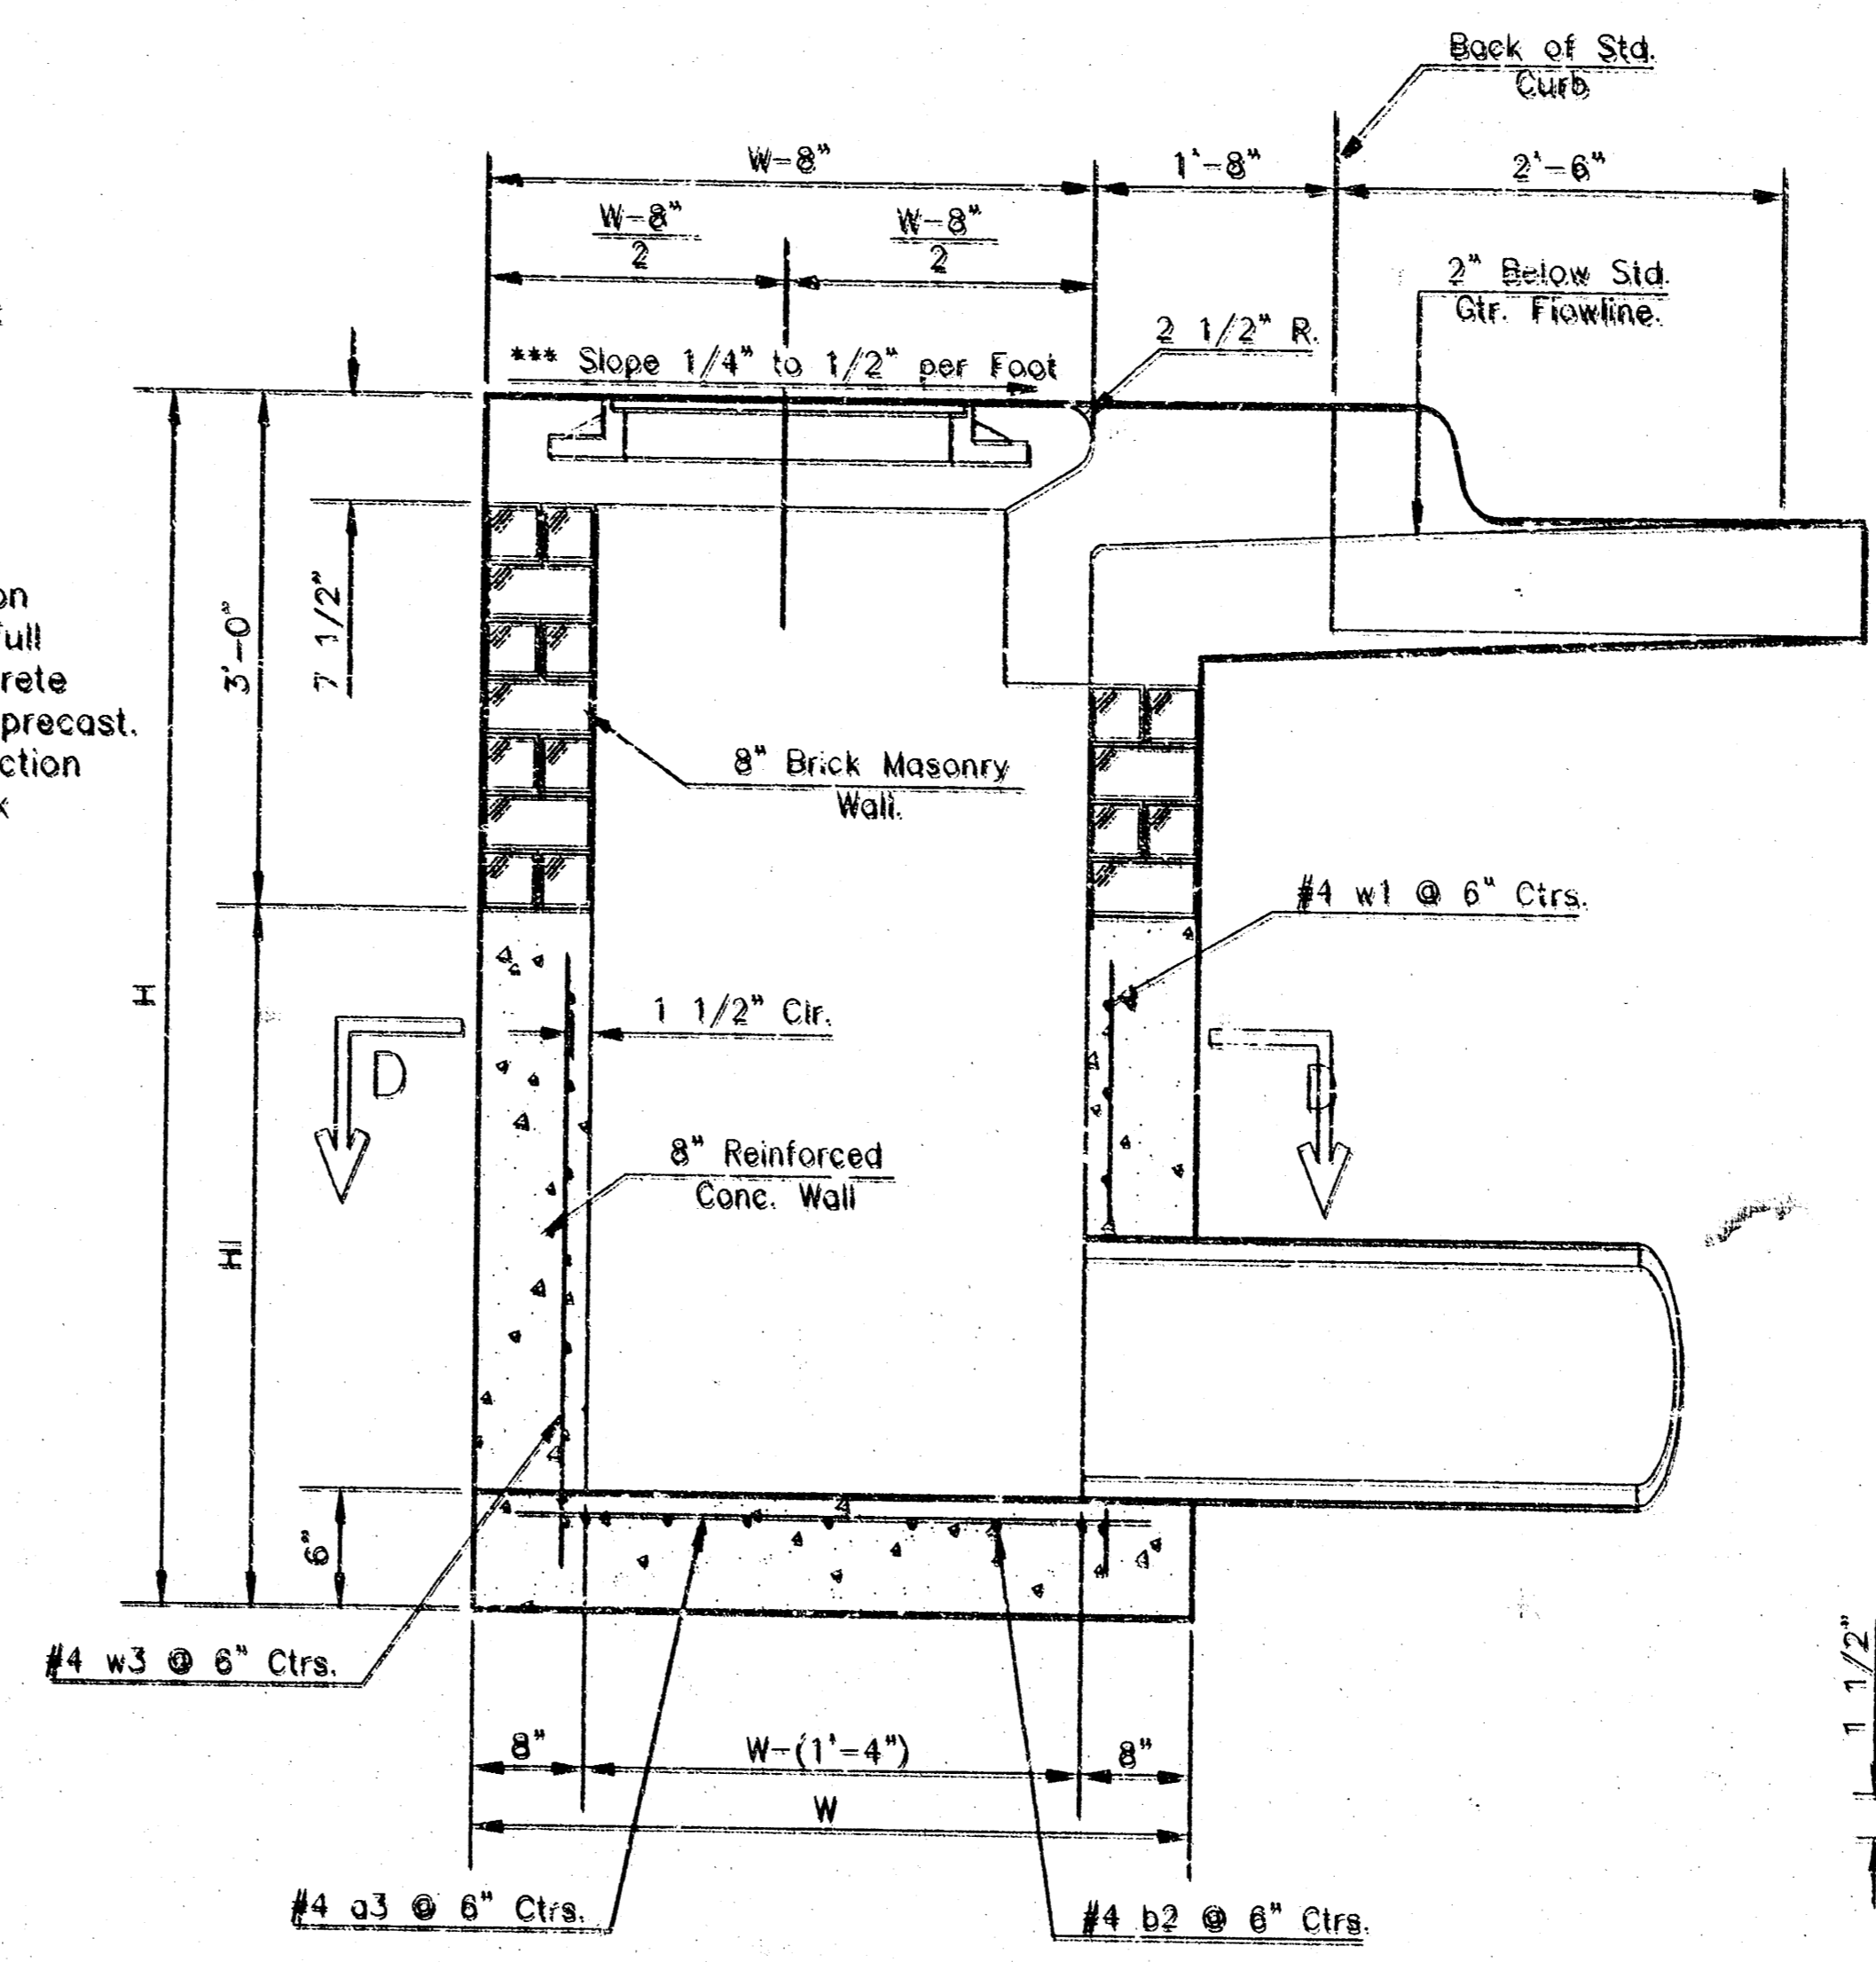


SECTION A-A


\*\*\*NOTE: Slope of Inlet tops to Match Sidewalk or Parking Slopes within Limits Indicated.

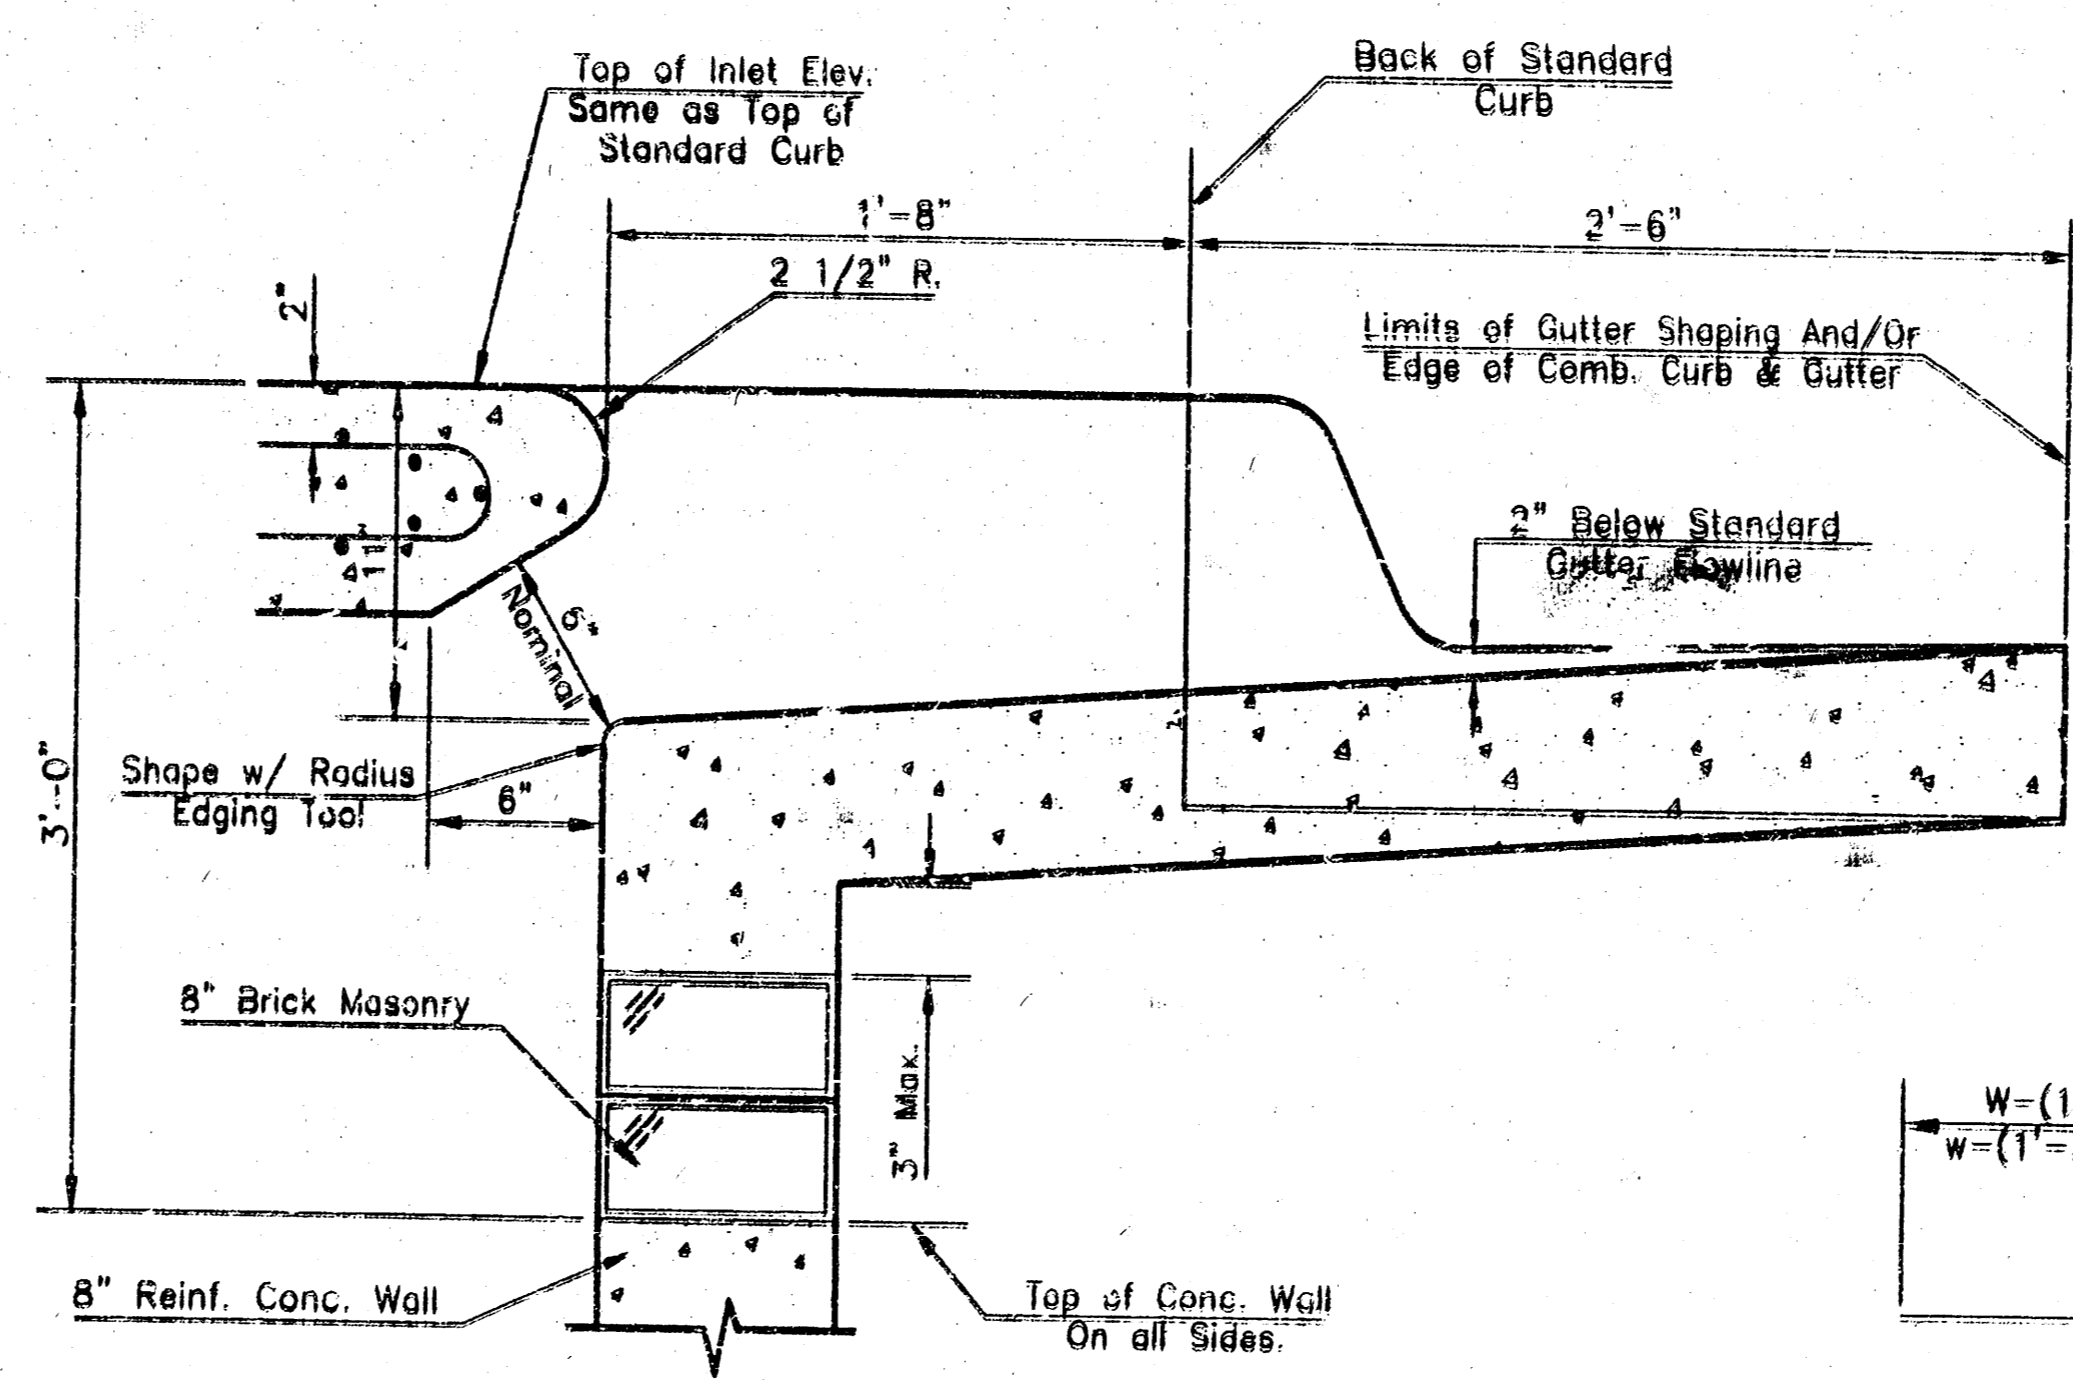

SECTION B-B

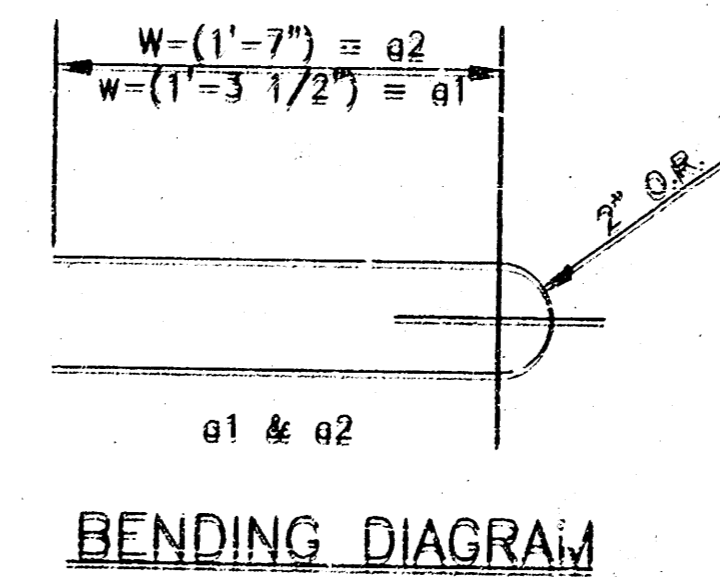


BENDING DIAGRAM

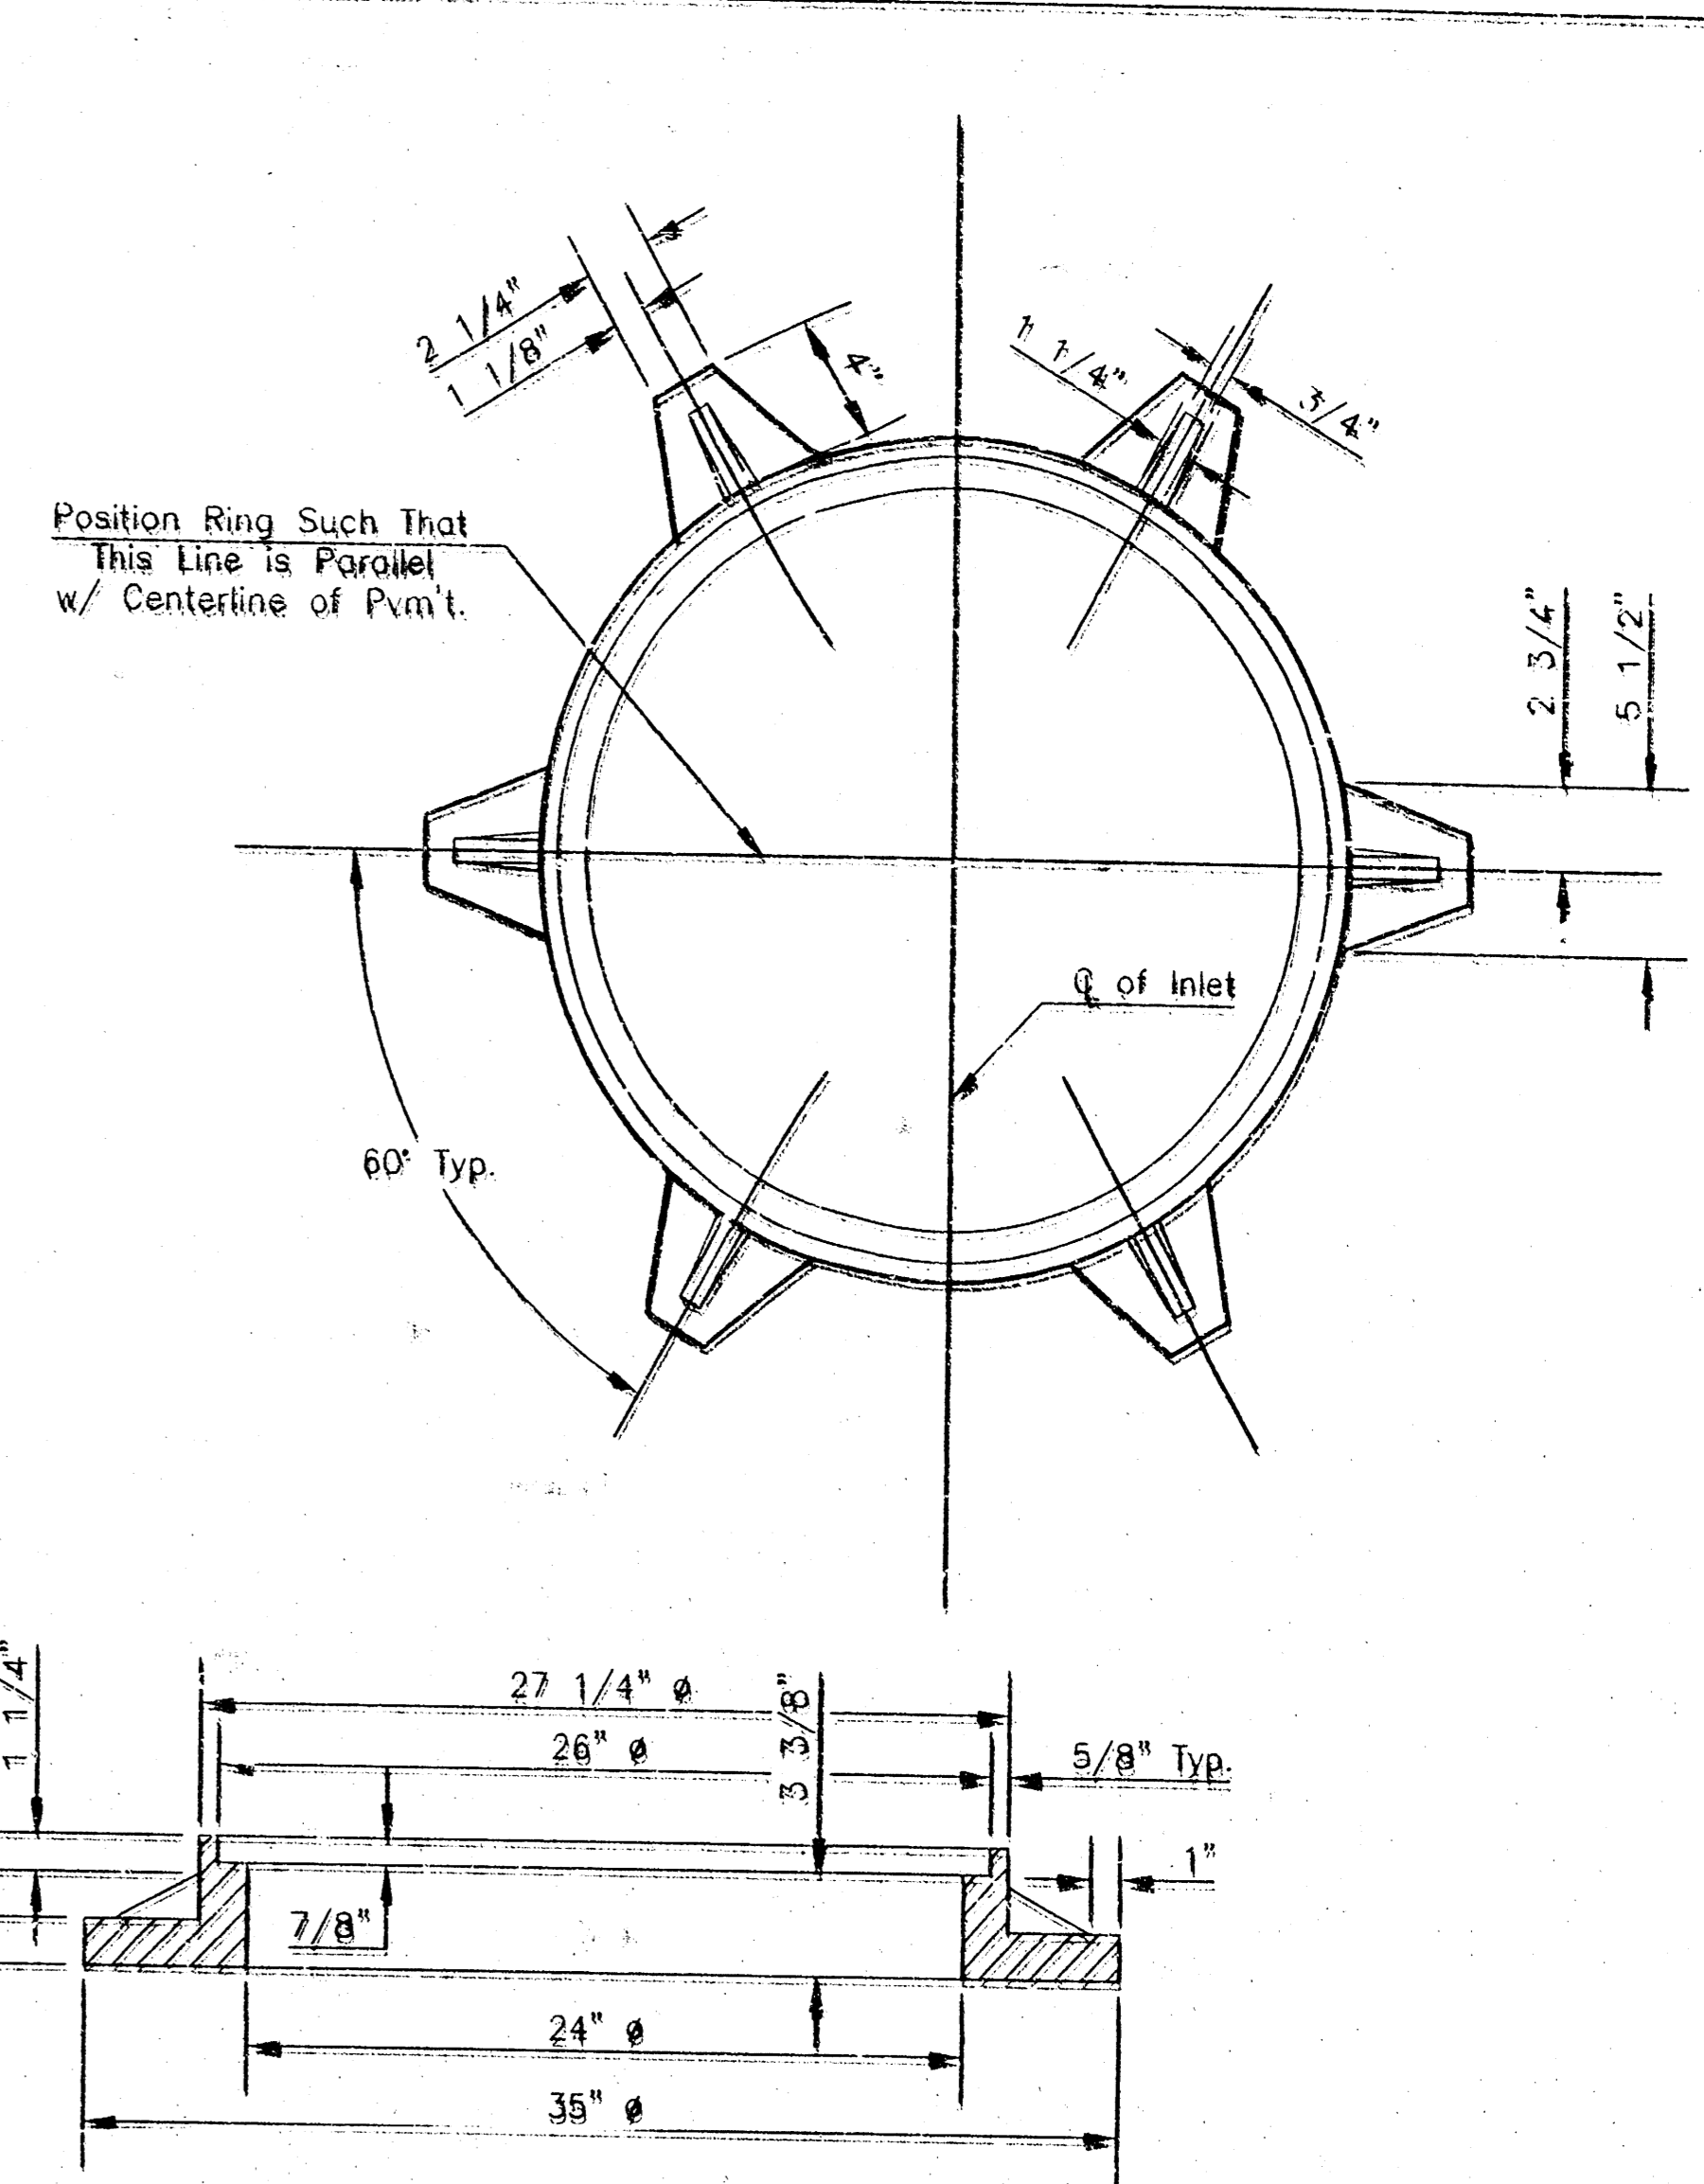

MANHOLE RING AND COVER

Weight = 180 Lbs.  
\*See City of Wichita Standard Manhole Ring and Cover Detail Sheet for Cover Details to Be Used With Inlet Frame.

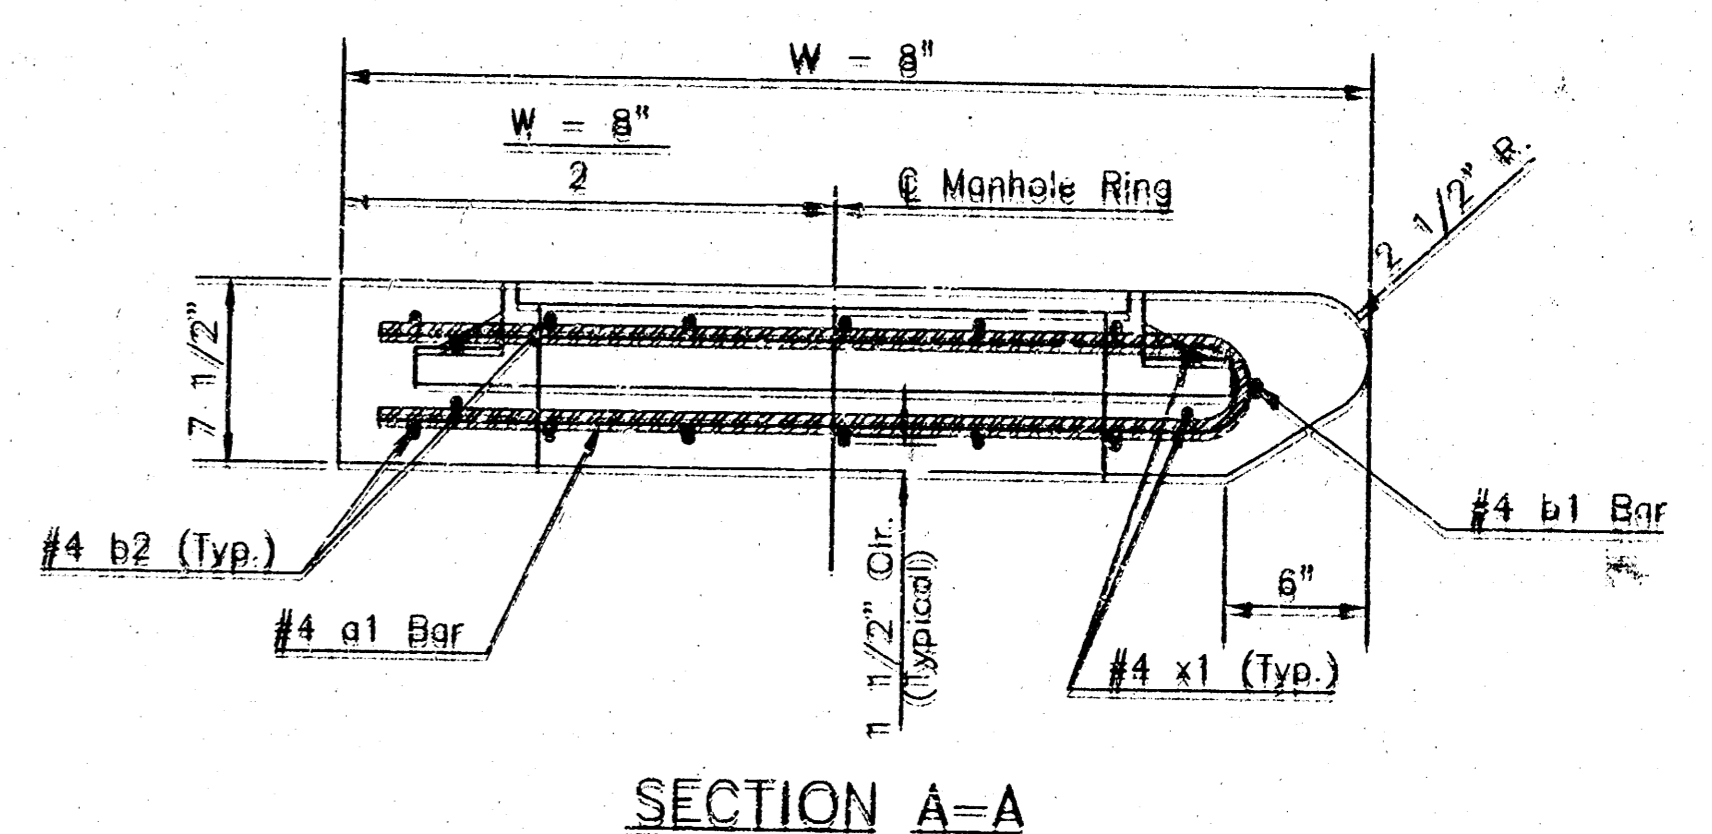

SECTION A-A

STANDARD CURB INLET PRECAST TOPS			
W	PRE-CAST TOP SIZE	PIPE SIZE	CU. YD. CONG.
4'-4"	3'-8" x 6'-4" x 7 1/2"	21" & SMALLER	0.38±
5'-4"	4'-8" x 6'-4" x 7 1/2"	24" & 30"	0.51±
6'-4"	5'-8" x 6'-4" x 7 1/2"	36" & 42"	0.64±
7'-4"	6'-8" x 6'-4" x 7 1/2"	48" & 54"	0.77±
8'-4"	7'-8" x 6'-4" x 7 1/2"	60" & 66"	0.90±

PRECAST SLAB AND FLOOR REINFORCING									
MARK	SIZE	NO.	LENGTH	NO.	LENGTH	NO.	LENGTH	NO.	LENGTH
* a1	#4	6	6'-7"	6	8'-7"	6	10'-7"	6	14'-7"
a2	#4	4	6'-0"	4	8'-0"	4	10'-0"	4	14'-0"
a3	#4	13	4'-1"	13	5'-1"	13	8'-1"	13	7'-1"
b1	#4	1	4'-9"	1	4'-9"	1	4'-9"	1	4'-9"
* b2	#4	23	6'-1"	29	6'-1"	35	6'-1"	41	6'-1"
x1	#4	8	3'-10"	8	4'-2"	8	4'-6"	8	4'-10"

WALL REINFORCING									
MARK	SIZE	NO.	LENGTH	NO.	LENGTH	NO.	LENGTH	NO.	LENGTH
w1	#4	4	6'-1"	4	6'-1"	4	6'-1"	4	6'-1"
w2	#4	4	4'-1"	4	5'-1"	4	5'-1"	4	7'-1"
w3	#4	32	4'-0"	36	4'-0"	40	4'-0"	44	4'-0"

\* Field, Bend or Cut Reinforcing as Required for Clearance.  
⊙4 (H<sub>1</sub> = 12") (H<sub>2</sub> = 21") Rounded down to nearest 0.5"  
⊙H<sub>1</sub> = 3"



THE CITY OF WICHITA  
CITY ENGINEER'S OFFICE  
607 N. SOUTHWEST STREET  
WICHITA, KANSAS 67202  
316-261-7174 FAX

**STANDARD TYPE 1-A  
CURB INLET**  
OPENING = 6" x 5'-0"


M. E. LINDEBAK P.E. - CITY ENGINEER

PROJECT NUMBER: 834PPS INDEX CASE: 607861  
DATE: MAR 96 SHEET 10 OF 12

C:\PHOTOS\BDD073.DWG THU SEP 03 03:35:01 1998 SAK


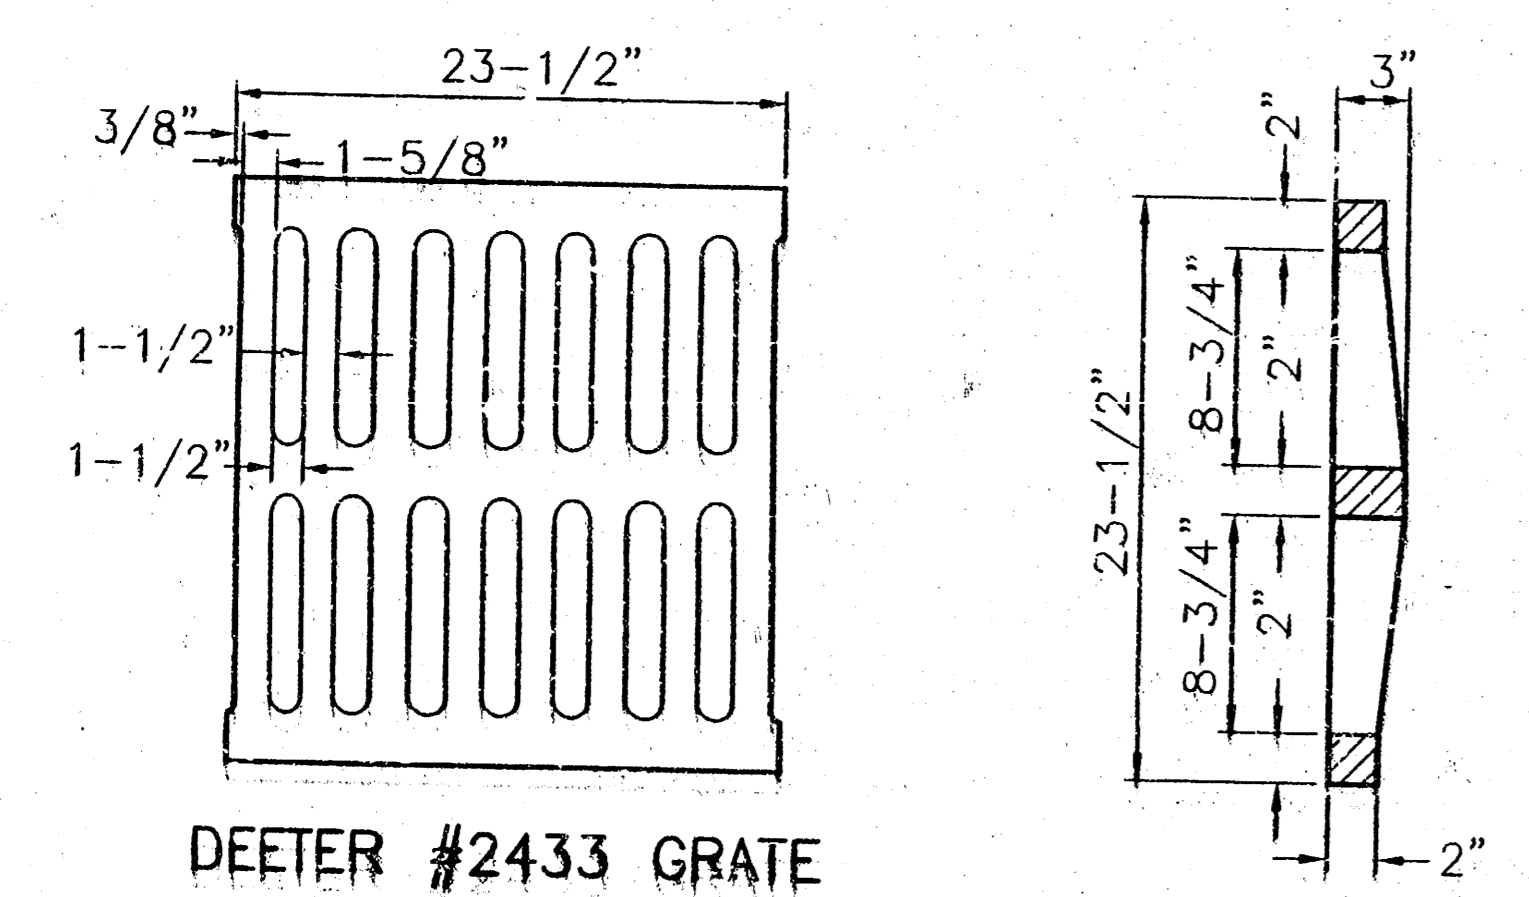
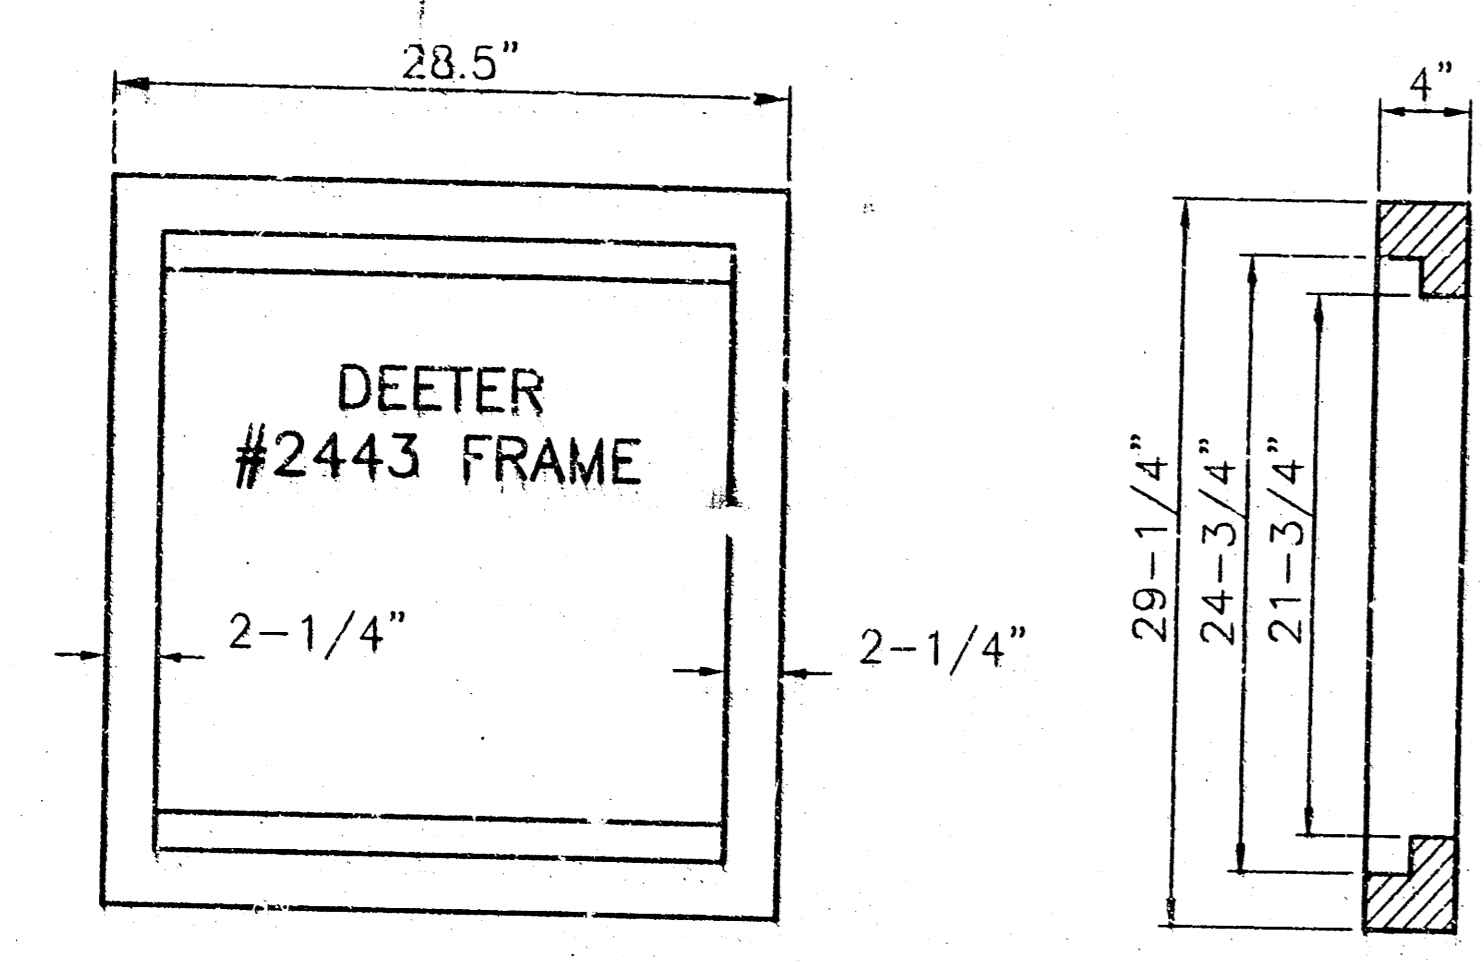


24" x 24" Frame and Grate Detail

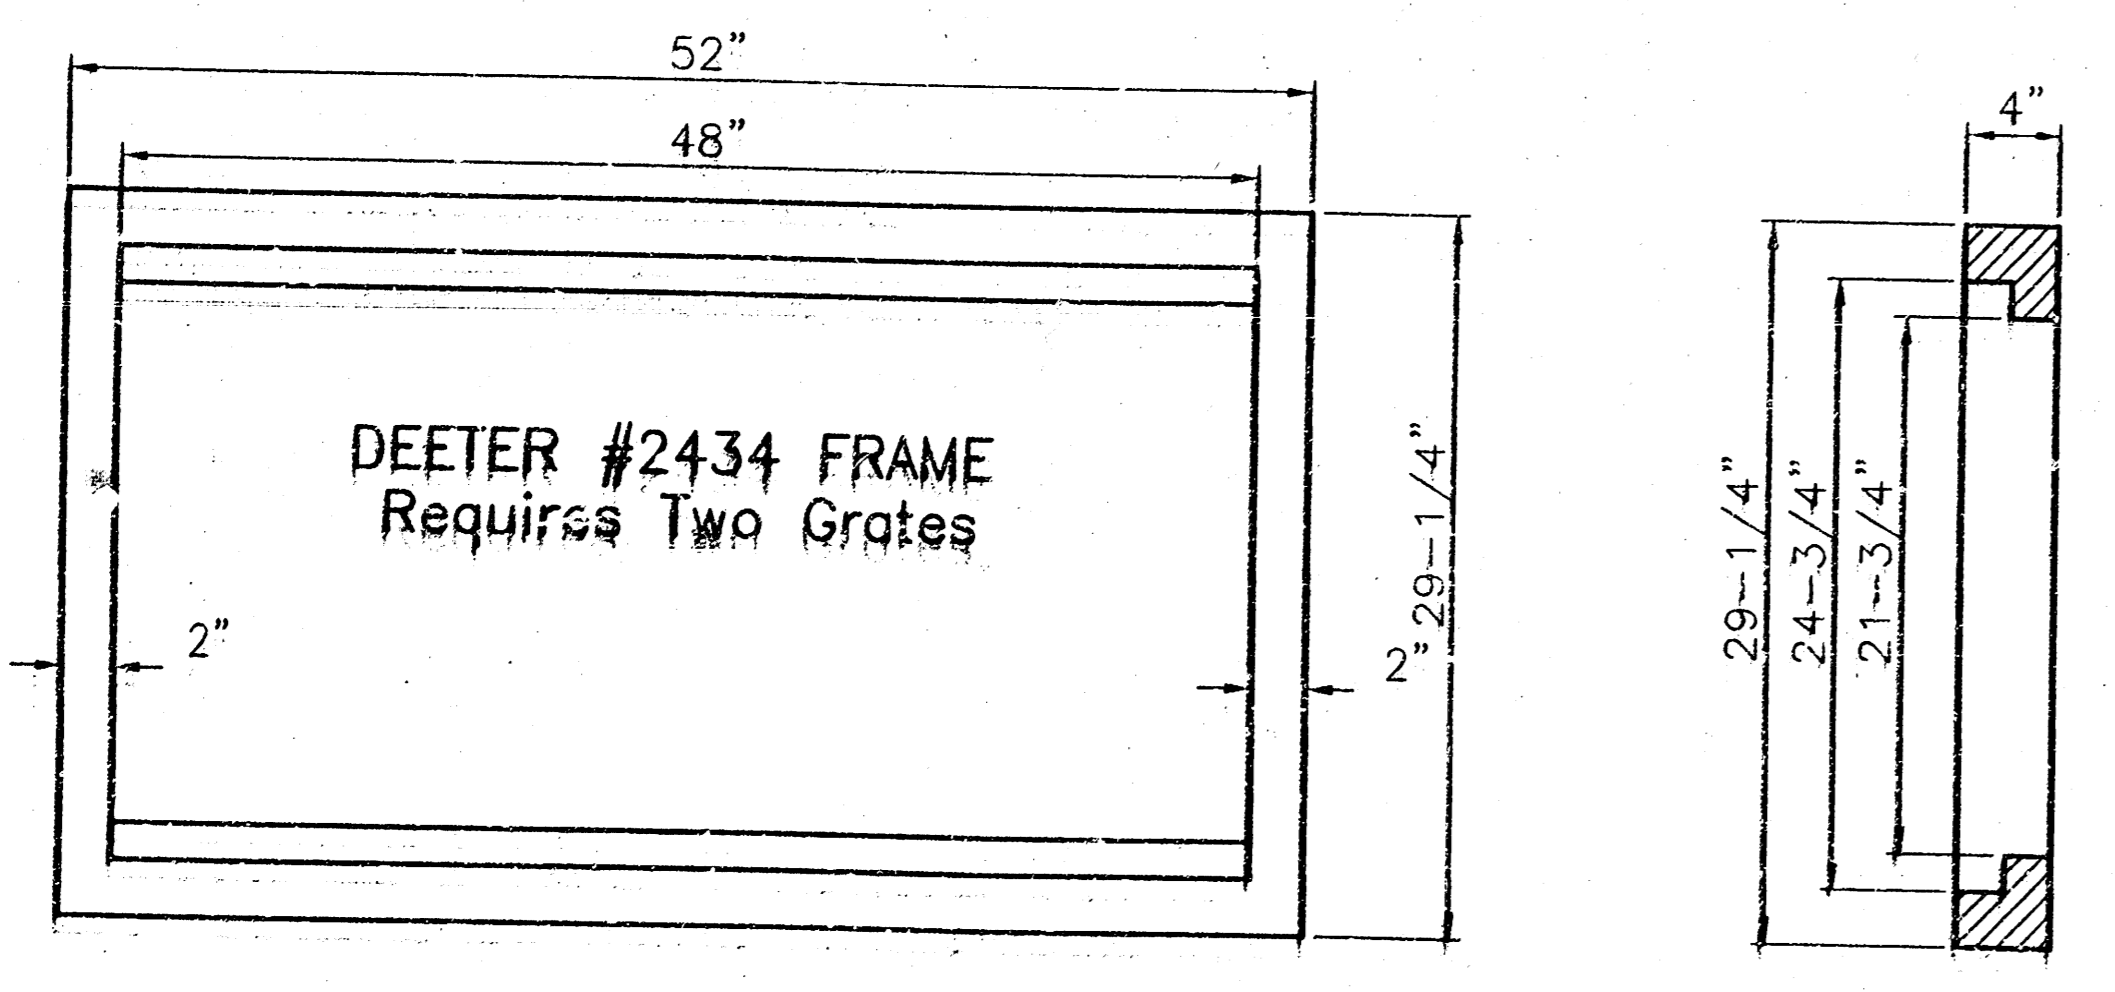


Double 24" x 24" Frame Detail

NOTE: Grates shall be imprinted on the top surface with "CITY OF WICHITA" using letters at least 1" in height. Other marking methods may be approved by the engineer.

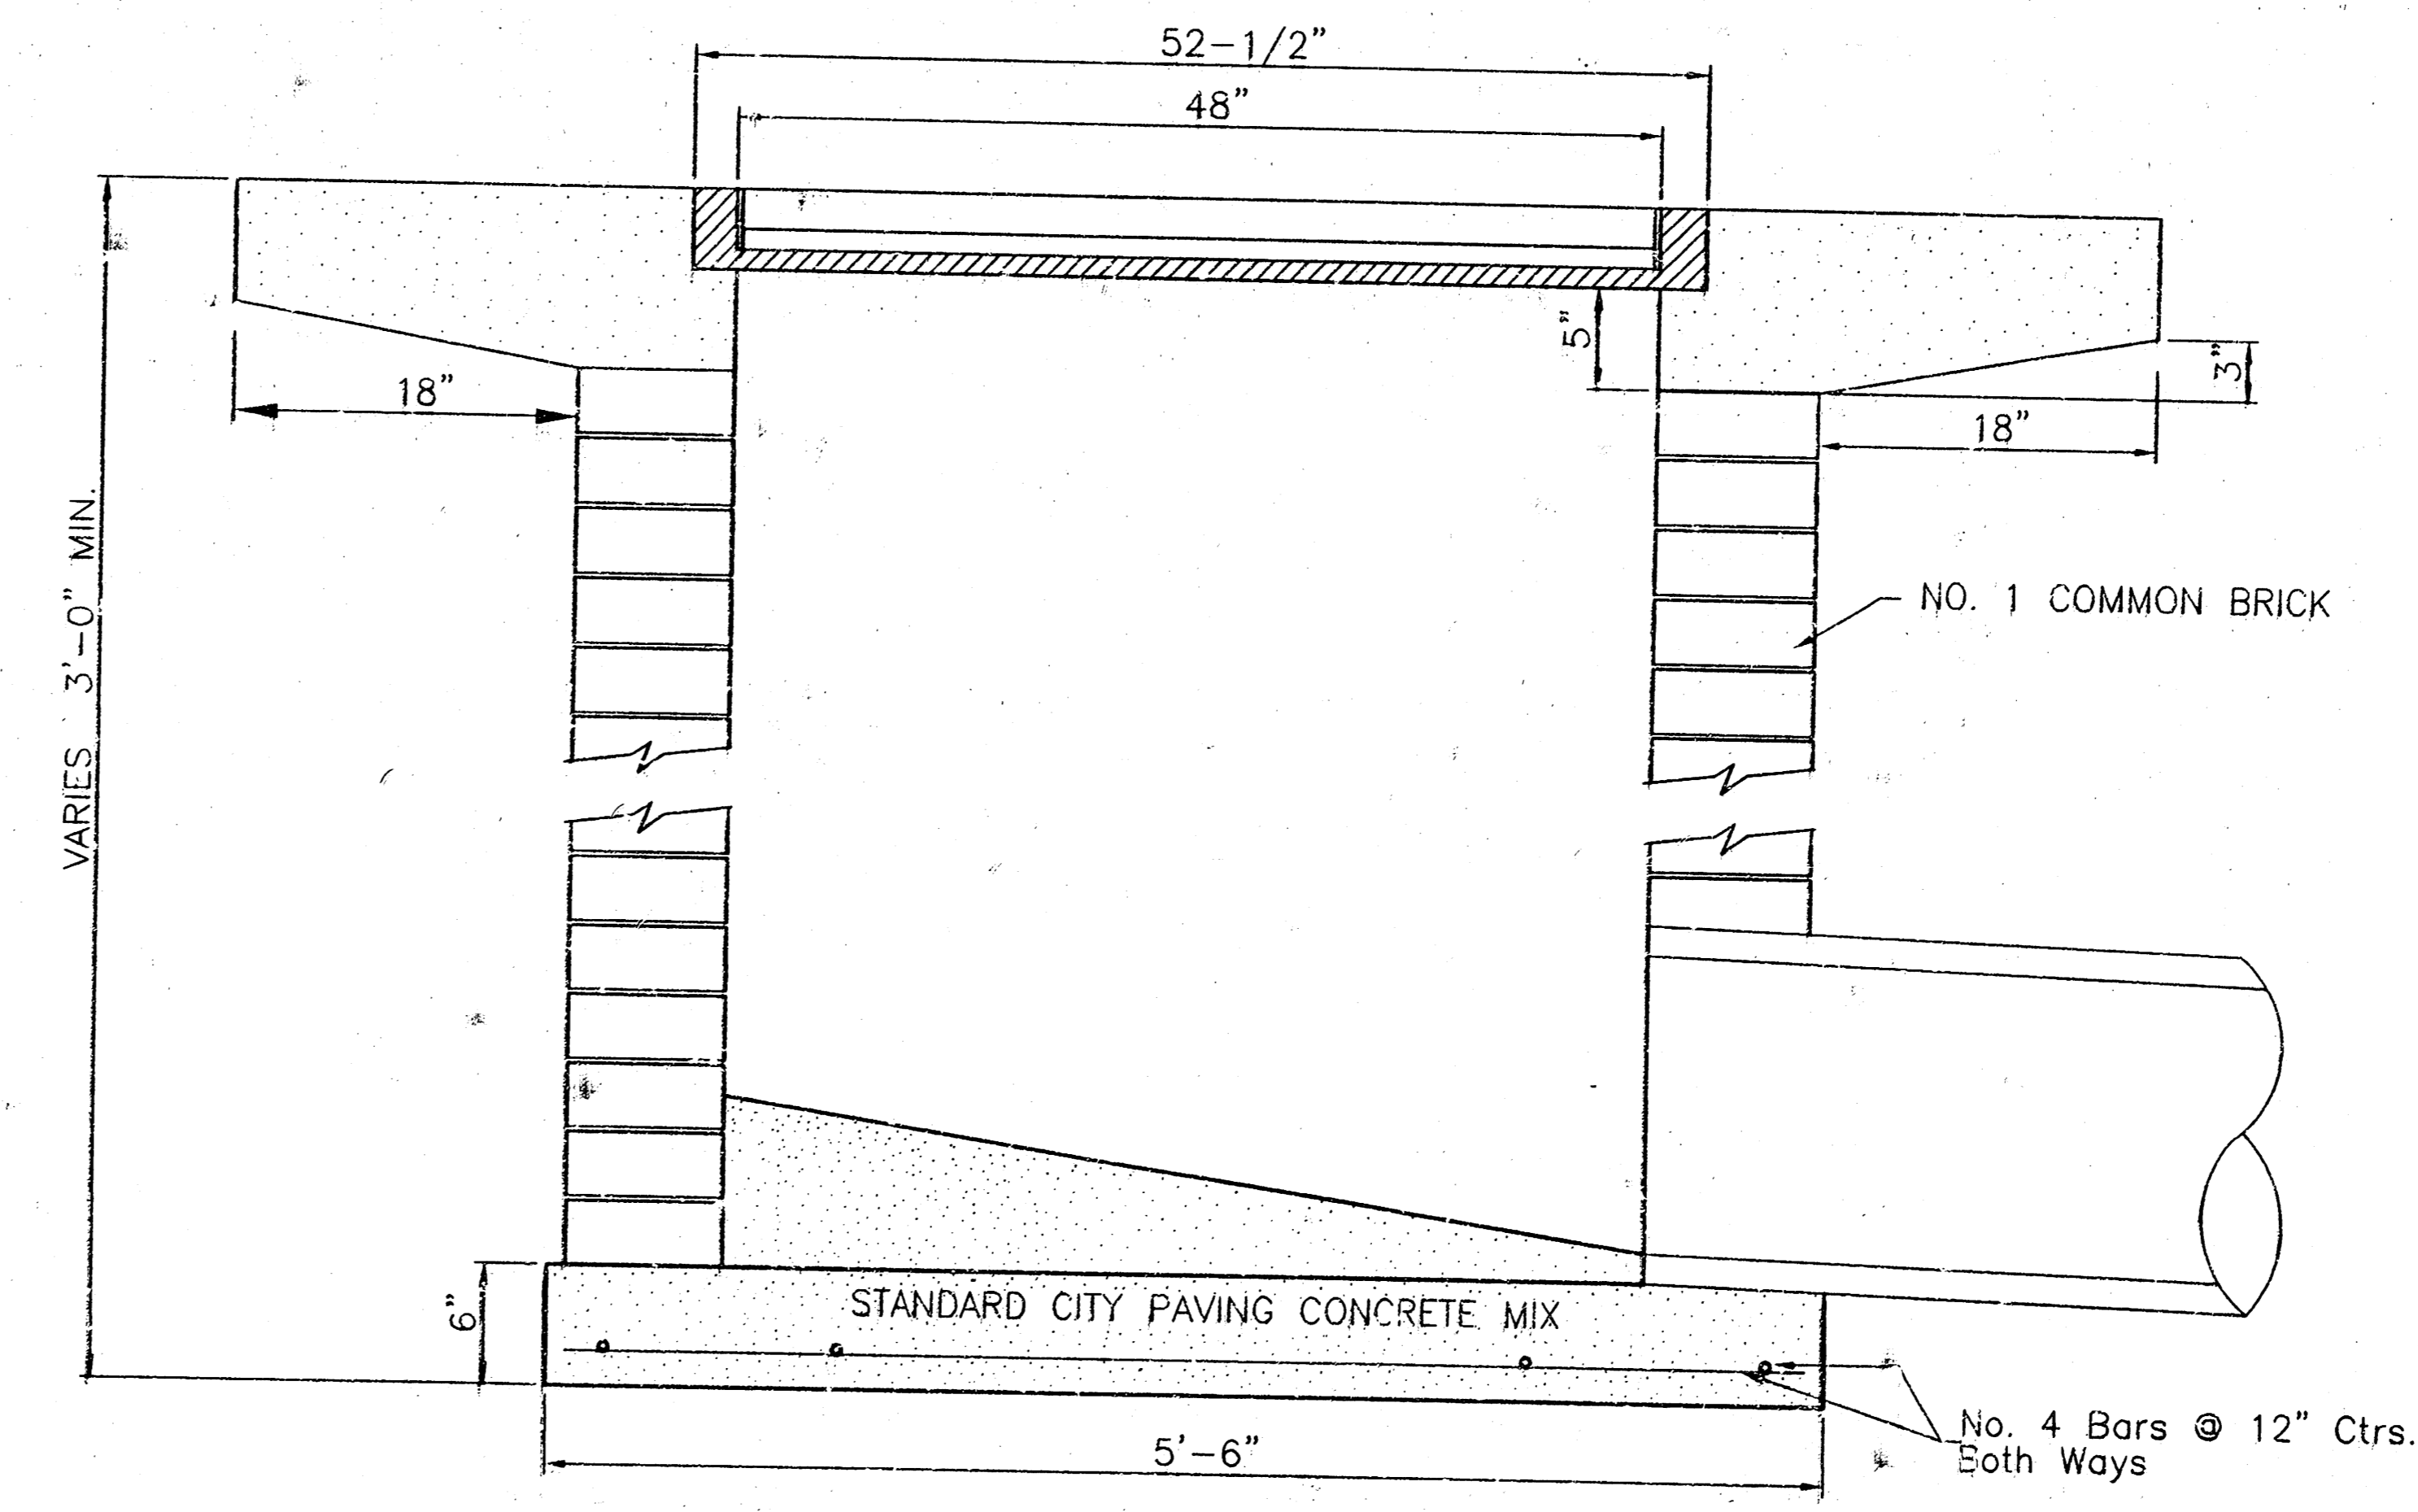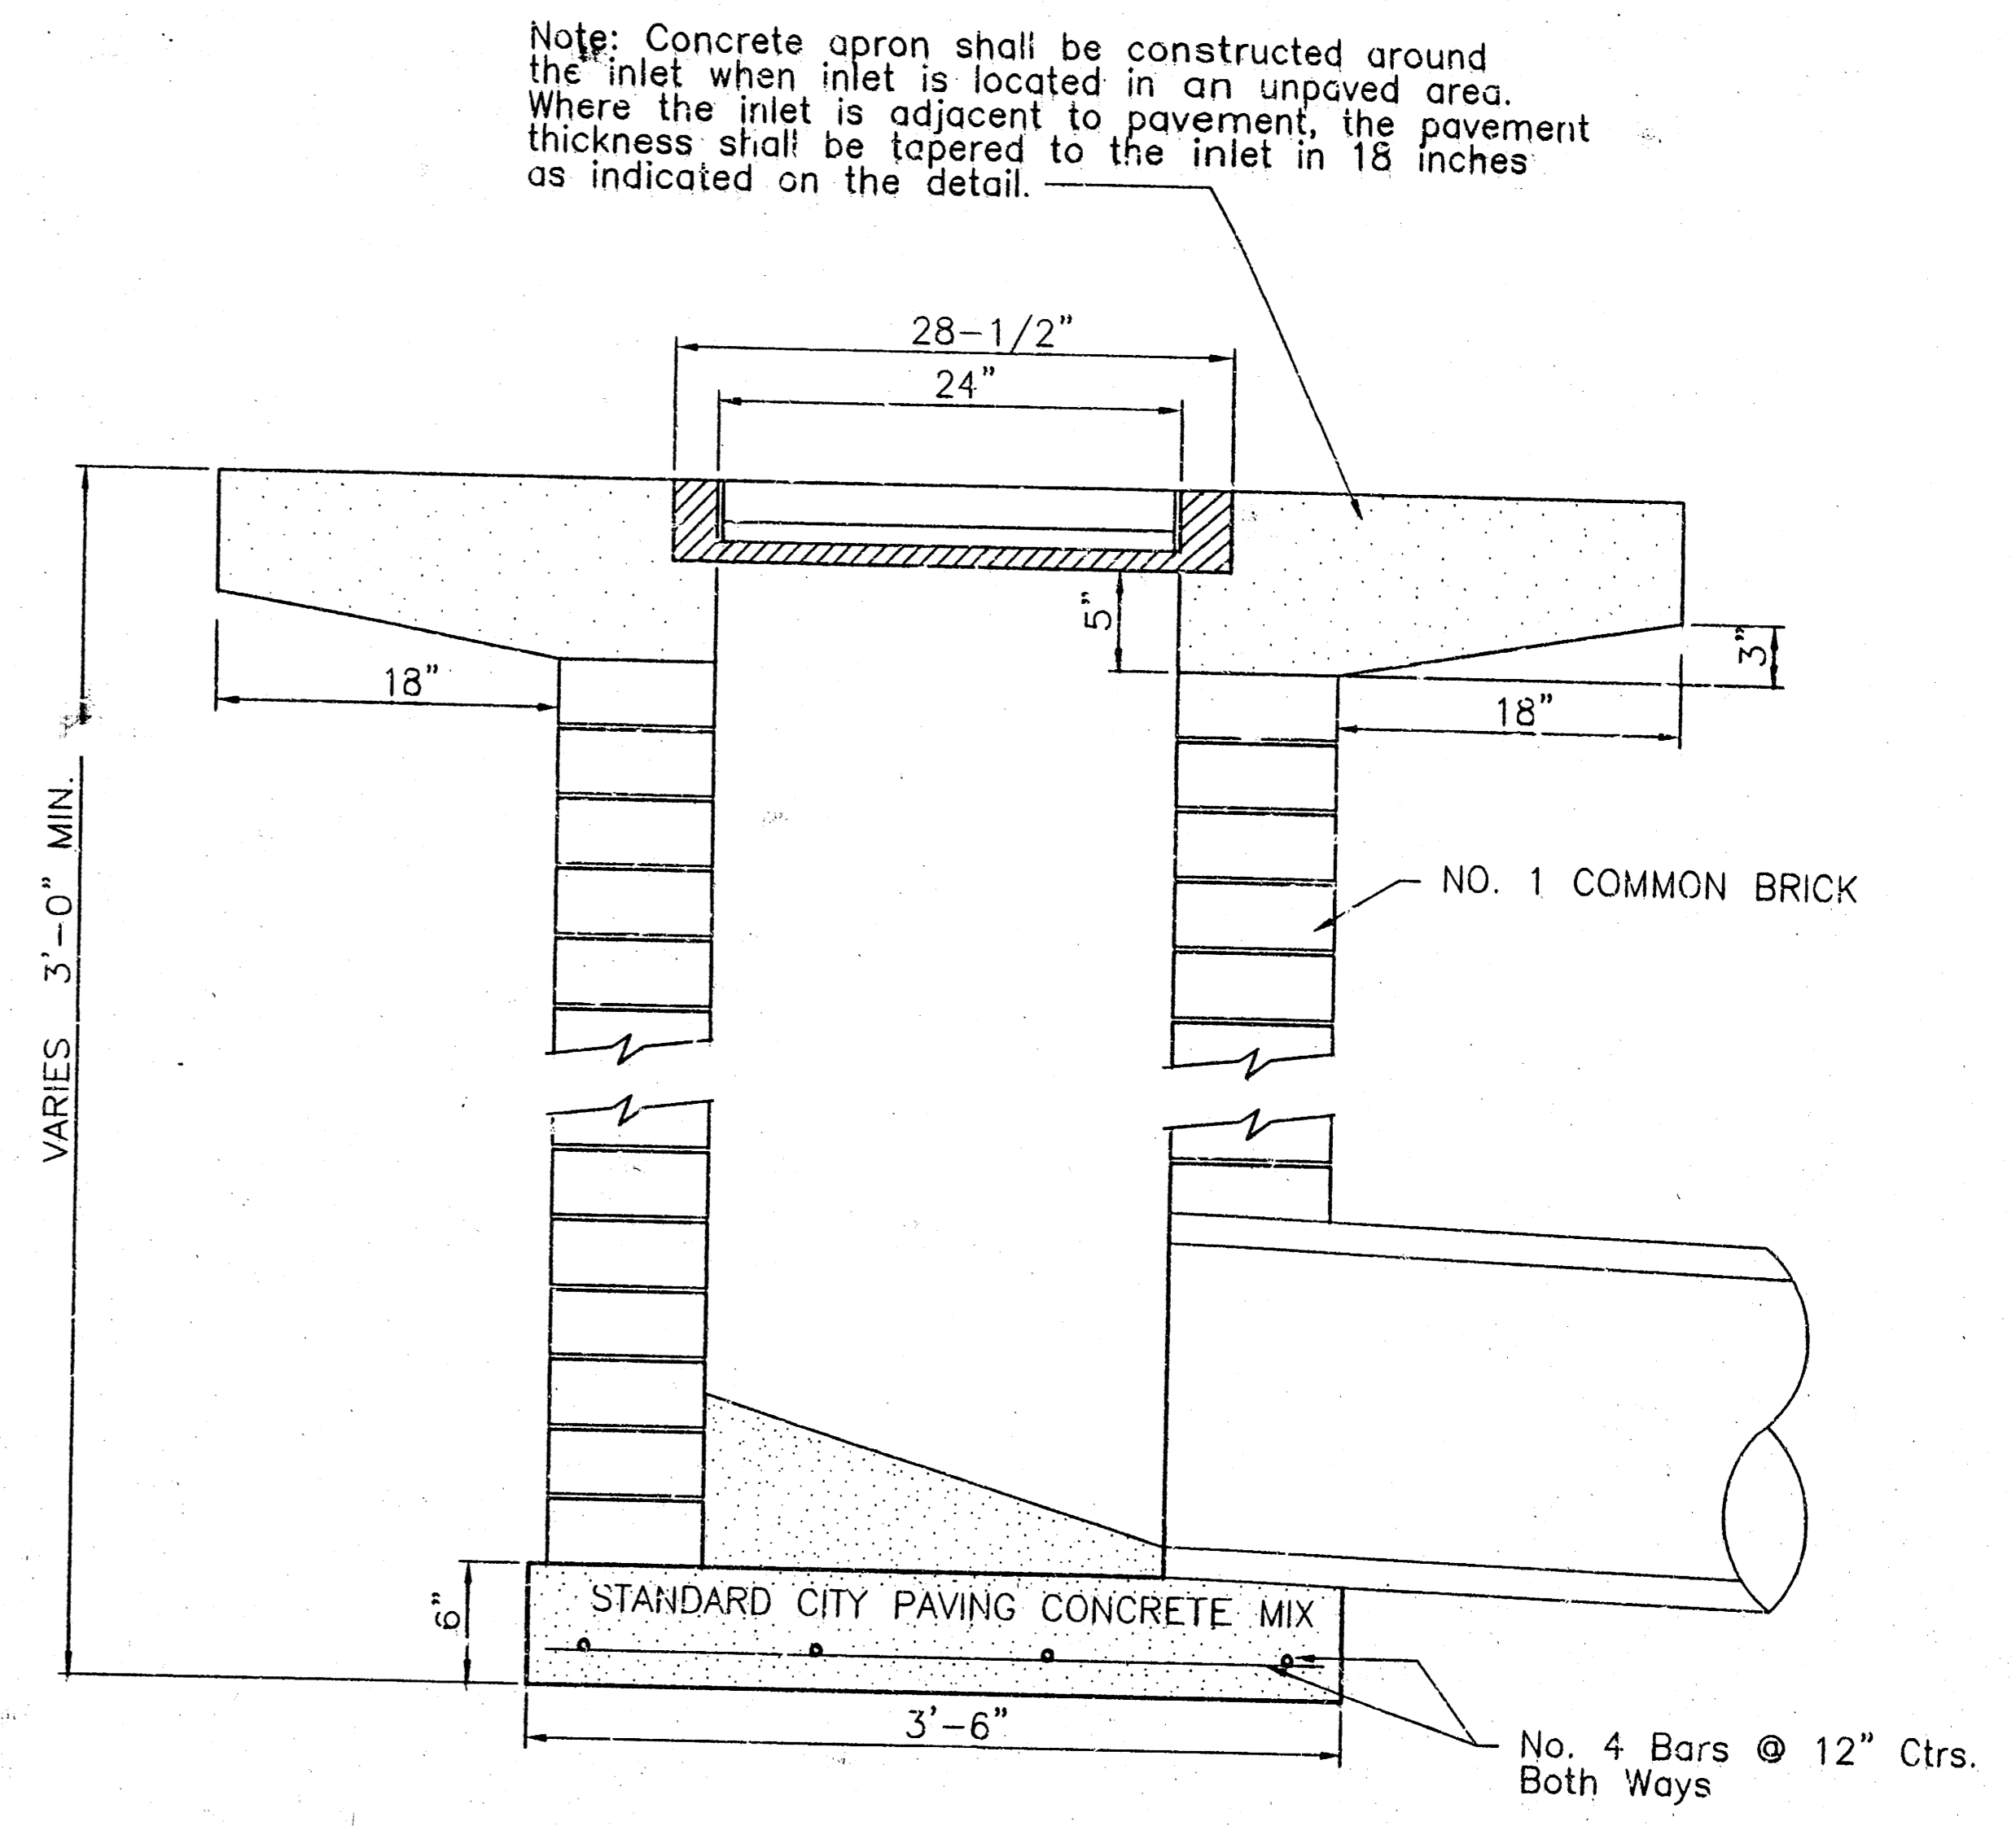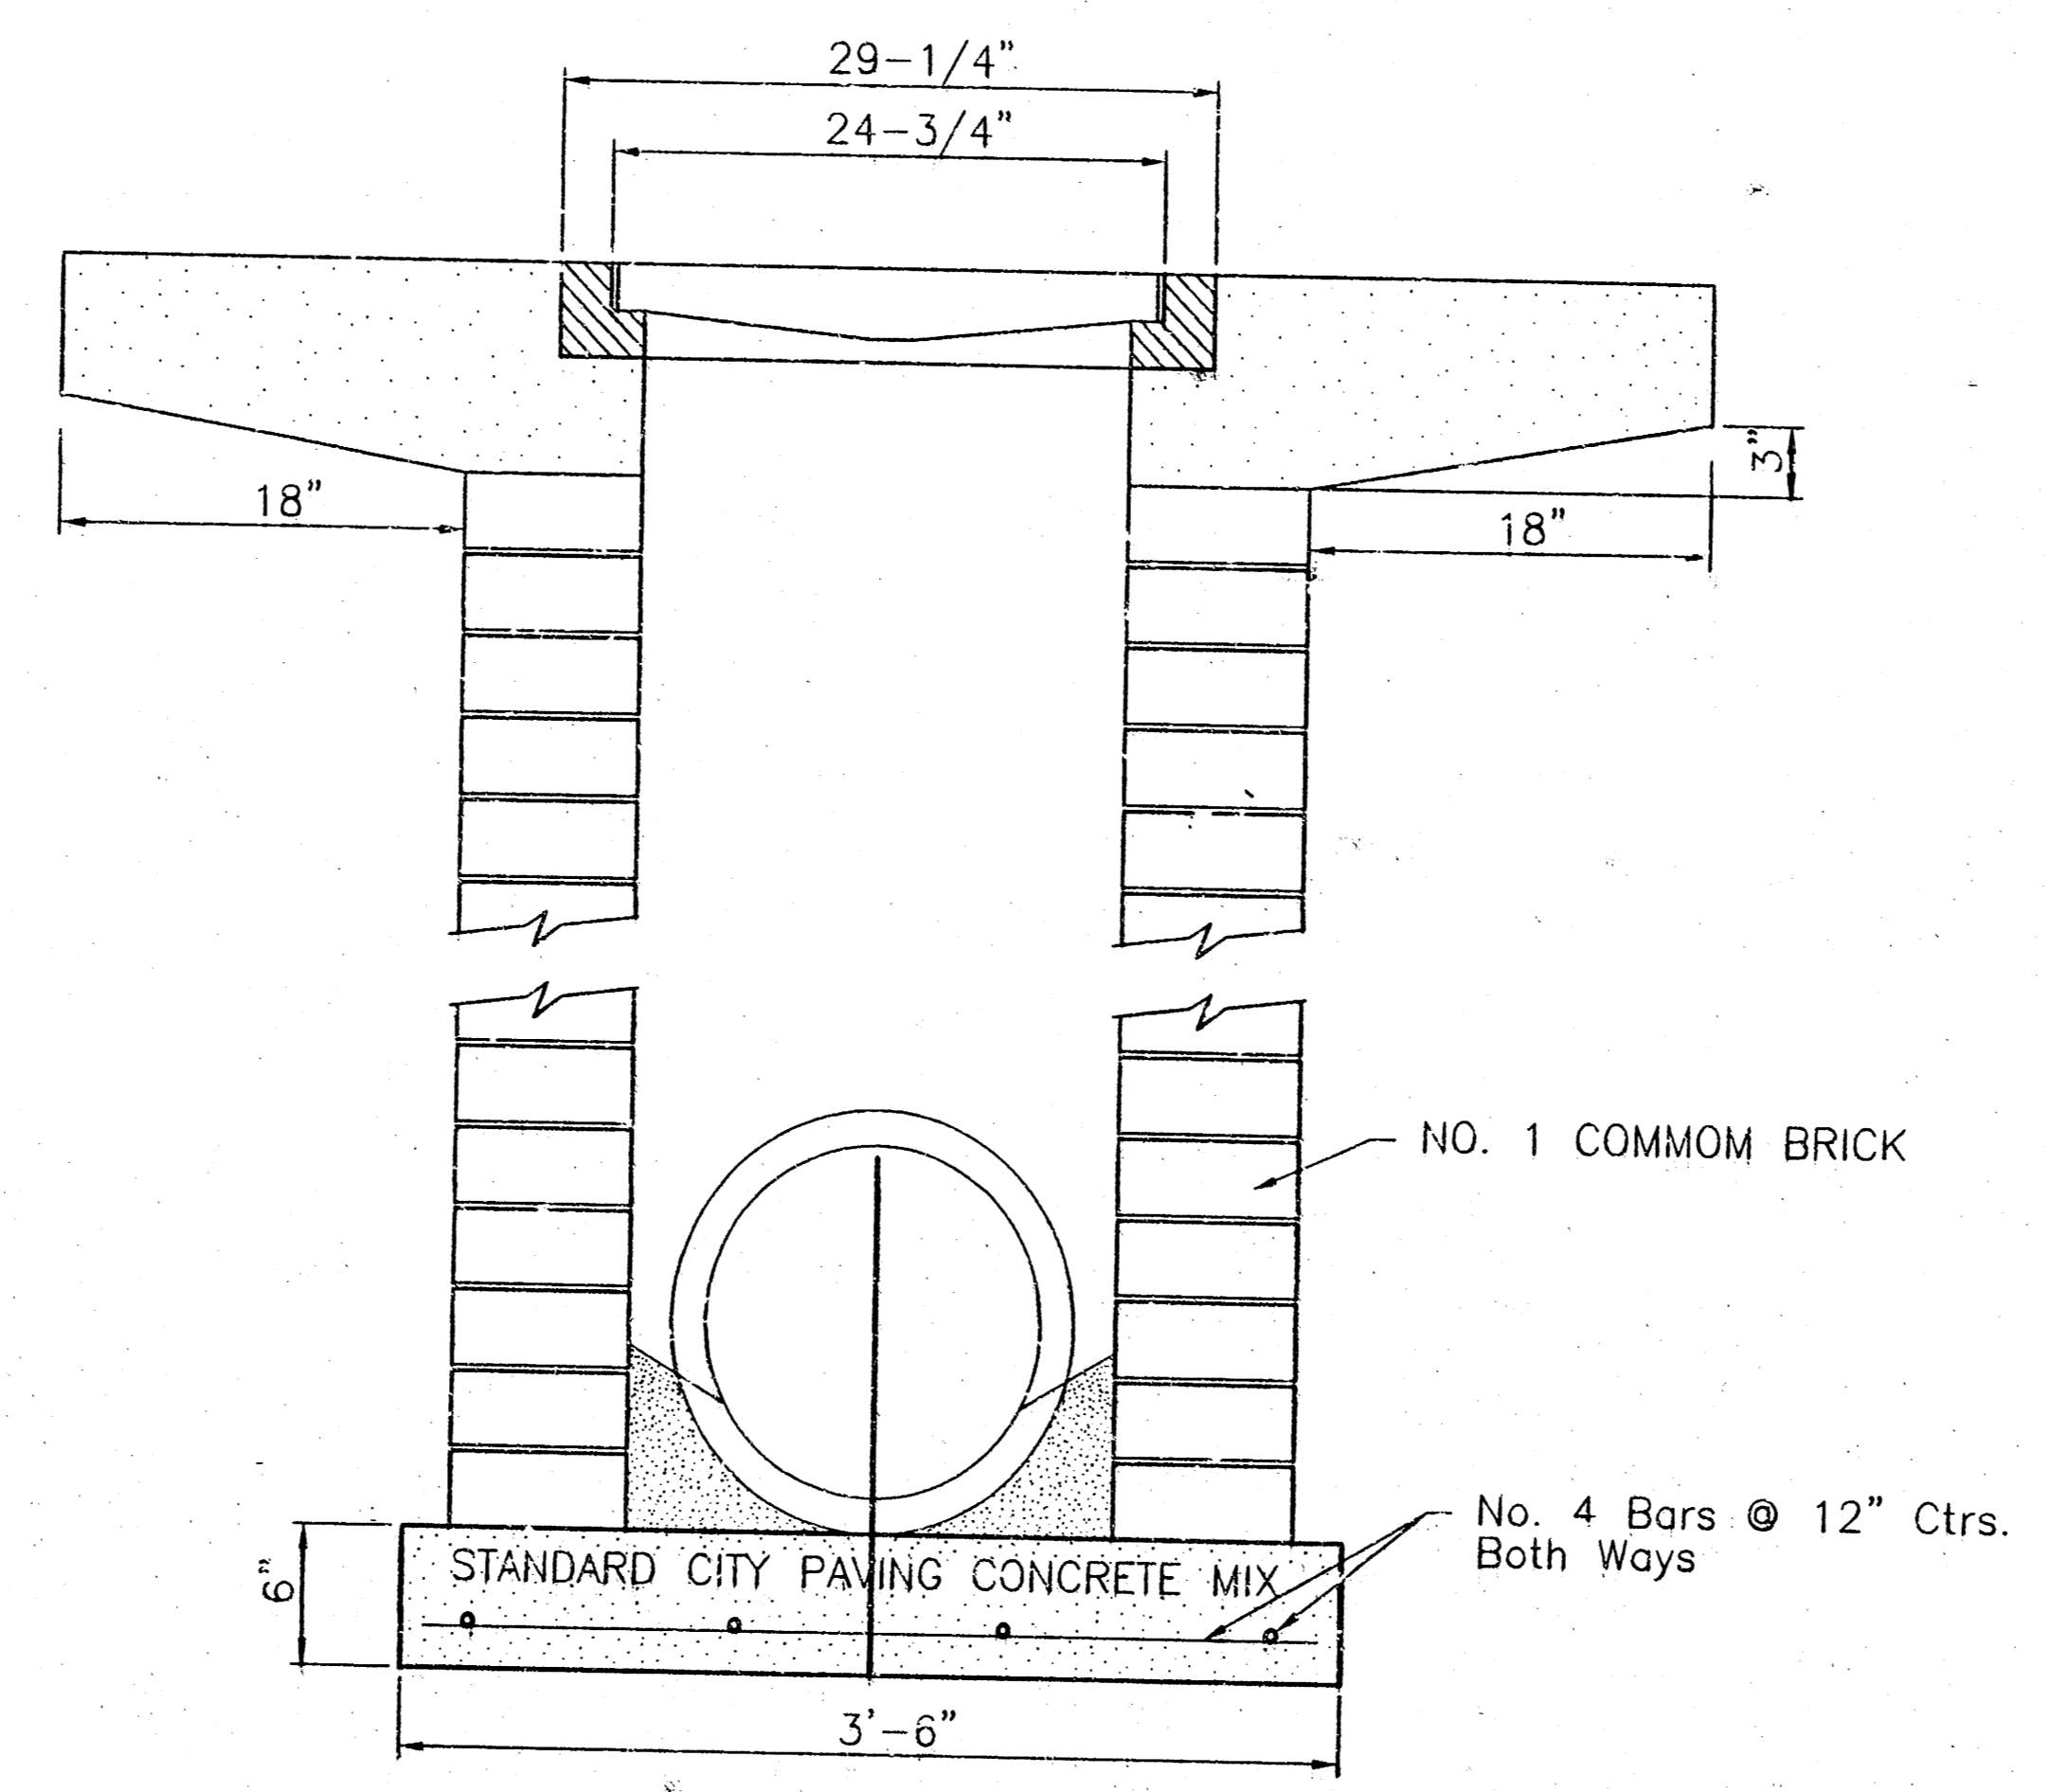


<p>THE CITY OF WICHITA</p> <p>CITY ENGINEER'S OFFICE CITY HALL - SEVENTH FLOOR 452 NORTH LAMAR STREET WICHITA, KANSAS 67202 (316) 266-4400 (316) 266-8118 FAX</p>	<p><b>DROP INLET</b> 2' X 2'<sup>1</sup>/<sub>2</sub>' X 4'</p>		
	<p>M. E. LINDEBAK P.E. - CITY ENGINEER</p>		
	<p>PROJECT NUMBER 834PPS</p>	<p>INDEX CODE 607861</p>	
	<p>DATE MAR 96</p>	<p>SHEET 11 OF 12</p>	


11/15/95/03/08/00/013.dwg Thu Sep 03 11:36:14 1996 SWK

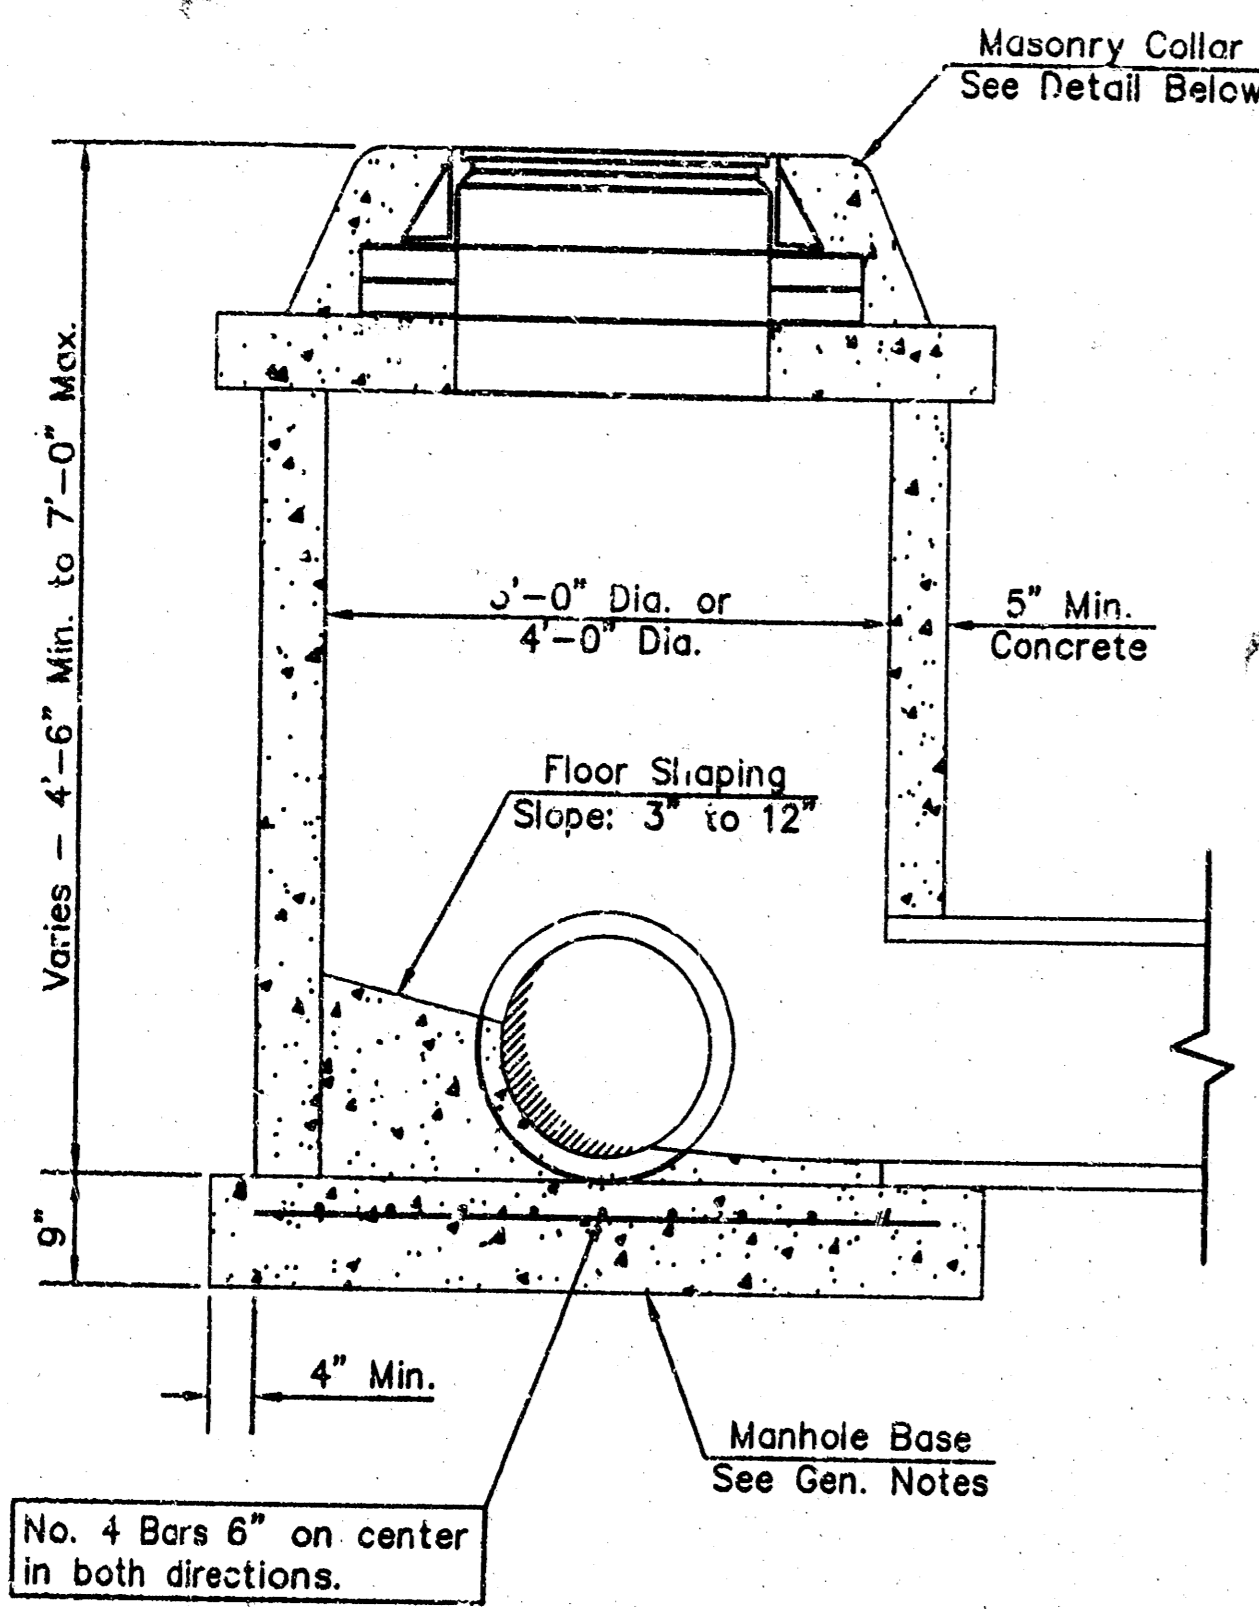


SHALLOW TYPE "P" MANHOLE

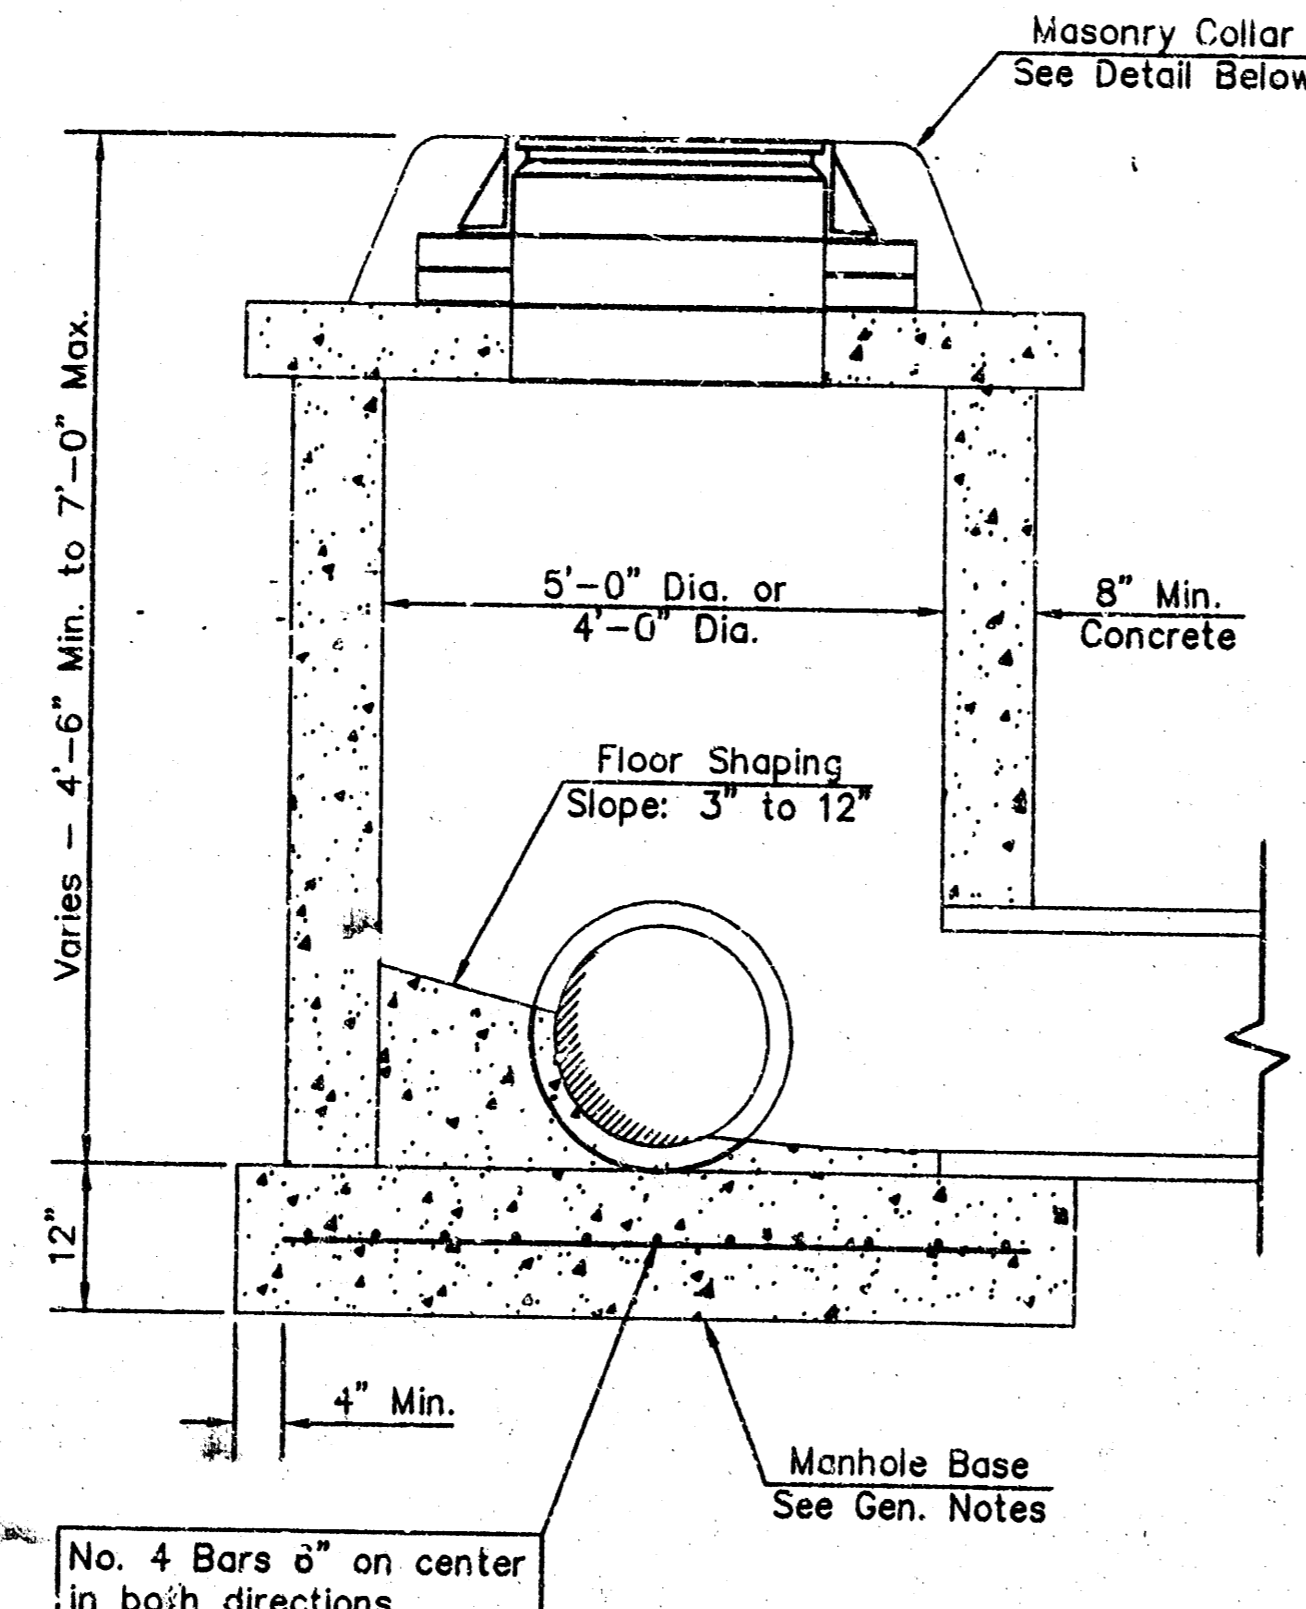


SHALLOW TYPE "C" MANHOLE

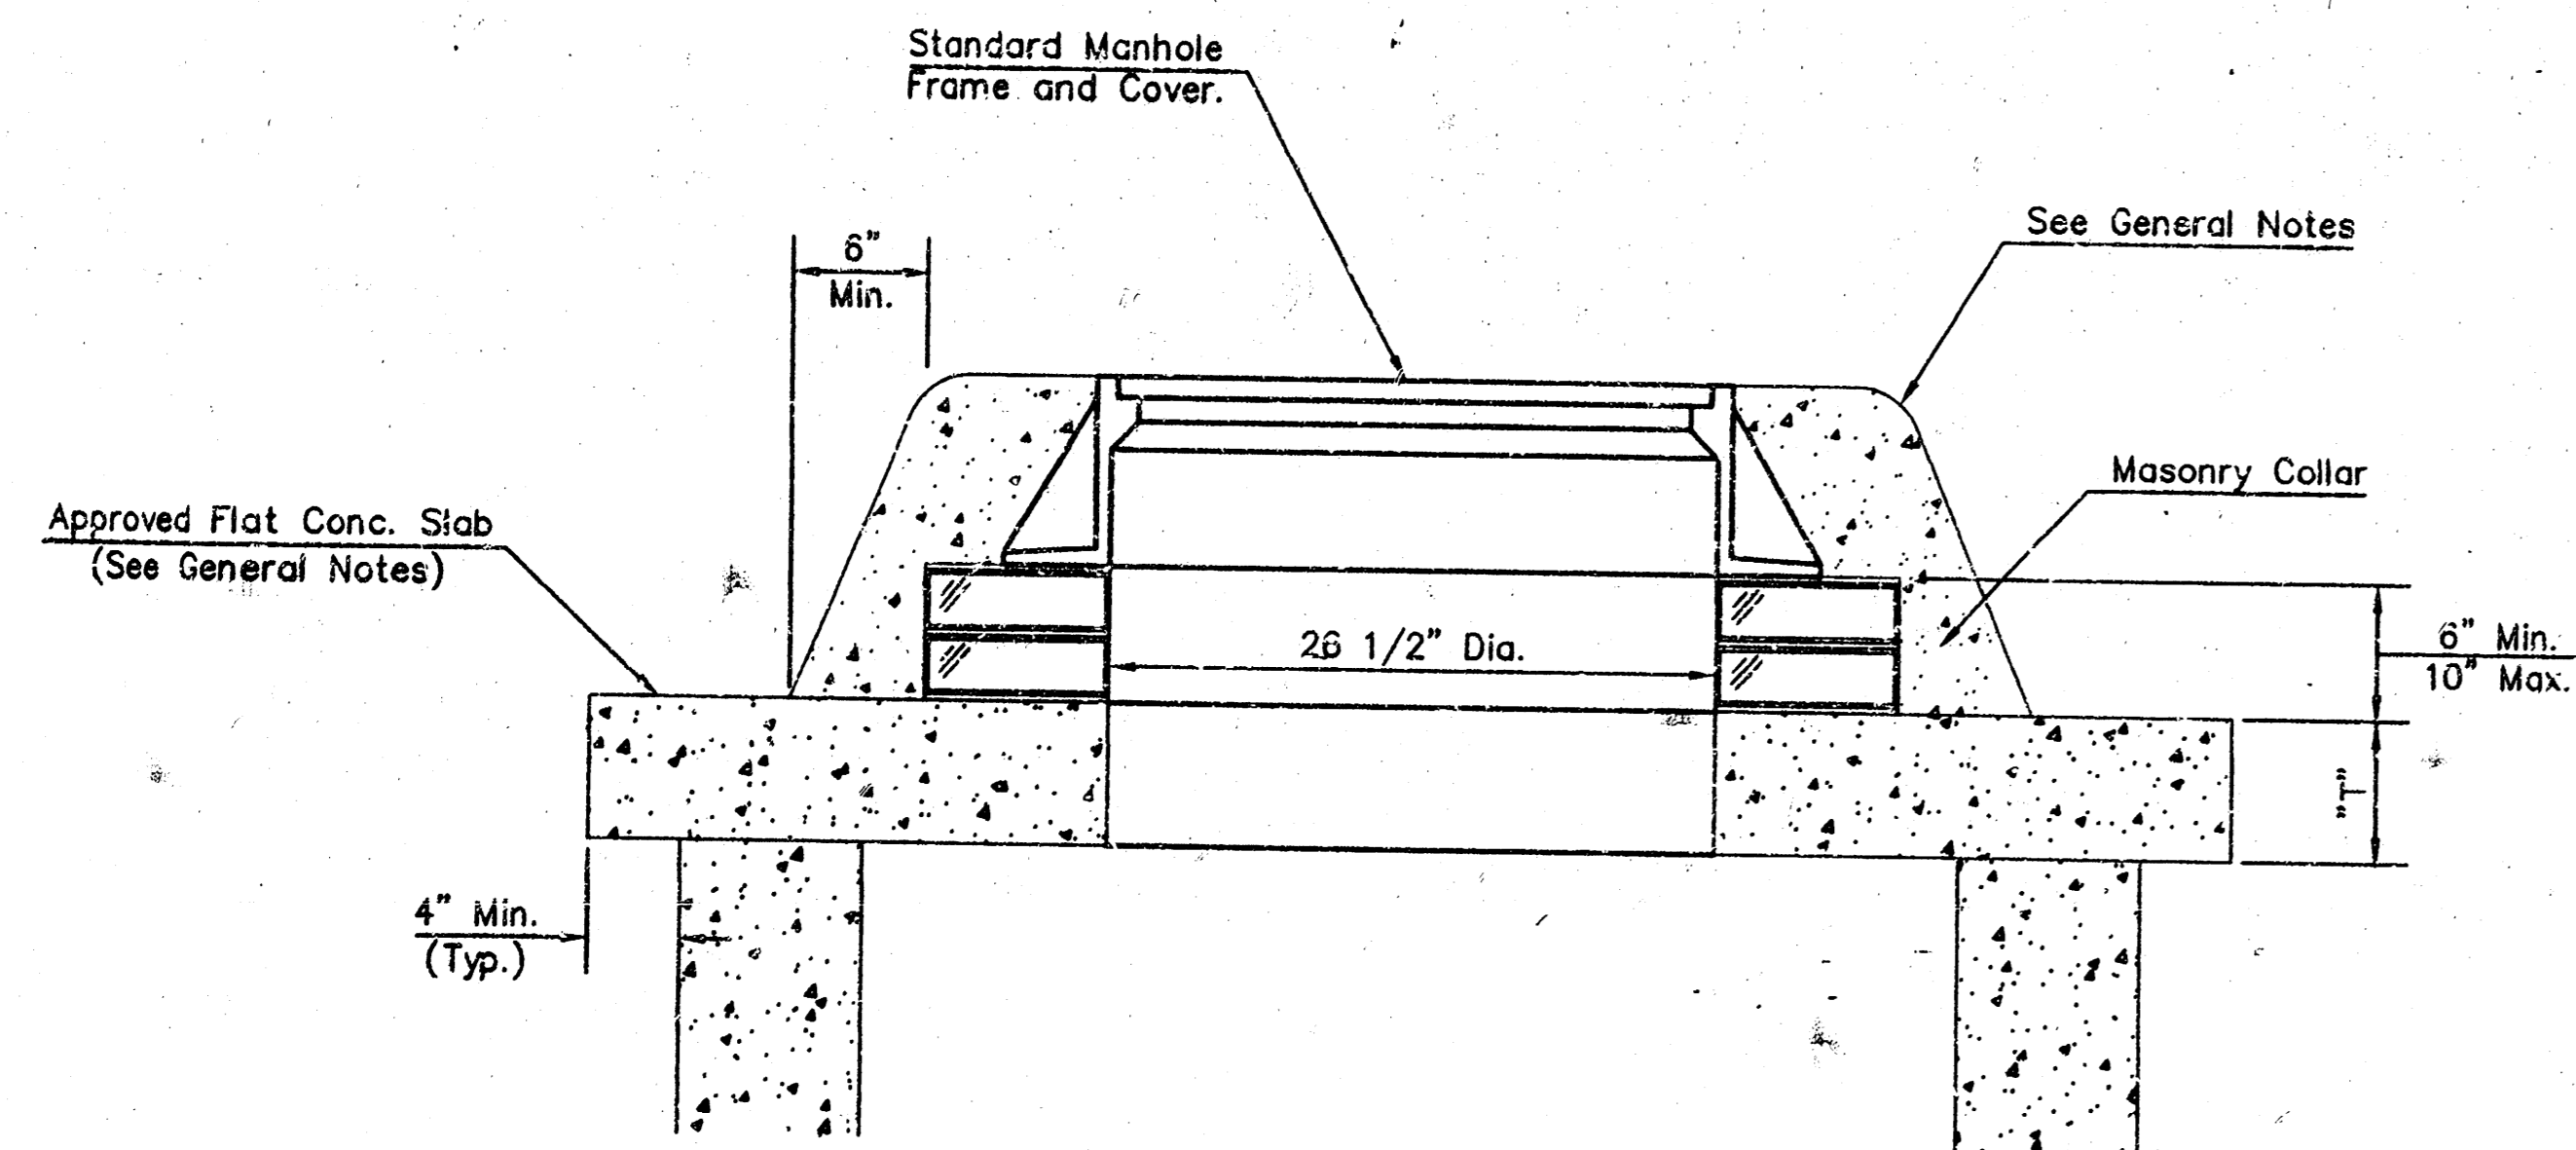

MASONRY COLLAR DETAIL

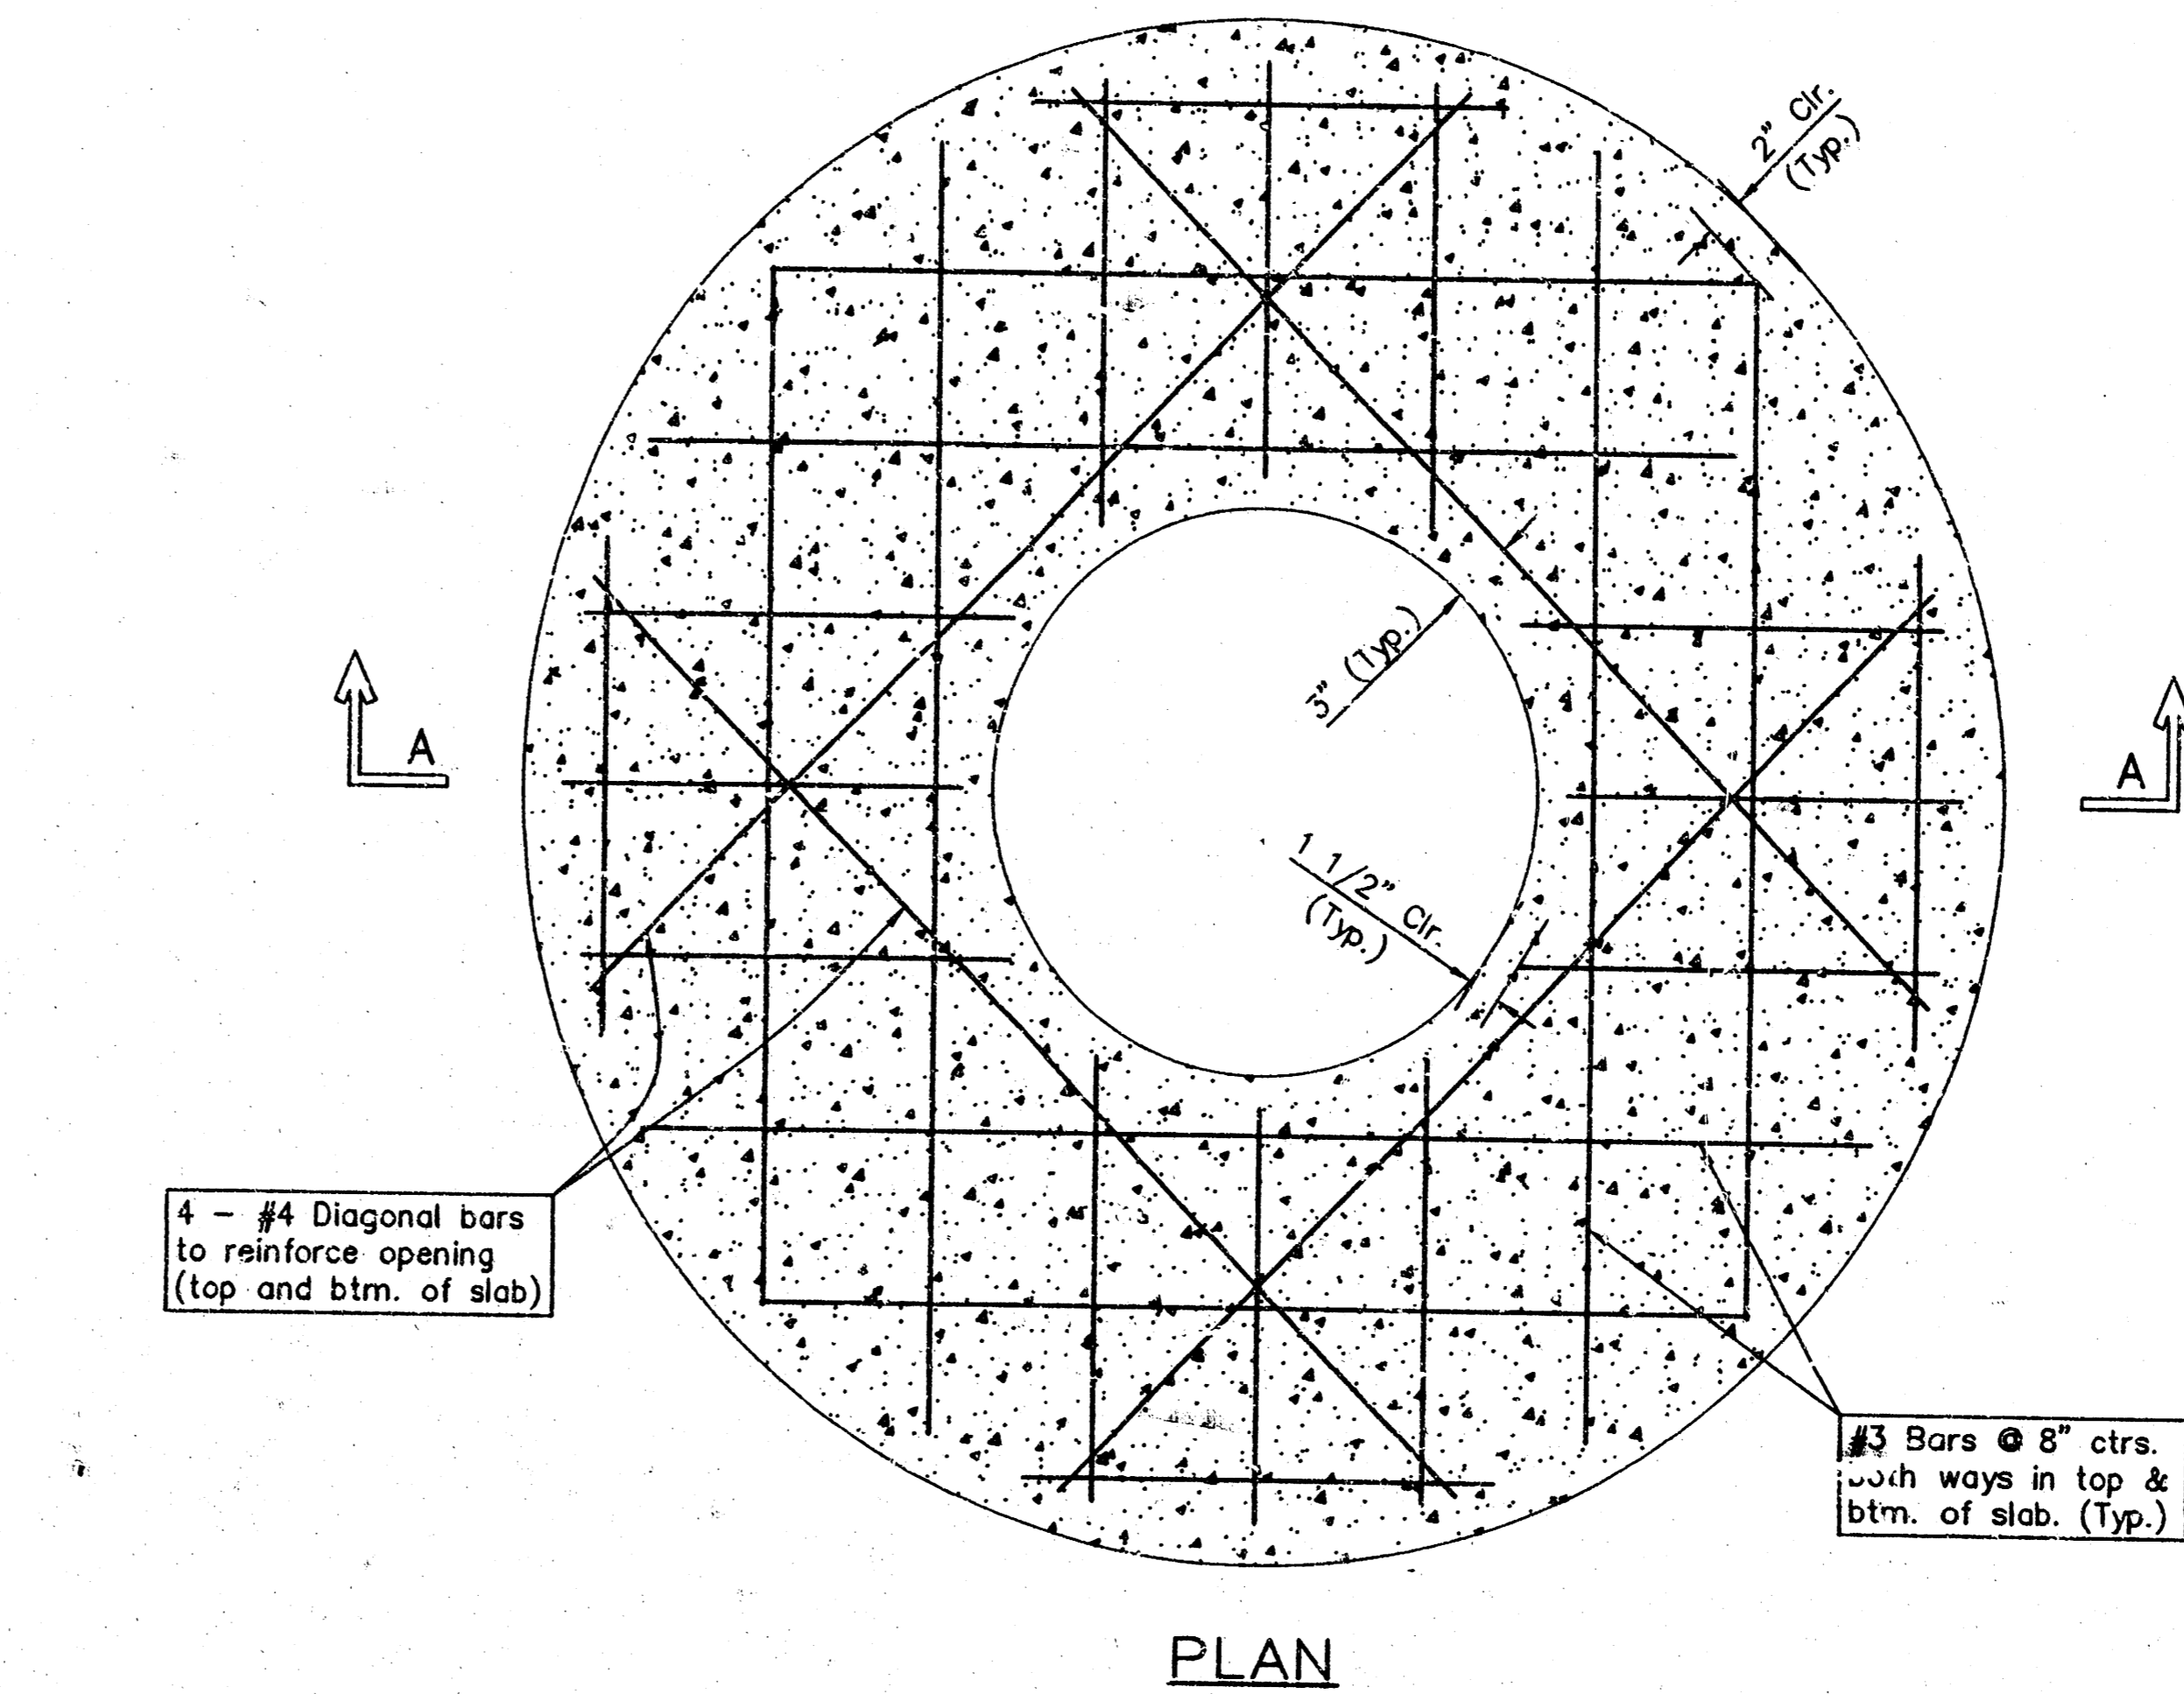

PLAN

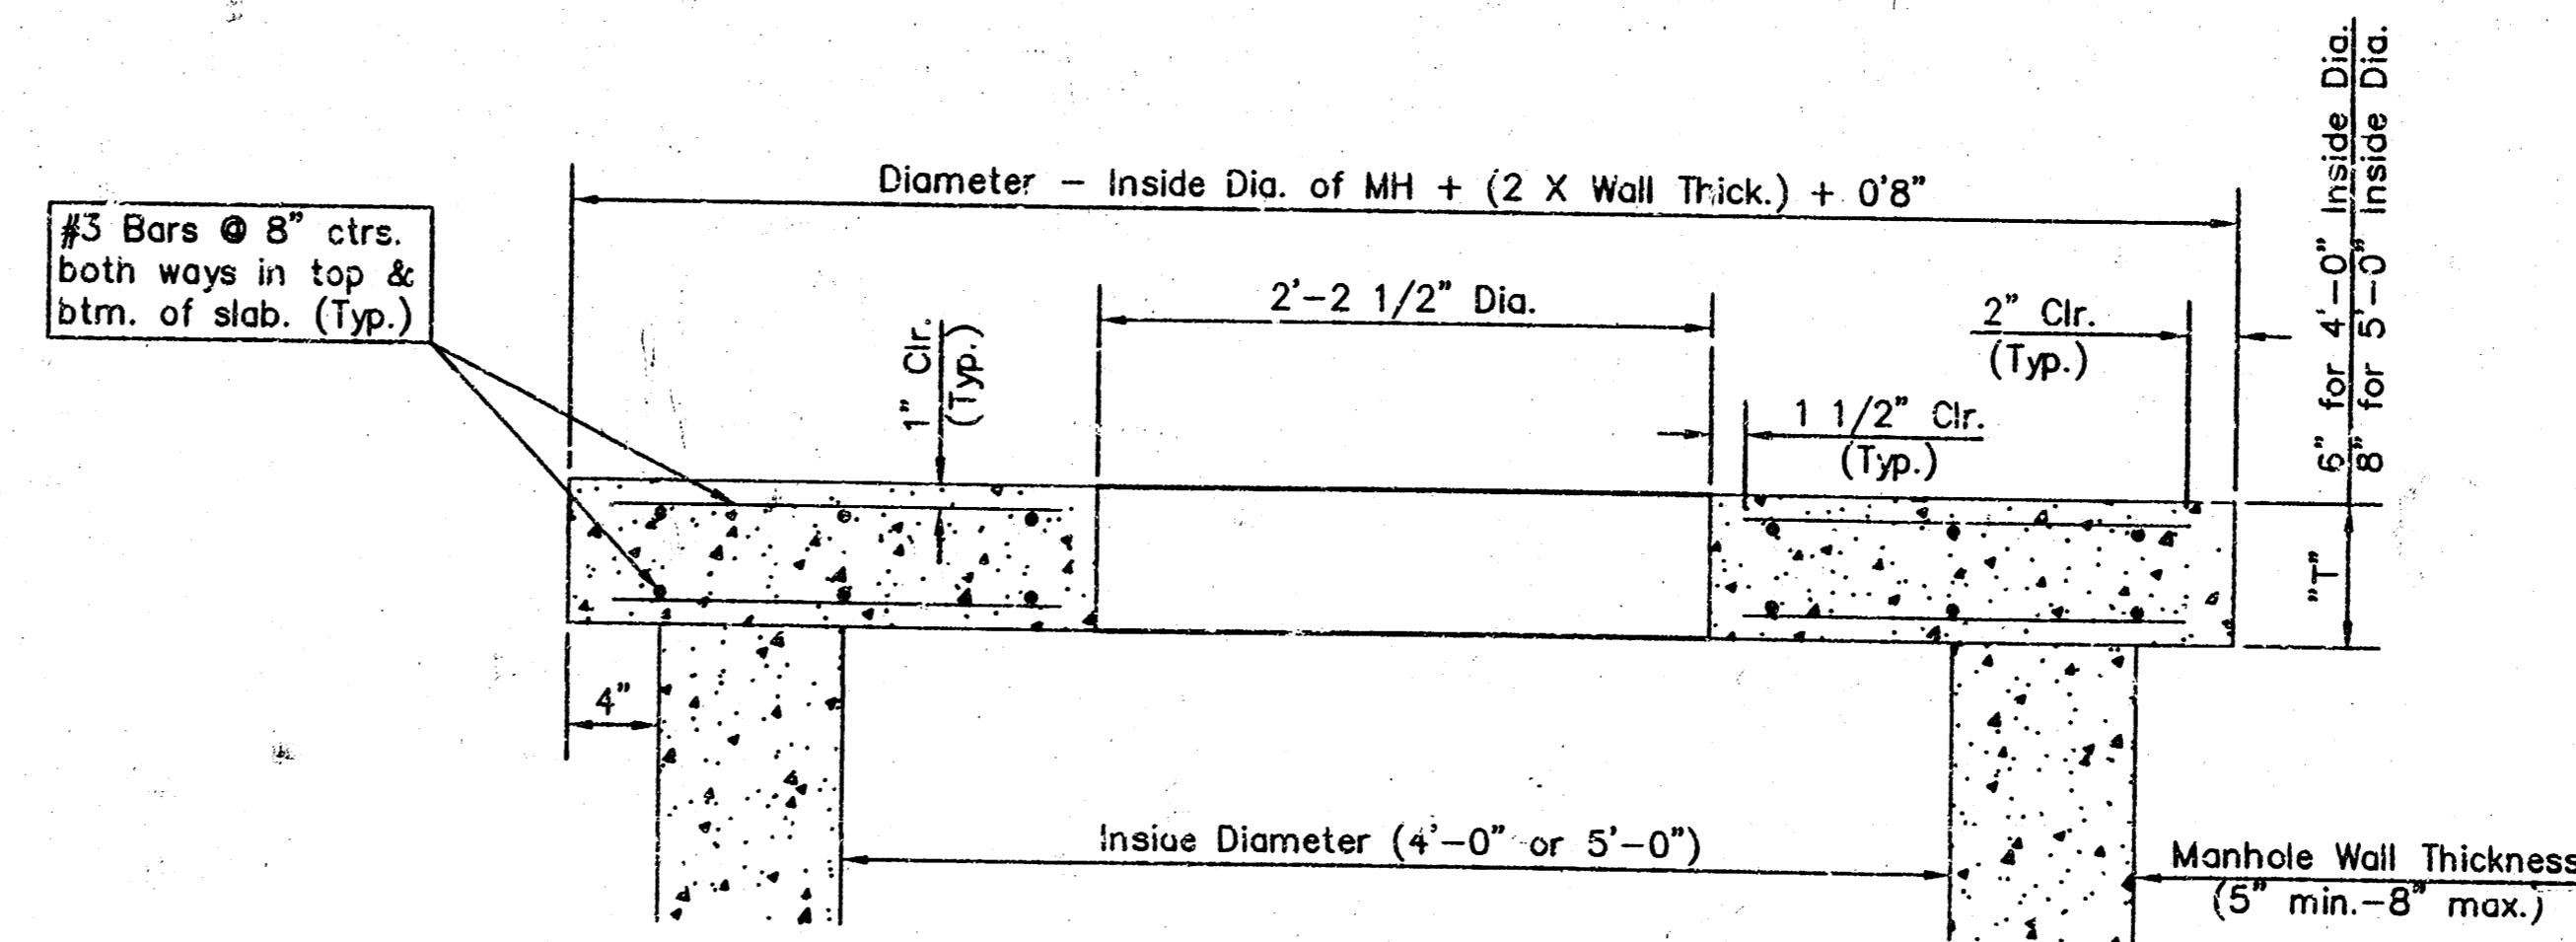

SECTION A-A  
FLAT CONCRETE SLAB DETAILS

GENERAL NOTES

- Mortar used in masonry construction shall contain 8 sacks of cement per cubic yard. Concrete used in manhole bases shall conform to the requirements of concrete for concrete pavement construction as specified in the city standard paving specifications using city concrete cement mix without air entraining admixture. Mortar shall be placed around the manhole ring as shown in the drawings when manholes are constructed in unpaved areas. Manholes constructed where pipe sizes are smaller than 24" shall have an inside diameter of 4". Manholes constructed where pipe sizes are 24" or larger shall have an inside diameter of 5". Completed manholes shall be without leaks and water tight.
- Reinforcing steel shall be installed in the manhole bases and shall consist of no. 4 bars placed on 6" centers in both directions. The manhole base reinforcement shall be placed 8" above the bottom of the manhole base. All costs for furnishing and installing reinforcing steel shall be included in the unit price bid for the manhole.
- The floors of all manholes shall be shaped with flow channels such that the manholes will be self cleaning and free of areas where solids could be deposited as sewage flows through the manhole from all inlet pipes to the outlet pipe. Flow channels shall be formed to match the bottom halves of the drawings. Manhole floors shall have slopes of 3 inches per foot in the areas outside of the flow channels sloped toward the flow channels. Pipes laid through manholes shall have the top half removed to neat lines for the full inside diameter of the manhole. Manhole floors shall then be shaped around the bottom half of the pipes which forms the flow channel.
- Pipes installed within the excavation made for the manhole shall be cradled with concrete to the limits of the manhole excavation. When clay pipe is used, the cradle shall extend to the first joint outside the manhole. The cradle shall be terminated at the clay pipe joint in a manner which will maintain the flexibility of the joint. Cost of cradle within manhole excavation or to clay pipe joints adjacent to manhole shall be included in the unit price bid for the manhole.
- Manhole cover castings and manhole frame castings shall conform to the requirements as indicated in the standard specifications and as shown in the standard detail drawings.
- The crowns of inflowing pipes shall never be set lower than the crown of the outflowing pipe.
- Standard shallow manholes type "P" and "C" shall be paid for at the unit price bid per each for the type and diameter indicated. All standard shallow manhole diameters will be 4' unless indicated otherwise.
- All brick used in manhole construction shall meet Grade SW of ASTM C652 or C62-87.

<p>THE CITY OF WICHITA</p> <p>CITY ENGINEER'S OFFICE CITY HALL - SEVENTH FLOOR 455 NORTH MAIN STREET WICHITA, KANSAS 67202 (316) 268-4800 (316) 268-2114 FAX</p>	SHALLOW MANHOLES	
	TYPE 'P' & 'C'	
	M. E. LINDEBAK P.E. - CITY ENGINEER	
	PROJECT NUMBER 834PPS	INDEX CODE 607881
DATE MAR 95	SHEET 12 OF 12	

C:\P\ORR\834PPS\834PPS.DWG Thu Sep 03 11:30:34 1998 SAK