

SANITARY SEWER IMPROVEMENTS TO SERVE 2121 S. Meridian Quiet Thunder

Project Number
1025 PPS (607861)


CITY OF WICHITA, KANSAS
Michael E. Lindebak, P. E., City Engineer

GENERAL NOTES

- Contractor will be required to provide notice to utility companies a minimum of twenty-four (24) hours prior to any excavation, as follows:
Kansas One-Call 687-2470
The Contractor must notify the following in case of an emergency:

Cablevision	262-4270
or	263-2061
K.P.L. Gas Service Company	383-8850
Kansas Gas & Electric Company	383-8600
Peoples Natural Gas Gas	942-8311
or	1800-303-0357
Southwestern Bell Telephone Company	1-571-2611
City of Wichita Water Department	268-4908
City of Wichita Sewer Department	268-4071
Kansas Gas Service	832-3168
or	832-3167
- Exist. utilities and their locations, as shown on the plans, represent the best information obtainable for design. Location information has been obtained from the various utility companies and is either from company record drawings or company-provided field locations. The Contractor will be required to work around existing utilities which do not conflict with proposed construction.
- The Contractor to verify utility locations prior to construction of this project.
- Utility service and installation shall be coordinated with the respective utility owners. Contacts are:

Kansas Gas Service	Jim Stoltz	832-3122
K.G.E.	Russ Chitwood	261-6251
Wichita Water	Chuck Steven	268-4555
	Joe Botinelly	268-4908
Southwestern Bell	Jim Tahn	268-2759
- All areas disturbed by construction shall be seeded with rye Rebel II Fescure grass at a rate of 350 lbs./acre immediately following construction in that area.
- Traffic affected by the construction of this project shall be handled in accordance with the latest edition of the Manual on Uniform Traffic Control Devices.
- All lawn/turf areas disturbed by construction of proposed improvements shall be restored with the same grass/ sod as existing. Restoration of disturbed areas shall include, but not be limited to, top soil preparation, seeding, mulch and/or reseeding. All seeding/sodding work shall be in accordance with the City of Wichita standard specifications and the City of Wichita administrative regulation No. AR78 which governs cleanup and replacement following construction. All costs for this work shall be subsidiary to the lump sum price bid for "Site Restoration."
- Benefit District Consists of Lot 11 Block 1 Southwest Industrial Addition North 149.50' of the East 250' of Lot 10 Block 1 Southwest Industrial Addition.

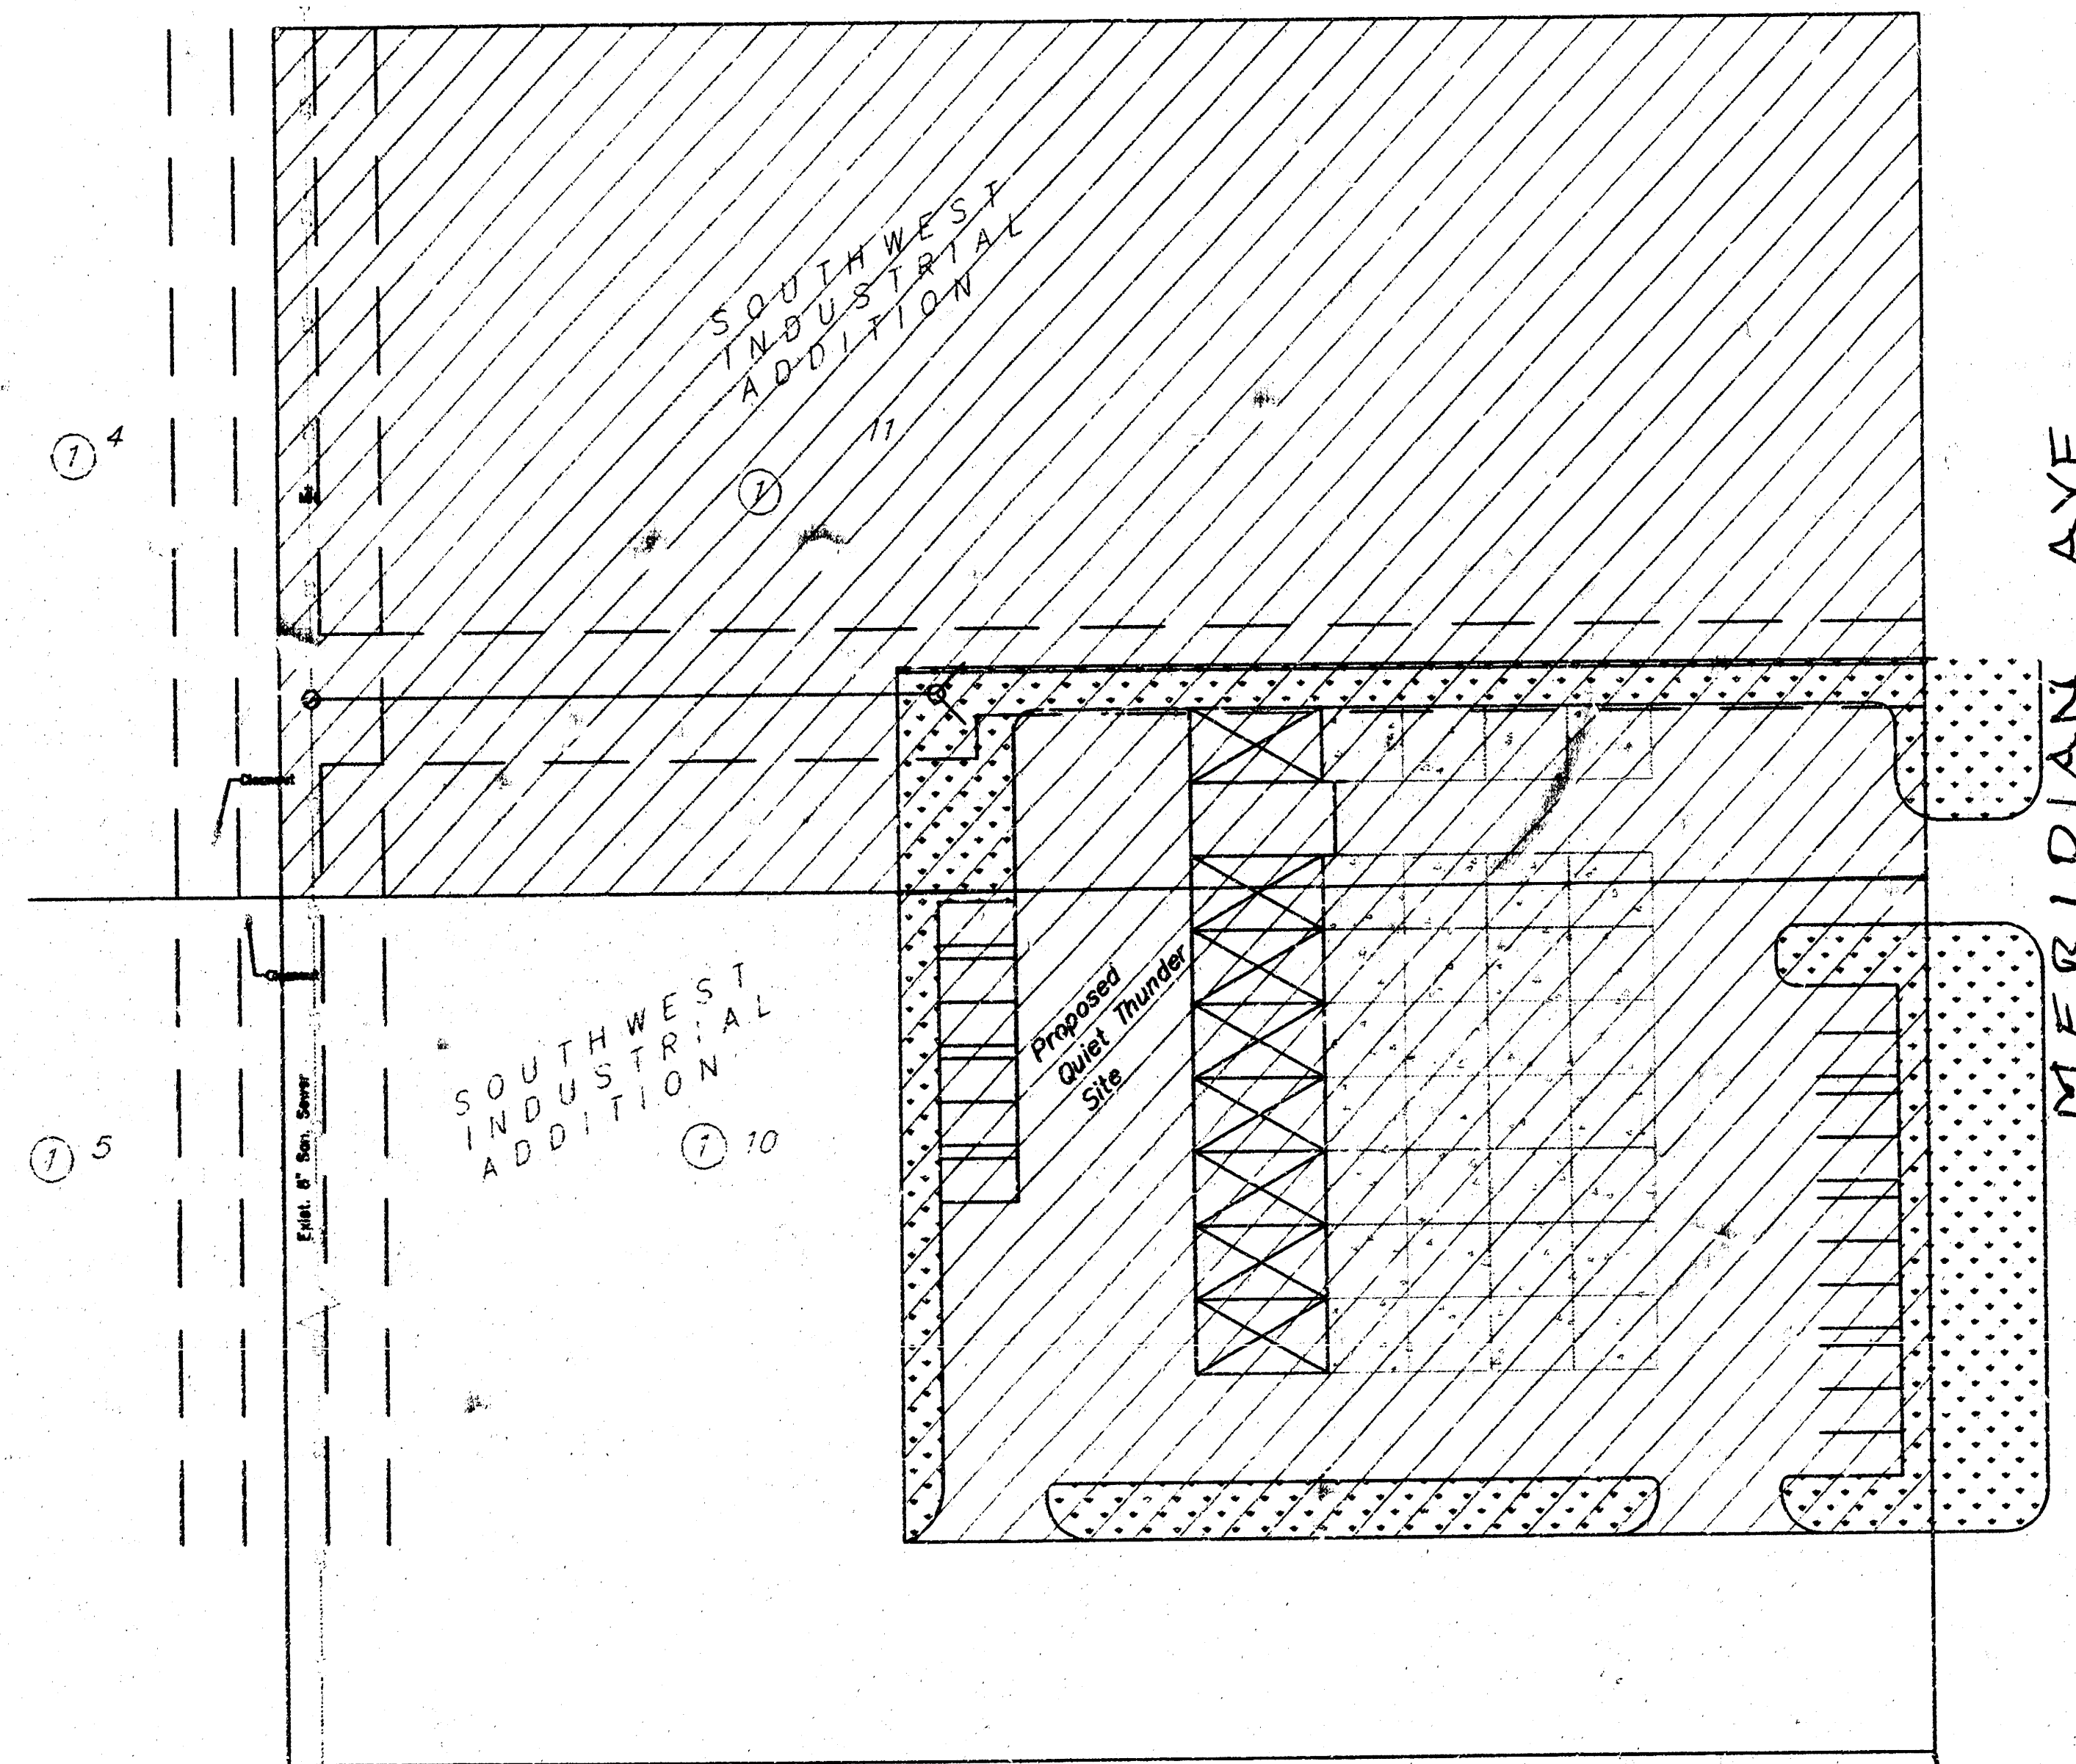


BENCHMARK:



Chisled square on tip of curb of private drive, Southwest Corner of Lot 10 Elev. = 103.61 (COW)

INDEX

- Cover
- Plan and Profile

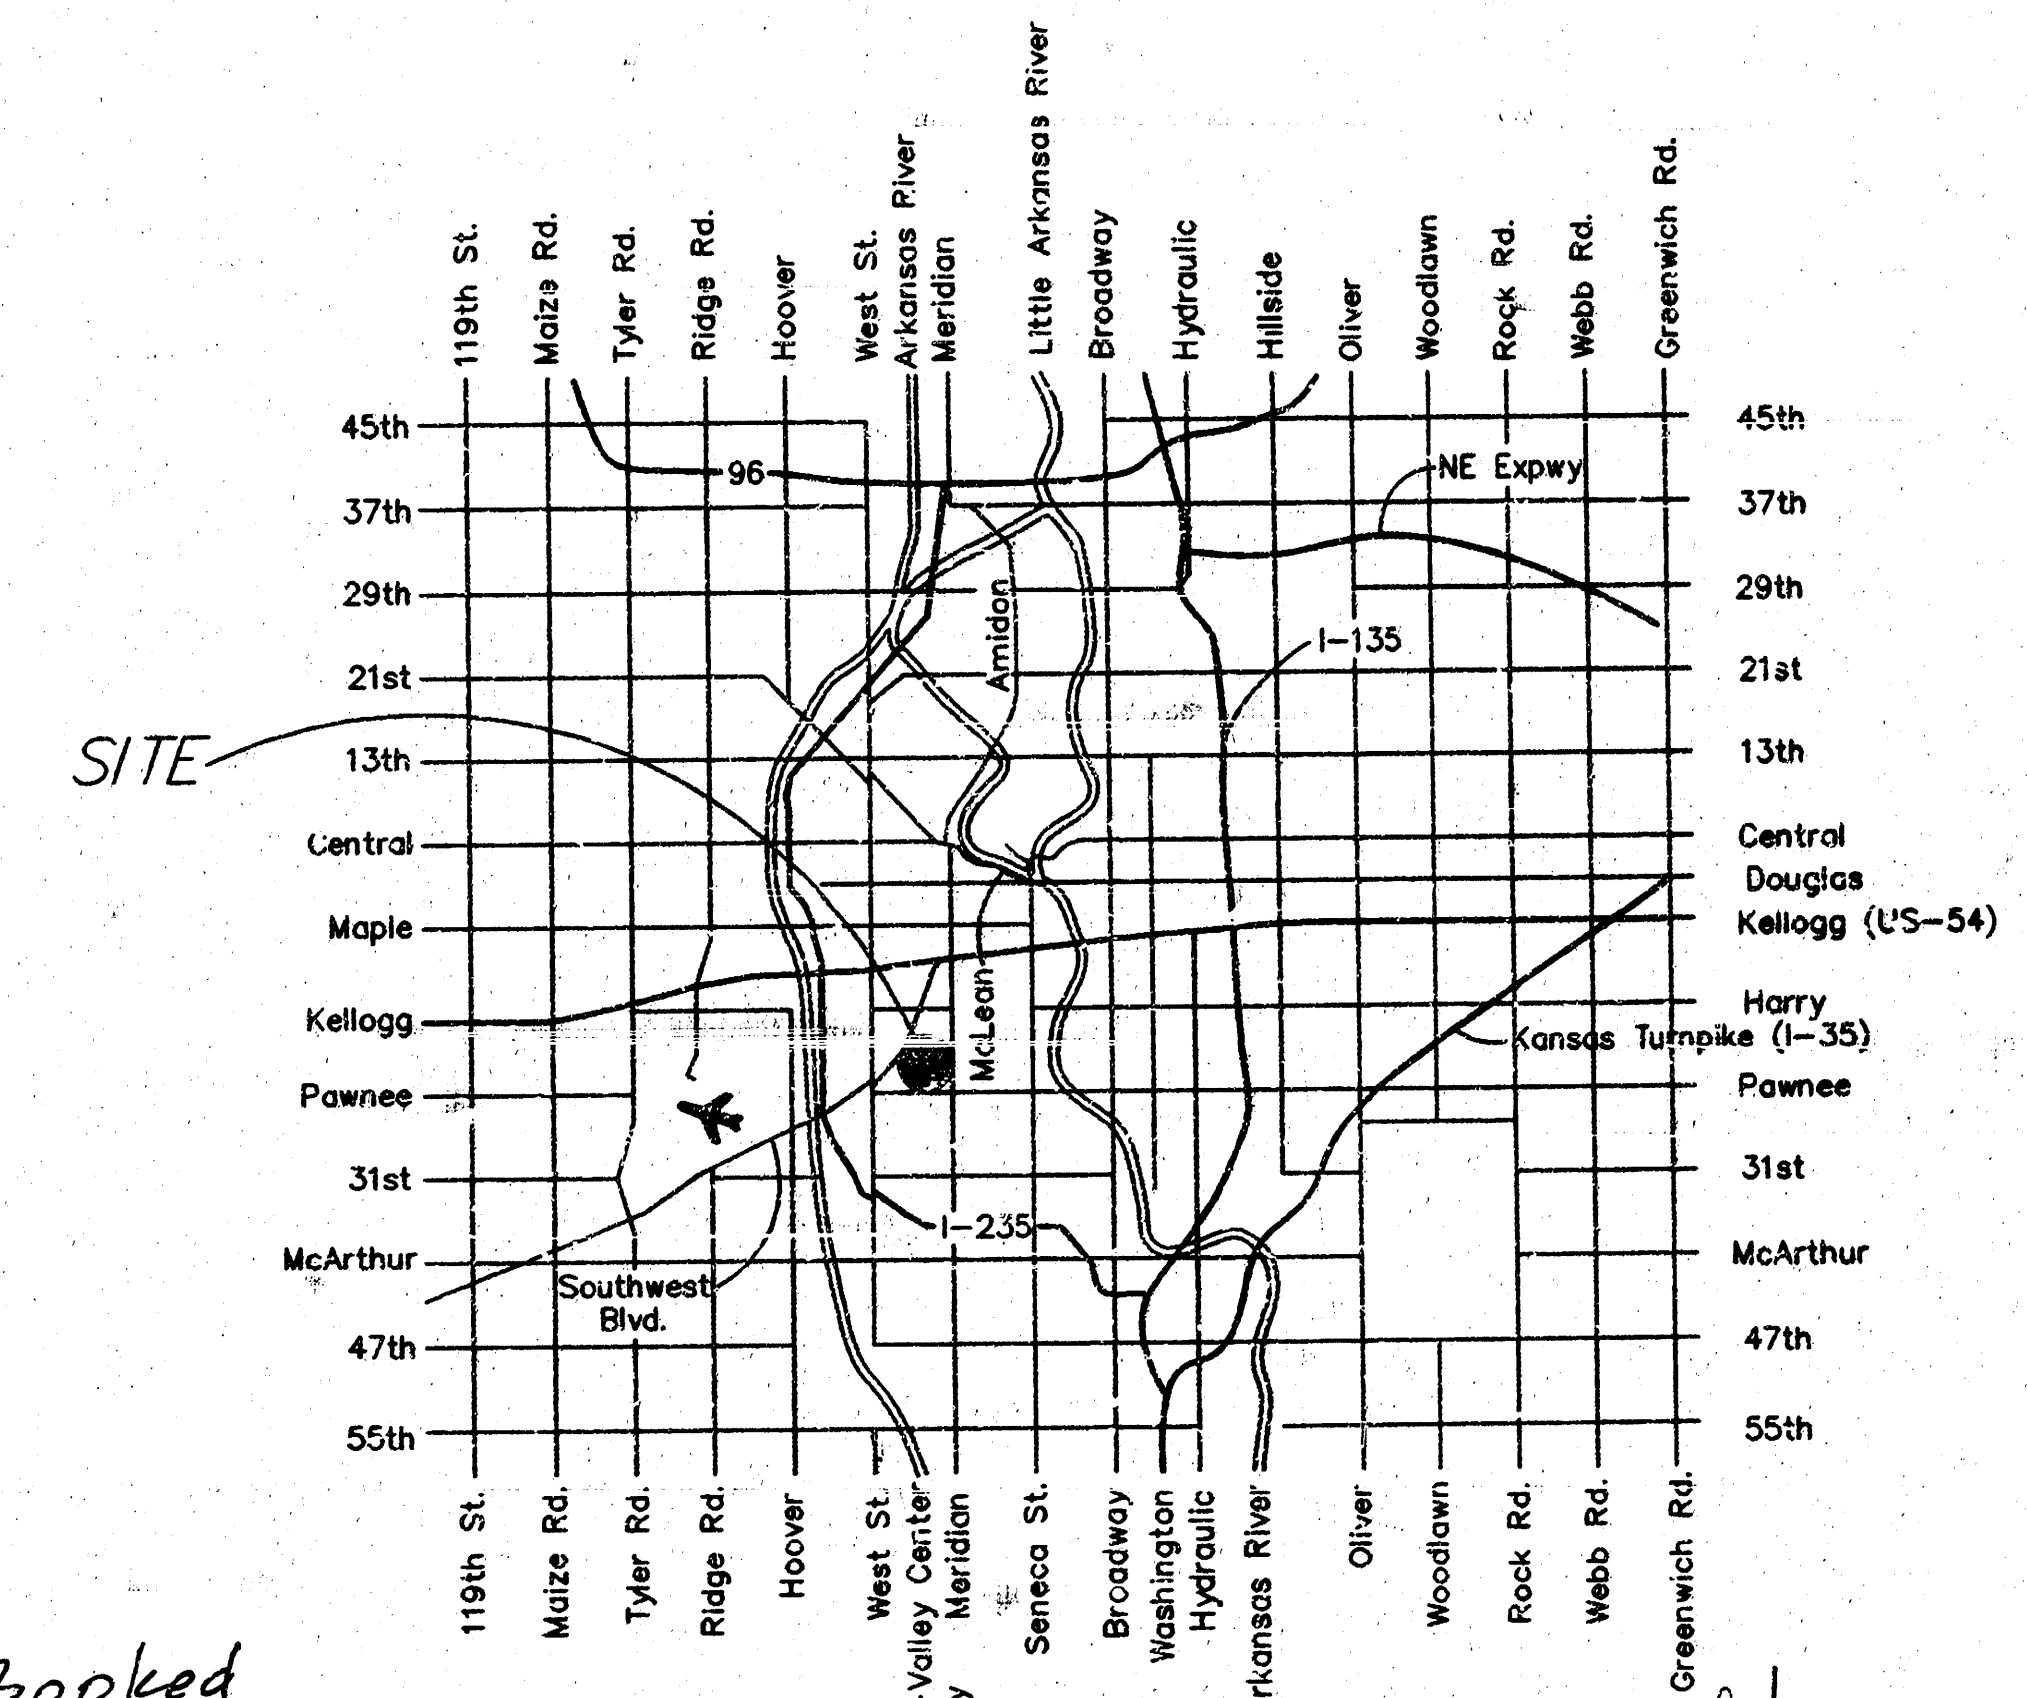


SOUTHWEST
INDUSTRIAL
ADDITION

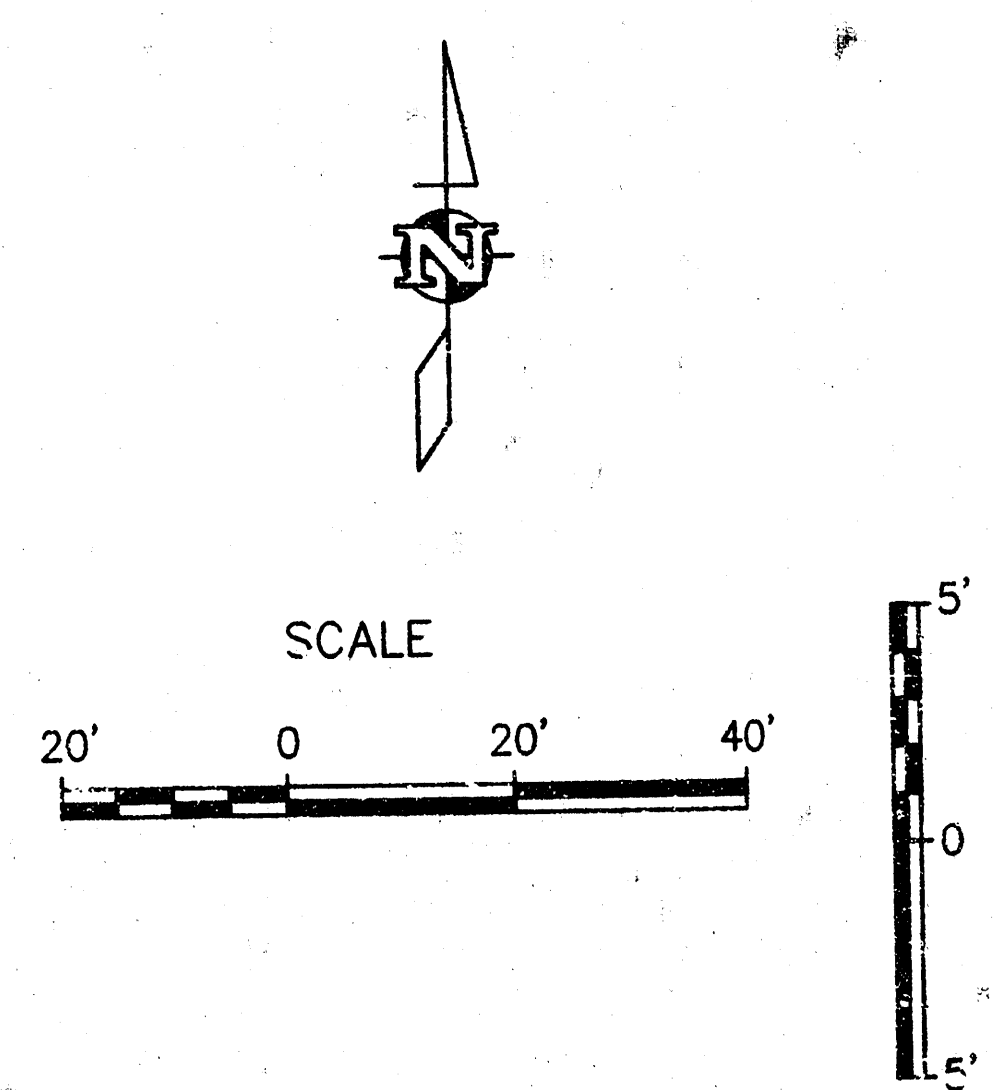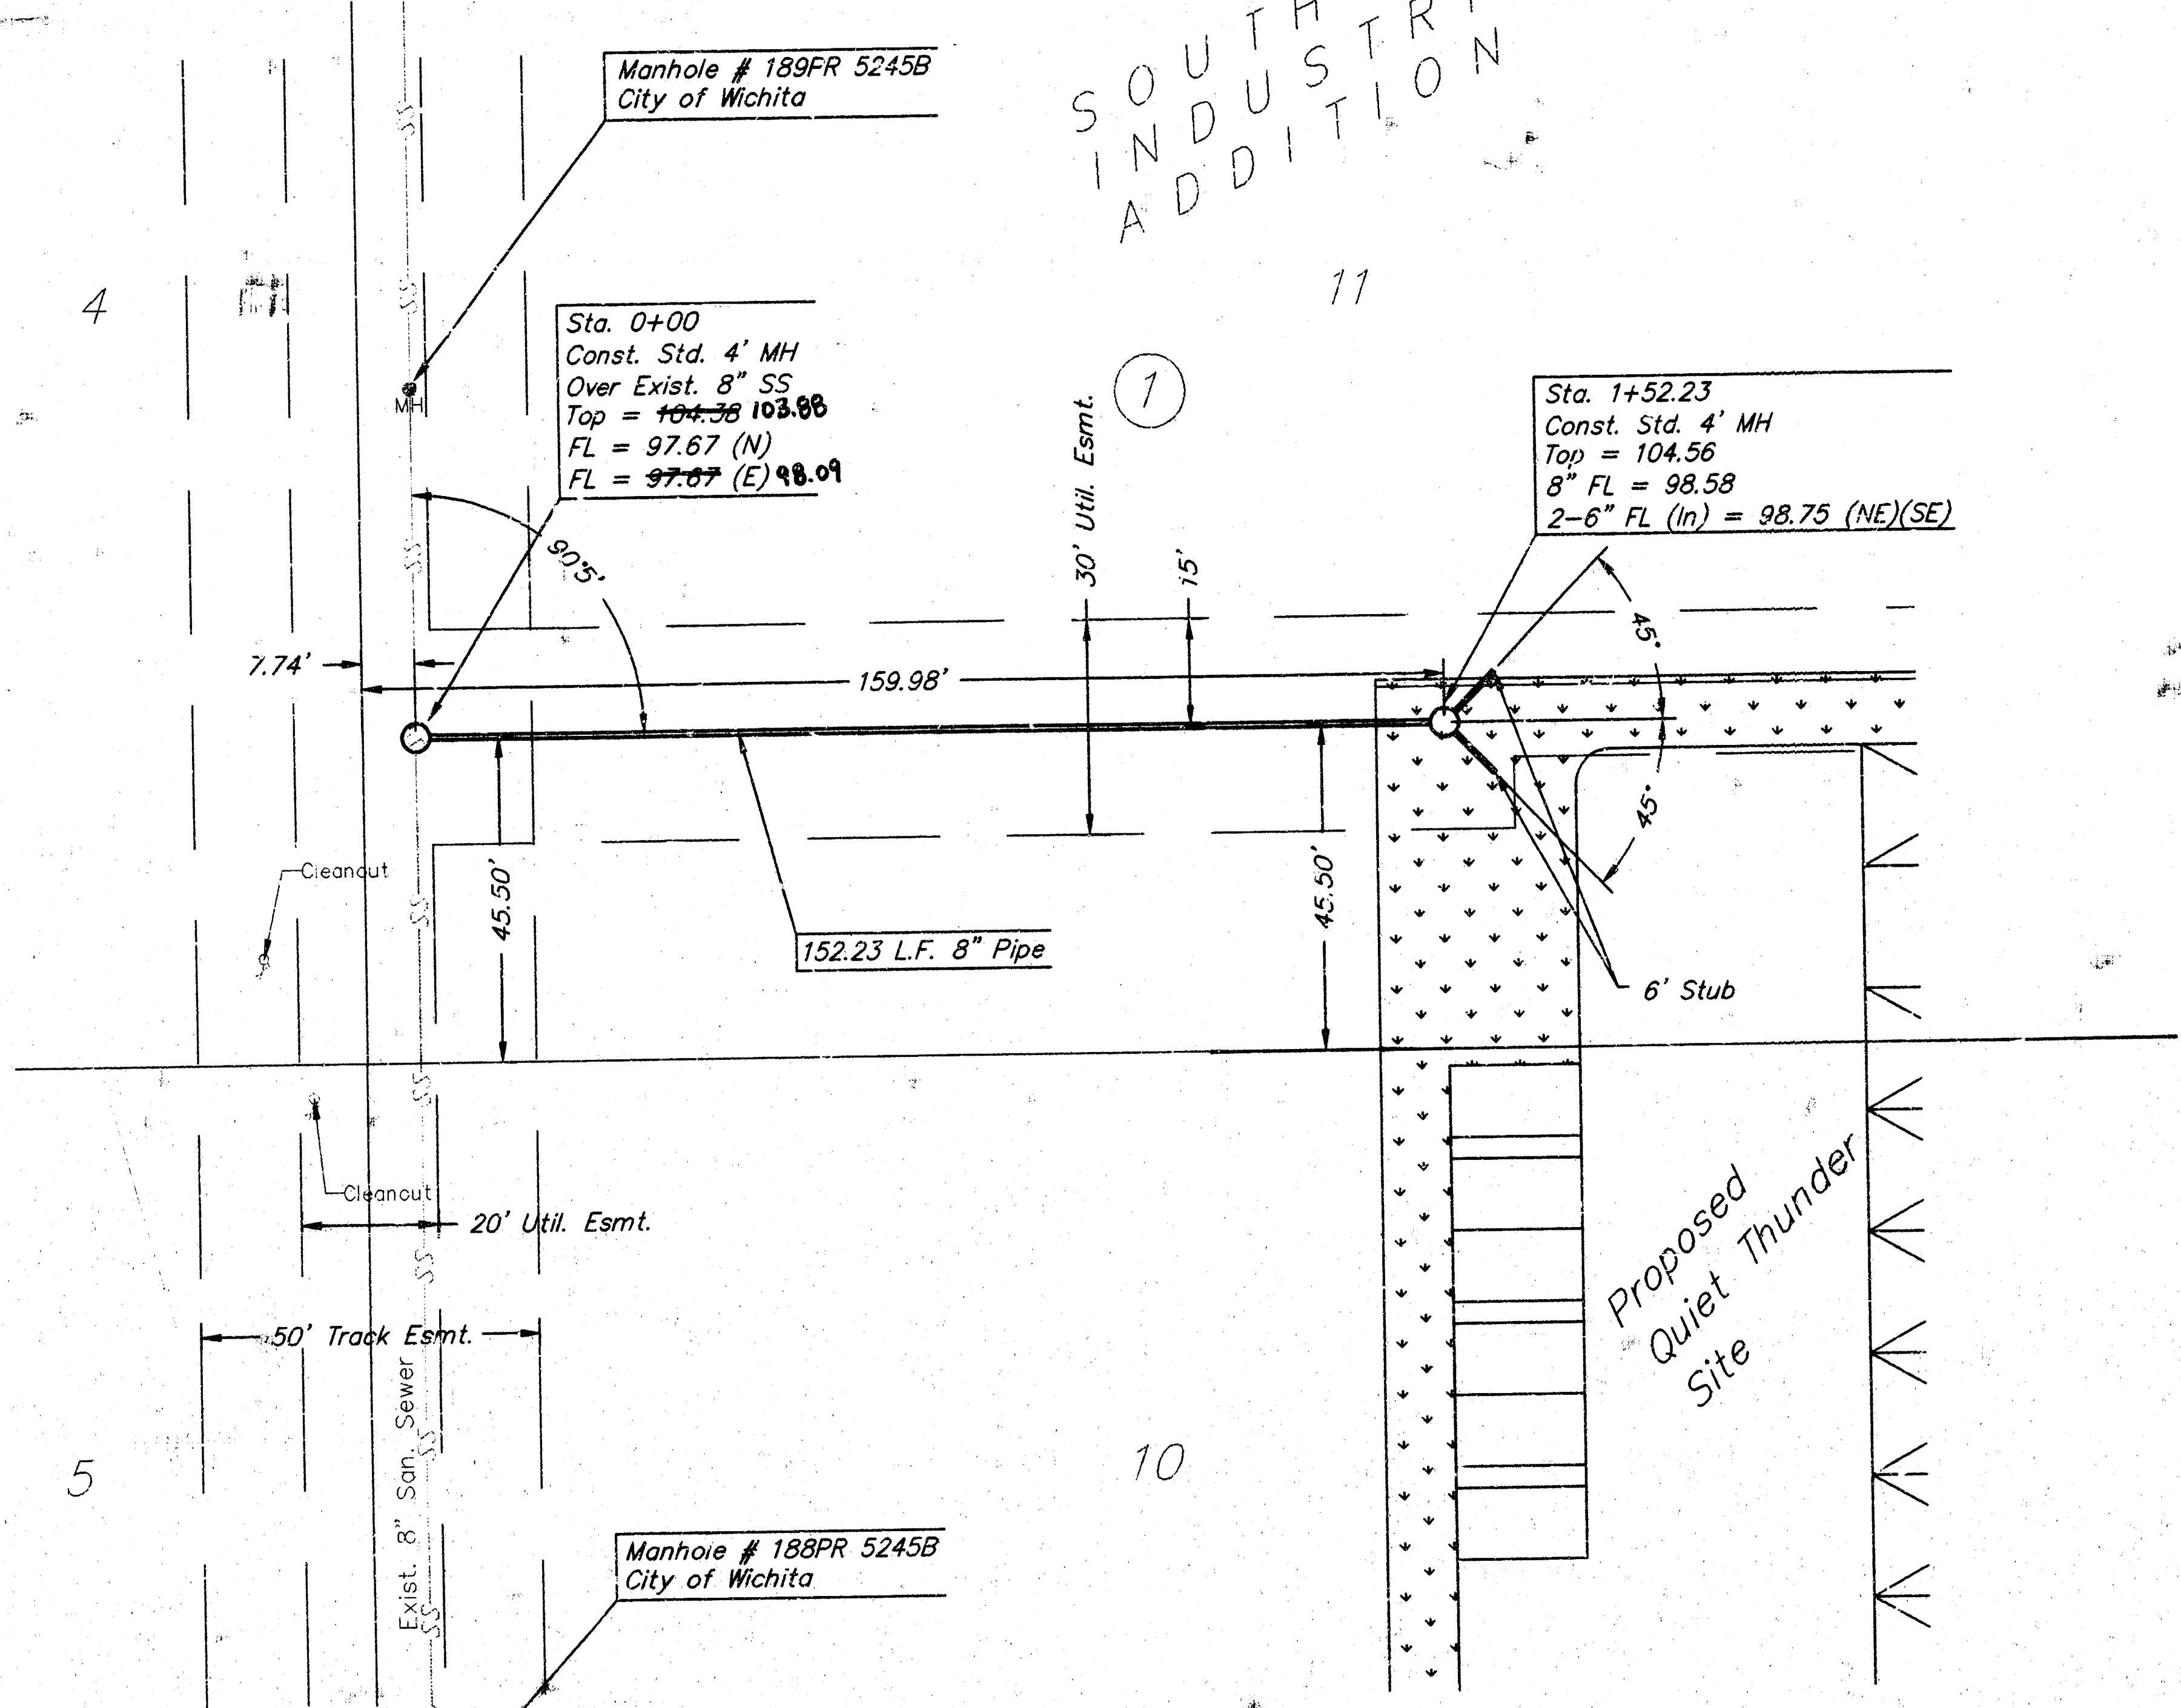

BENCHMARK:

Chisled square on tip of curb
of private drive, Southwest Corner of Lot 10
Elev. = 105.61 (COW)

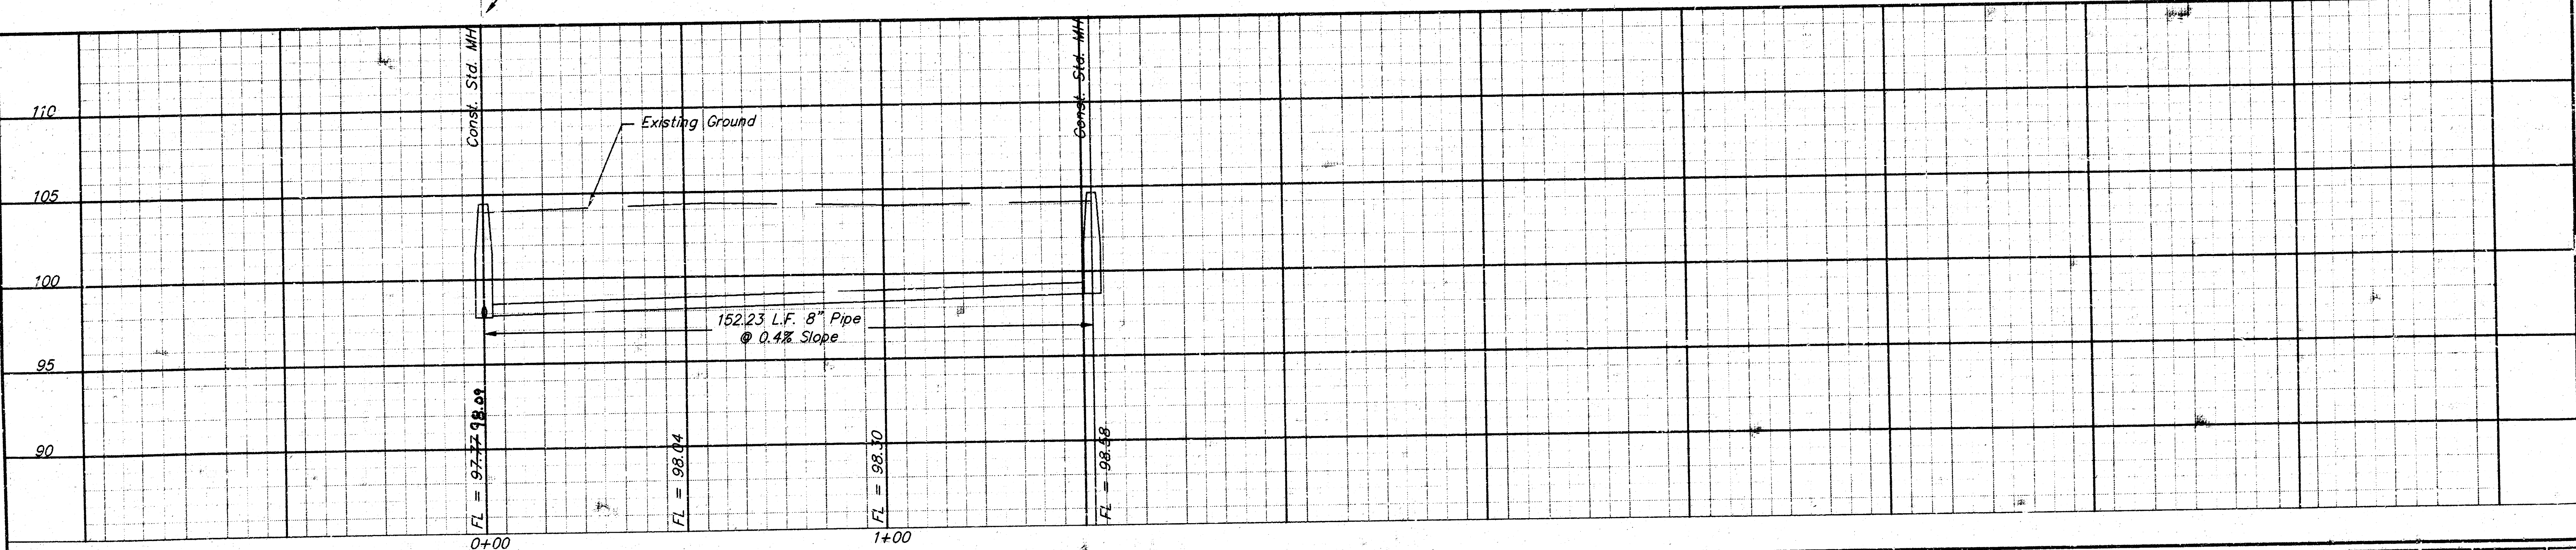

	PROJECT NUMBER 1025 P.S. (807881)				AM. NO. 00226	Sanitary Sewer Ext. Quiet Thunder Wichita, Kansas	SHEET 2 OF 2	REVISION 7/1/00
	DESIGN PB	DRAWN MP	FILE SS1	DATE 7/00	SCALE 1"=20'			