

|                    |      |  |
|--------------------|------|--|
| PLAN               | DATE |  |
|                    | BY   |  |
| SURVEYED           | DATE |  |
|                    | BY   |  |
| NOTE BOOK          | DATE |  |
|                    | BY   |  |
| STRUCTURE NOTATION | DATE |  |
|                    | BY   |  |


GRANT OF EASEMENT  
FILM 360, PAGE 263  
EXHIBIT A

110 FT. 8 MAIN W/  
(1) MANHOLE

EXIST. SANITARY  
SEWER M.H. TOP  
OF RING 172.55

THE RESIDENCE INN

LOT 1 EVC ADDITION  
WICHITA, SEDGWICK CO., K.S.

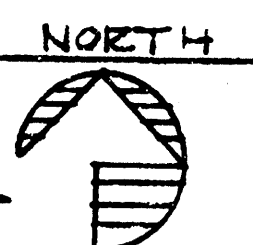


LOCATION  
LOT 1 EVC ADDITION  
WICHITA, SEDGWICK CO.  
PROJ. ADDRESS  
41150 W. 66th ROAD  
WICHITA, K.S.

DATE: 10-31-80  
CONTRACTOR  
DON VAUGHN

NOTE TO CONTRACTOR  
This project will be constructed under  
the supervision of the CITY ENGINEER  
and conforming to the SPECIFICATIONS  
of the CITY OF WICHITA. The CON-  
TRACTOR will reimburse the City of  
Wichita for all cost of ~~inspection~~  
Inspection.


10-31-80  
APPROVED AS NOTED  
By CITY ENGINEER OF WICHITA  
Sanitary Sewers *[Signature]*  
Storm Sewers  
Driveway Approaches

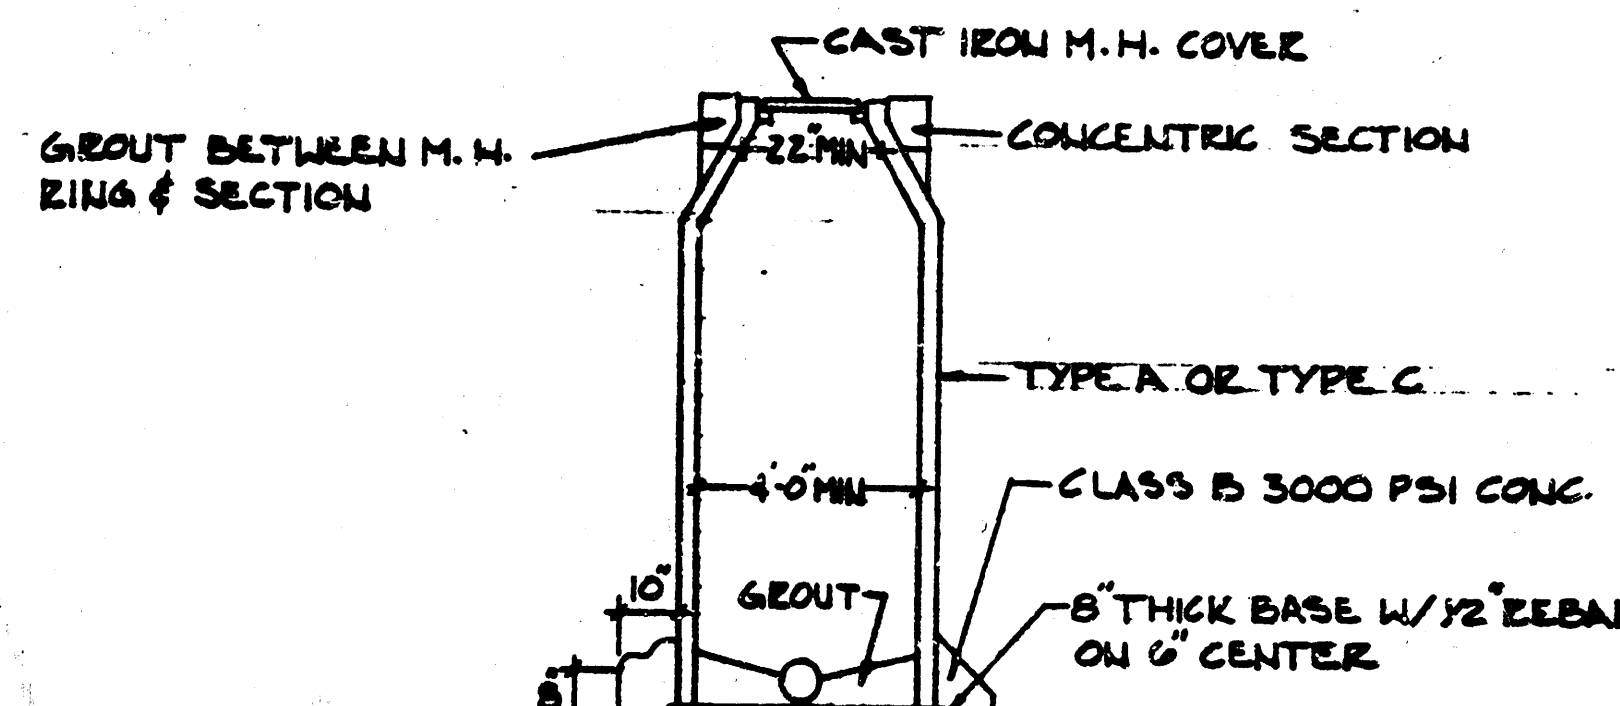

MANHOLE DETAIL NO SCALE

|                    |      |  |
|--------------------|------|--|
| PROFILE            | DATE |  |
|                    | BY   |  |
| SURVEYED           | DATE |  |
|                    | BY   |  |
| NOTE BOOK          | DATE |  |
|                    | BY   |  |
| STRUCTURE NOTATION | DATE |  |
|                    | BY   |  |

EXIST. SANITARY  
SEWER

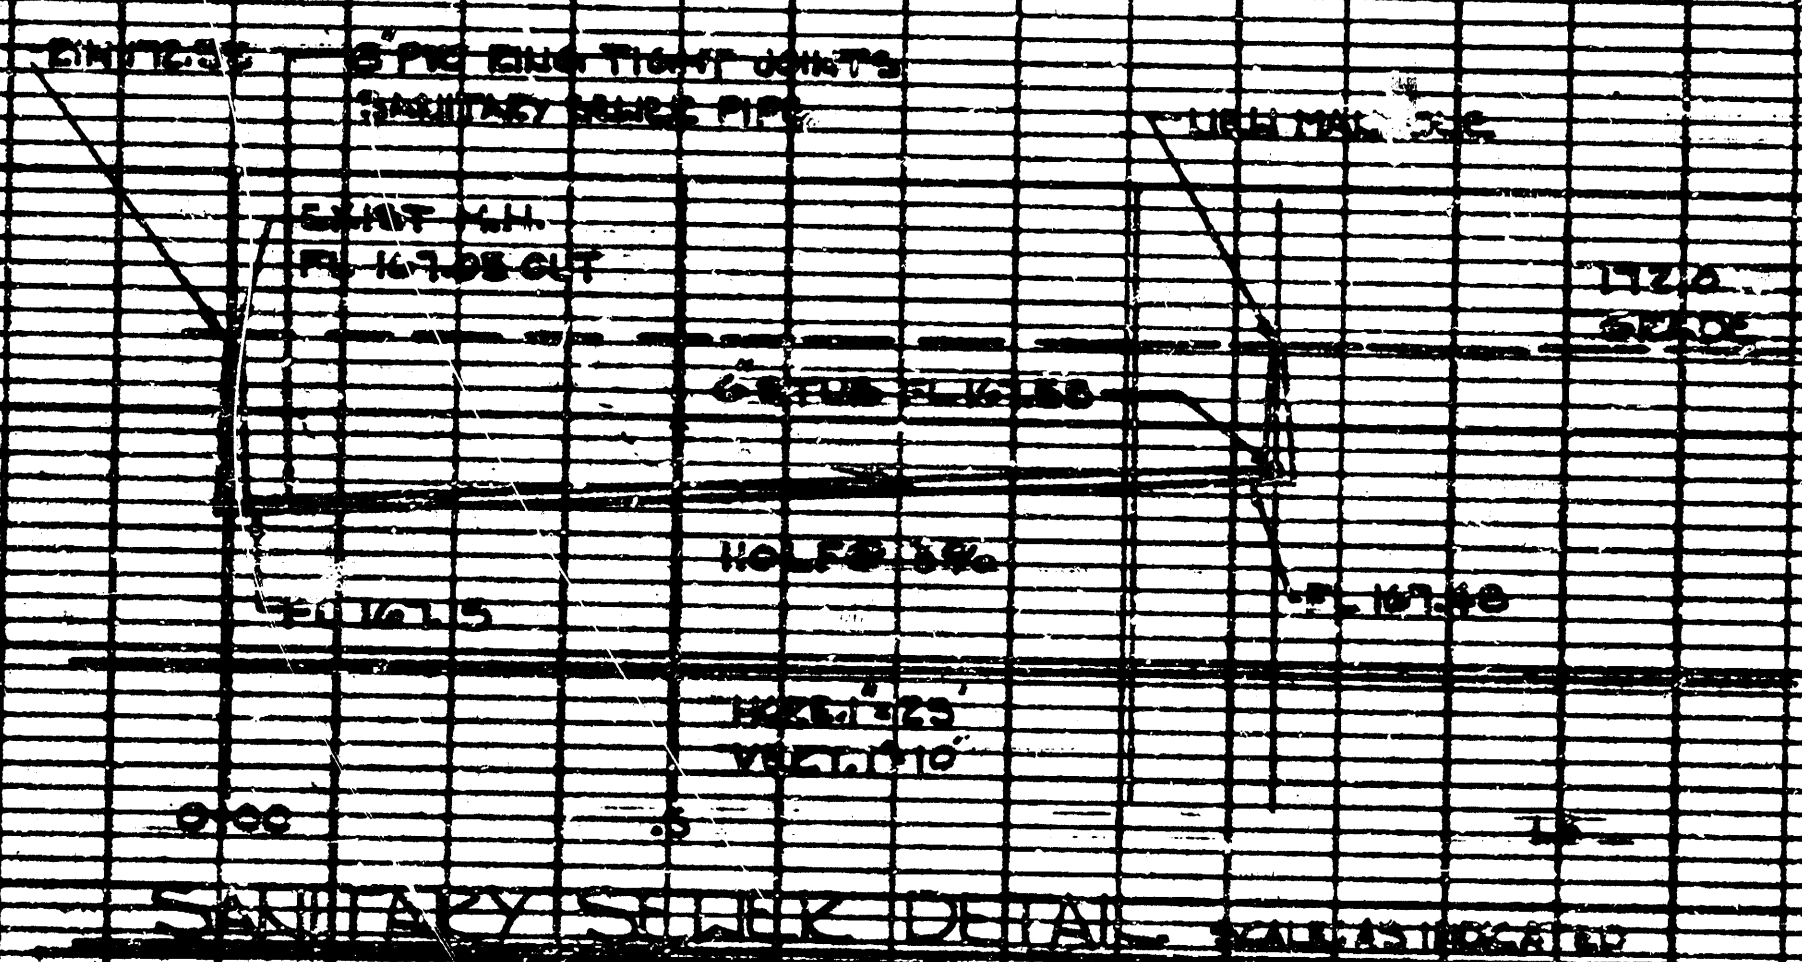

SANITARY SEWER DETAIL

KELLOGG

PLATE 1 - PLAN - PROFILE - F.A.S.  
CLEARPRINT PAPER CO., S.P. CAL.  
NO. 100-1

Project # 468-76-245-80000-000-000-008

SEAN J. VAUGHN  
CONSULTING ENGINEER  
ROOM 202  
1111 N. LAUREL, WICHITA, KANSAS 67202



FILED FROM THE BEST