

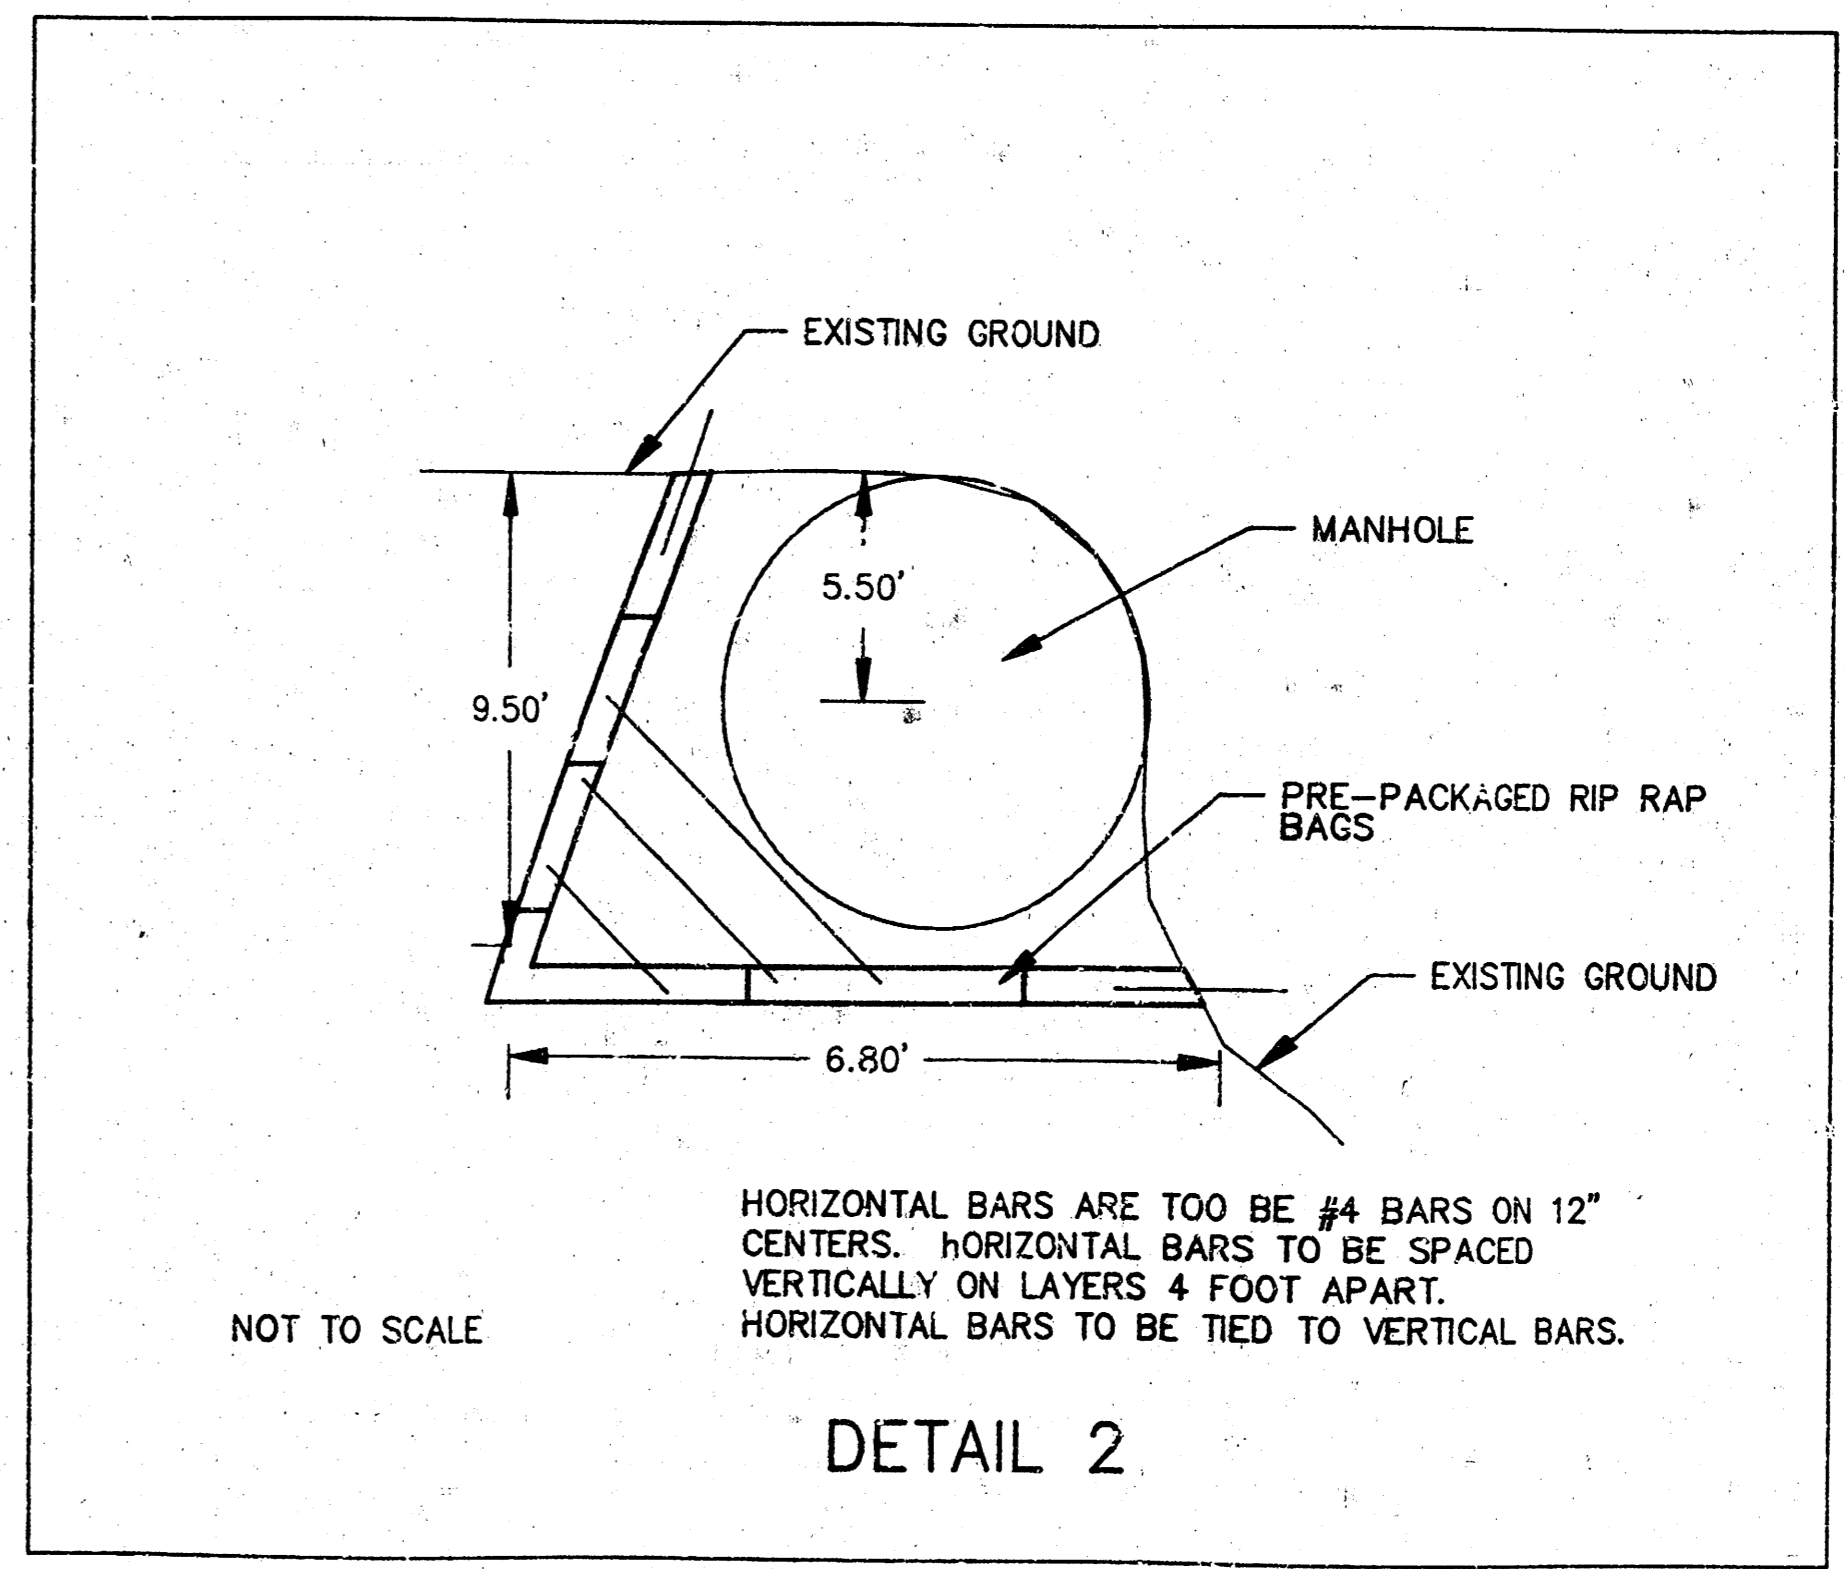


PROJECT LOCATION

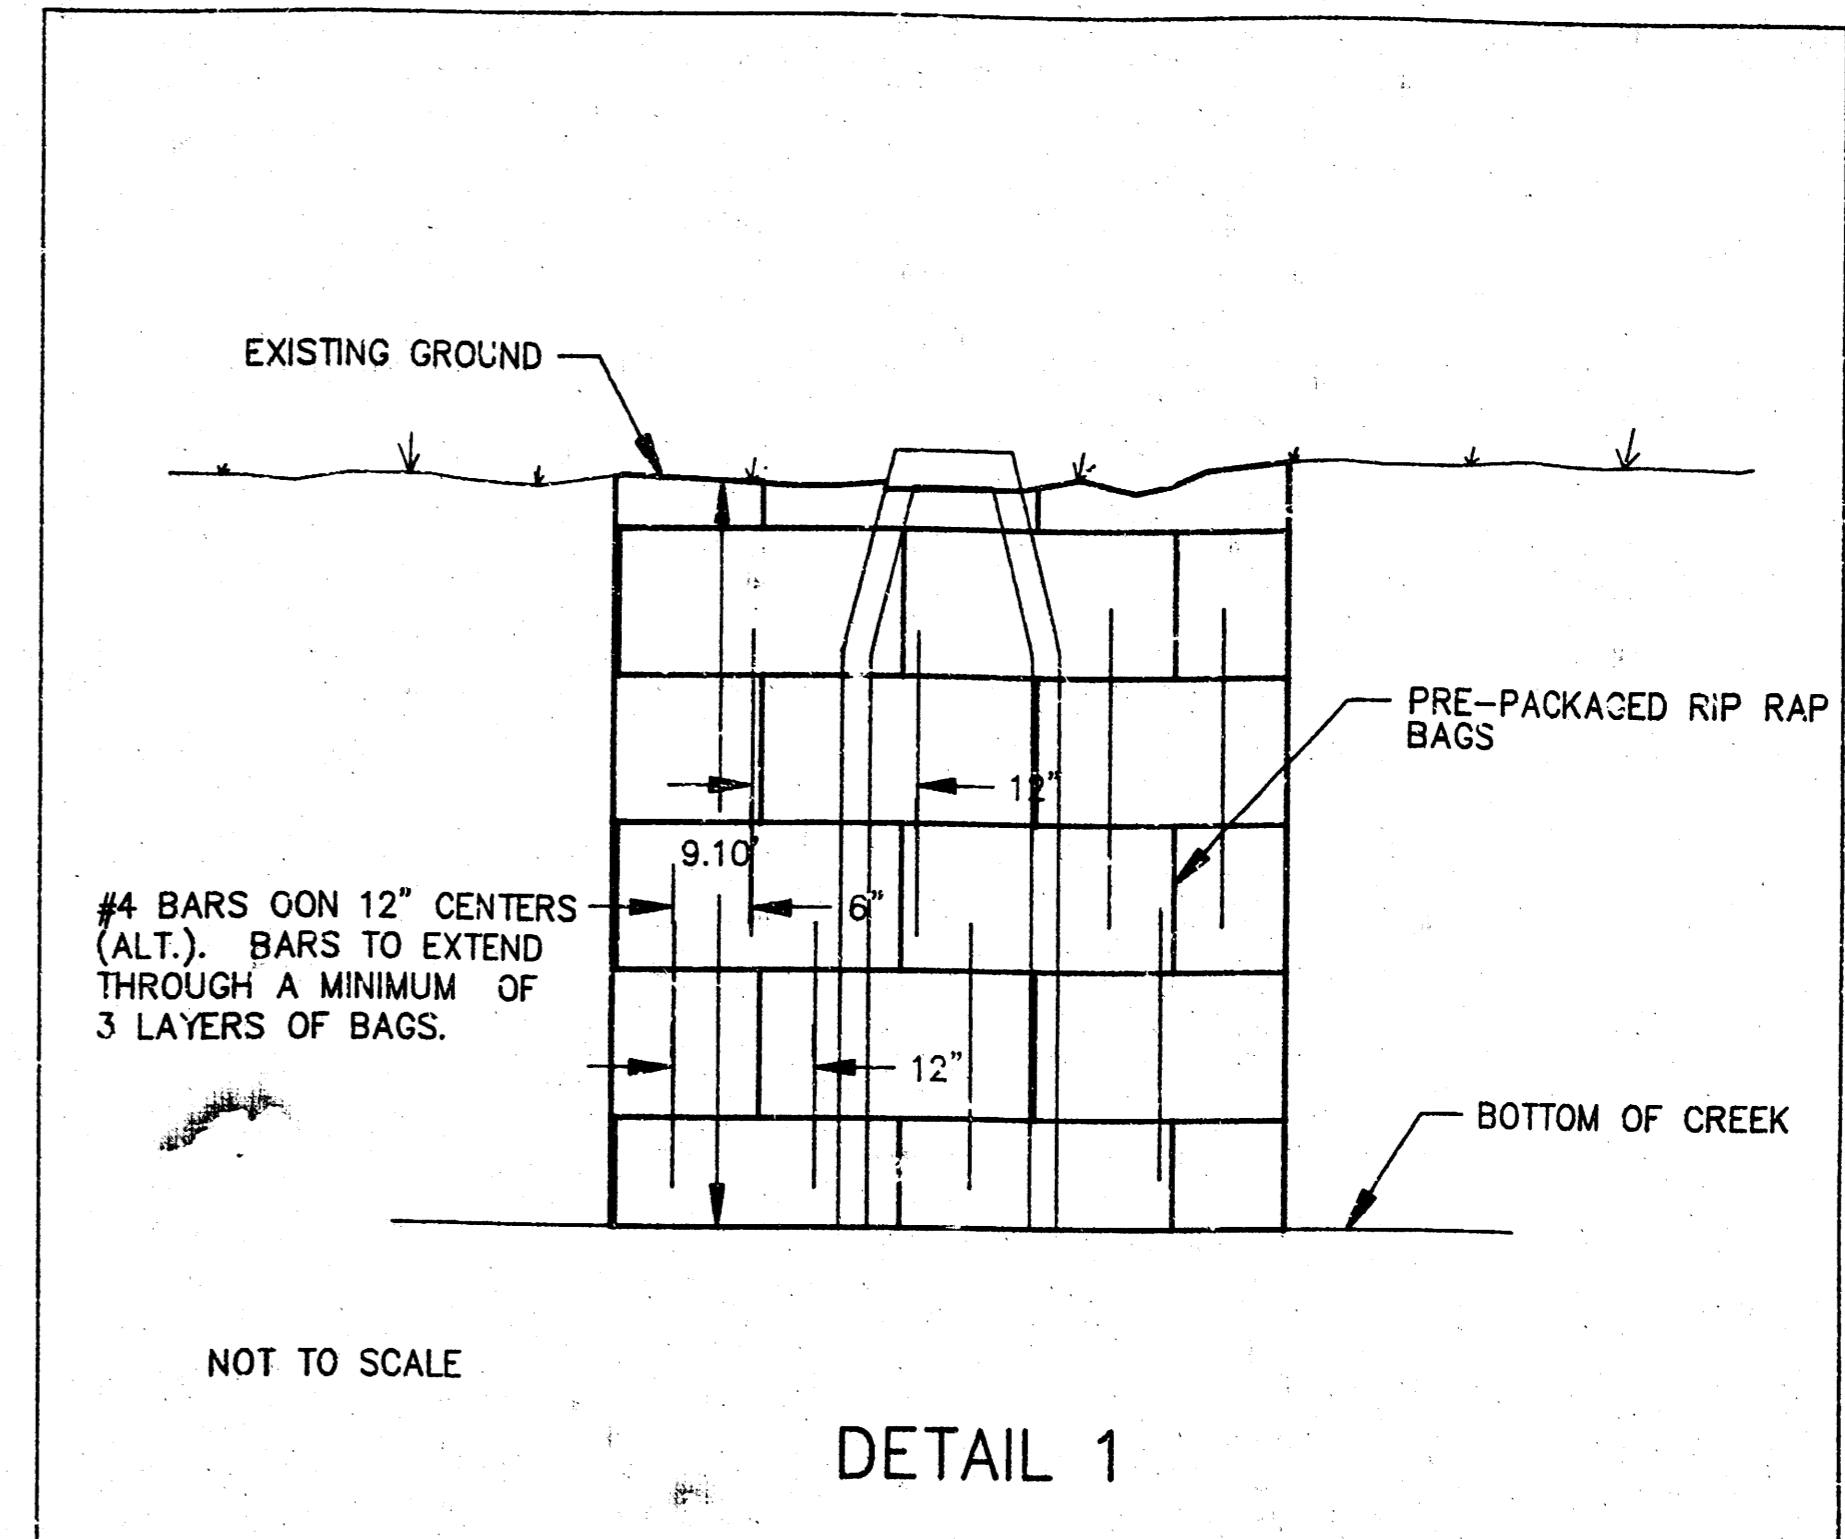


SCALE: 1" = 40'

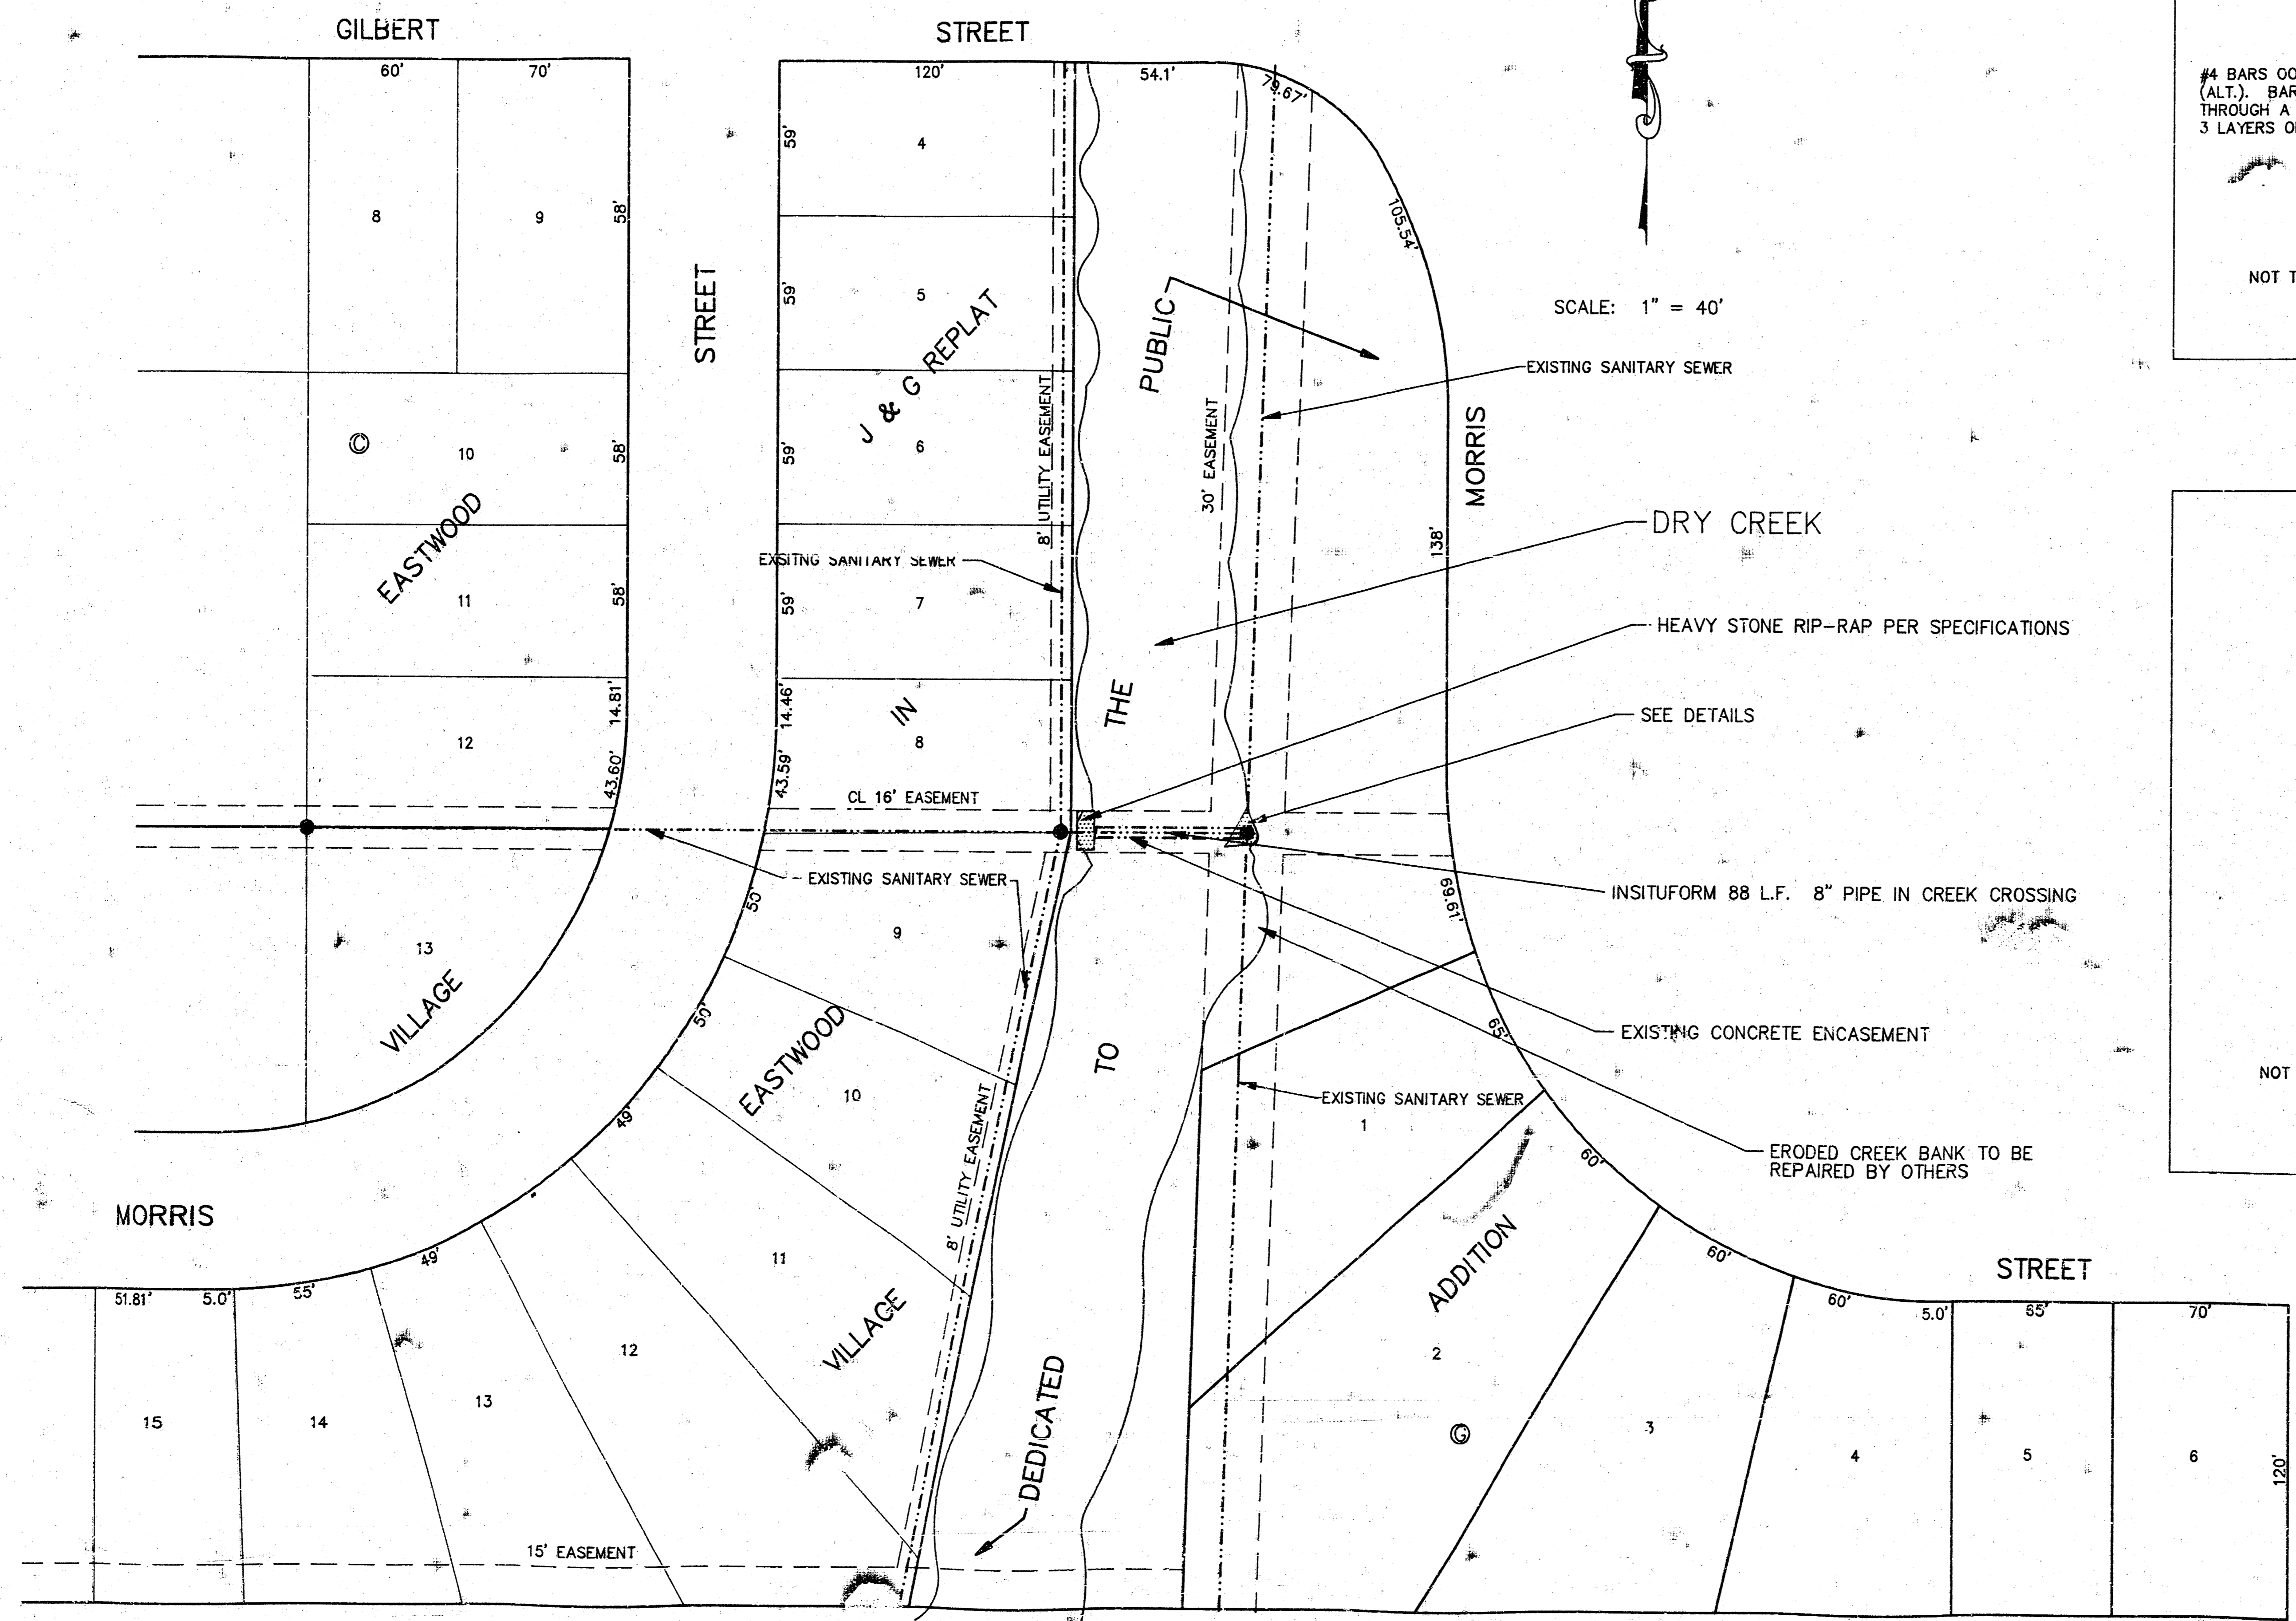

1994 Sanitary Sewer Rehabilitation Program Phase I

Booked 2-15-95
As Per Plan

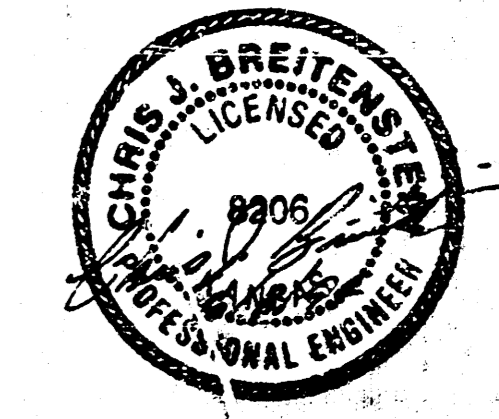

PROJ. NO. 468-82399
INDEX NO. 623124
DRAWN BY J. BRIGGS