

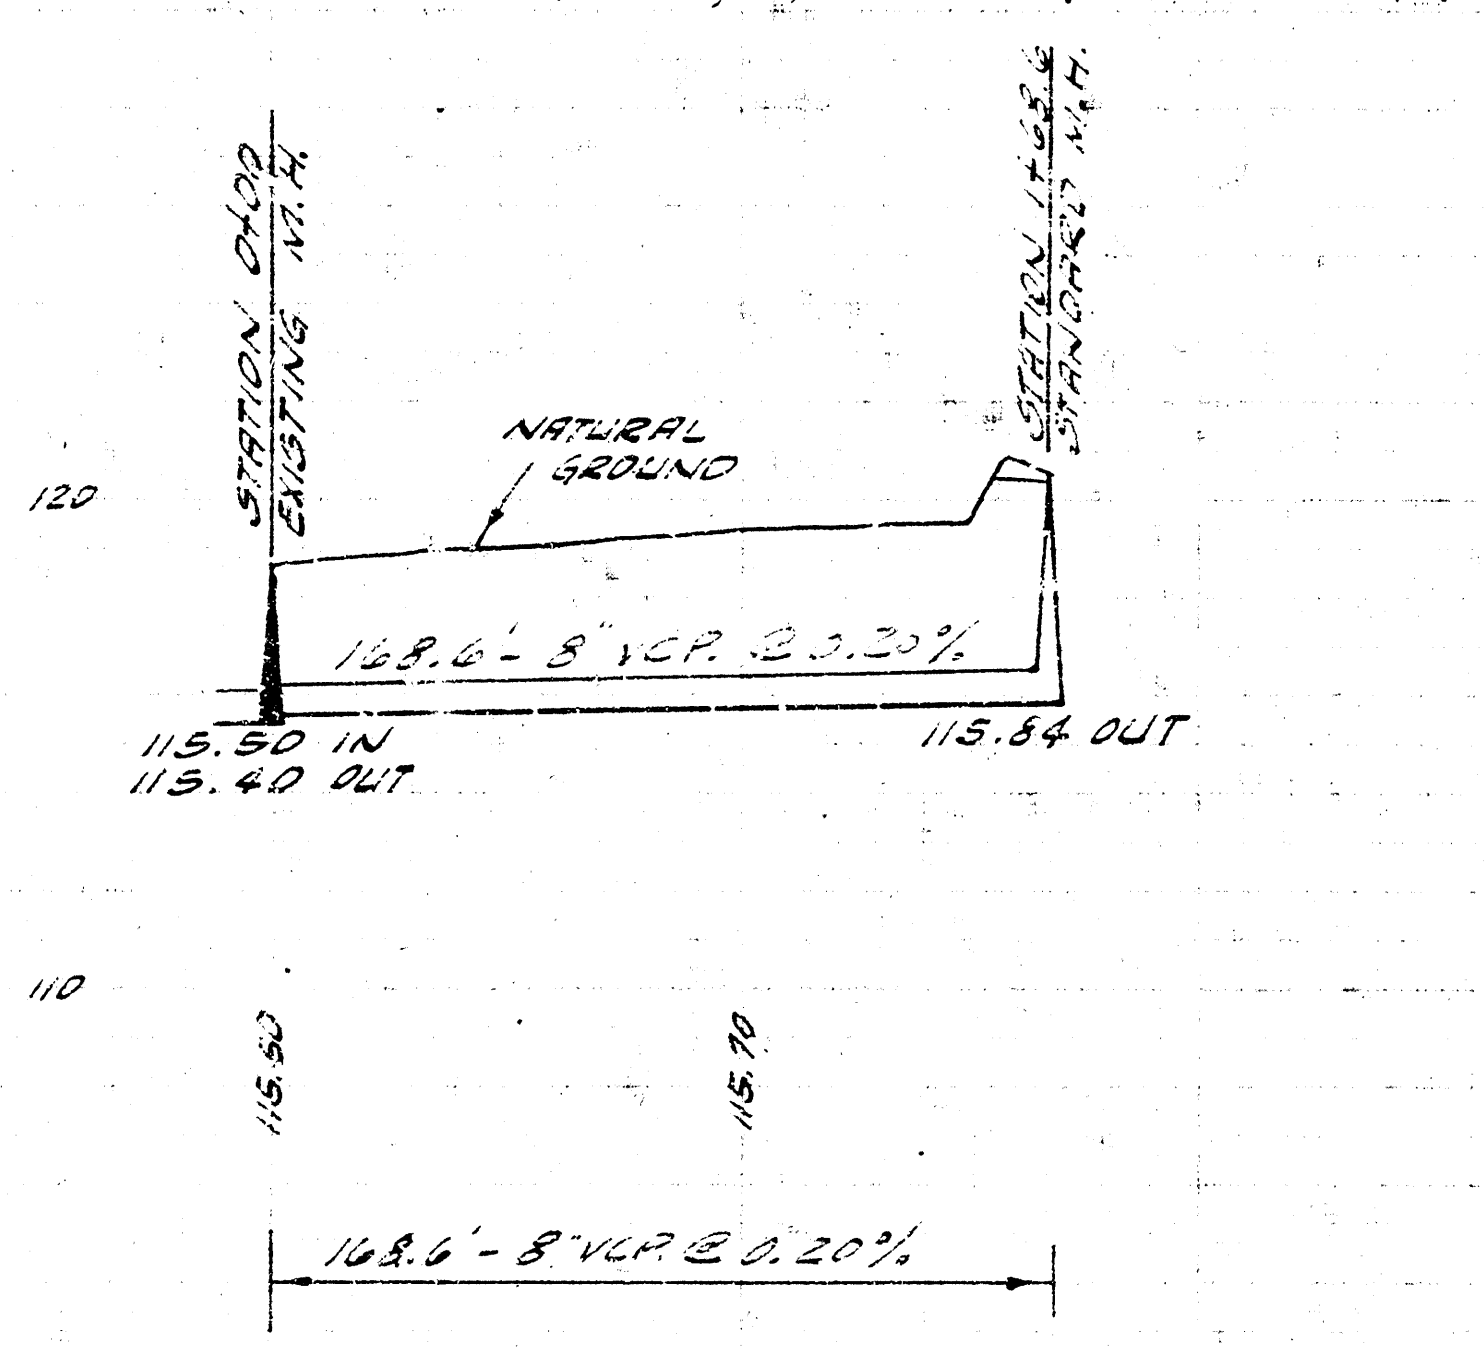
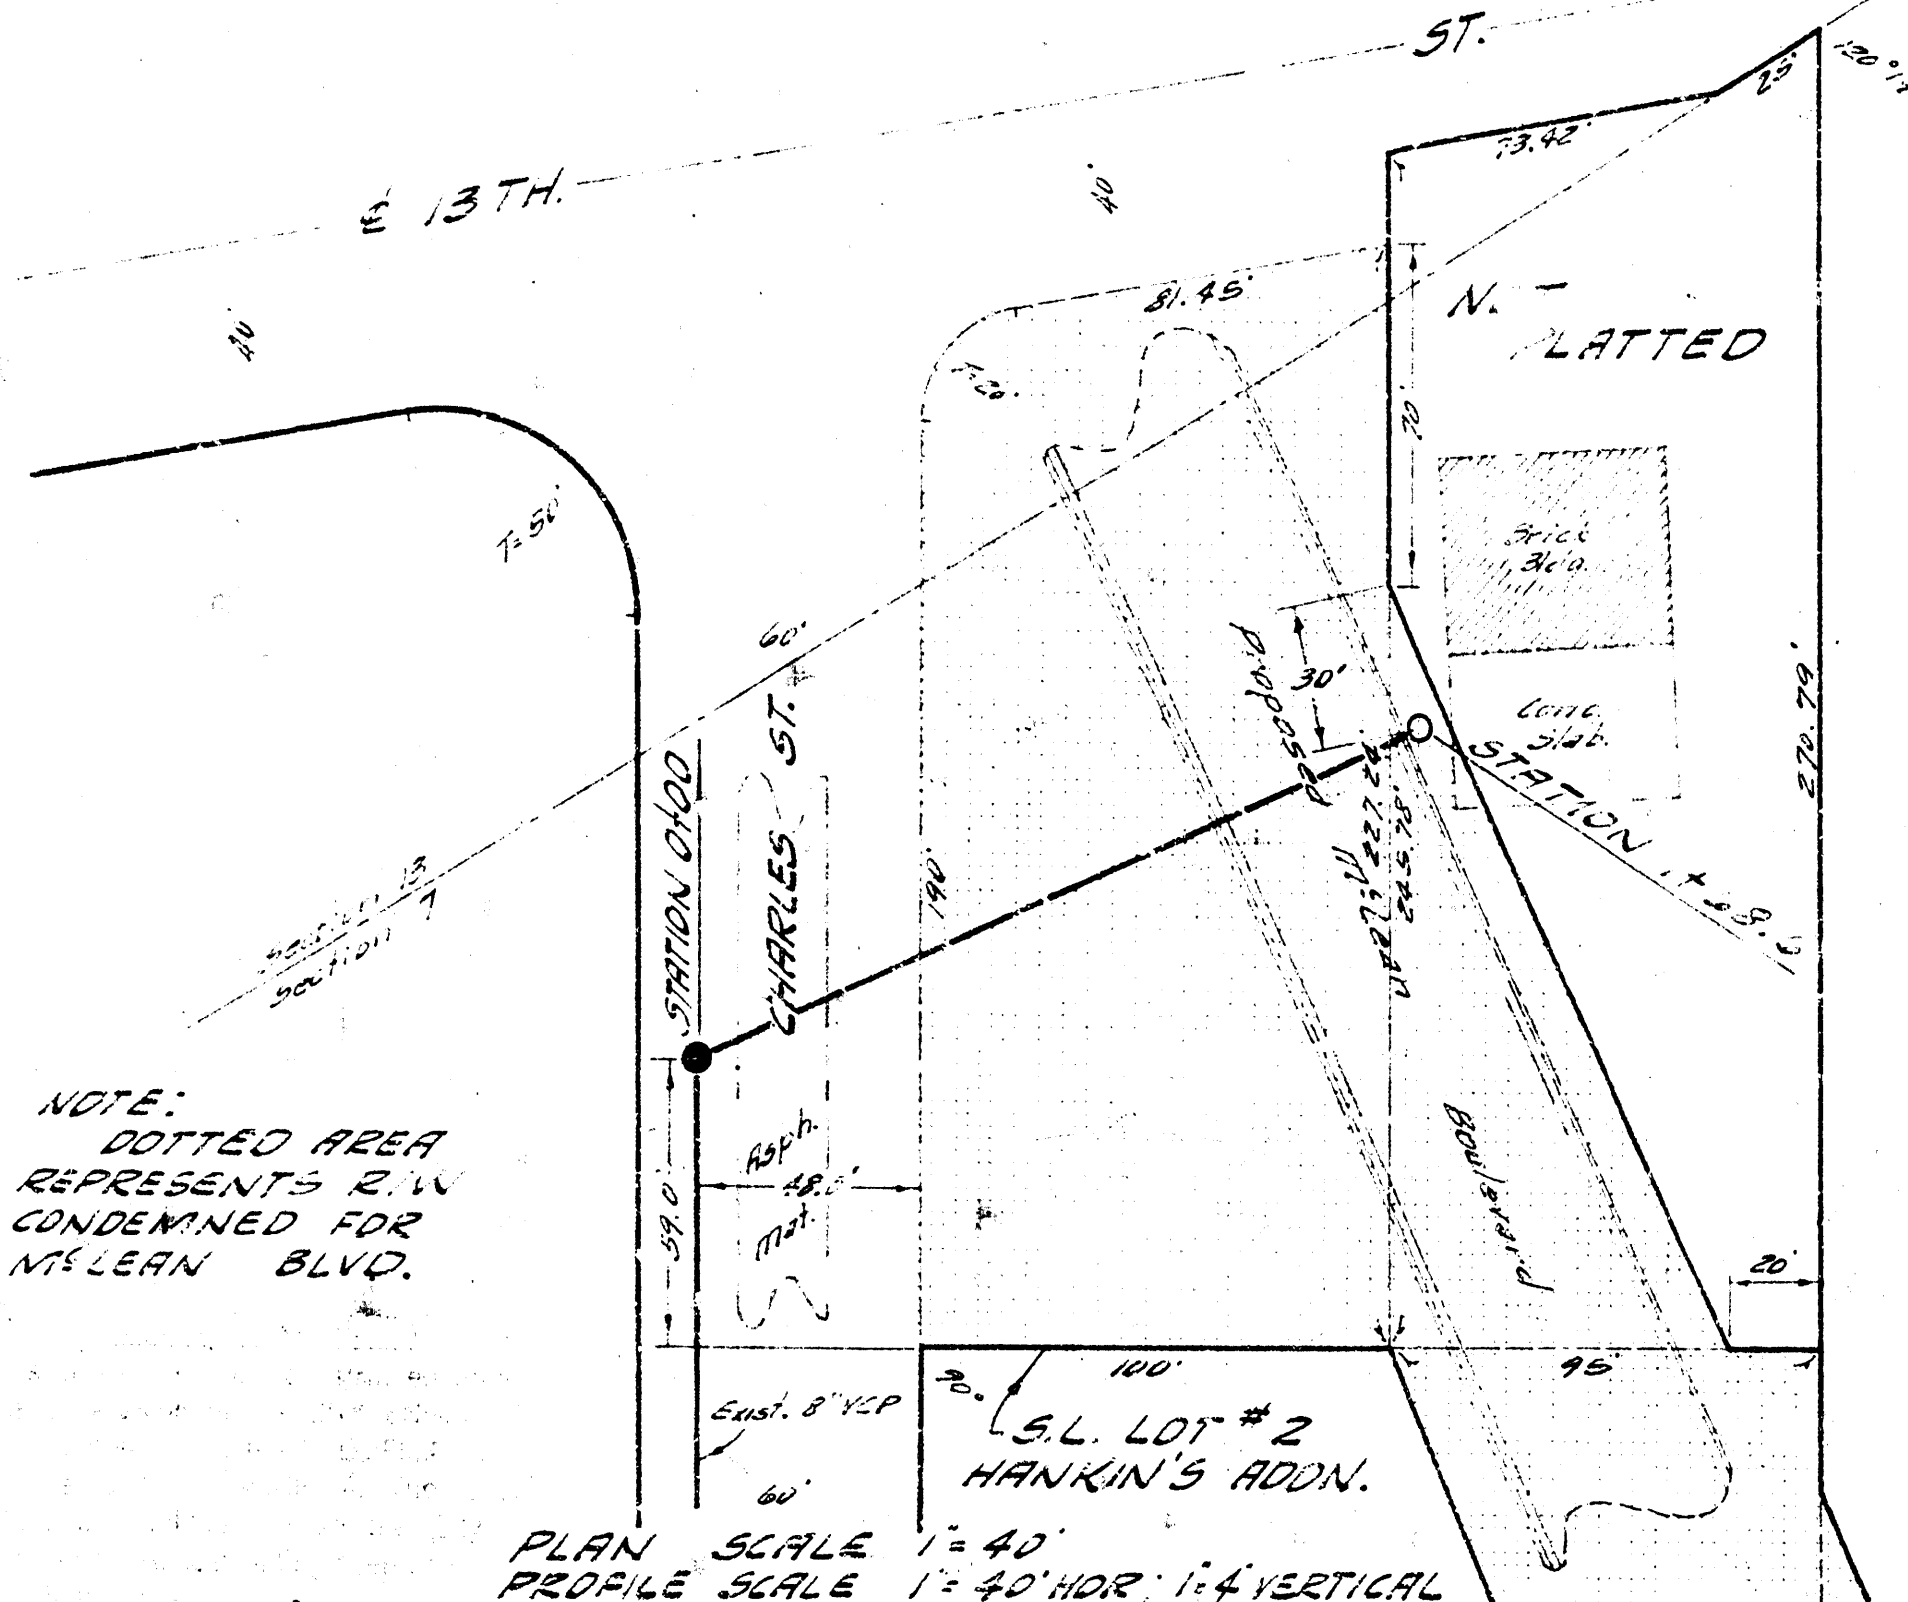


B.M. 119.30 NAIL IN ALP ES CHARLES END POLE N. OF 13TH.
AS BUILT PLANS
 S.W. CORNER OF INTERSECTION BULL KIRCH

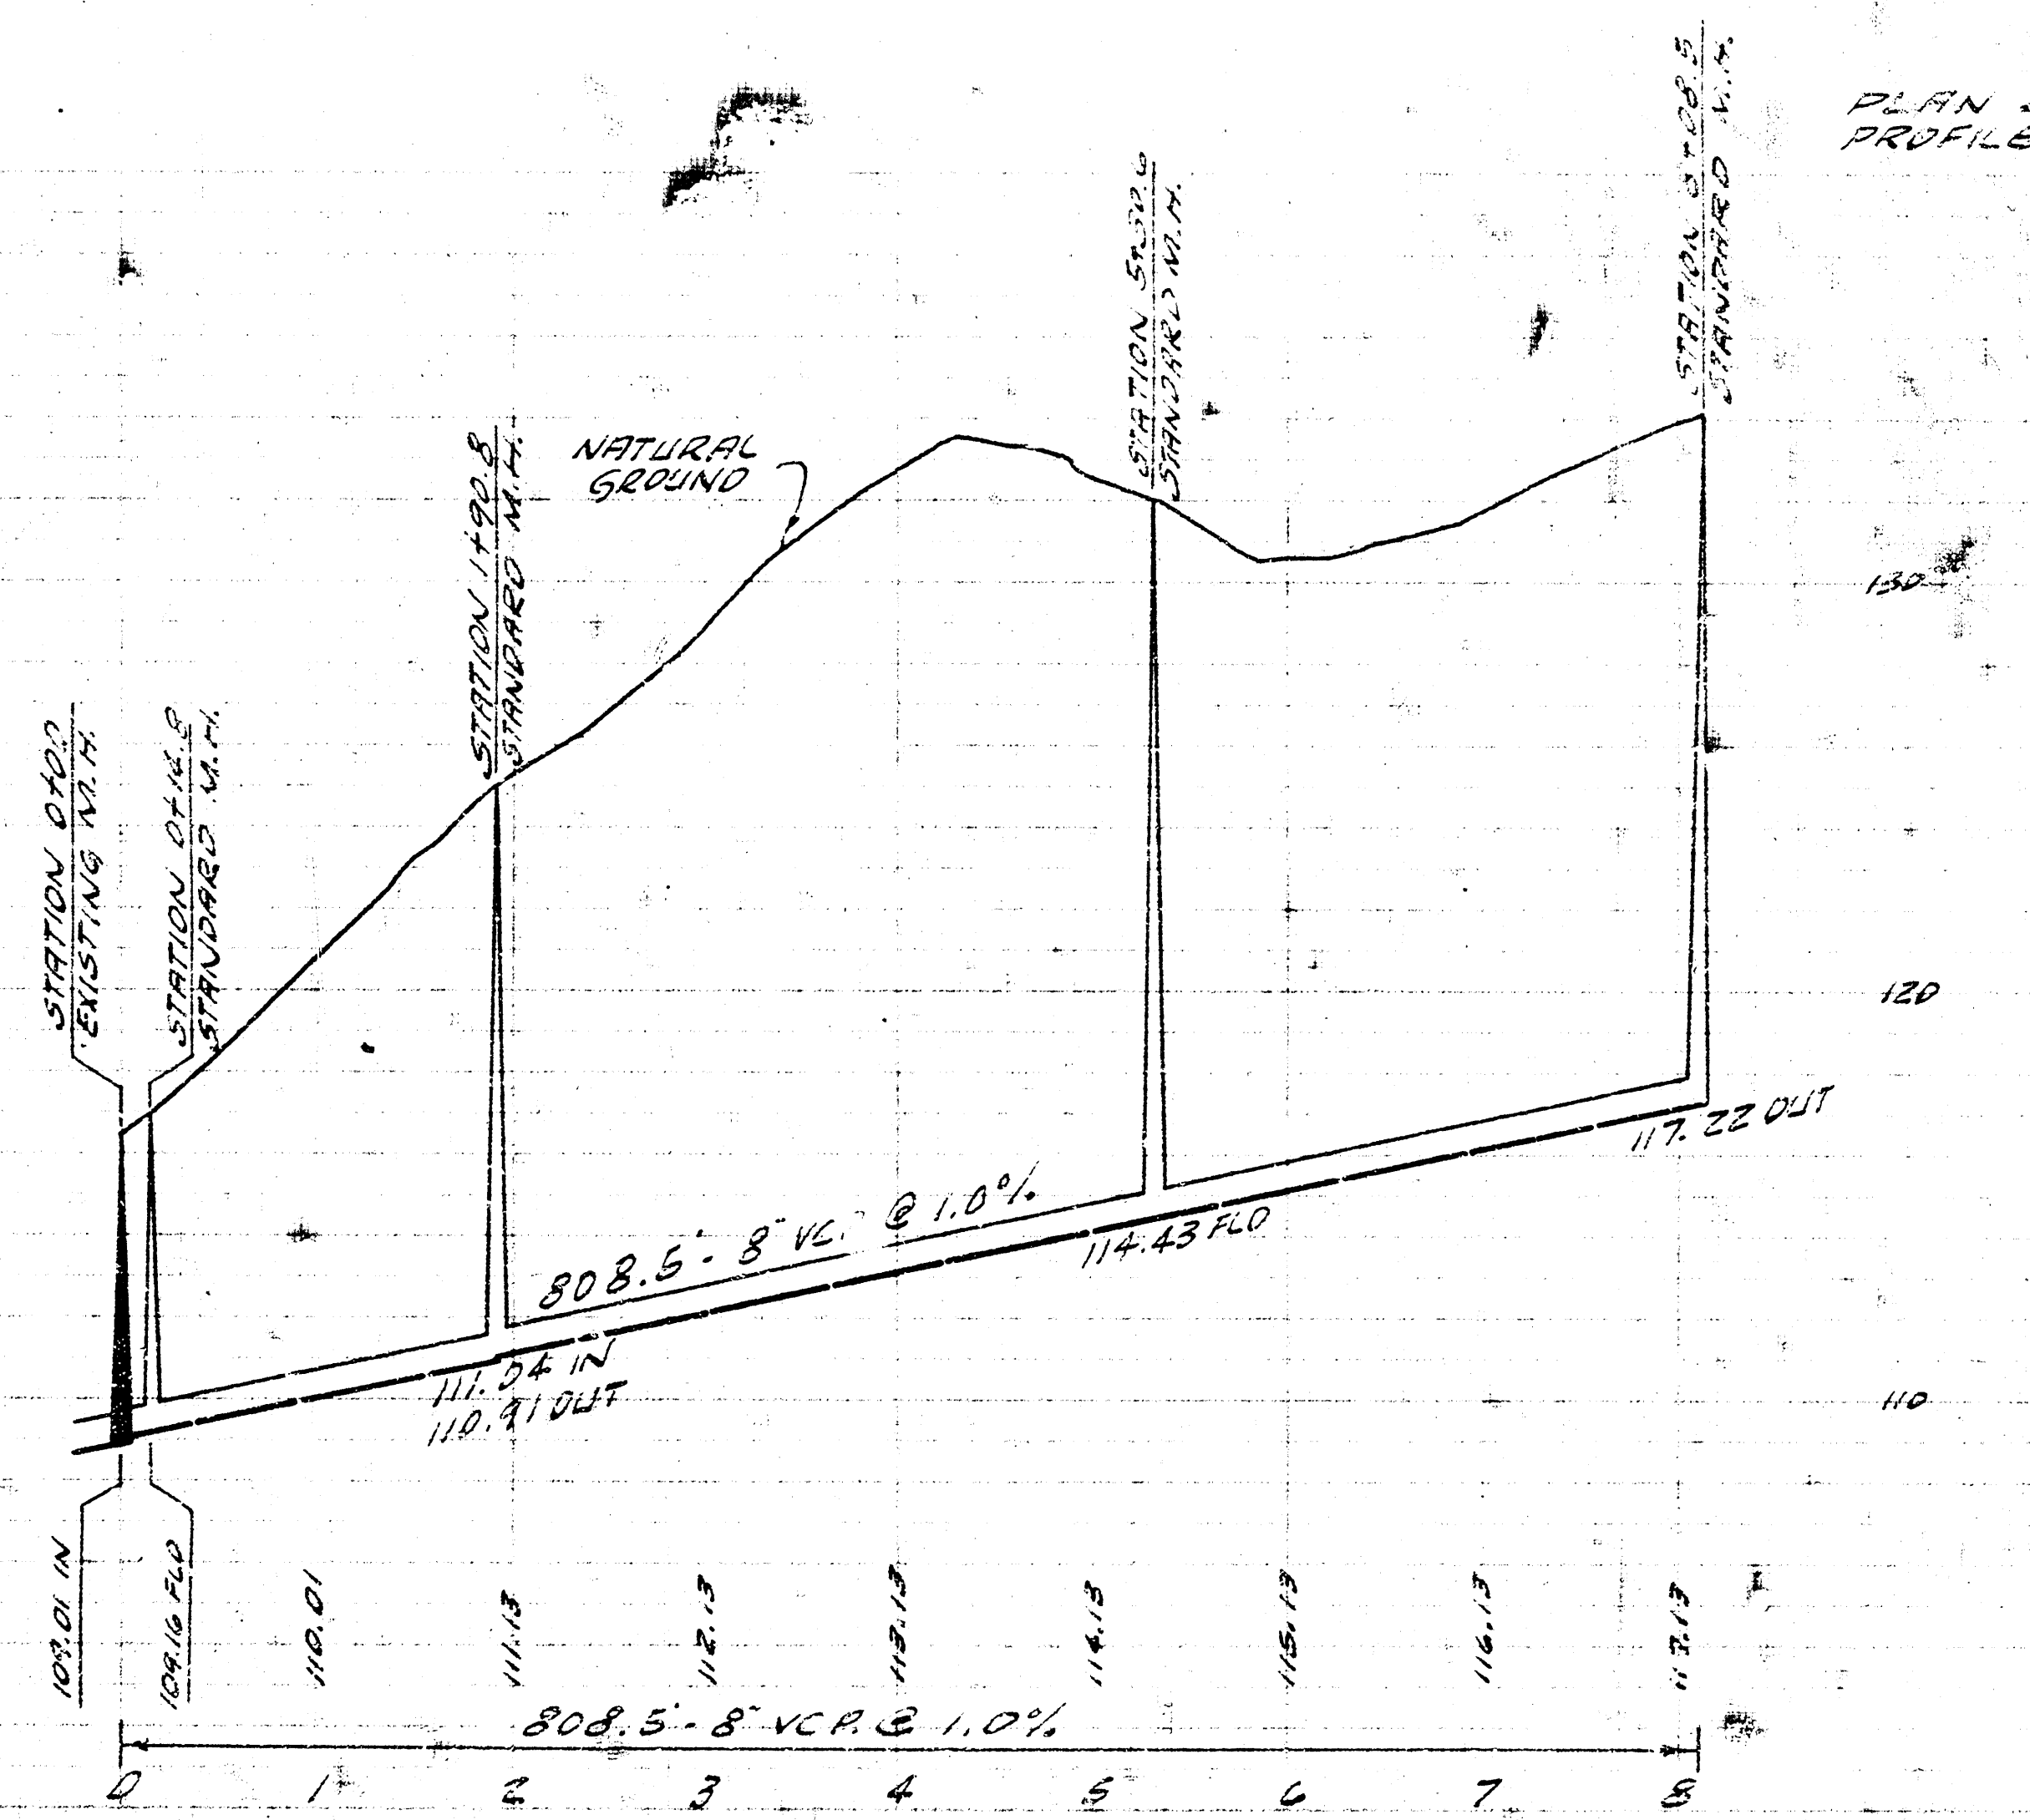

AS BUILT PLANS

ENT. OF LAT 16 SUB. 13 SAN. SEWER 22
 CITY OF WICHITA, KANSAS
 B.E. SMITH CITY ENGINEER
 PRIVATE JOB. MAY, 1960

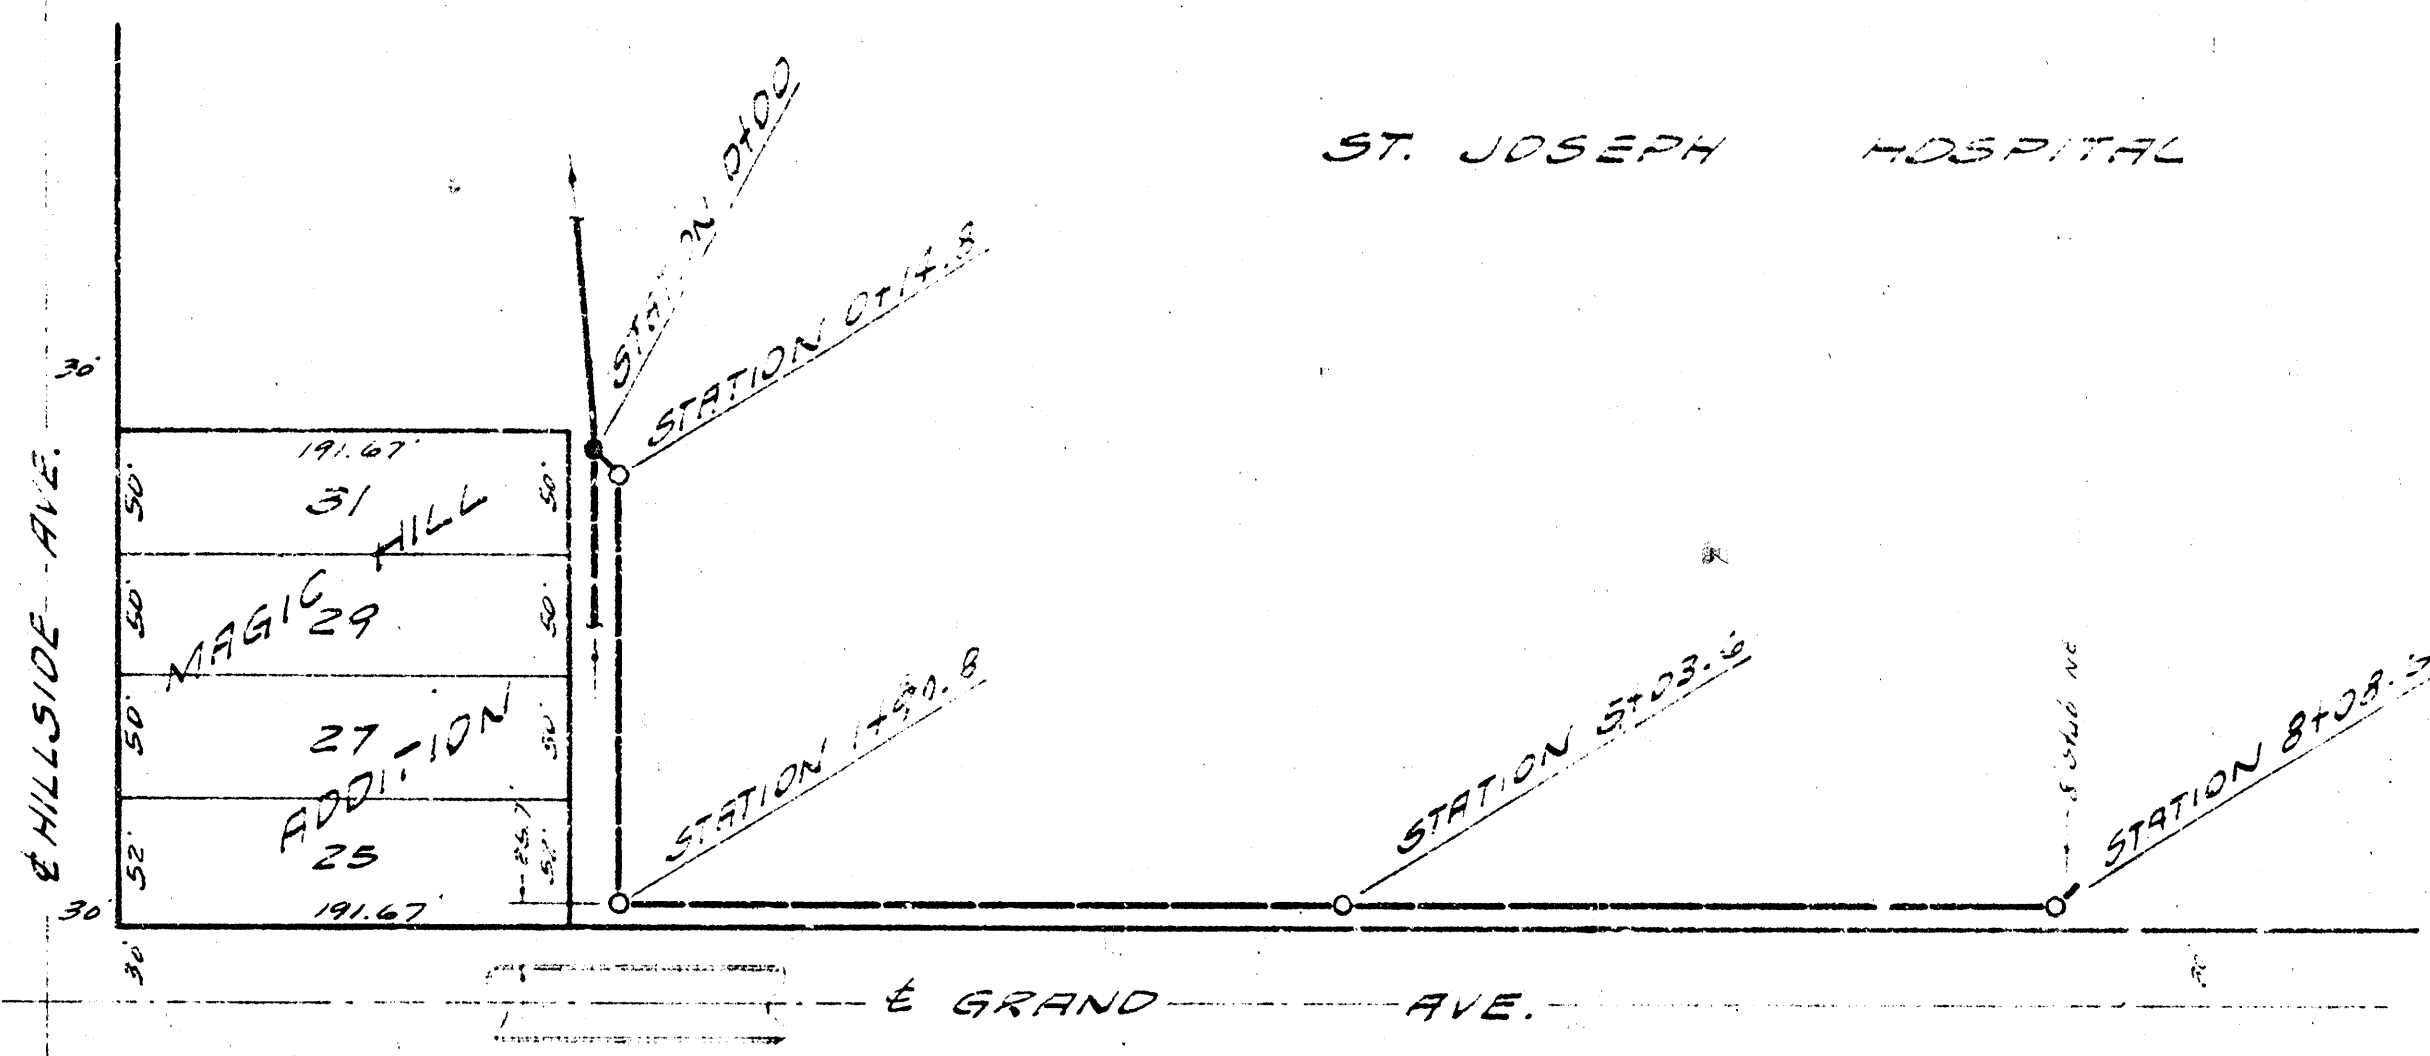

PRIVATE S.S. FOR ST. JOSEPH HOSPITAL
 CITY OF WICHITA, KANSAS
 B.E. SMITH CITY ENGINEER
 PRIVATE JOB. JUNE 1960