


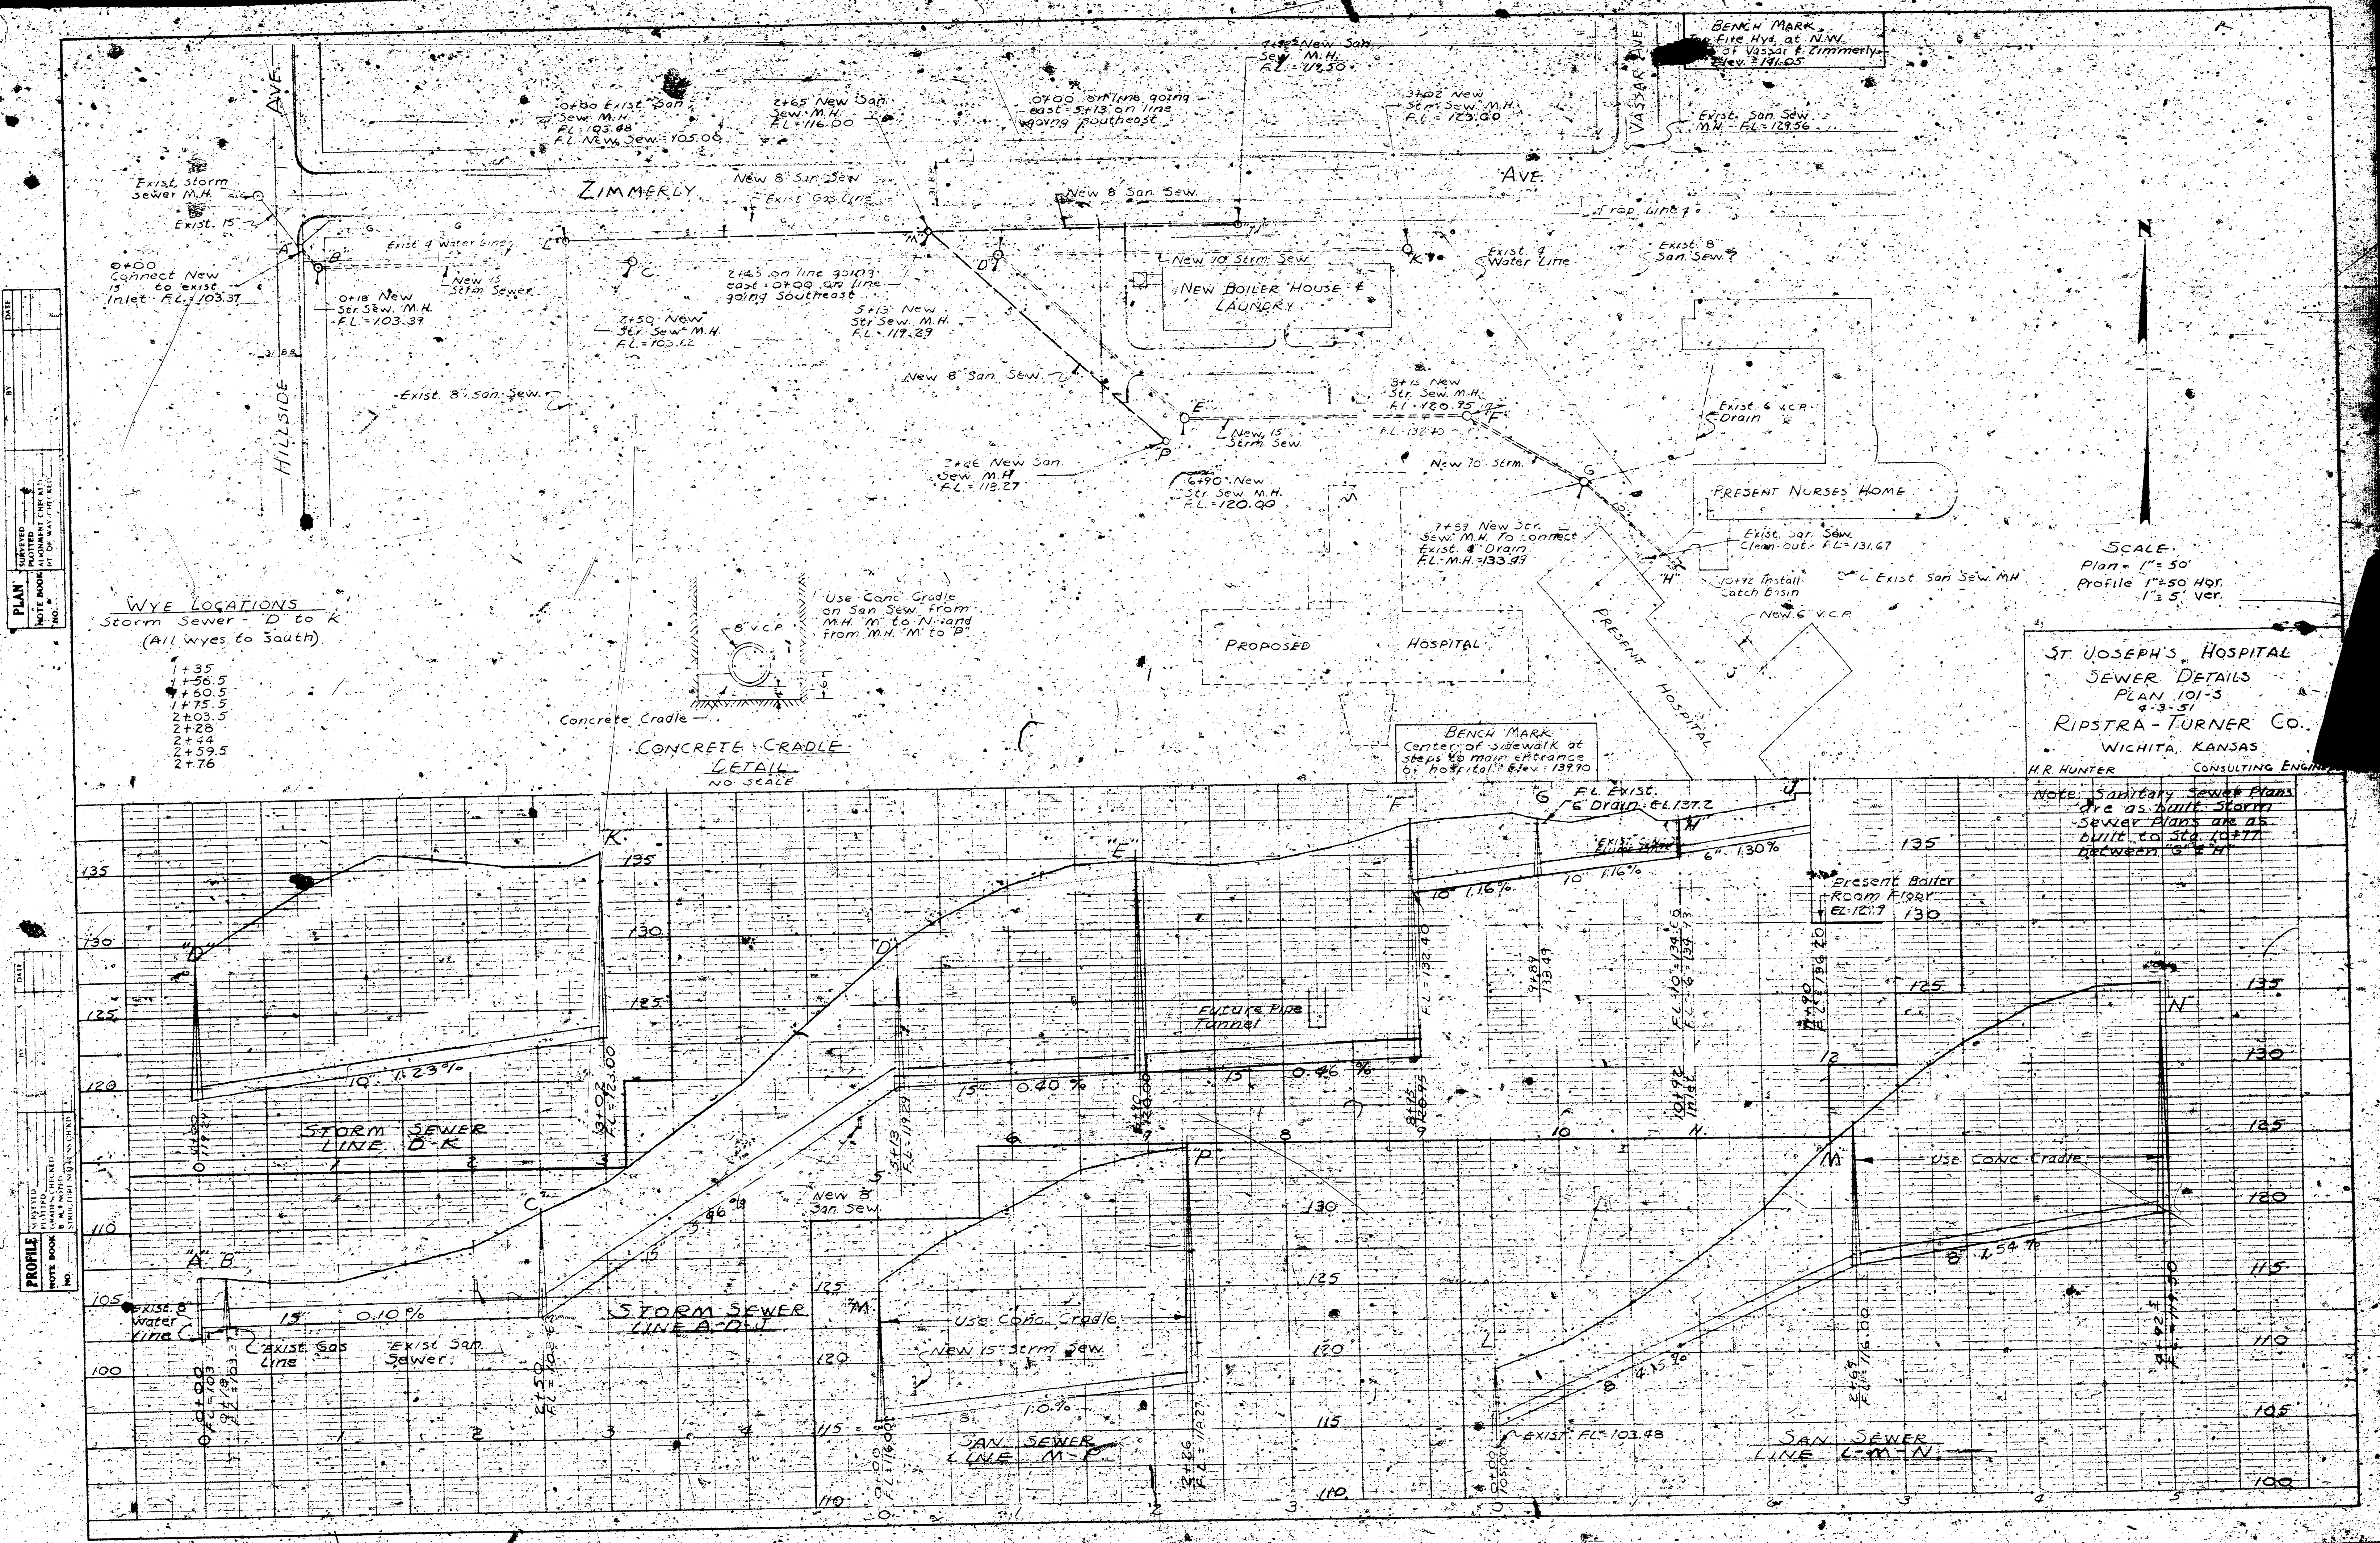

PLAN
NOTE BOOK
NO. 1

PROFILE
NOTE BOOK
NO. 2

ST JOSEPH'S HOSPITAL
SEWER DETAILS
PLAN 101-3
RIPSTRA-TURNER CO.
WICHITA, KANSAS
H. R. HUNTER CONSULTING ENGINEER

NOTE: Sanitary Sewer Plans are as built storm sewer plans as built to 34" to 42" between 6" & 8"

H. R. HUNTER
CONSULTING ENGINEER
P. O. BOX 1330 PHONE 4-8932
313 EAST THIRD STREET
WICHITA 2, KANSAS
May 4, 1951

City Engineer
City of Wichita
City Building
Wichita, Kansas
Dear Sir, Write:
We enclose herewith a print showing sewers as installed for St. Joseph Hospital.
Yours very truly,
H. R. HUNTER-CONSULTING ENGINEER
H. R. Hunter