


PLAN SURVEYED, PLOTTED, PRINTED, AND REPRODUCED BY THE ENGINEER. NOTE: WORK IS TO BE DONE IN ACCORDANCE WITH THE CITY OF WICHITA SPECIFICATIONS.



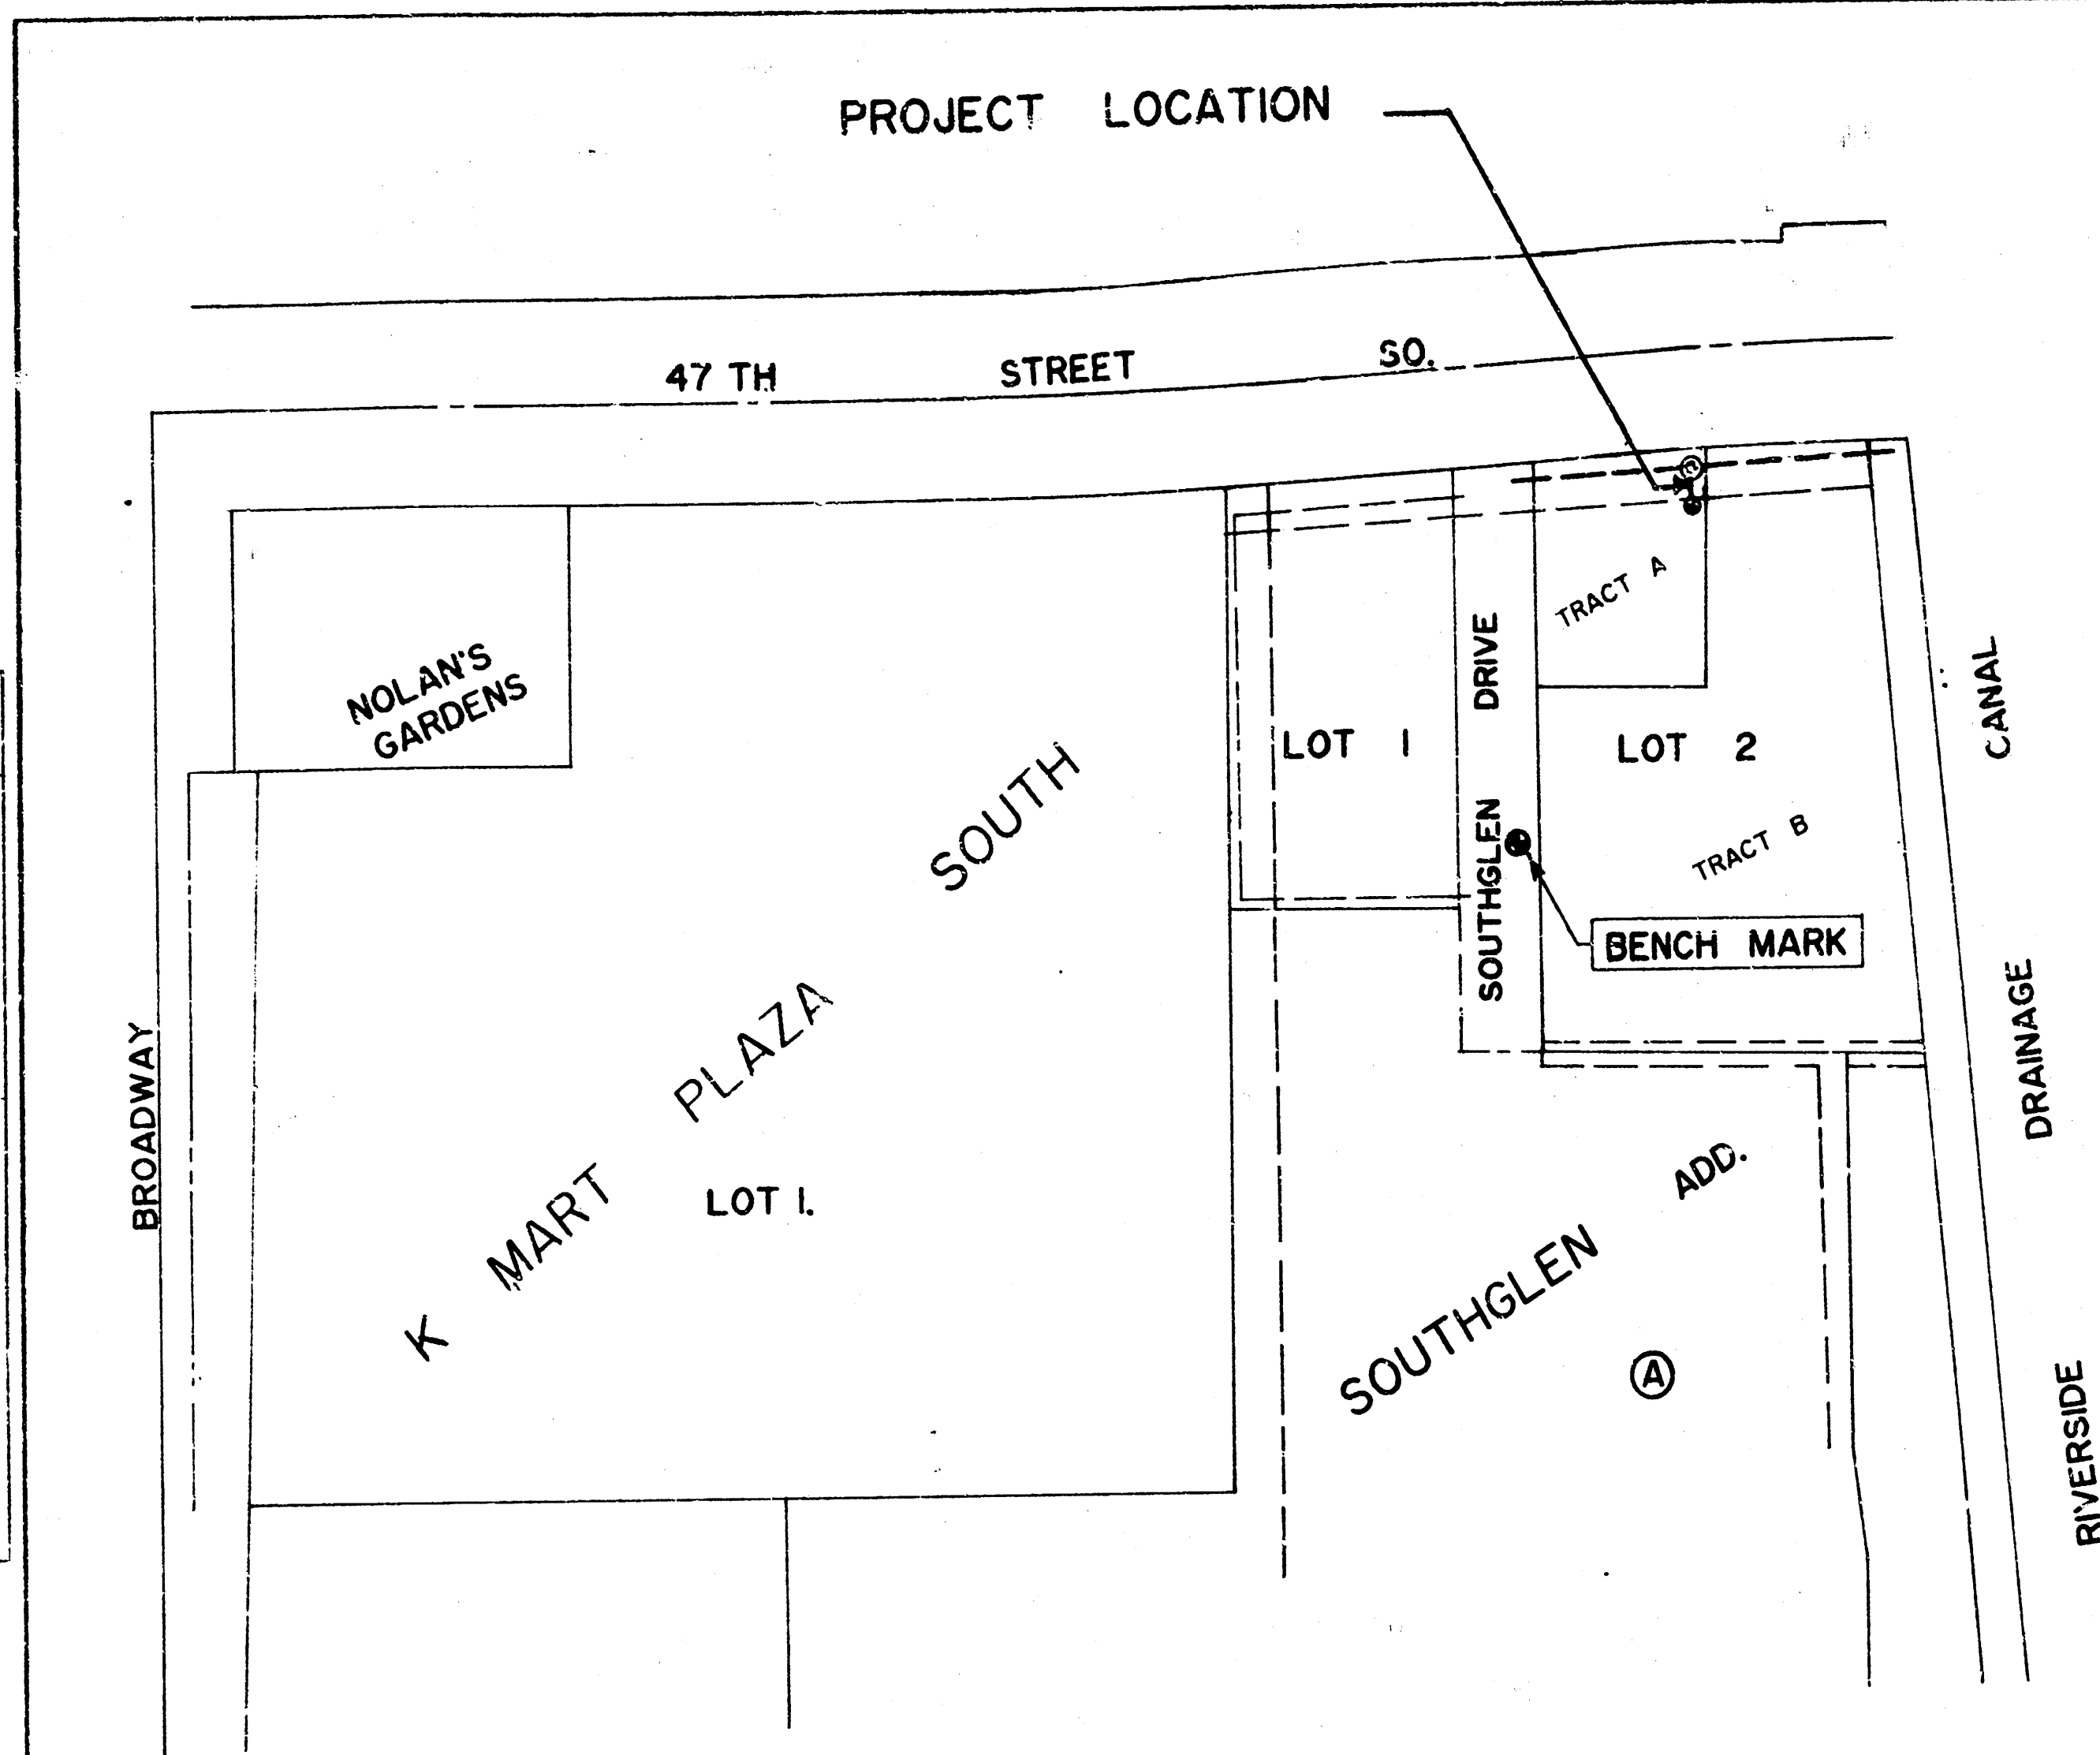


LOCATION MAP

SANITARY SEWER EXTENSION TO SERVE TRACT A, LOT 2, BLOCK A, SOUTHGLEN ADDITION WICHITA, KANSAS


PROECT NO.: 468 - 76 - 245 - 80001 - 000 - 000 - 173

- GENERAL NOTES:**
- Bench Mark: 'Q' cut on top of east curb; south end of paved road (Southglen Drive); Elev. = 83.27
 - All construction shall conform to City of Wichita, Kansas Standard Specifications.
 - Location of underground utilities including derby gasoline, as shown, are approximate. Contractor shall contact utility companies and verify the location and depth of all underground utilities.

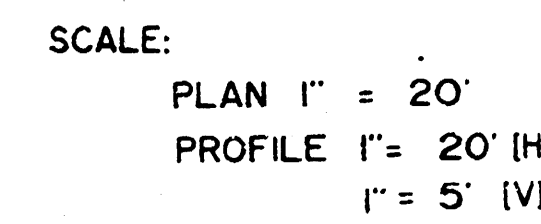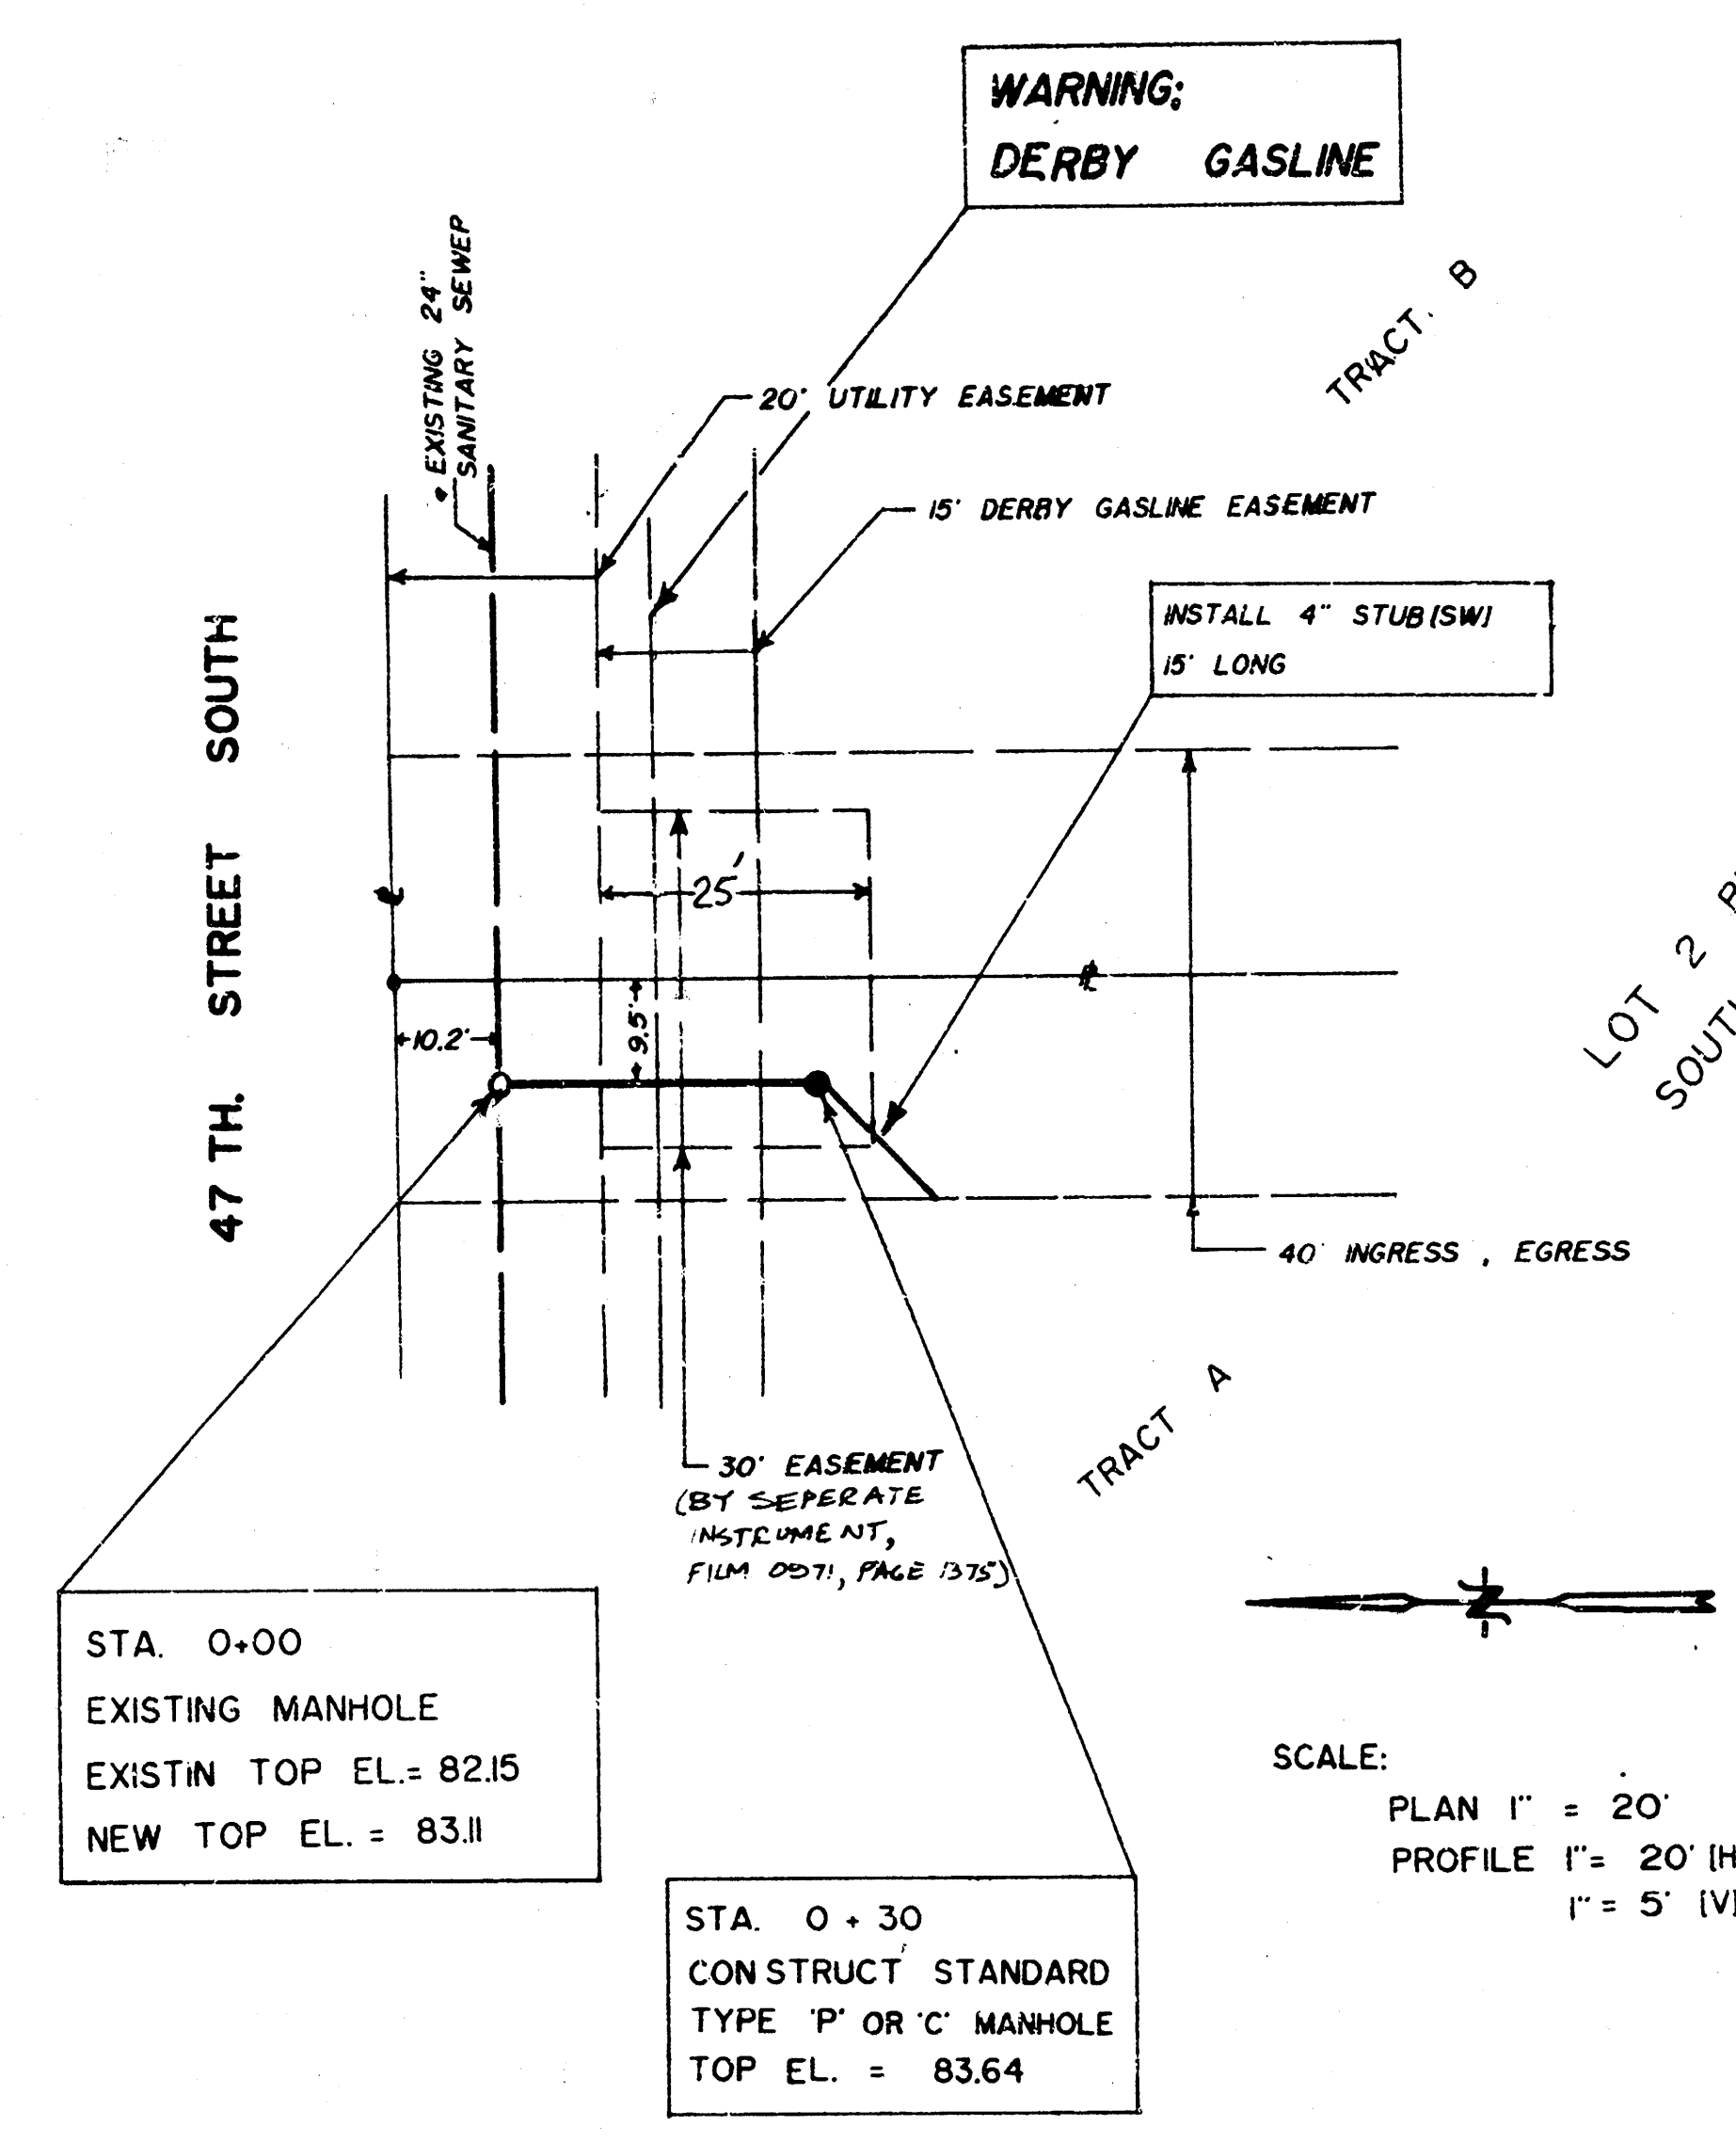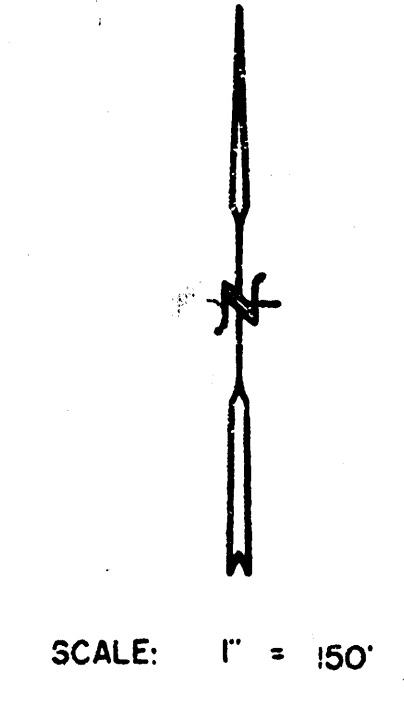

APPROVED AS NOTED BY CITY ENGINEER OF WICHITA
 City Engineer
 City Engineer
 City Engineer

NOTE TO CONTRACTOR
 THE CONTRACTOR SHALL VERIFY THE LOCATION AND DEPTH OF ALL UNDERGROUND UTILITIES.

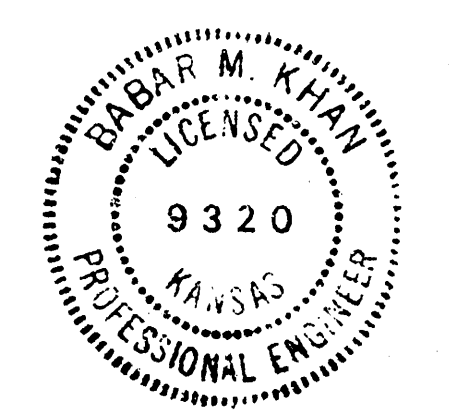

BOOKED

PROFILE SURVEYED, PLOTTED, PRINTED, AND REPRODUCED BY THE ENGINEER. NOTE: WORK IS TO BE DONE IN ACCORDANCE WITH THE CITY OF WICHITA SPECIFICATIONS.

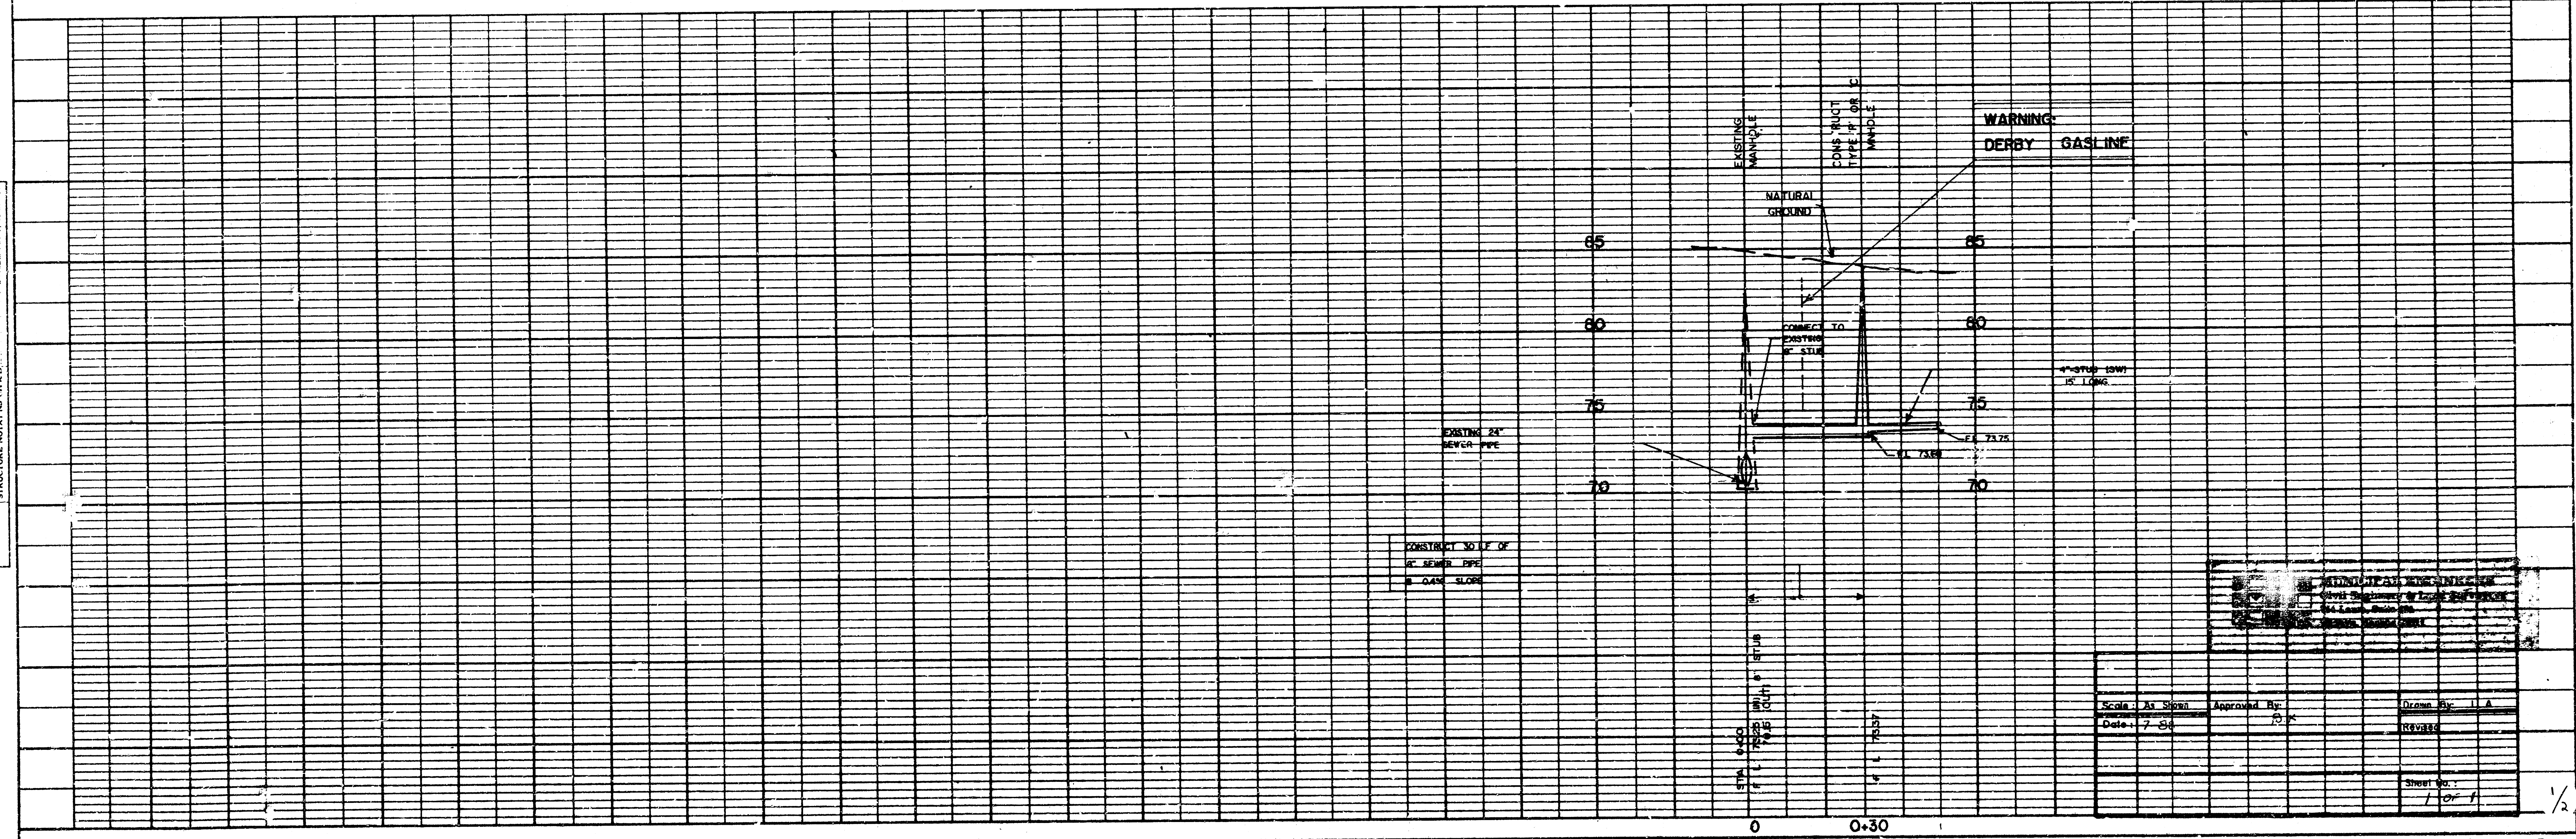


PLATE 1 - PLAN - PROFILE - S.S. CLEARPRINT PAPER CO. S. F. CAL. NO. 1000-1


Scale: As Shown	Approved By: [Signature]	Drawn By: [Signature]
Date: 7-54	Checked: [Signature]	Revised: [Signature]
Sheet No.: 1 of 1		

at 10 3 14

FILMED FROM THE BEST AVAILABLE COPY....

DATE: _____ BY: _____
 PLAN: DRAWING CHECKED: _____
 NOTE BOOK: ALIGNMENT CHECKED: _____
 NO. _____ RT. OF WAY CHECKED: _____
 NO. _____

DATE: _____ BY: _____
 PROFILE: SURVEYED: _____
 NOTE BOOK: GRADES CHECKED: _____
 NO. _____ STRUCTURE NOTATIONS CHECKED: _____
 NO. _____

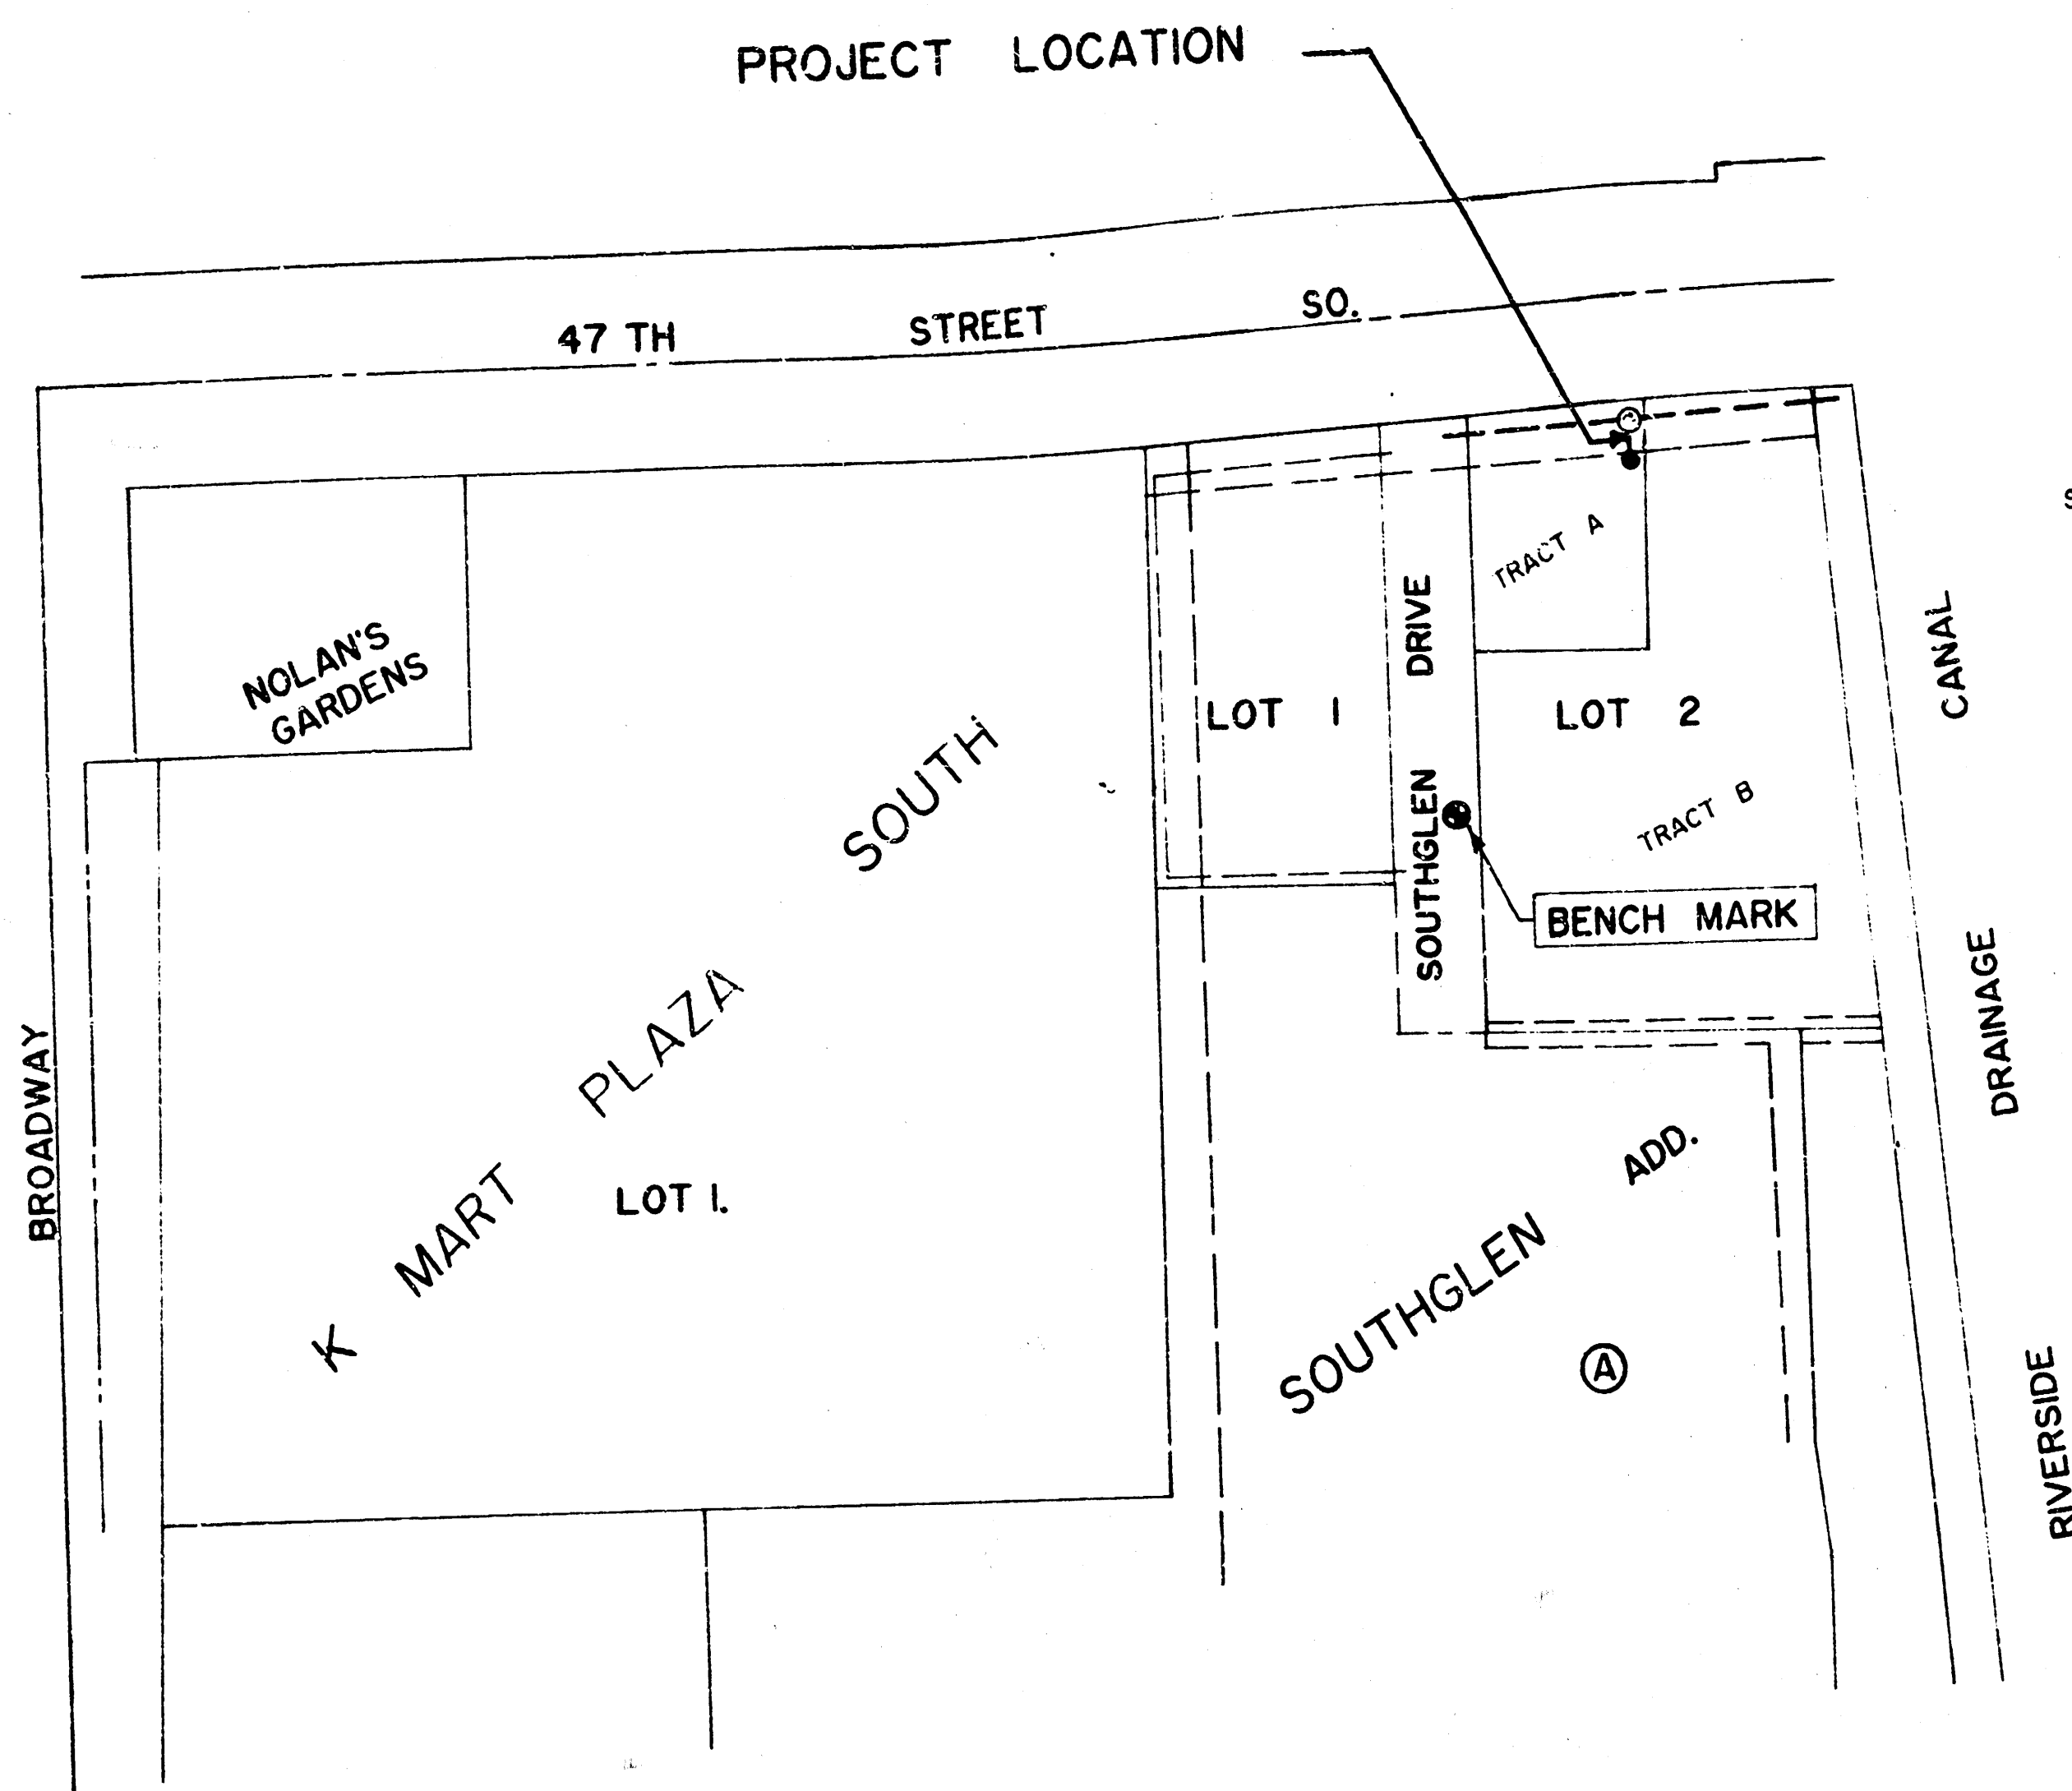

LOCATION MAP



SANITARY SEWER EXTENSION
 TO SERVE
 TRACT A, LOT 2, BLOCK A,
 SOUTHGLEN ADDITION
 WICHITA, KANSAS

SCALE: 1" = 150'


PROECT NO.: 468 - 76 - 245 - 80001 - 000 - 000 - 173

GENERAL NOTES:

1. Bench Mark: 'g' cut on top of east curb; south end of paved road (Southglen Drive); Elev. = 83.27
2. All construction shall conform to City of Wichita, Kansas Standard Specifications.
3. Location of underground utilities including derby gasline, as shown, are approximate. Contractor shall contact utility companies and verify the location and depth of all underground utilities.

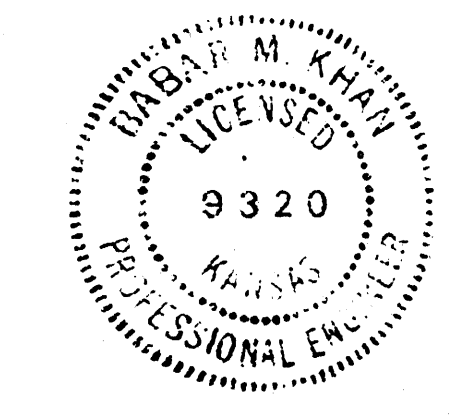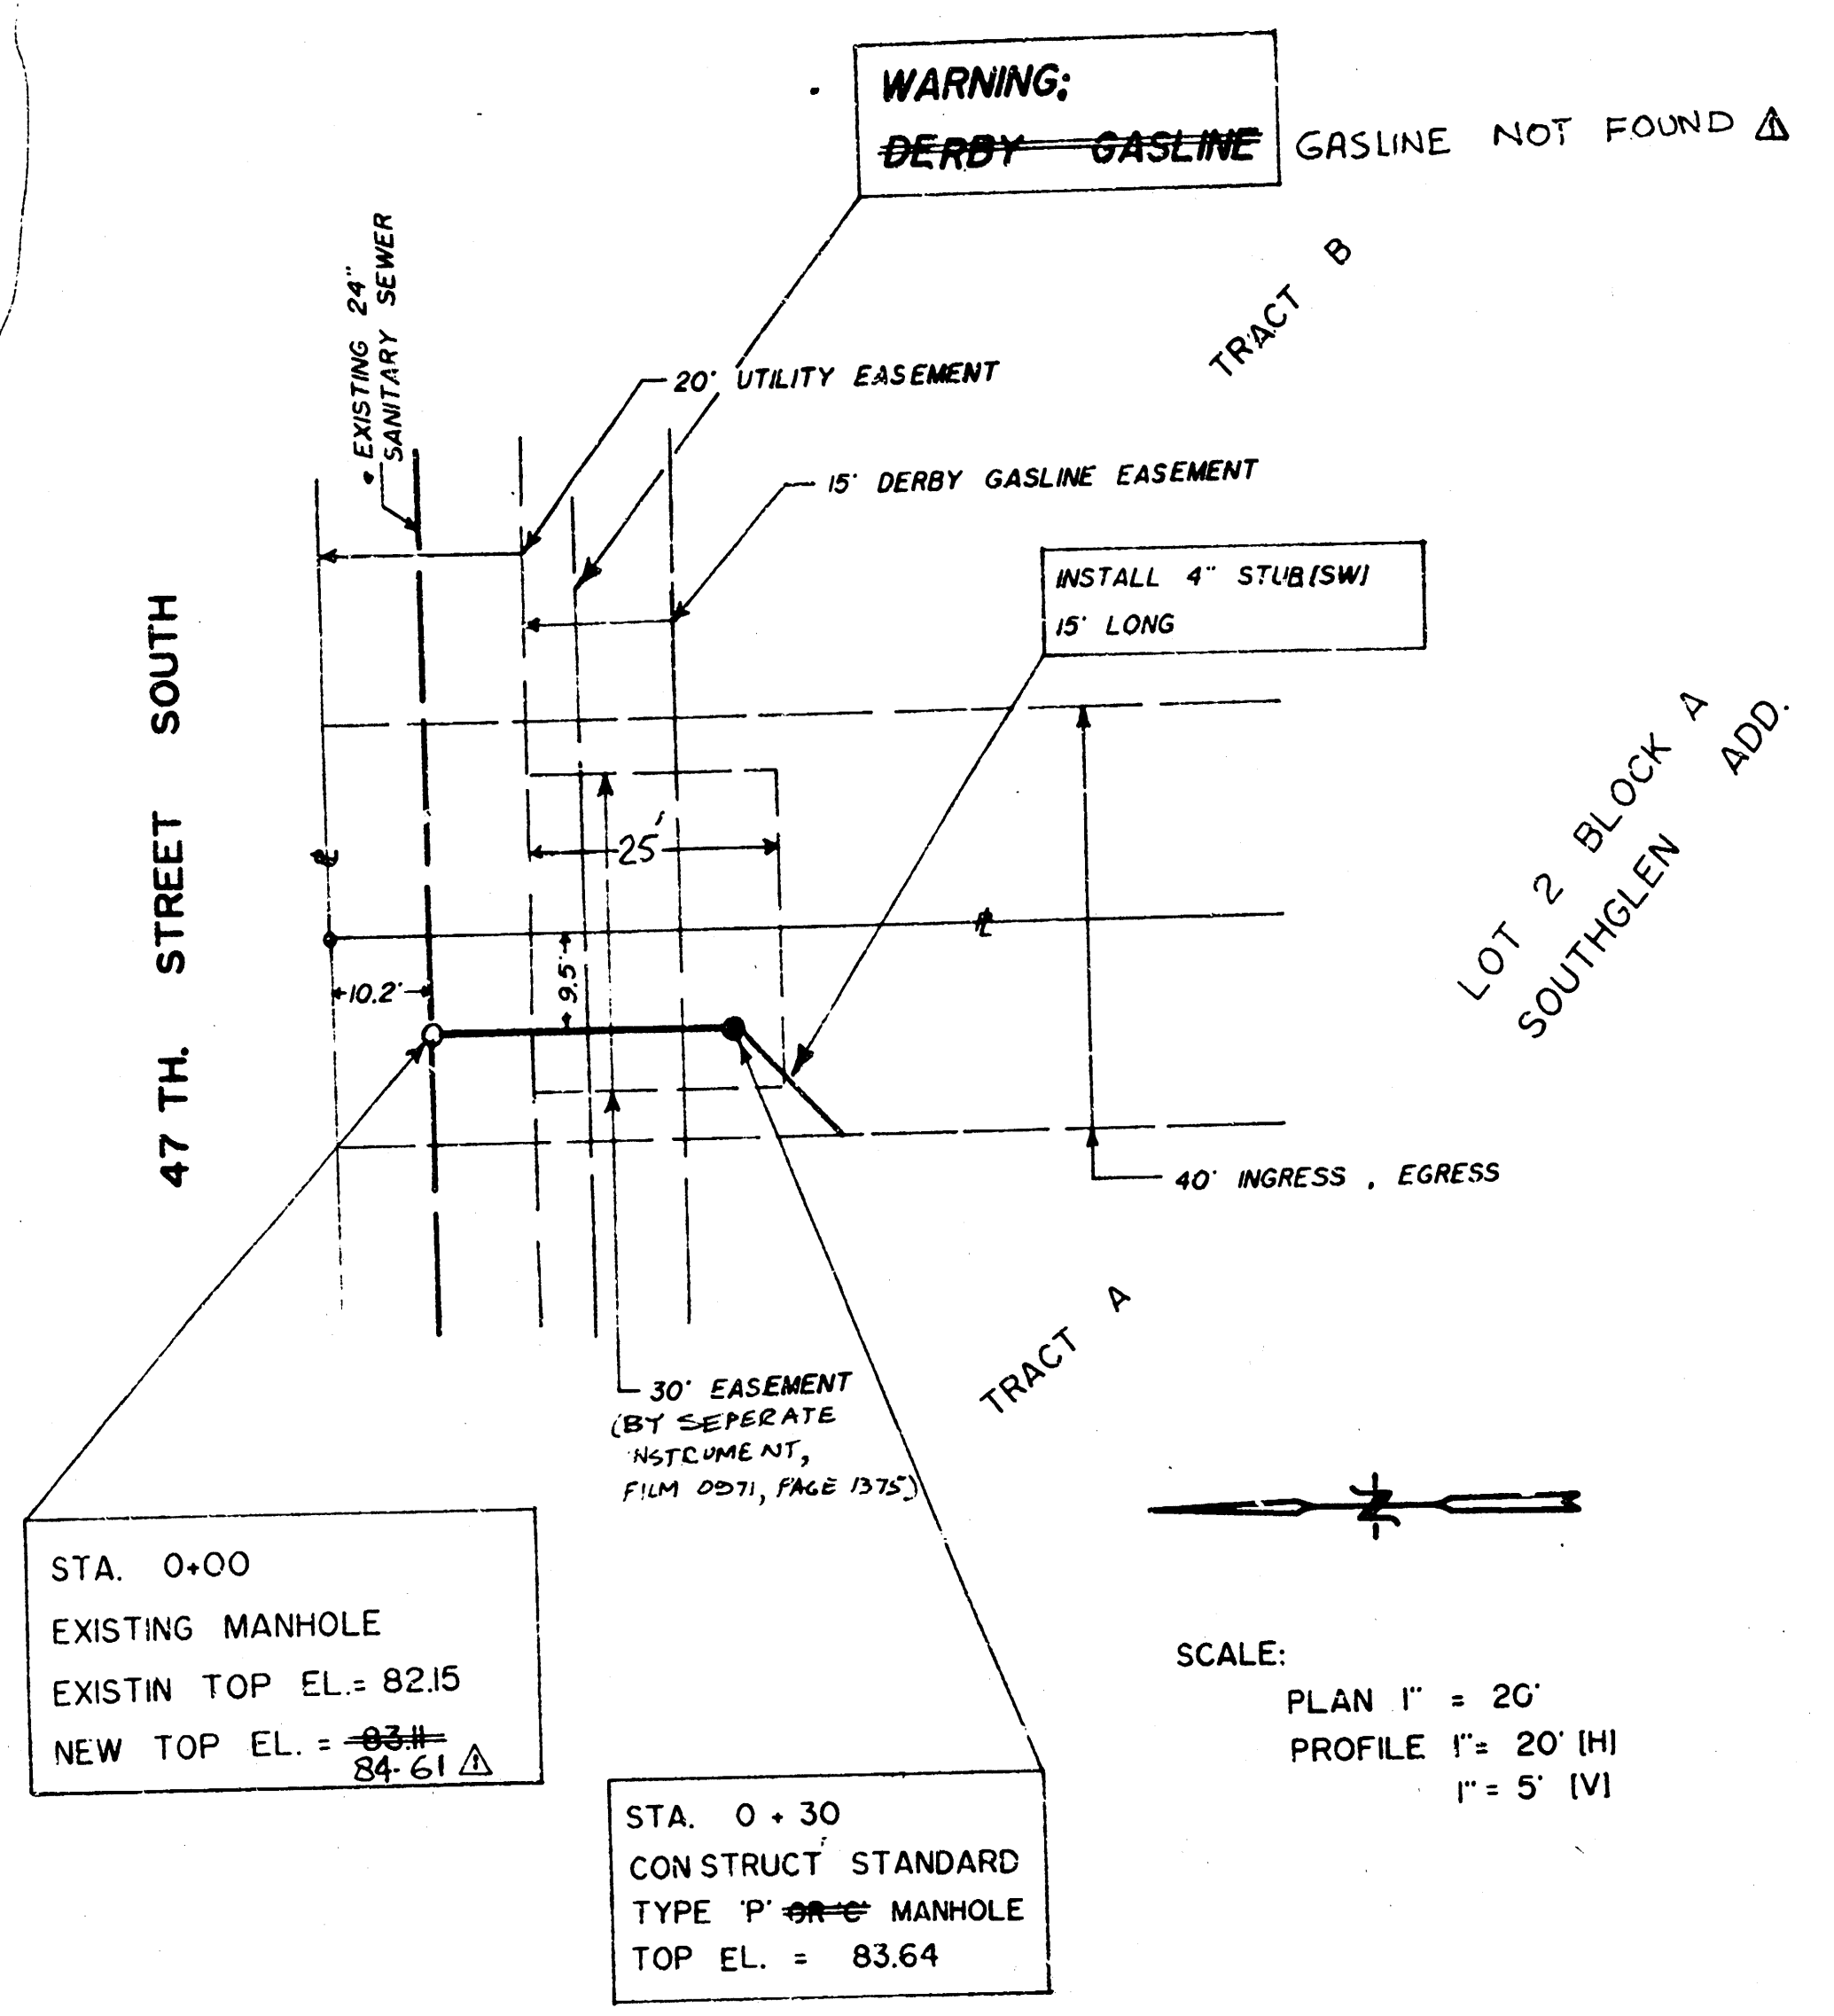

Δ AS-BUILT

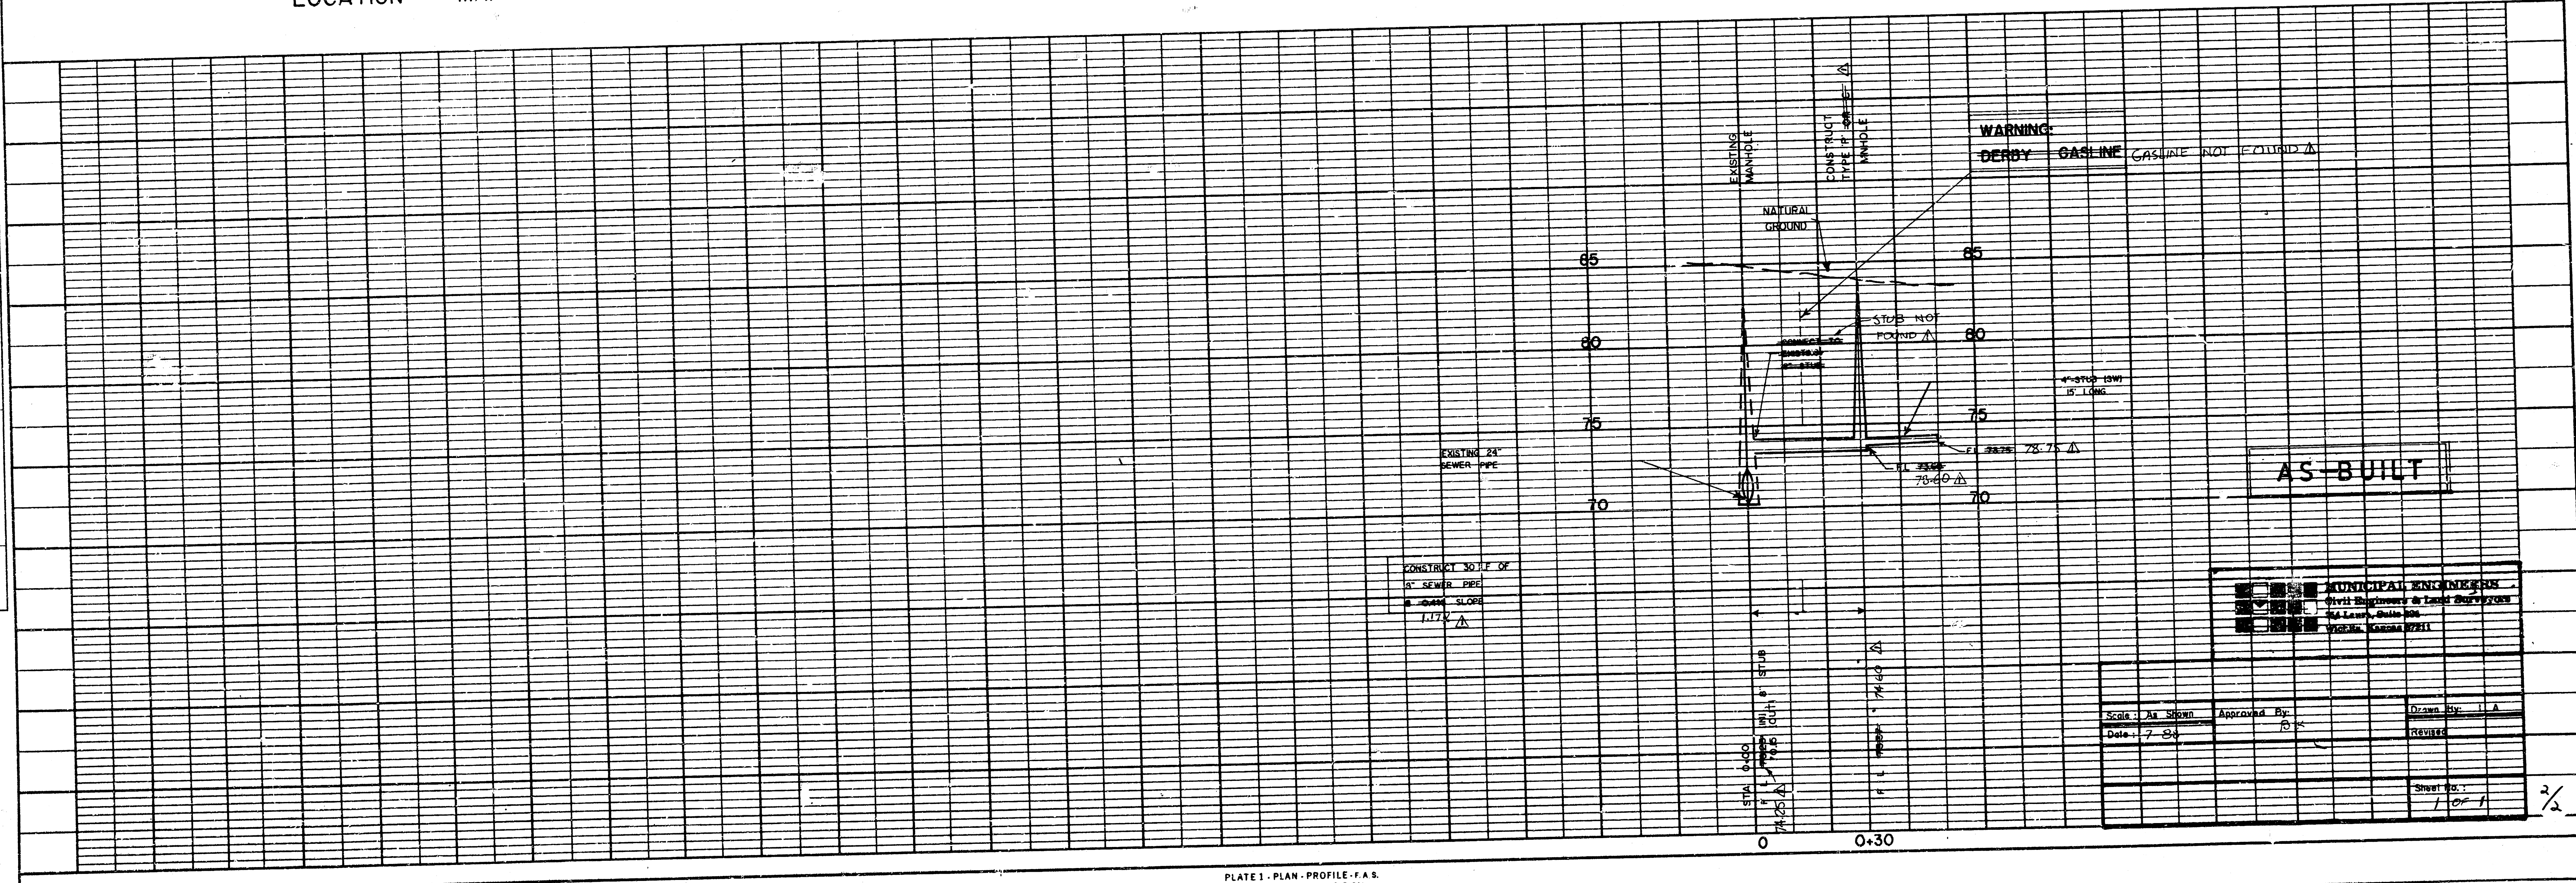

FILMED FROM THE BEST AVAILABLE COPY