




STANDARD MANHOLE  
TYPE "A"  
\* 4' ON 5' DIA. M.H.

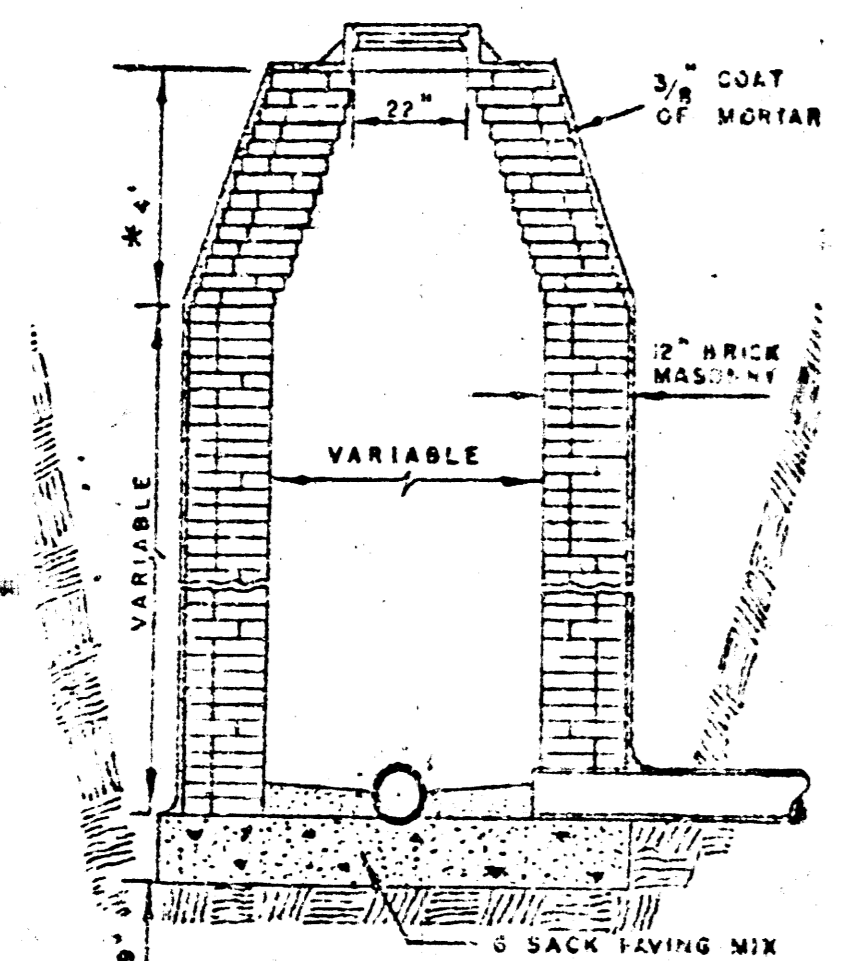

STANDARD MANHOLE  
TYPE "B"

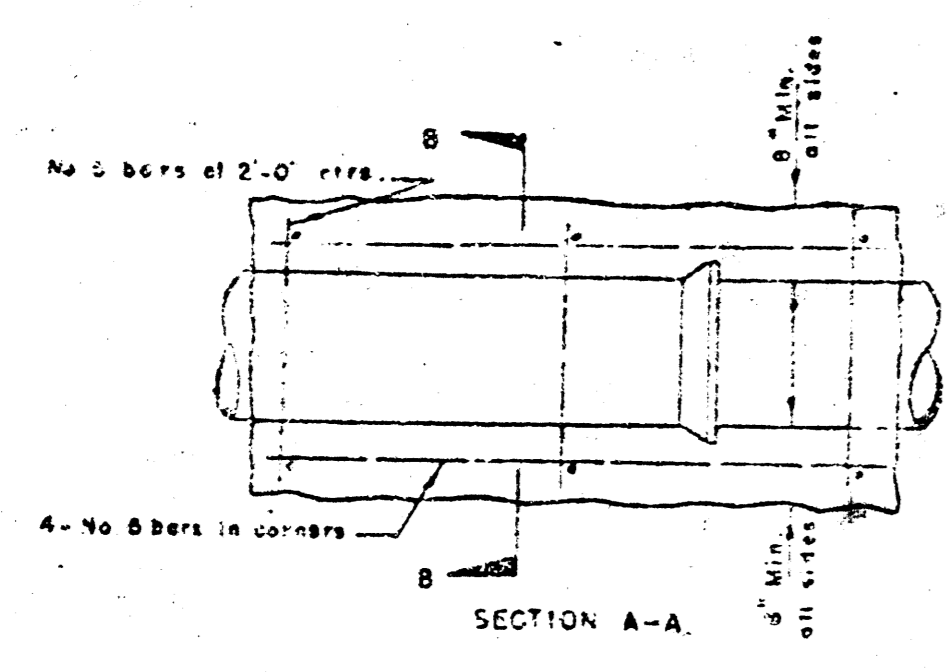


SECTION A-A

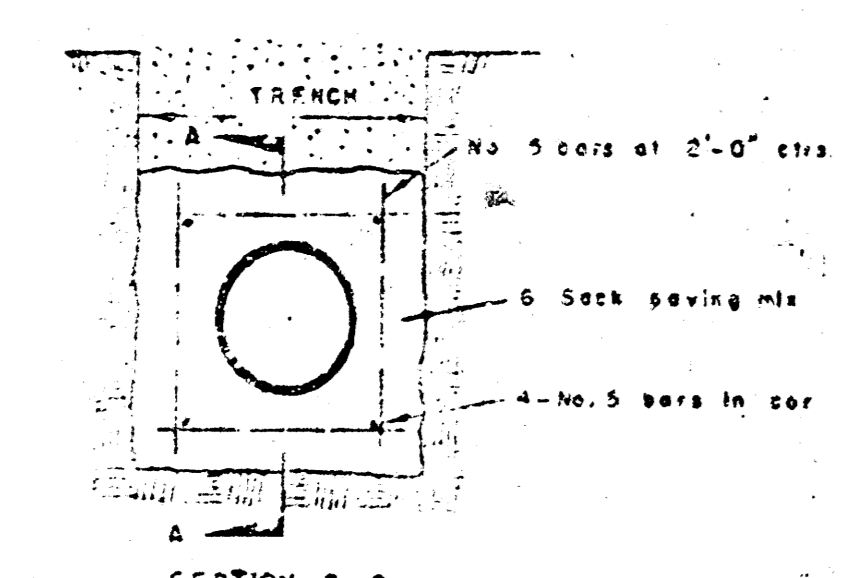

SECTION B-B

REINFORCED CONCRETE ENCASEMENT

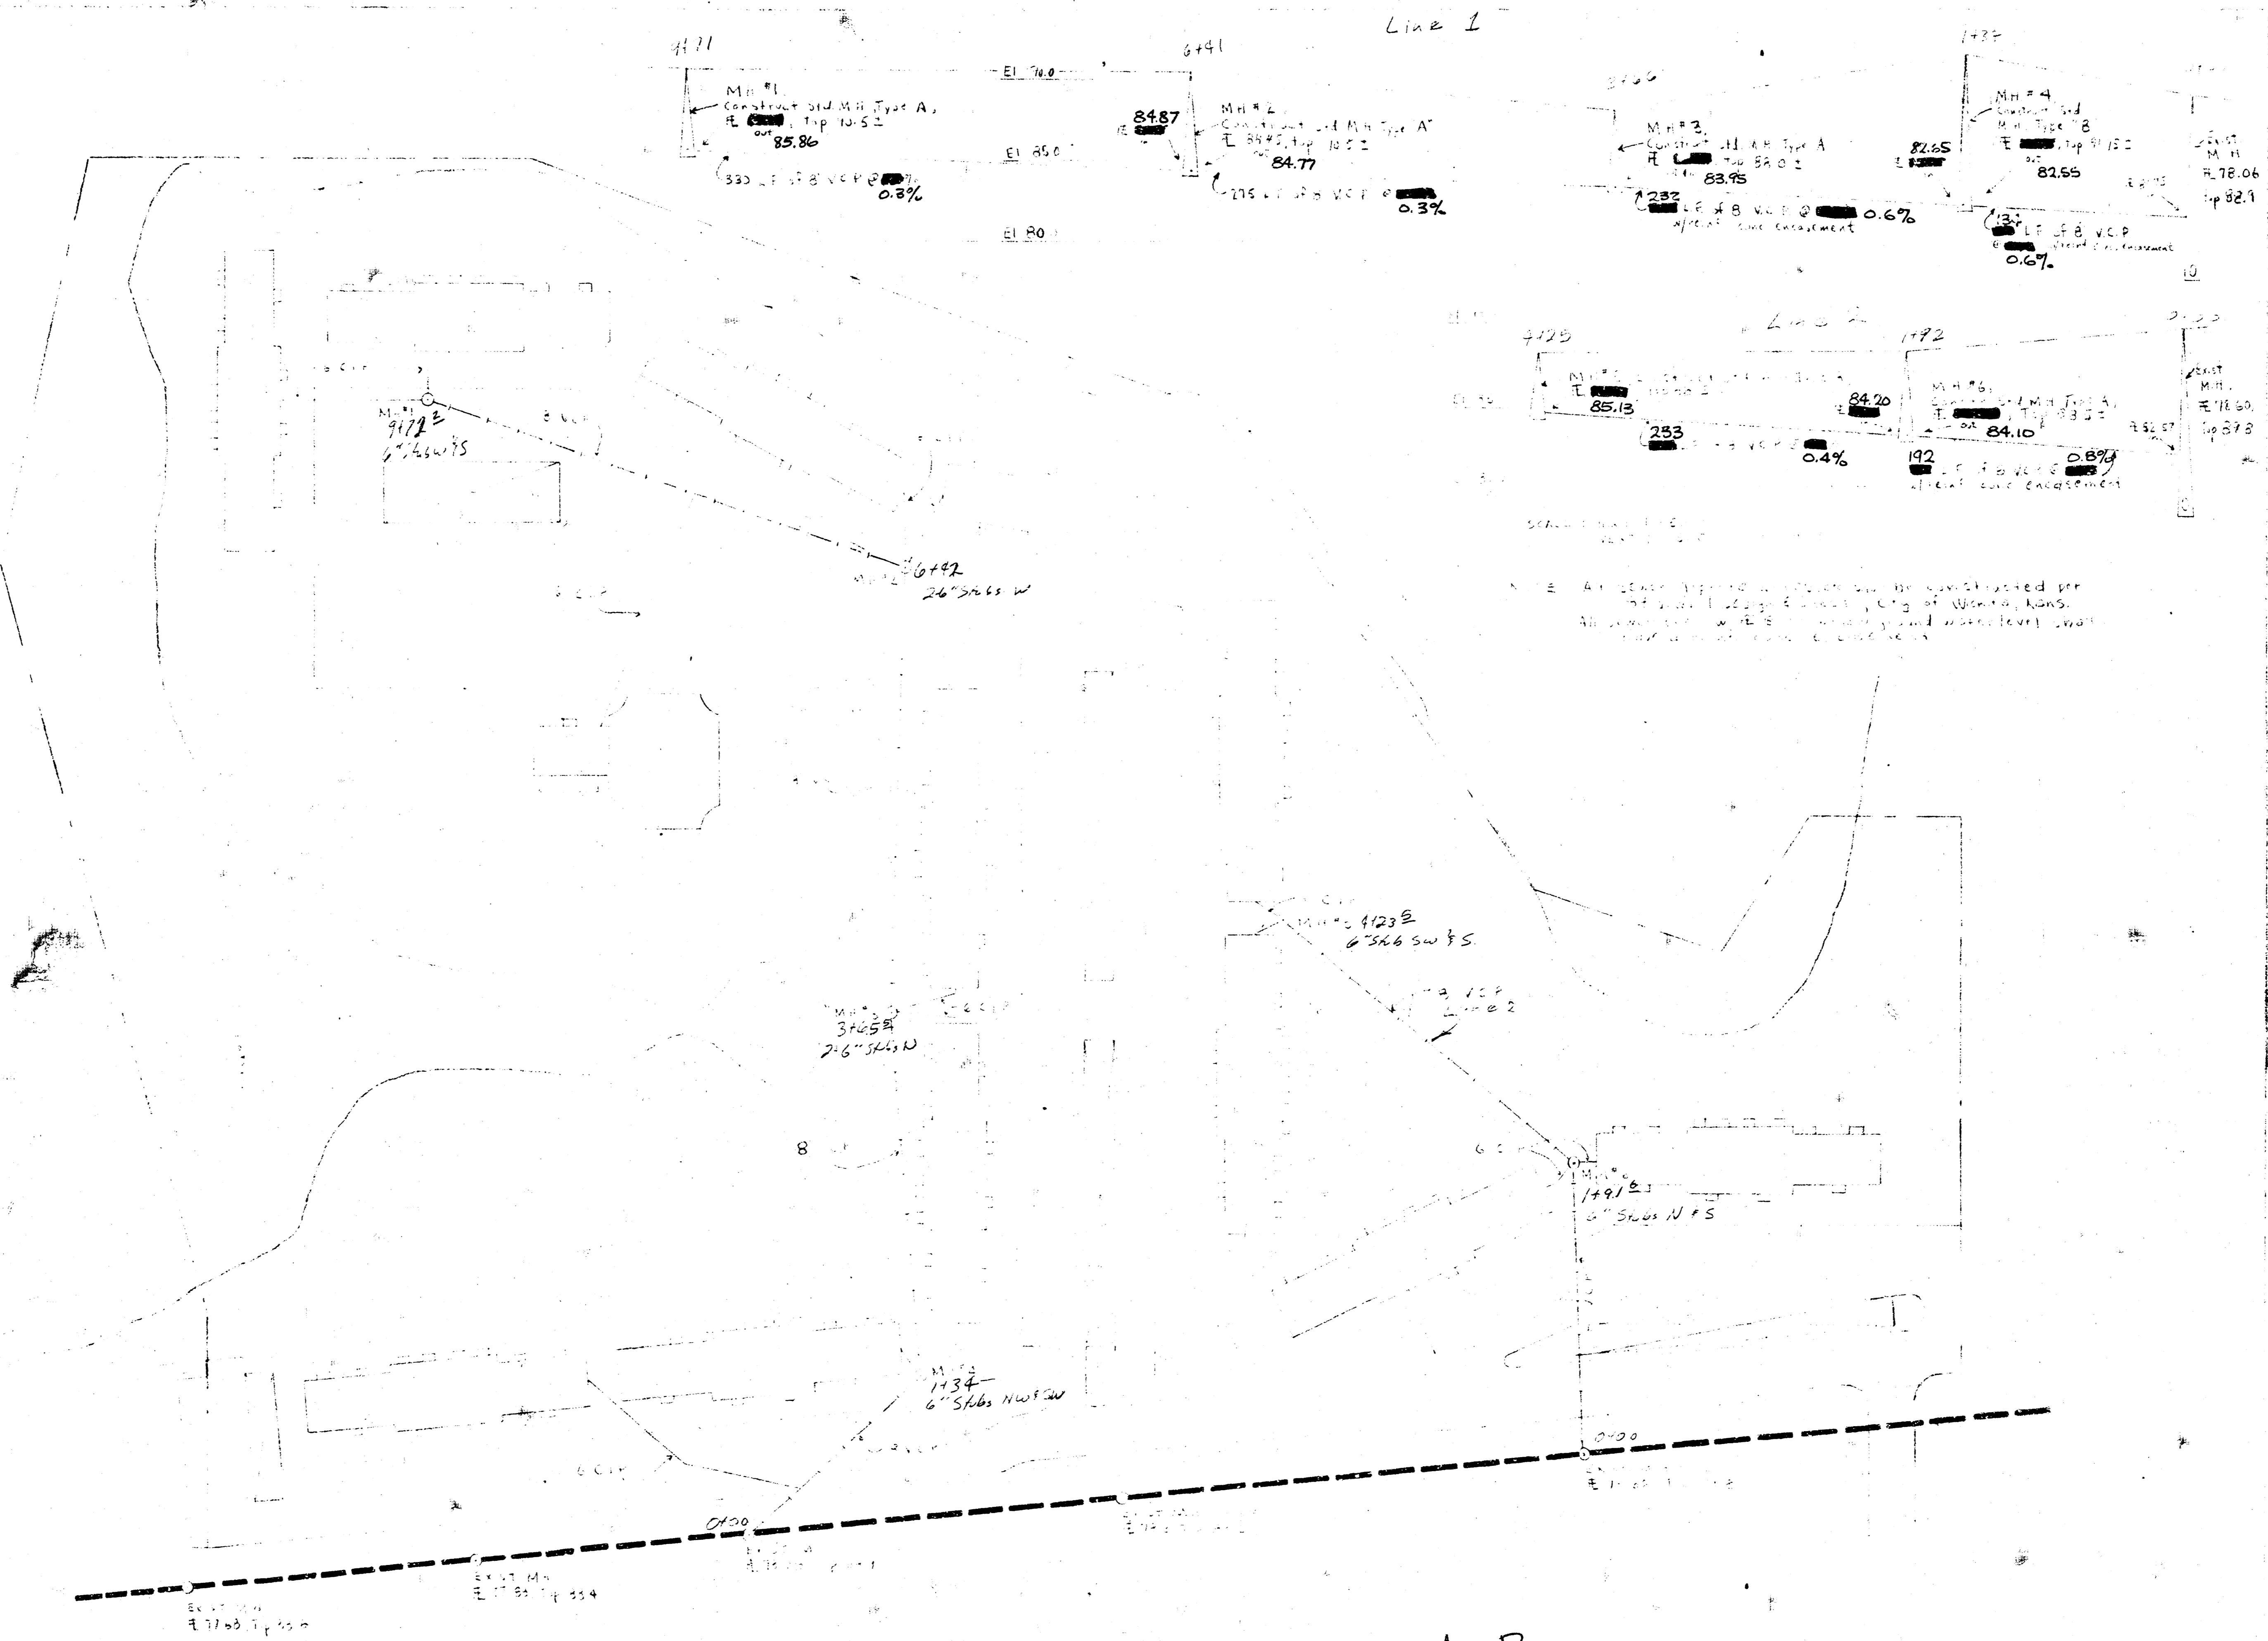

As Built

UTILITY PLAN  
Scale 1" = 30'

Final Meet. 31.55 JK #4  
SOUTHLAKE VILLAGE  
BHEB50355  
DICK BRABINAM ARCH. IS  
12/2/73