


## REINFORCED CONCRETE ENCASEMENT

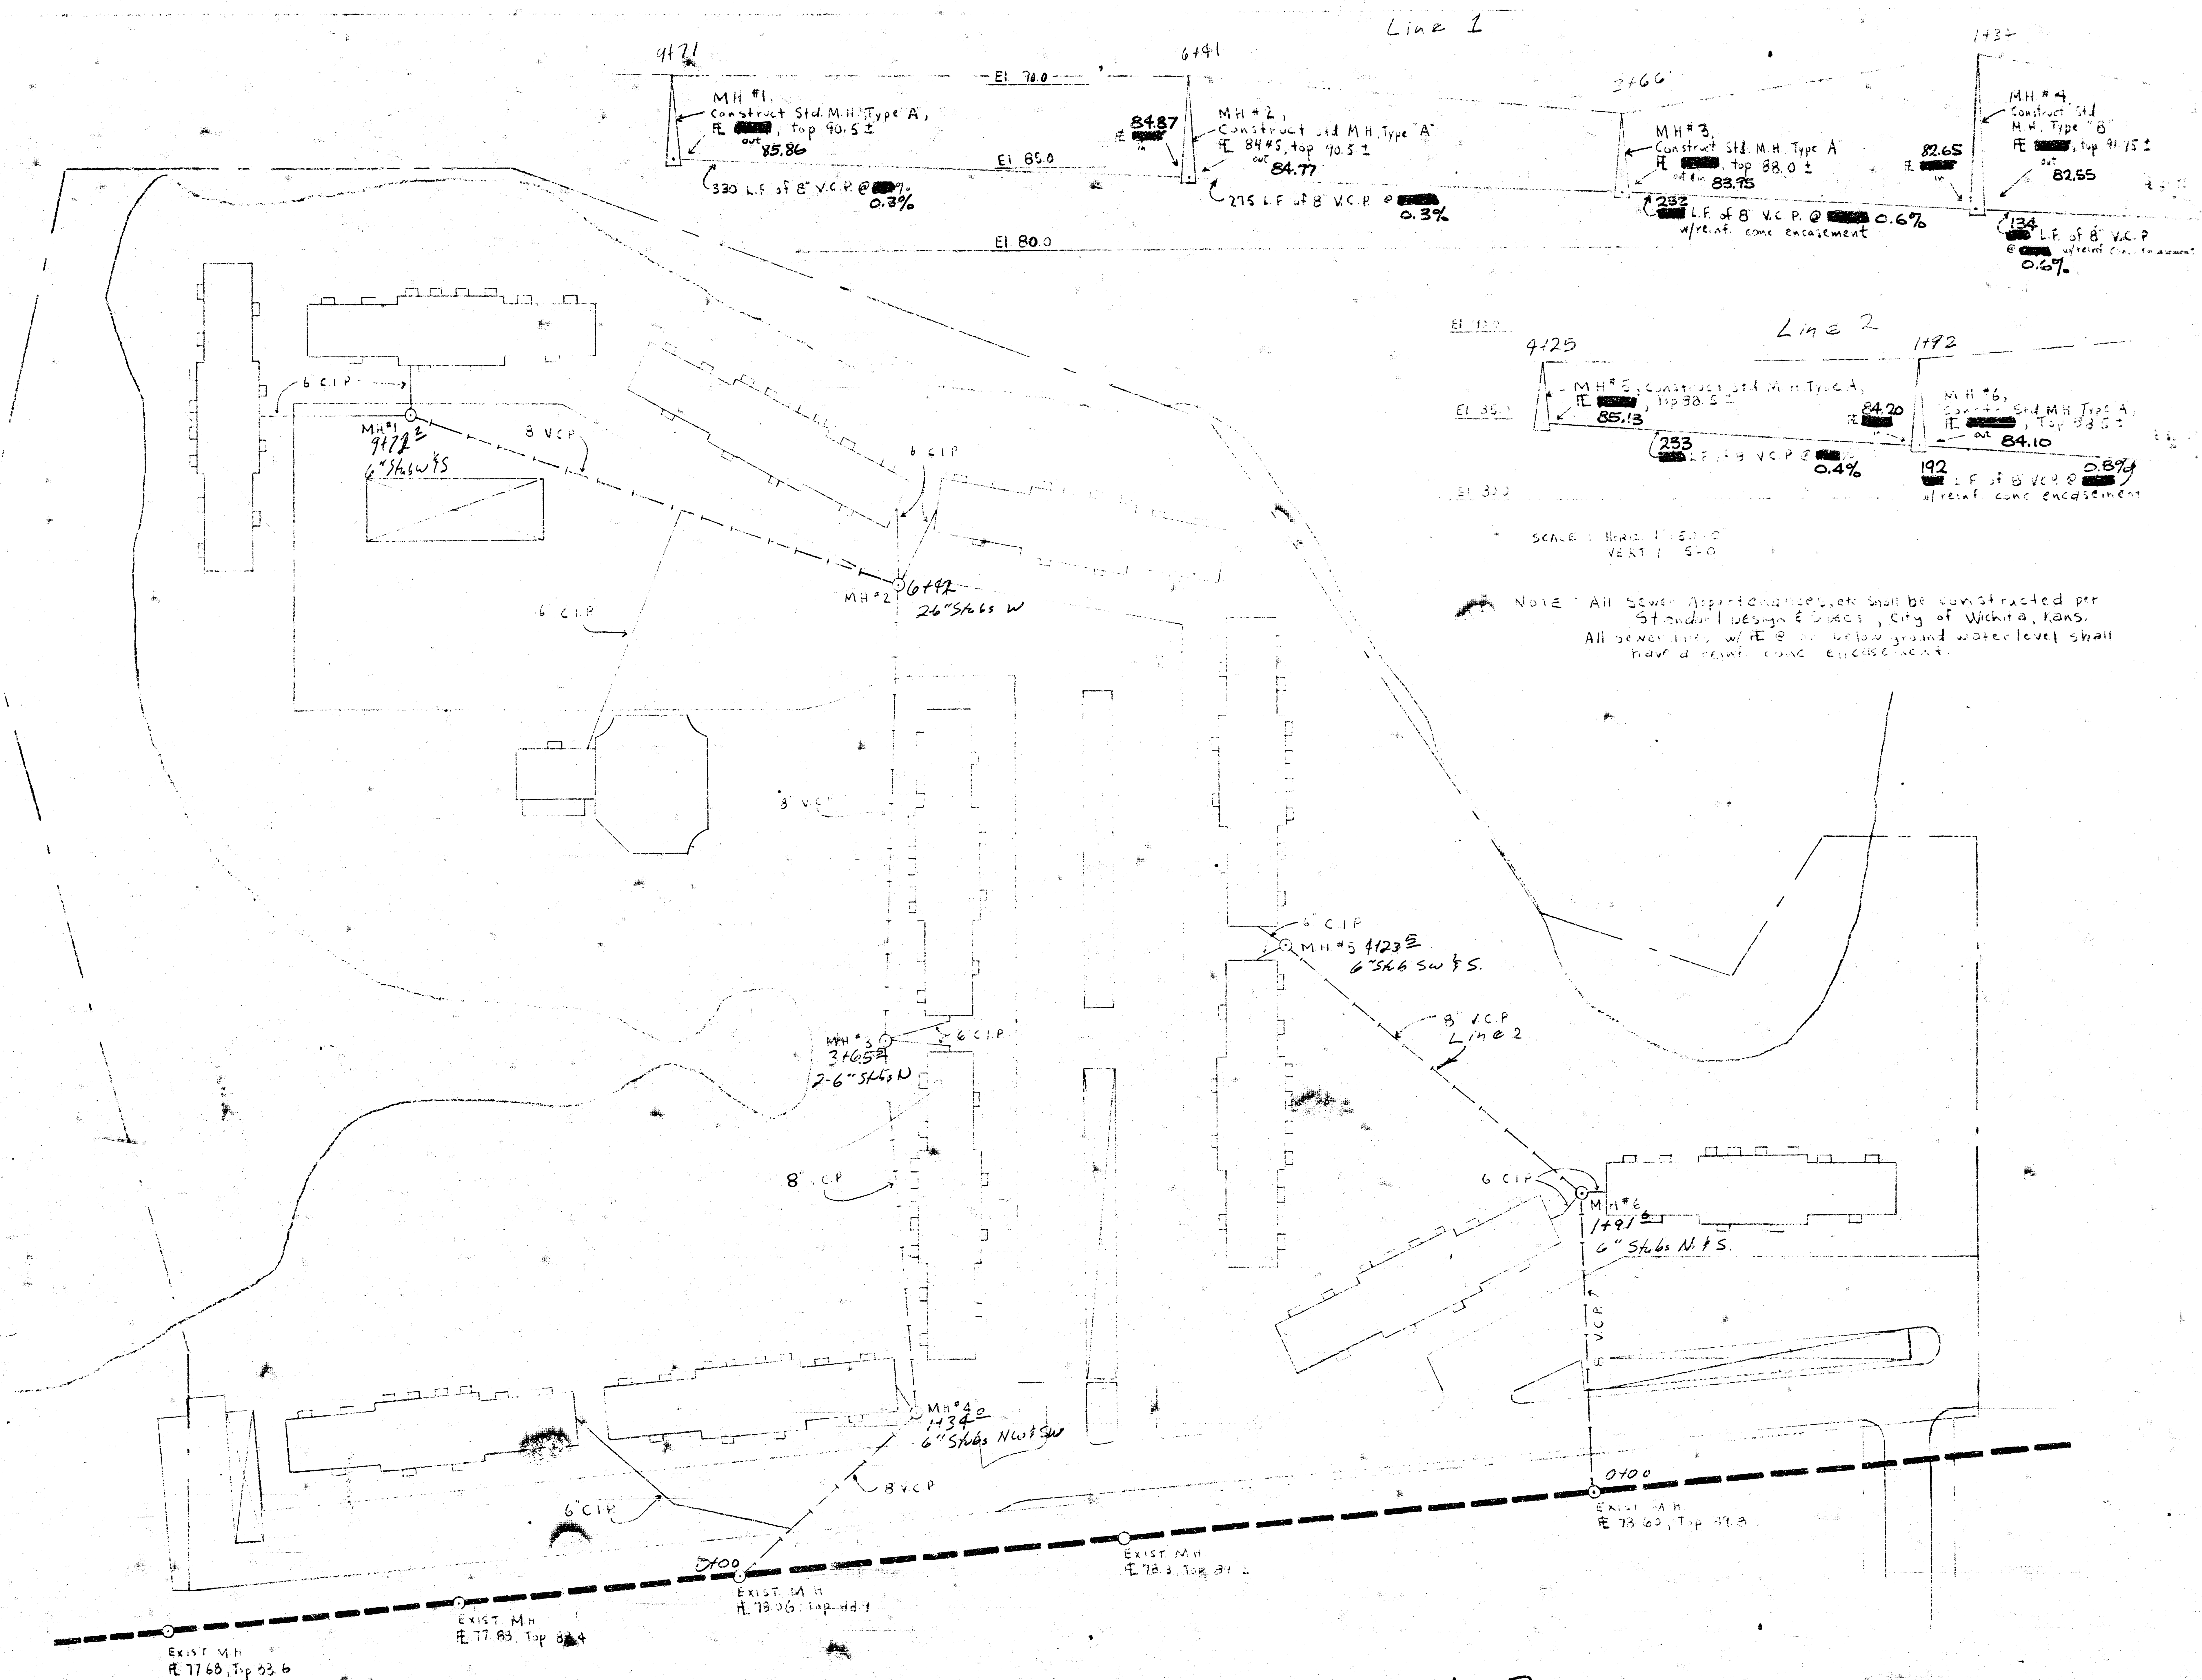

As BUILT

# UTILITY PLAN