

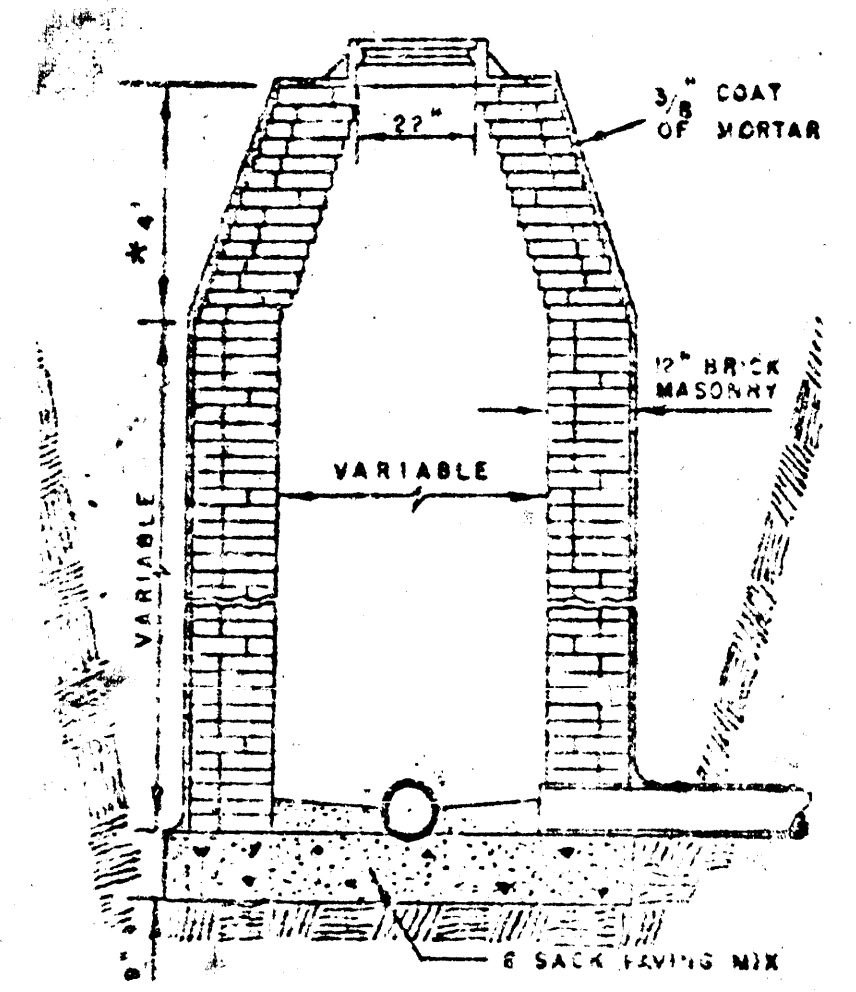




STANDARD MANHOLE
TYPE "A"
4' DIA. ON 5' DIA. M.H.

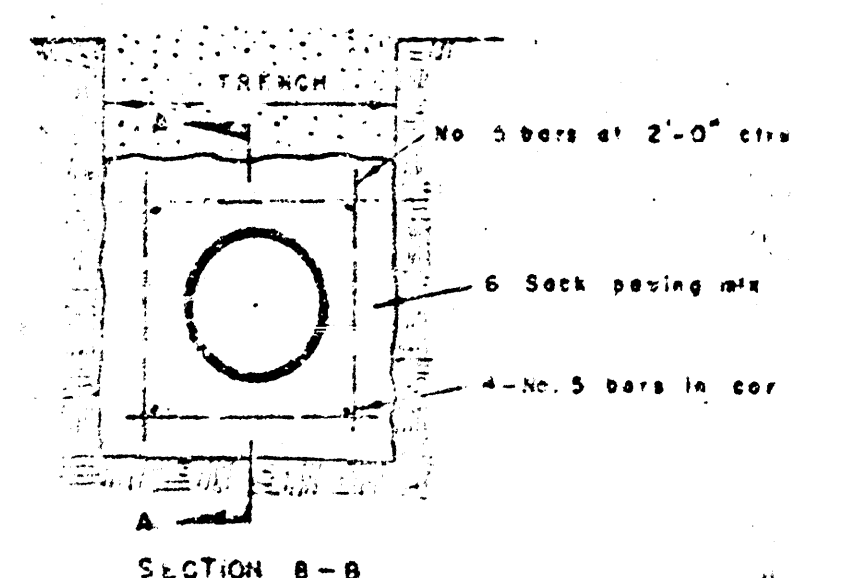

STANDARD MANHOLE
TYPE "B"

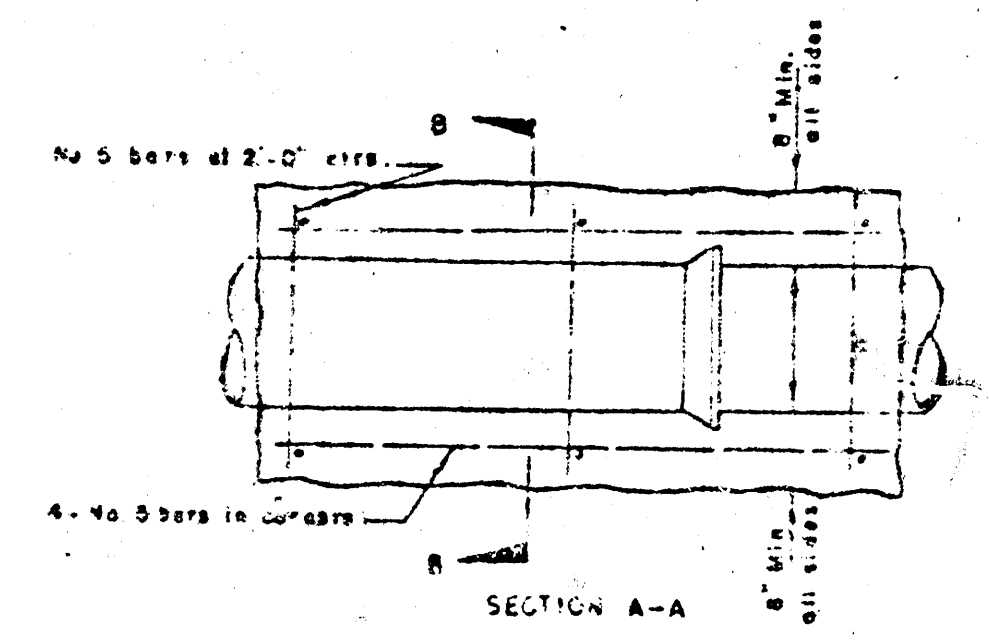

REINFORCED CONCRETE ENCASUREMENT

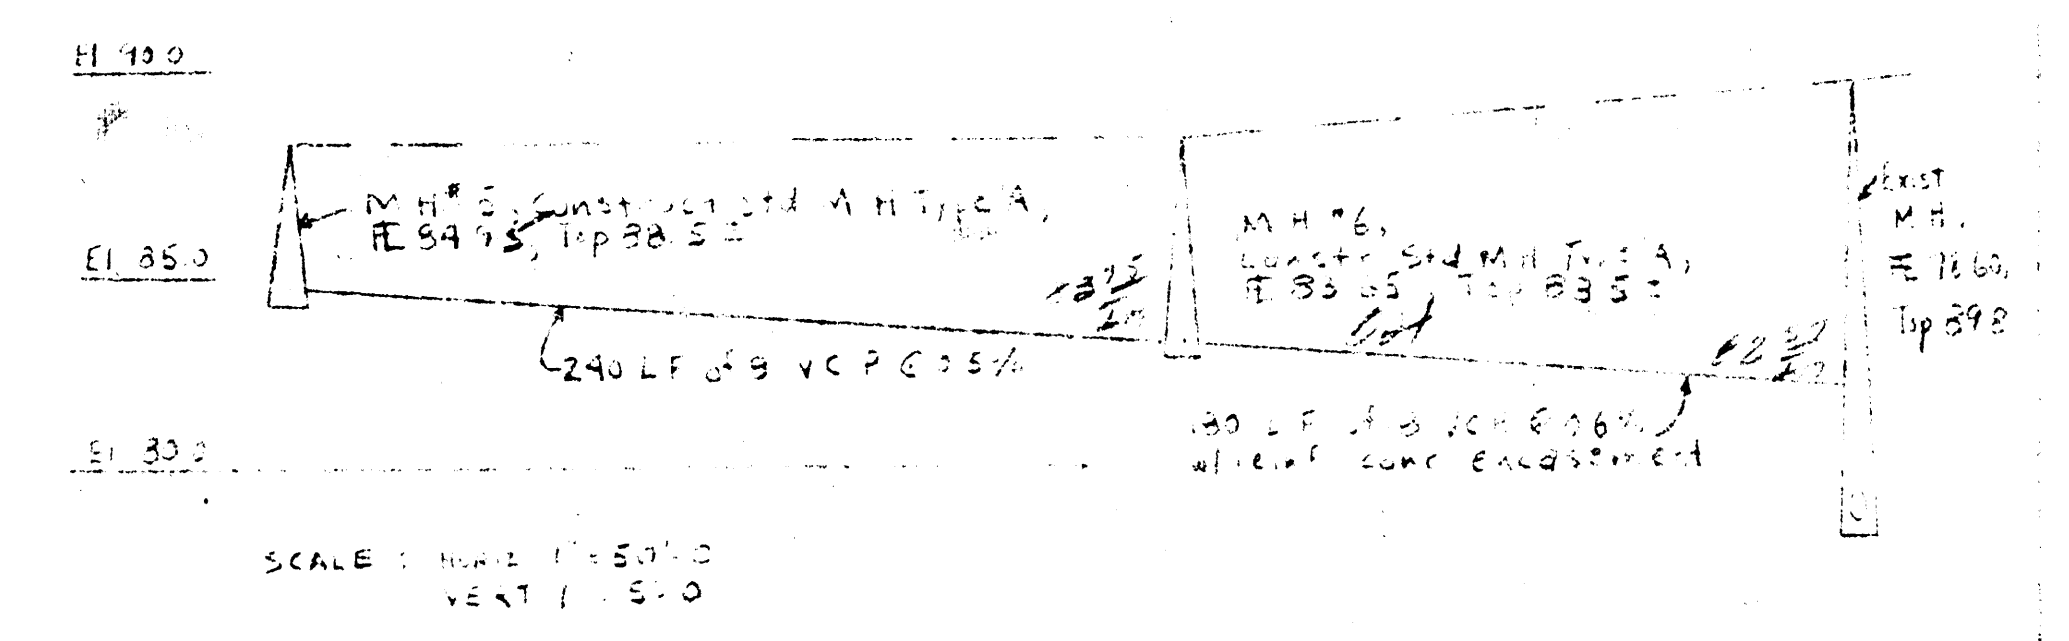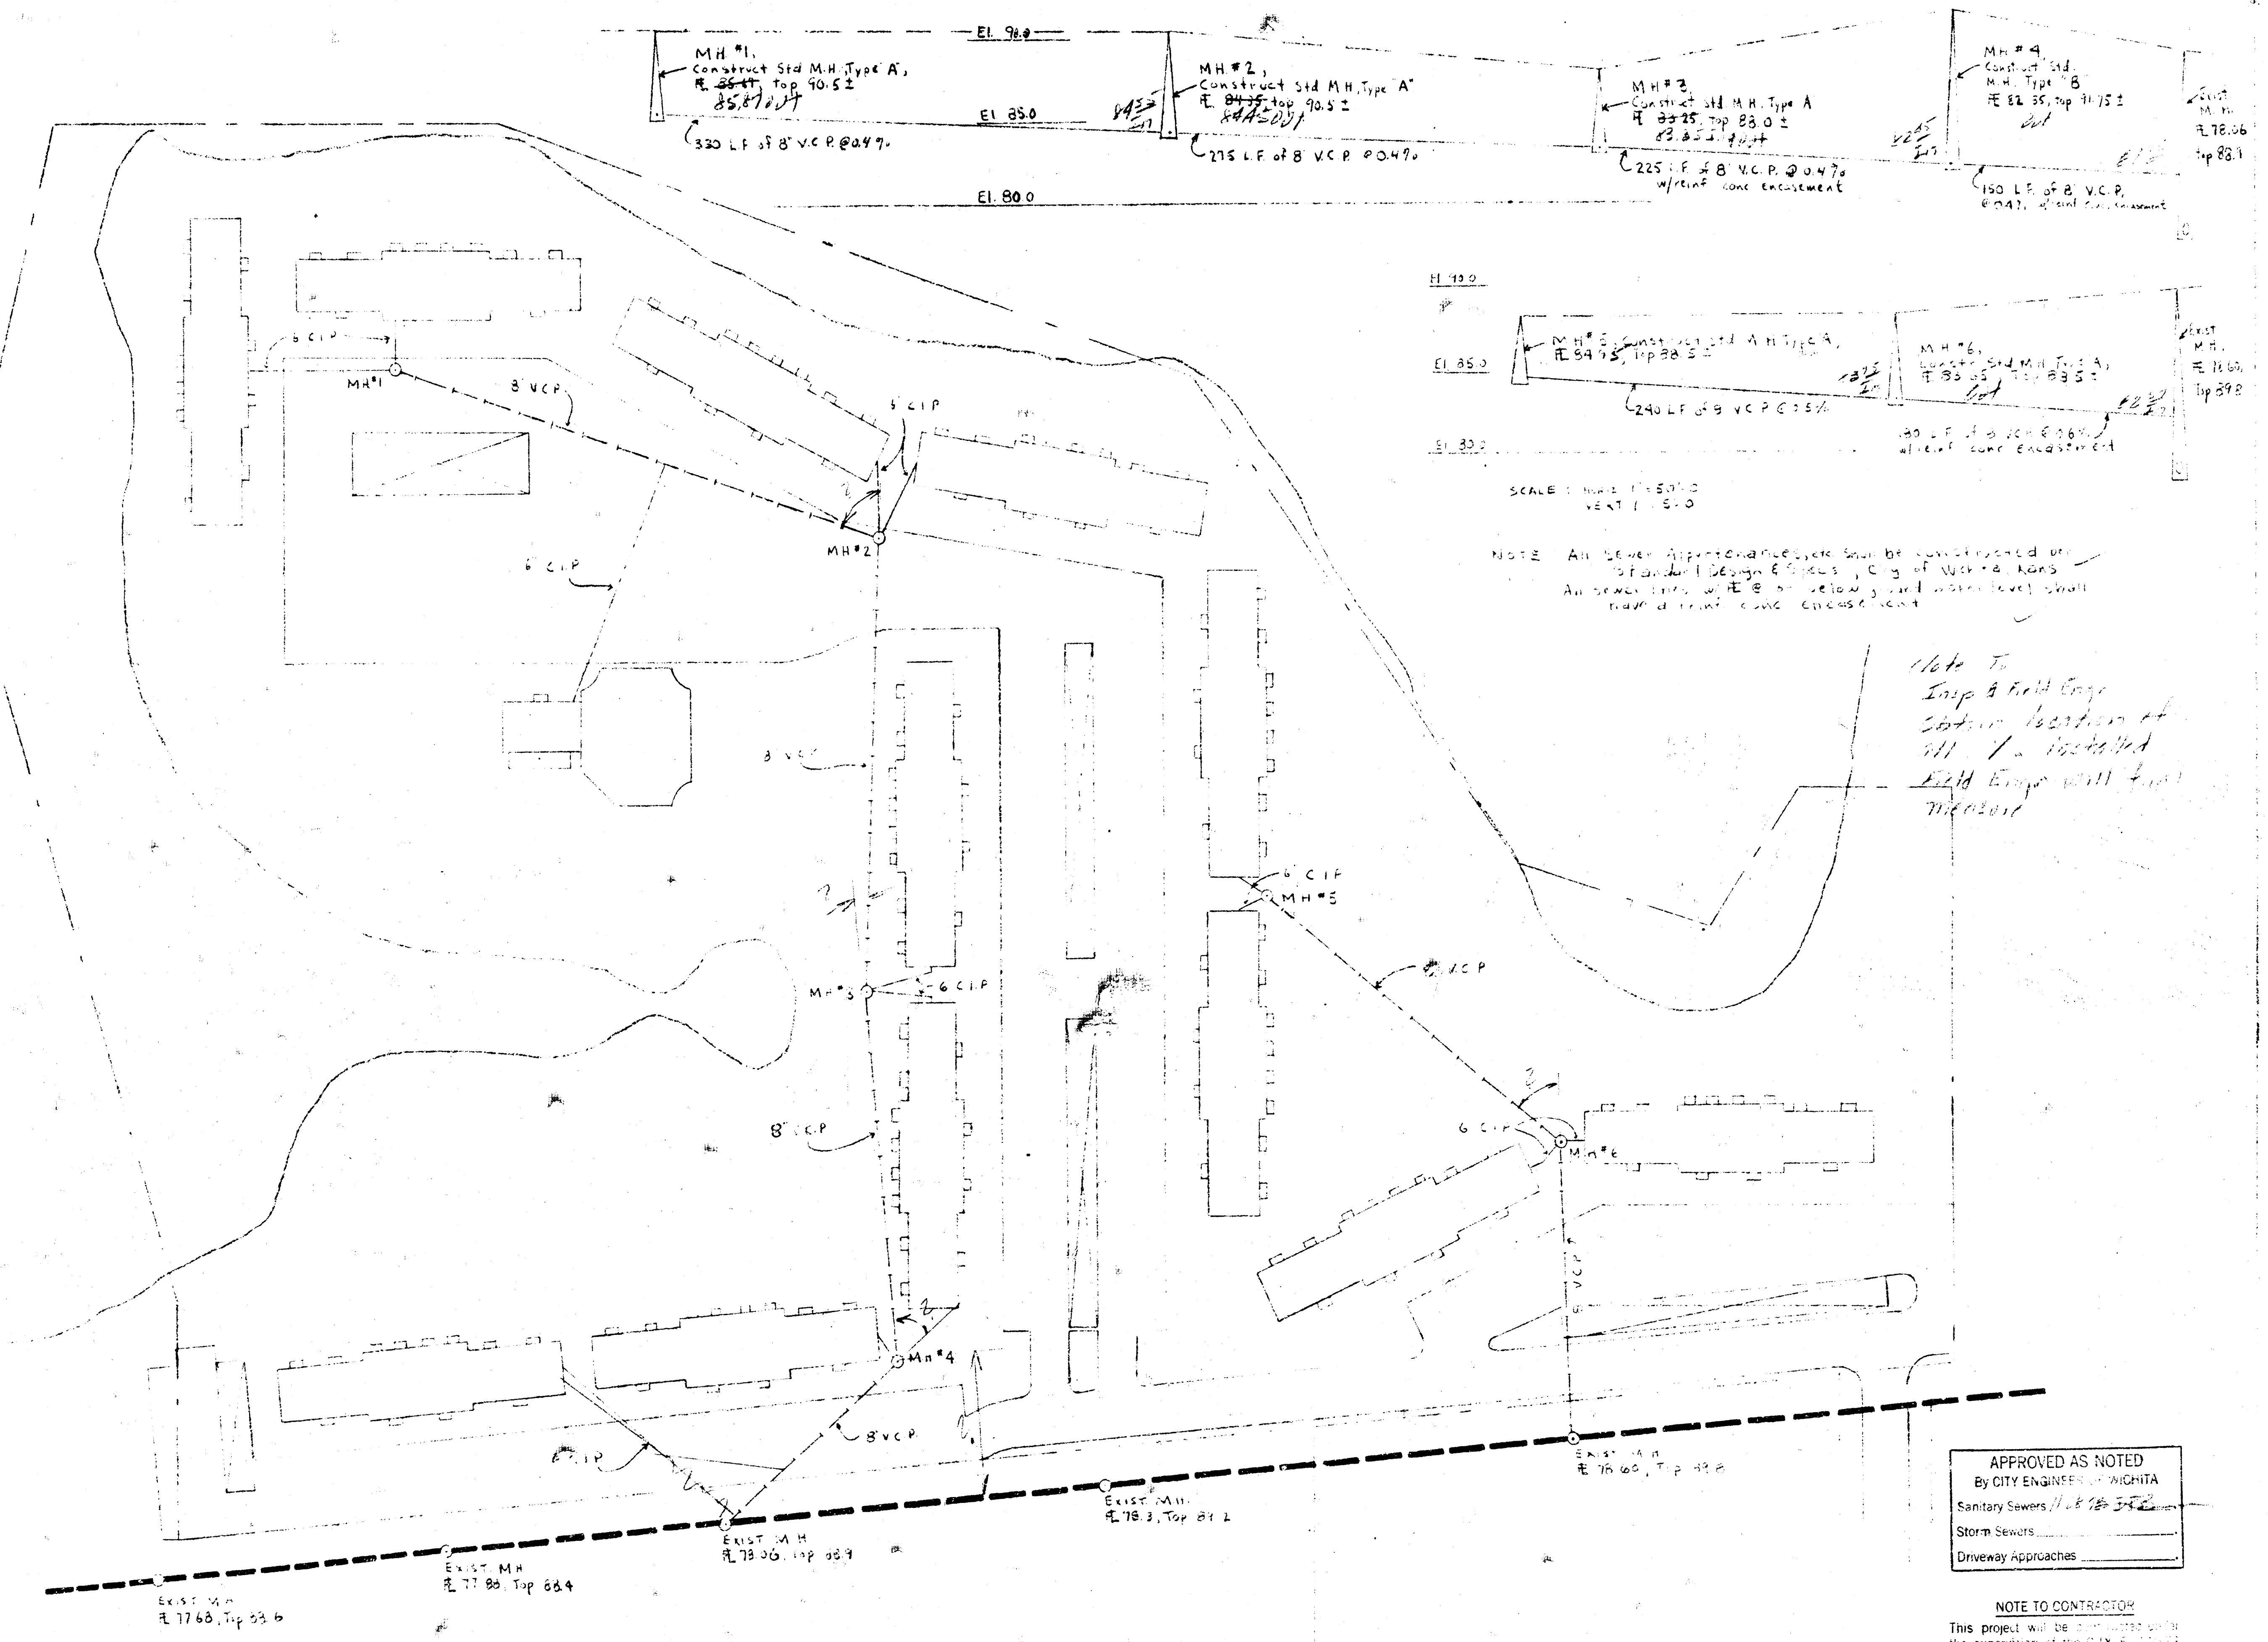

NOTE: All sewer approaches shall be constructed on 3\"/>

Note To
Imp & Field Engs
Slightly location of
all 1\"/>

APPROVED AS NOTED
By CITY ENGINEER WIGHTA
Sanitary Sewers 11/18/52
Storm Sewers
Driveway Approaches

NOTE TO CONTRACTOR
This project will be constructed under the supervision of the City Engineer and conform to the specifications of the City of Wichita. The CONTRACTOR will be under the supervision and inspection of the City Engineer and Inspector.

UTILITY PLAN
SCALE - 1" = 50'-0"

SOUTHLAKE VILLAGE
DICK BRABHAM ARCH 15