

SANITARY SEWER TO SERVE LOTS 4 & 5, BLK. 7 SOUTHWEST IND. ADDITION

Private Project Number:

687PPB (607861)

CITY OF WICHITA, KANSAS

Michael E. Lindebak, P.E. City Engineer

February, 1997

BENEFIT DISTRICT
SOUTHWEST IND. ADD.

3	10
4	9
5	8
6	7

General Notes

- Contractor will be required to provide notice to utility companies a minimum of twenty-four (24) hours prior to any excavation, as follows:

Kansas One-Call 687-2470

The Contractor must notify the following in case of an emergency:

Cablevision 262-4270
or
K.G.E. Gas Service Company 263-2061
Kansas Gas & Electric Company 383-8650
Peoples Natural Gas Company 383-8600
Southwestern Bell Telephone Company 942-7600
City of Wichita Water Department 1-571-2611
City of Wichita Sewer Maintenance 268-4908

- Underground utility service lines and overhead utility pole lines are to be adjusted as necessary by others prior to construction, unless the plans specifically call for their adjustment by the Contractor. Existing utilities and their locations, as shown on the plans, represent the best information obtainable for design. Location information has been obtained from the various utility companies and is either from company record drawings or company-provided field locations. The Contractor will be required to work around existing utilities within the right-of-way which do not conflict with proposed construction.


- The Contractor shall be responsible for maintaining continuous flow of sewage through construction. Contractor's proposed method for maintaining sewage flow shall be approved by the Engineer. Cost of maintaining flow of sewage through construction will not be paid for directly and this cost shall be considered as subsidiary to the other pay items of work.

- The Contractor shall be responsible for preserving property irons. The Contractor will be required to re-establish any property irons which are damaged or destroyed by his construction operations. Such irons shall be re-established by a licensed land surveyor in accordance with state laws.

- All areas disturbed by construction operations shall be restored to pre-construction conditions including seeding, grading, and mulching if so required.

- The Contractor shall erect and maintain traffic control devices in accordance with the Manual on Uniform Traffic Control Devices. Subject to Engineer's approval.

- The Contractor shall comply with all applicable safety codes particularly with regard to Confined Spaces and conditions thereof.

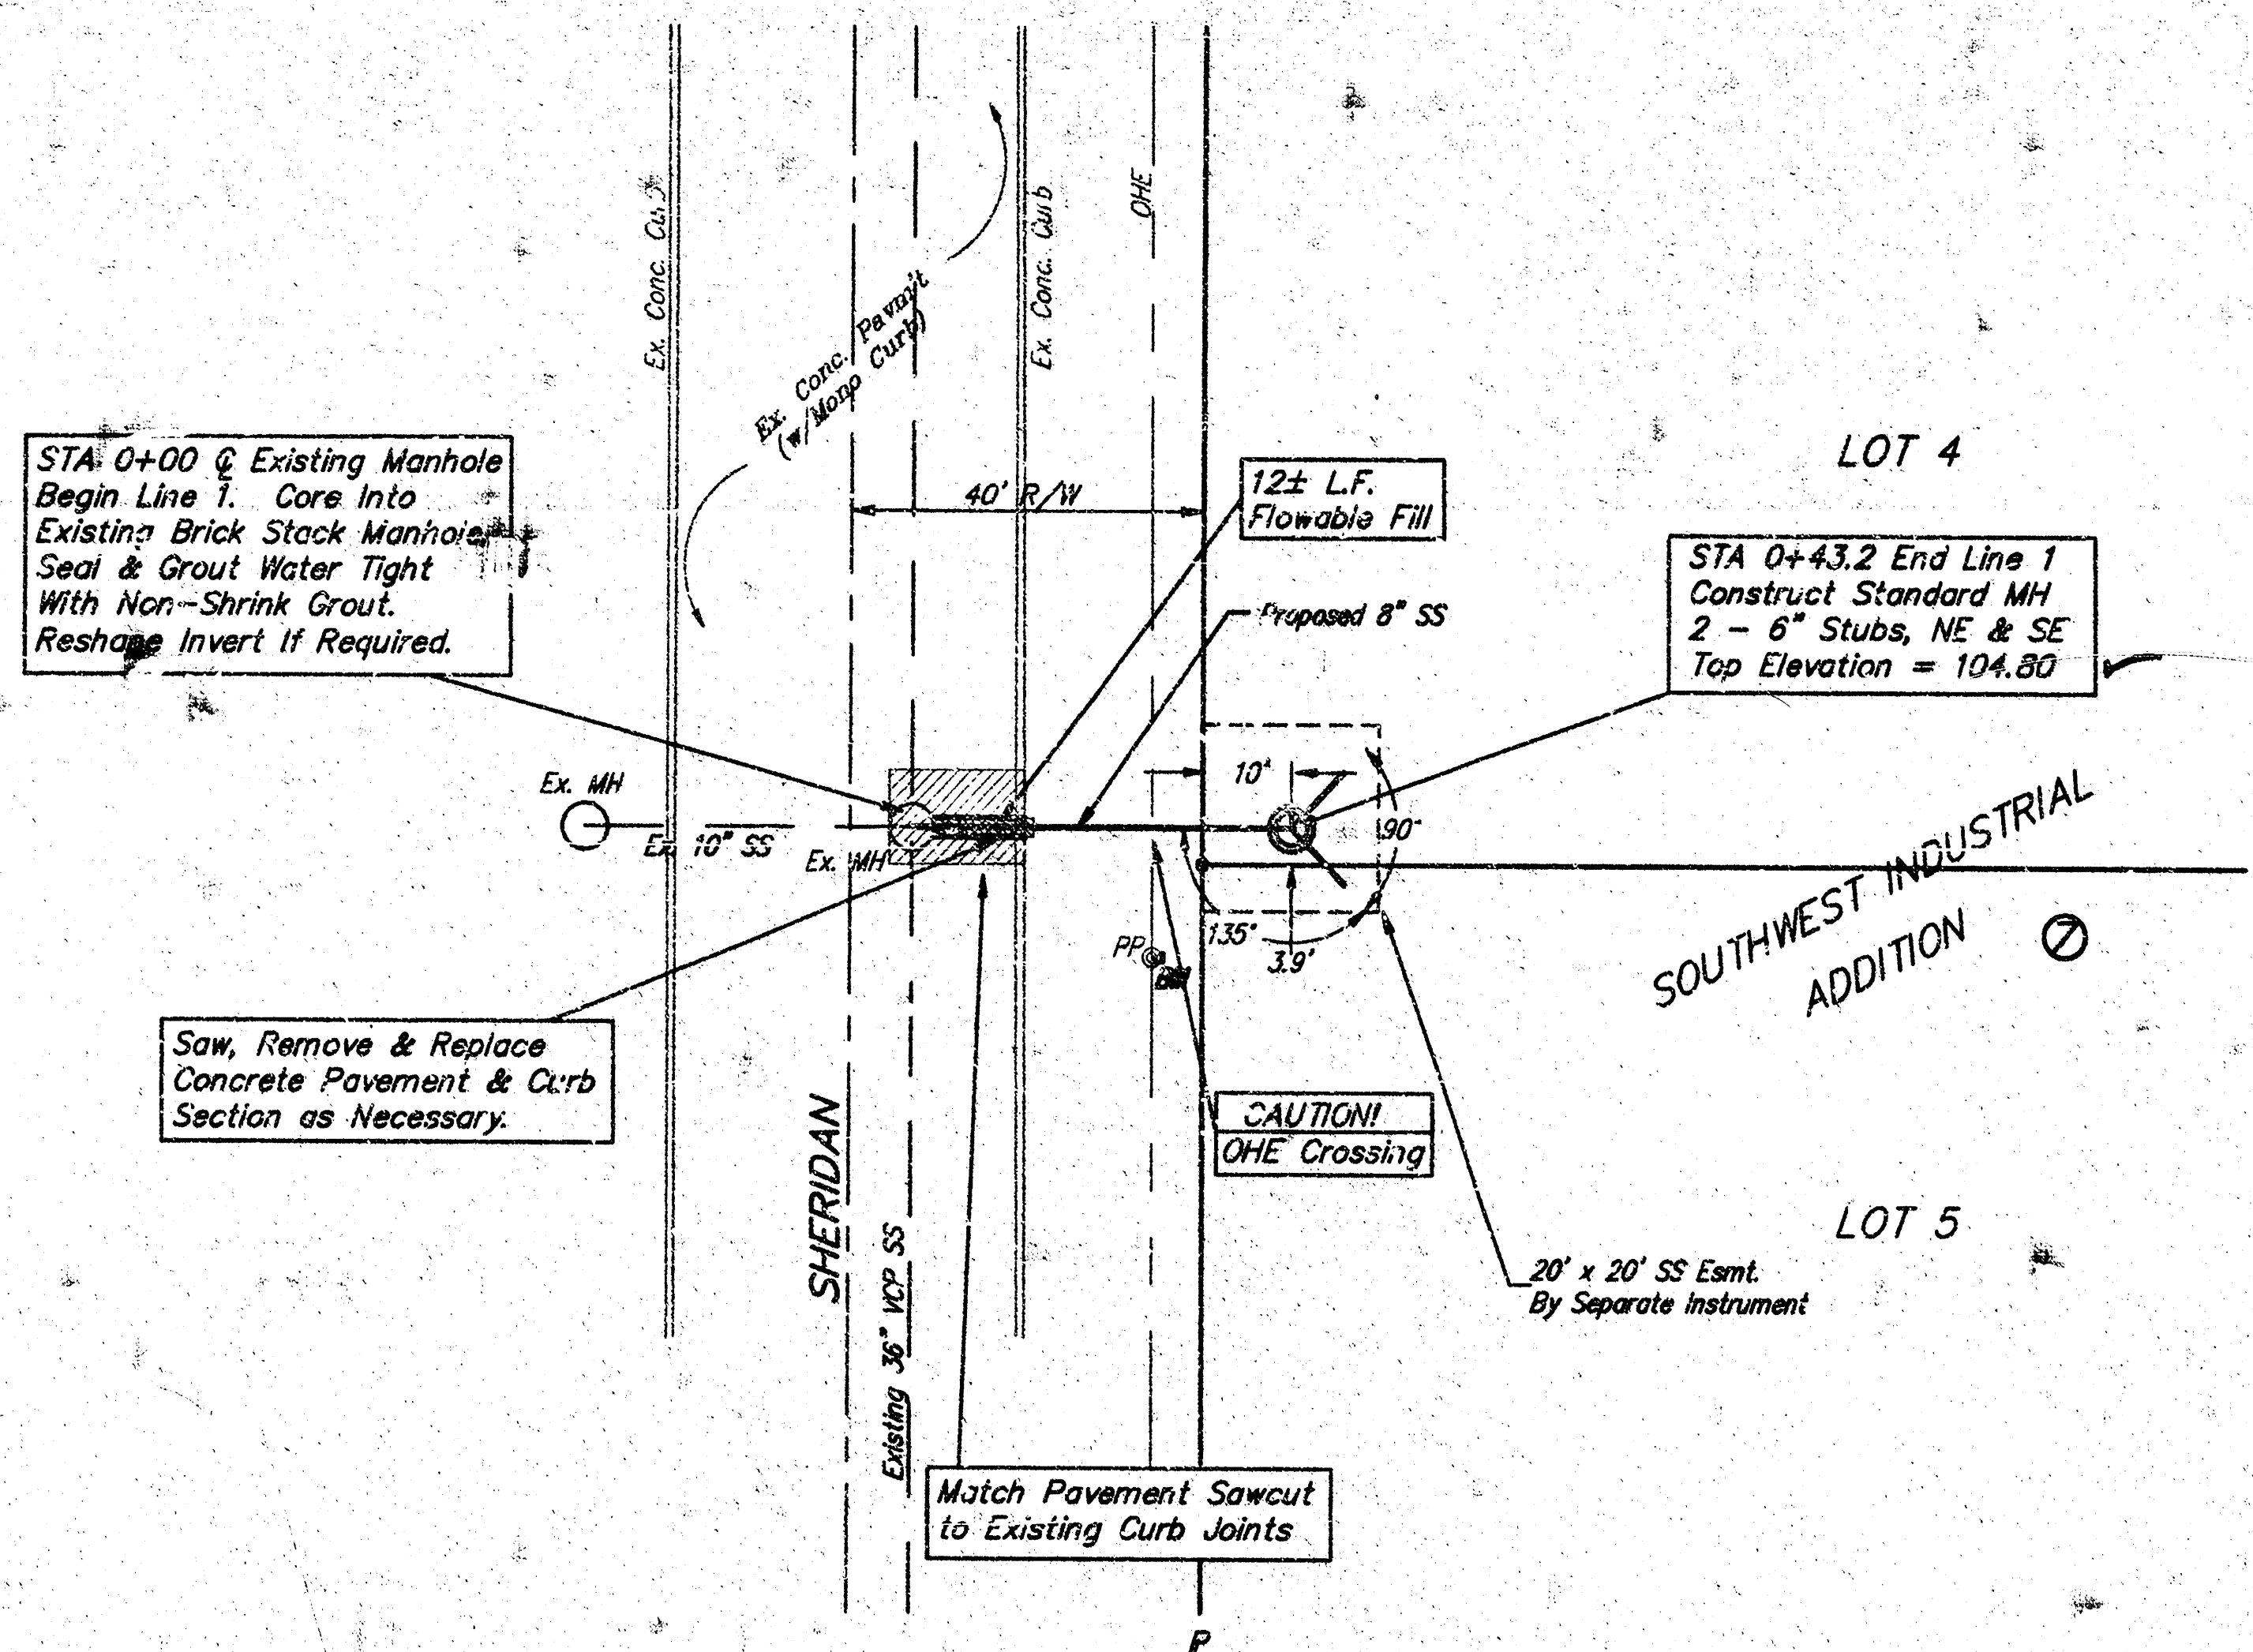

SCALE:


1" = 20' Horizontal

1" = 5' Vertical

• = IRON

BENCHMARK

60d Step Nail East Side Power Pole
5' West & 10' South of NW Corner
Lot 5, Blk. 7
Elevation = 104.22 City Datum

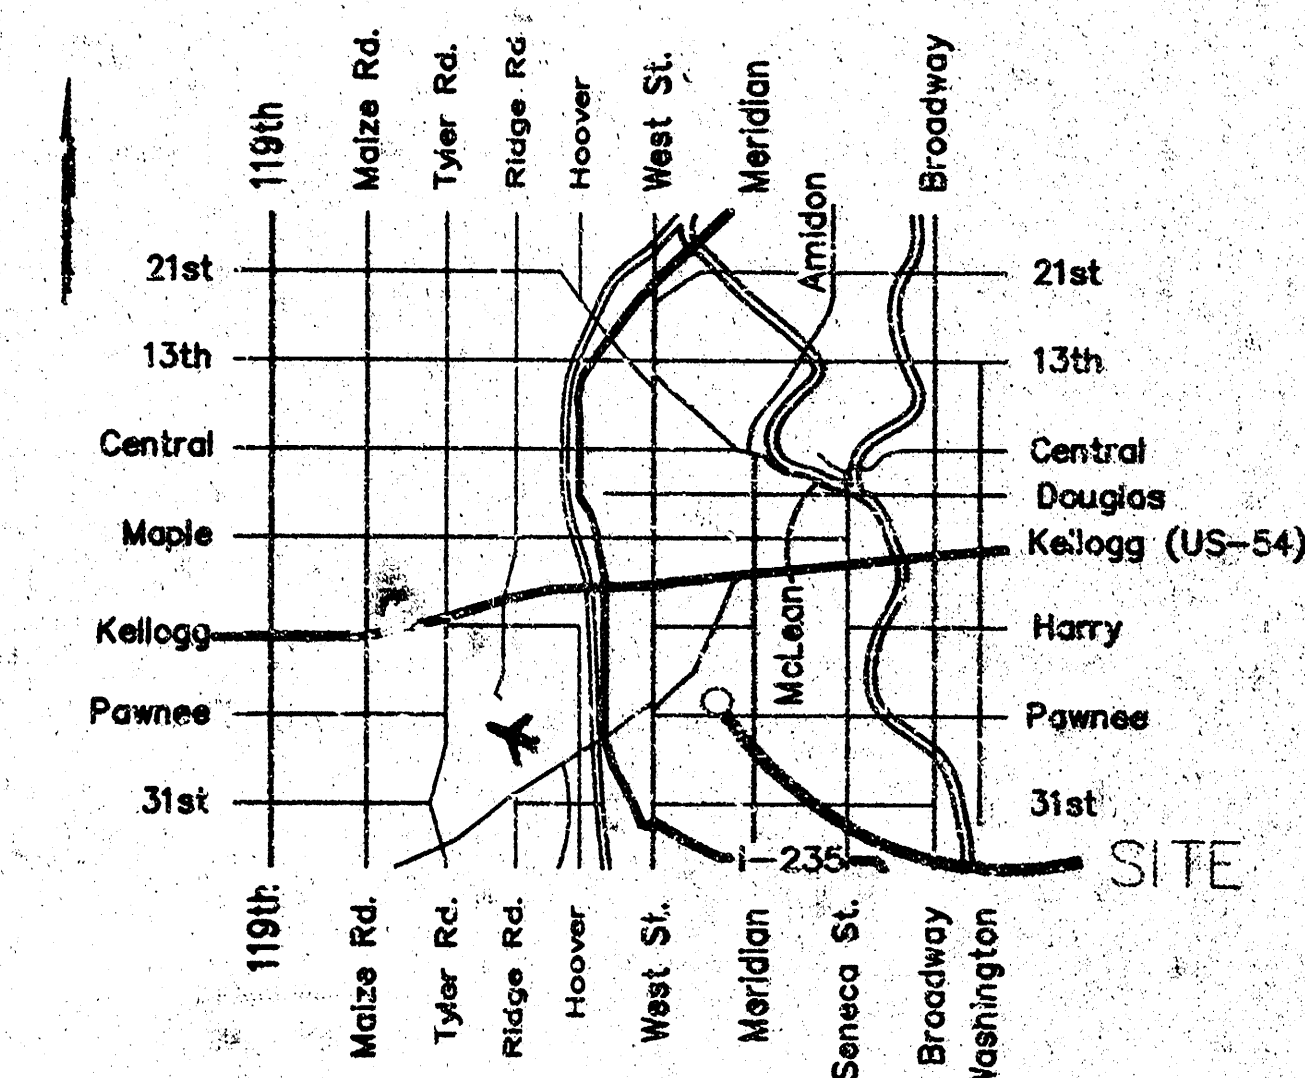

LOCATION MAP

Booked
ROL
3/10/97

ASBUILT PER
PLAN
3/17/97


APPROVED AS NOTED
BY CITY ENGINEER OF WICHITA

Sanitary Sewer *2/10/97*

NOTE TO CONTRACTORS

Inspection and testing for this project is to be provided by a Licensed Consulting Engineering Firm under contract with the Owner/Developer. Said inspection to be in accordance with the City of Wichita standard construction engineering practices and certified by a Licensed Professional Engineer. No work shall be performed in dedicated easements or public right-of-way by the Contractor without such inspection nor shall any work be commenced without written authorization by the City Engineer. All Construction and Materials shall comply with the City of Wichita Specifications and Standards (on file and available in the City Engineer's Office).

INSPECTOR: LYLE POWERS, BAUGHMAN CO.
ASBUILT: 3/15/97 JFB, BAUGHMAN CO.
BAUGHMAN COMPANY P.A.
ENGINEERING, SURVEYING, & PLANNING
315-255-7271 • 315 ELLIS WICHITA, KANSAS 67211

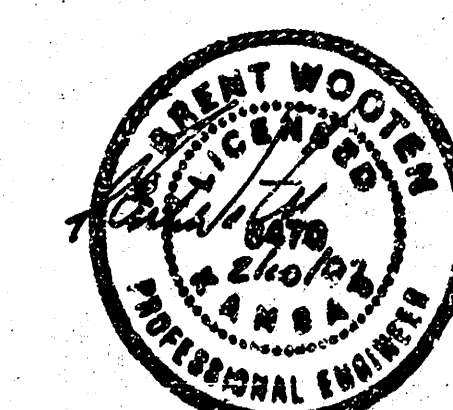

14-2-4-13