
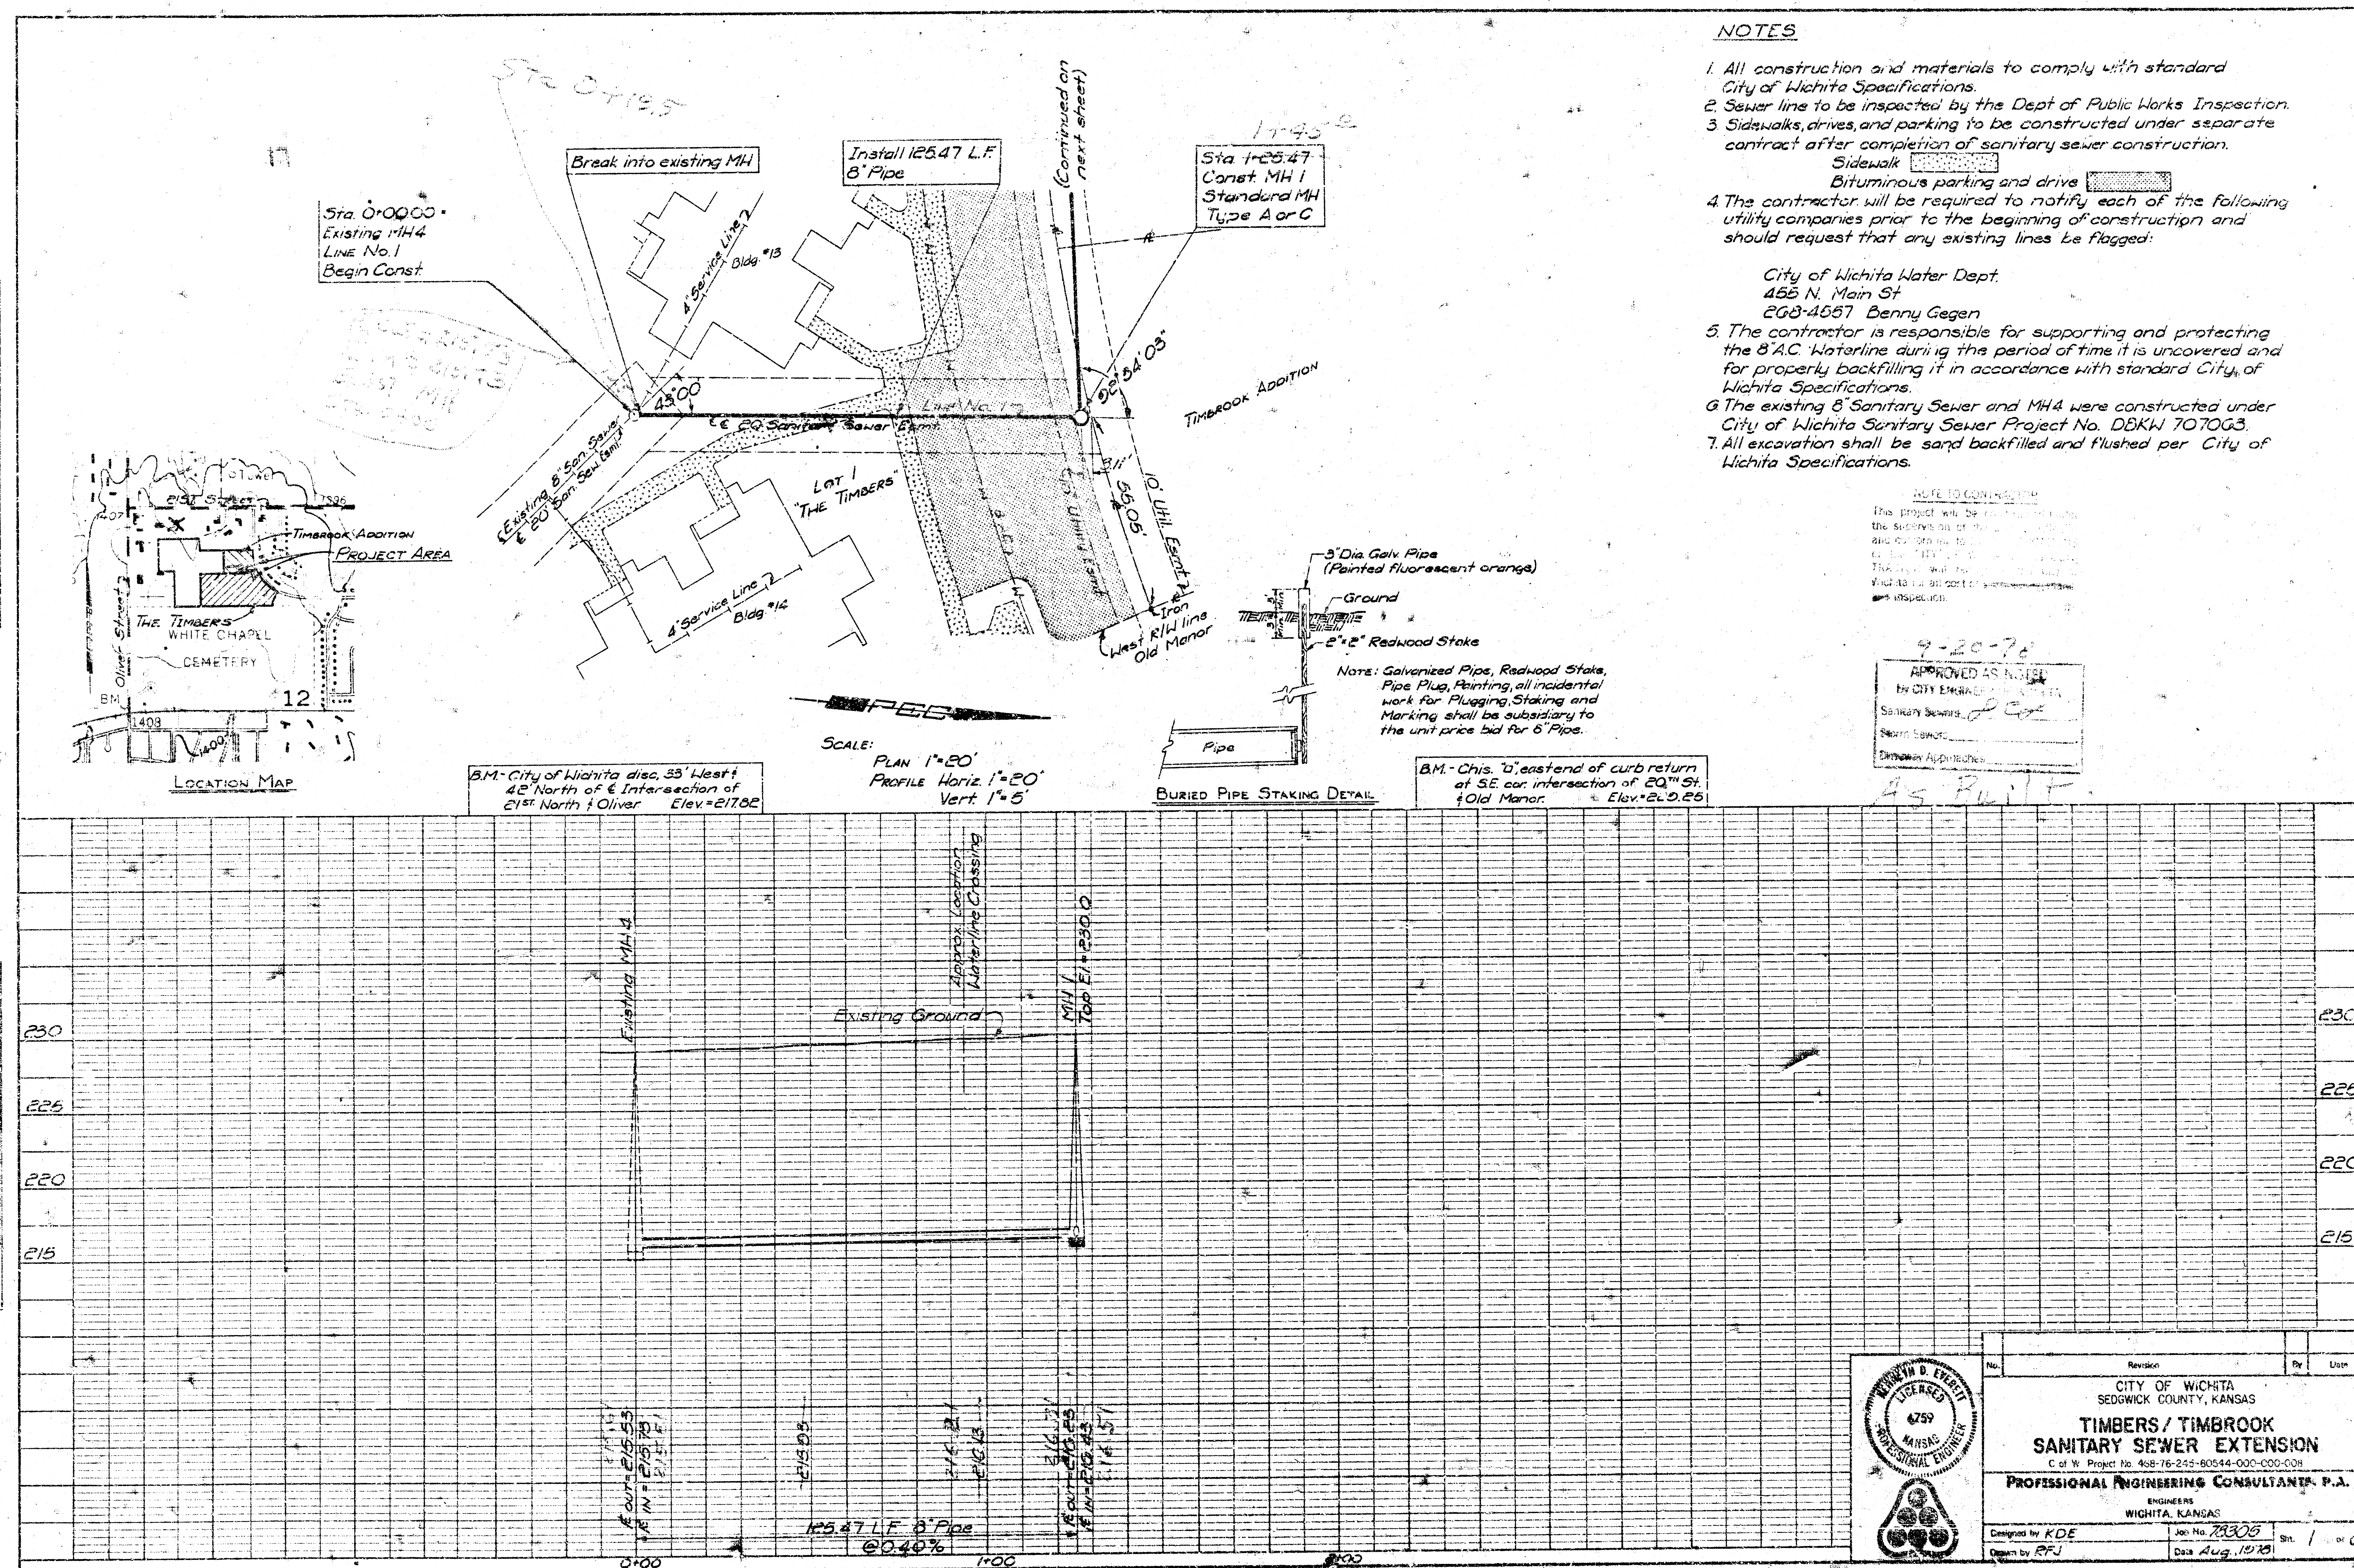


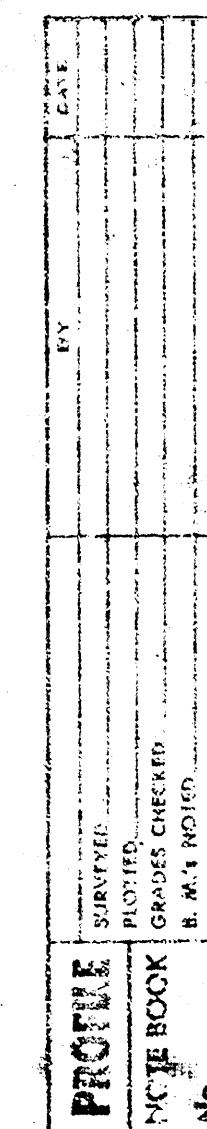

NOTES

1. All construction and materials to comply with standard City of Wichita Specifications.
2. Sewer line to be inspected by the Dept of Public Works Inspection.
3. Sidewalks, drives, and parking to be constructed under separate contract after completion of sanitary sewer construction.
Sidewalk [REDACTED]
Bituminous parking and drive [REDACTED]
4. The contractor will be required to notify each of the following utility companies prior to the beginning of construction and should request that any existing lines be flagged:

City of Wichita Water Dept.
456 N. Main St
268-4557 Benny Gegen
5. The contractor is responsible for supporting and protecting the 8" A.C. Waterline during the period of time it is uncovered and for properly backfilling it in accordance with standard City of Wichita Specifications.
6. The existing 8" Sanitary Sewer and MH4 were constructed under City of Wichita Sanitary Sewer Project No. DDKW 7070G3.
7. All excavation shall be sand backfilled and flushed per City of Wichita Specifications.

City of Wichita Water Dept.
455 N. Main St
268-4557 Bennu Gegen

5. The contractor is responsible for supporting and protecting the 8" A.C. Waterline during the period of time it is uncovered and for properly backfilling it in accordance with standard City of Wichita Specifications.
6. The existing 8" Sanitary Sewer and M44 were constructed under City of Wichita Sanitary Sewer Project No. DBKW 7070G3.
7. All excavation shall be sand backfilled and flushed per City of Wichita Specifications.

NOTE TO CONTRACTOR

This project will be completed under the supervision of the District Engineer and Engineer in Charge, District Office, and will be subject to the approval of the District Engineer and Engineer in Charge, District Office. The project will be subject to the approval of the District Engineer and Engineer in Charge, District Office.

9-20-78
APPROVED AS NOTED
BY CITY ENGINEER
Sanitary Sewers
Storm Sewers
Disposal Approaches

As Built

K&E PLATE 1, PLAN-PROFILE
REIFFEL & ESSER CO.
40 7024 MADE IN U.S.A.

