



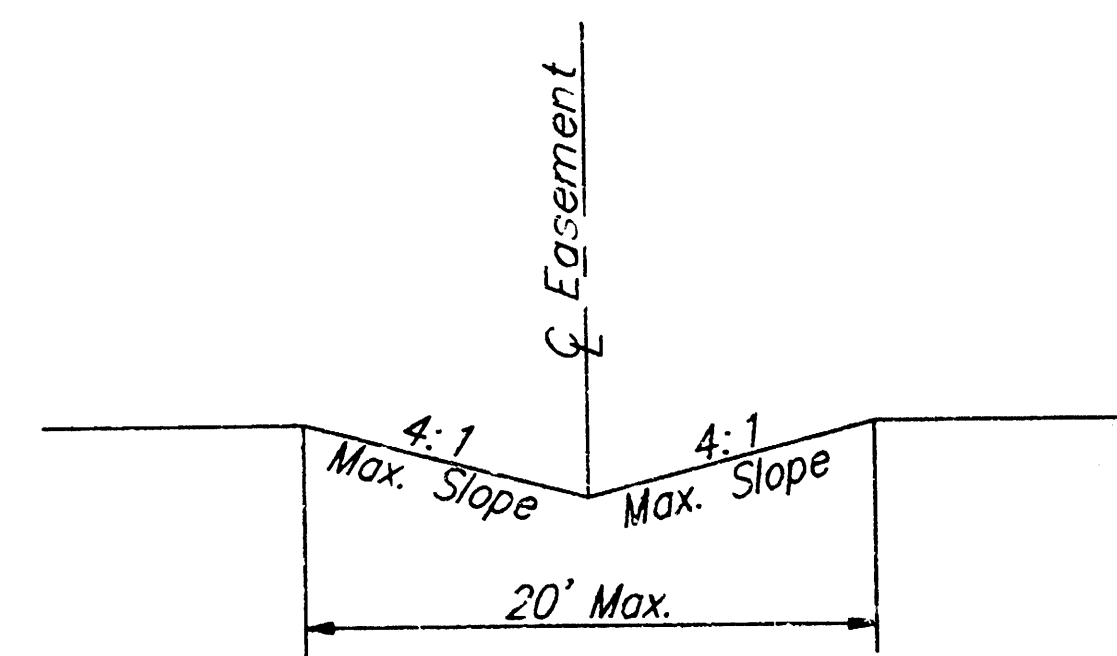

Easement Grading Cross-Section

BENCH MARKS: Standard City Disk 2 feet east and 48 feet south of the N.W. Corner, N.E. Quarter, Section 5-8-2E Elevation = 192.20 City Datum.

'a' Cut top of curb on the south side of Carson and west R/W of Linden. Elevation = 201.71 City Datum.

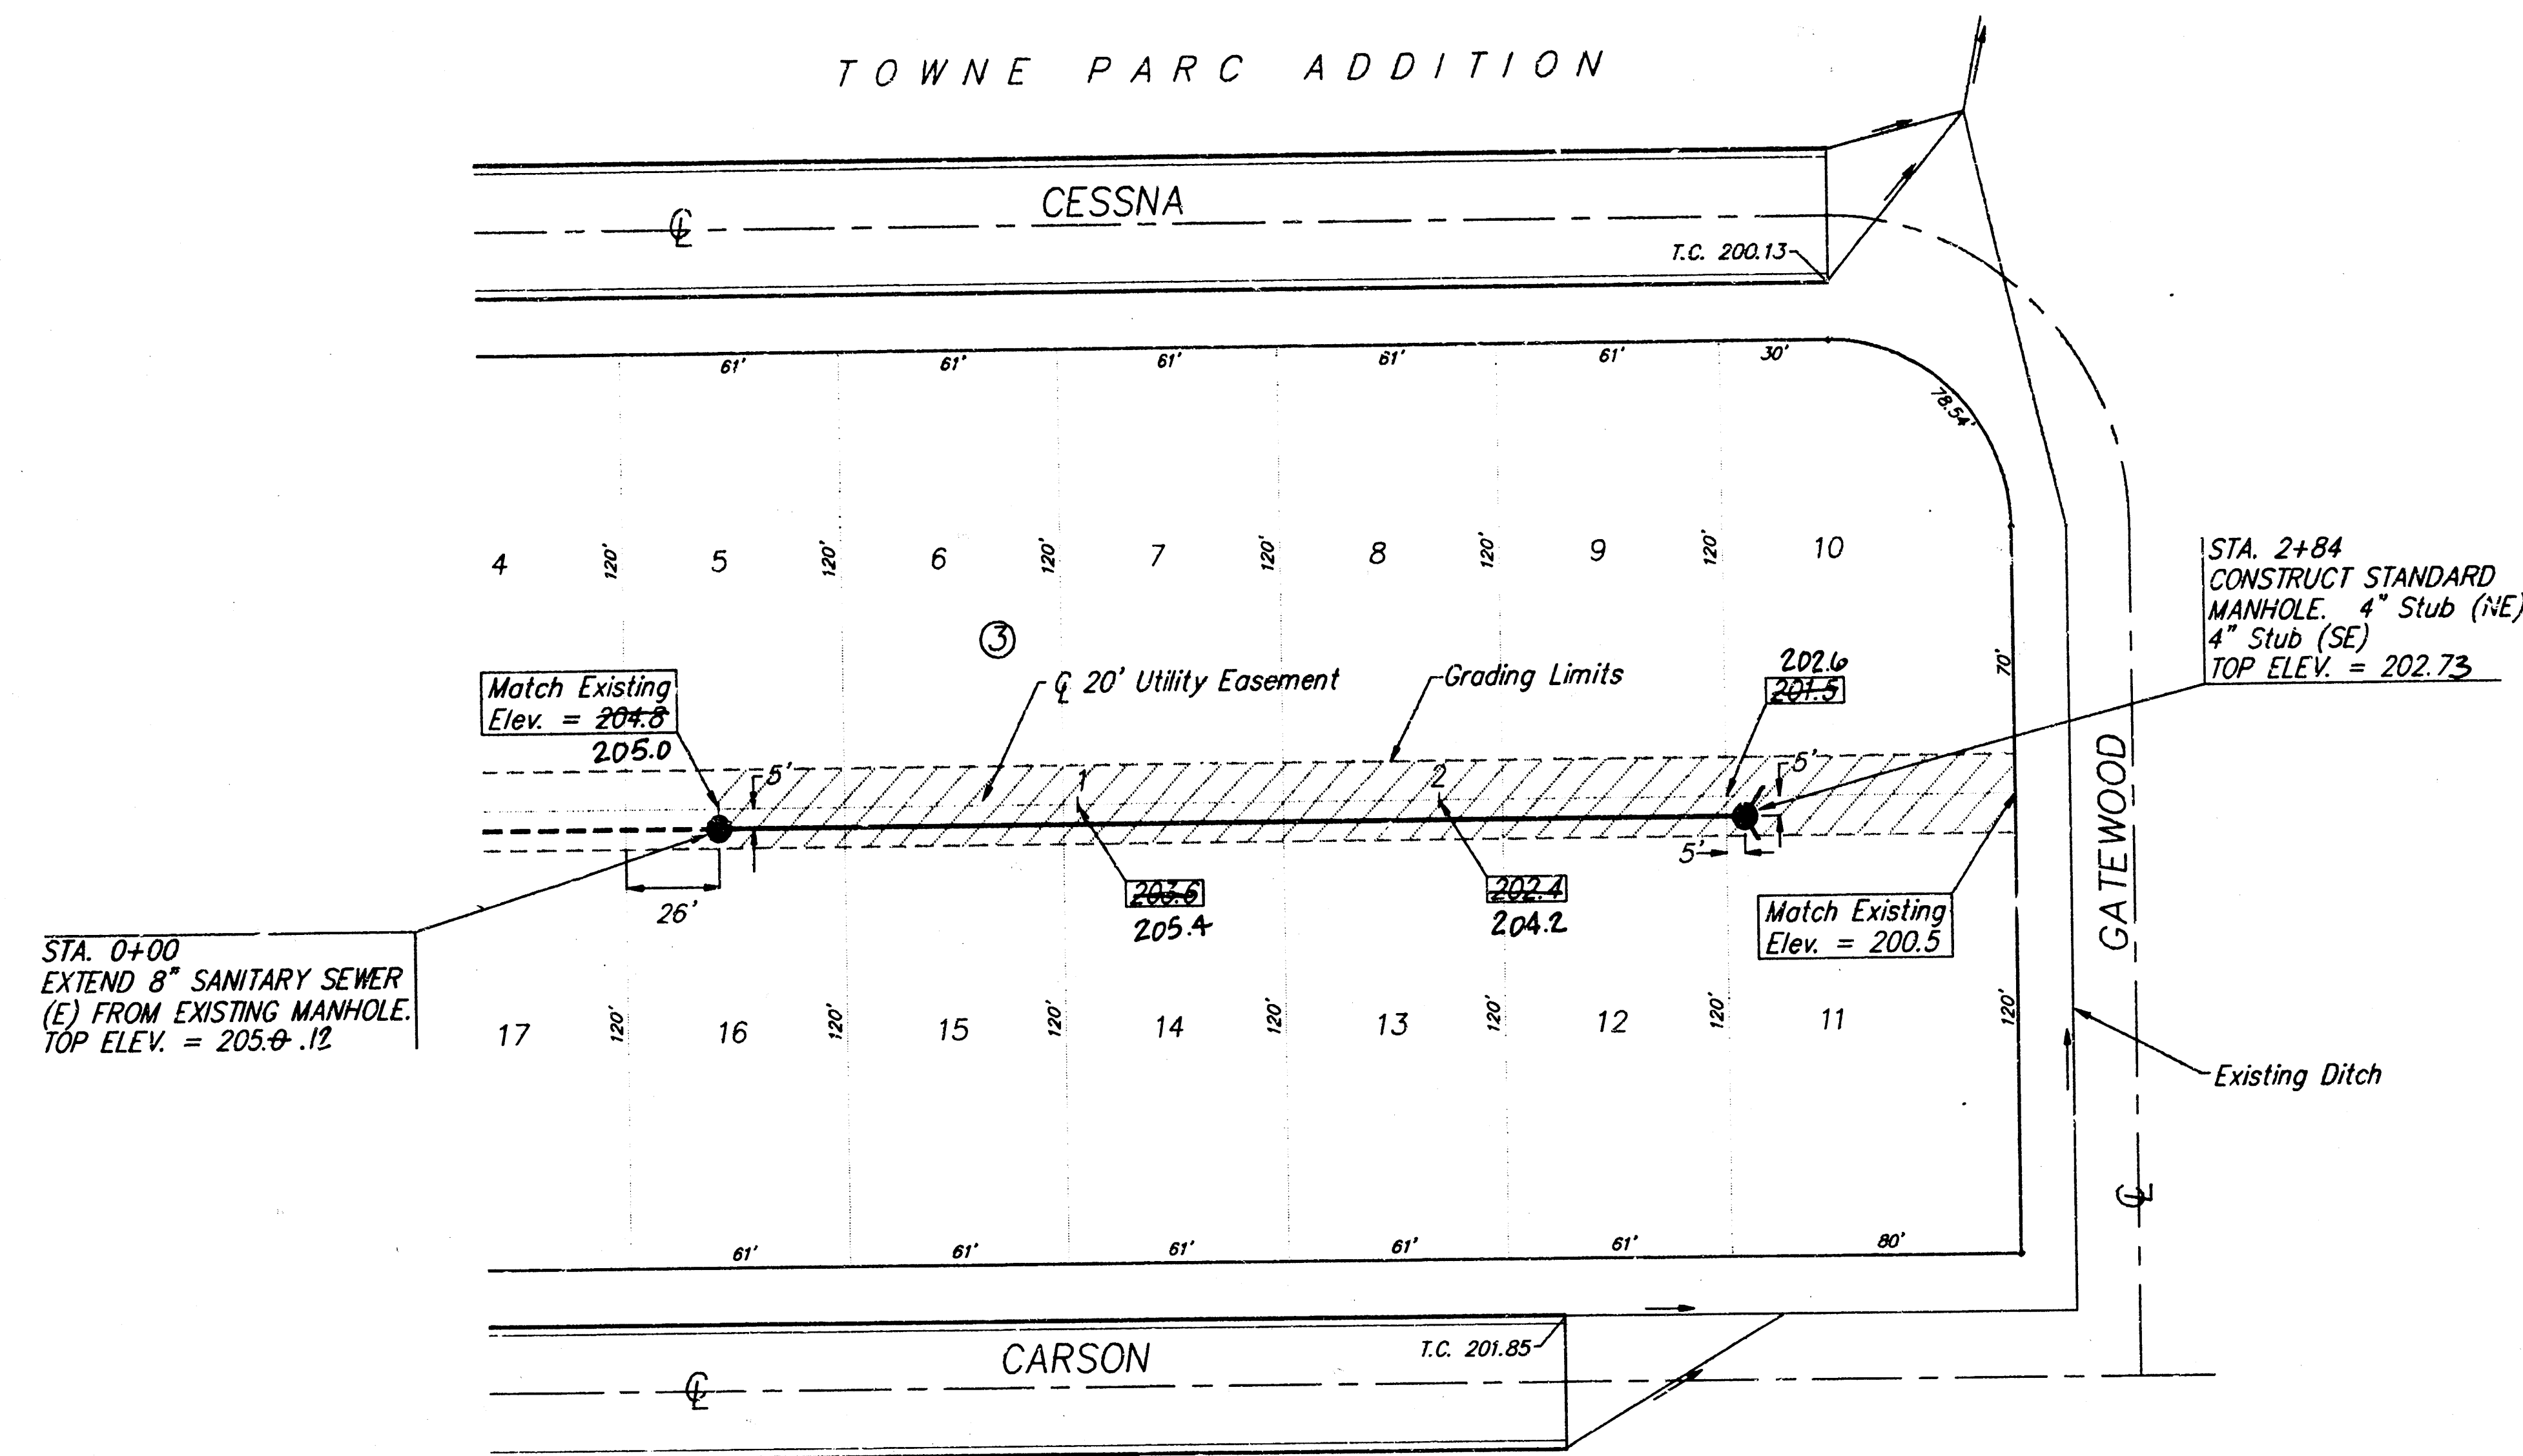

APPROVED AS NOTED  
BY CITY ENGINEER OF WICHITA

Sanitary Sewers VRH 1/7/92

Storm Sewers \_\_\_\_\_

Driveway Approaches \_\_\_\_\_


Water Mains \_\_\_\_\_

Paving \_\_\_\_\_


NOTE TO CONTRACTORS

Inspection and testing for this project is to be provided by a Licensed Consulting Engineering Firm under contract with the Owner/Developer. Said inspection to be in accordance with the City of Wichita standard construction engineering practices and certified by a Licensed Professional Engineer. No work shall be performed in dedicated easements or public right-of-way by the Contractor without such inspection nor shall any work be commenced without written authorization by the City Engineer.

SCALE: 1" = 40' Horizontal  
1" = 5' Vertical  
• = Iron

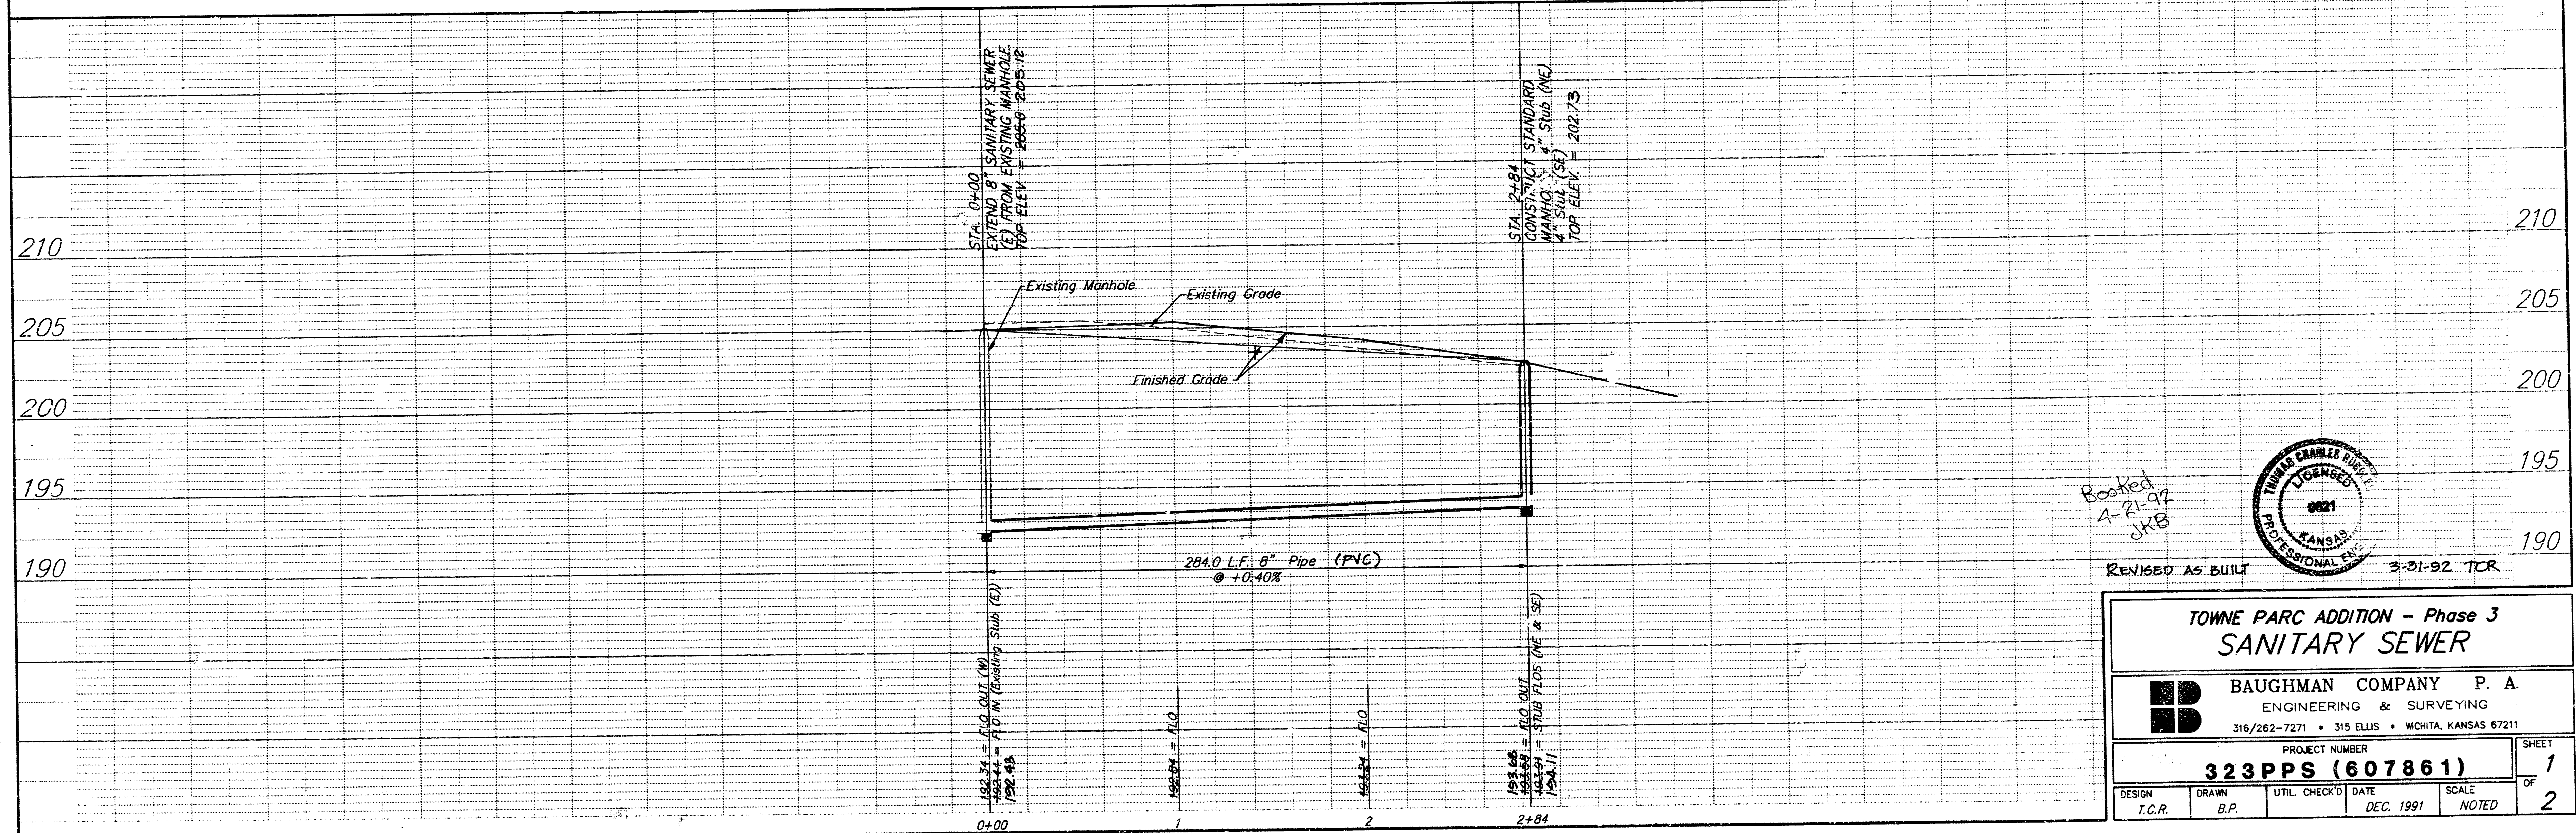

Booked  
4-21-92  
JKB

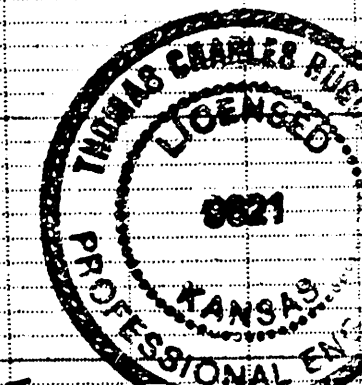

REVISED AS BUILT

3-31-92 TCR

TOWNE PARC ADDITION - Phase 3  
SANITARY SEWER

BAUGHMAN COMPANY P. A.  
ENGINEERING & SURVEYING  
316/262-7271 • 315 ELLIS • WICHITA, KANSAS 67211

PROJECT NUMBER  
**323PPS (607861)**

DESIGN T.C.R. DRAWN B.P. UTIL. CHECKED DATE DEC. 1991 SCALE NOTED

SHEET 1 OF 2