


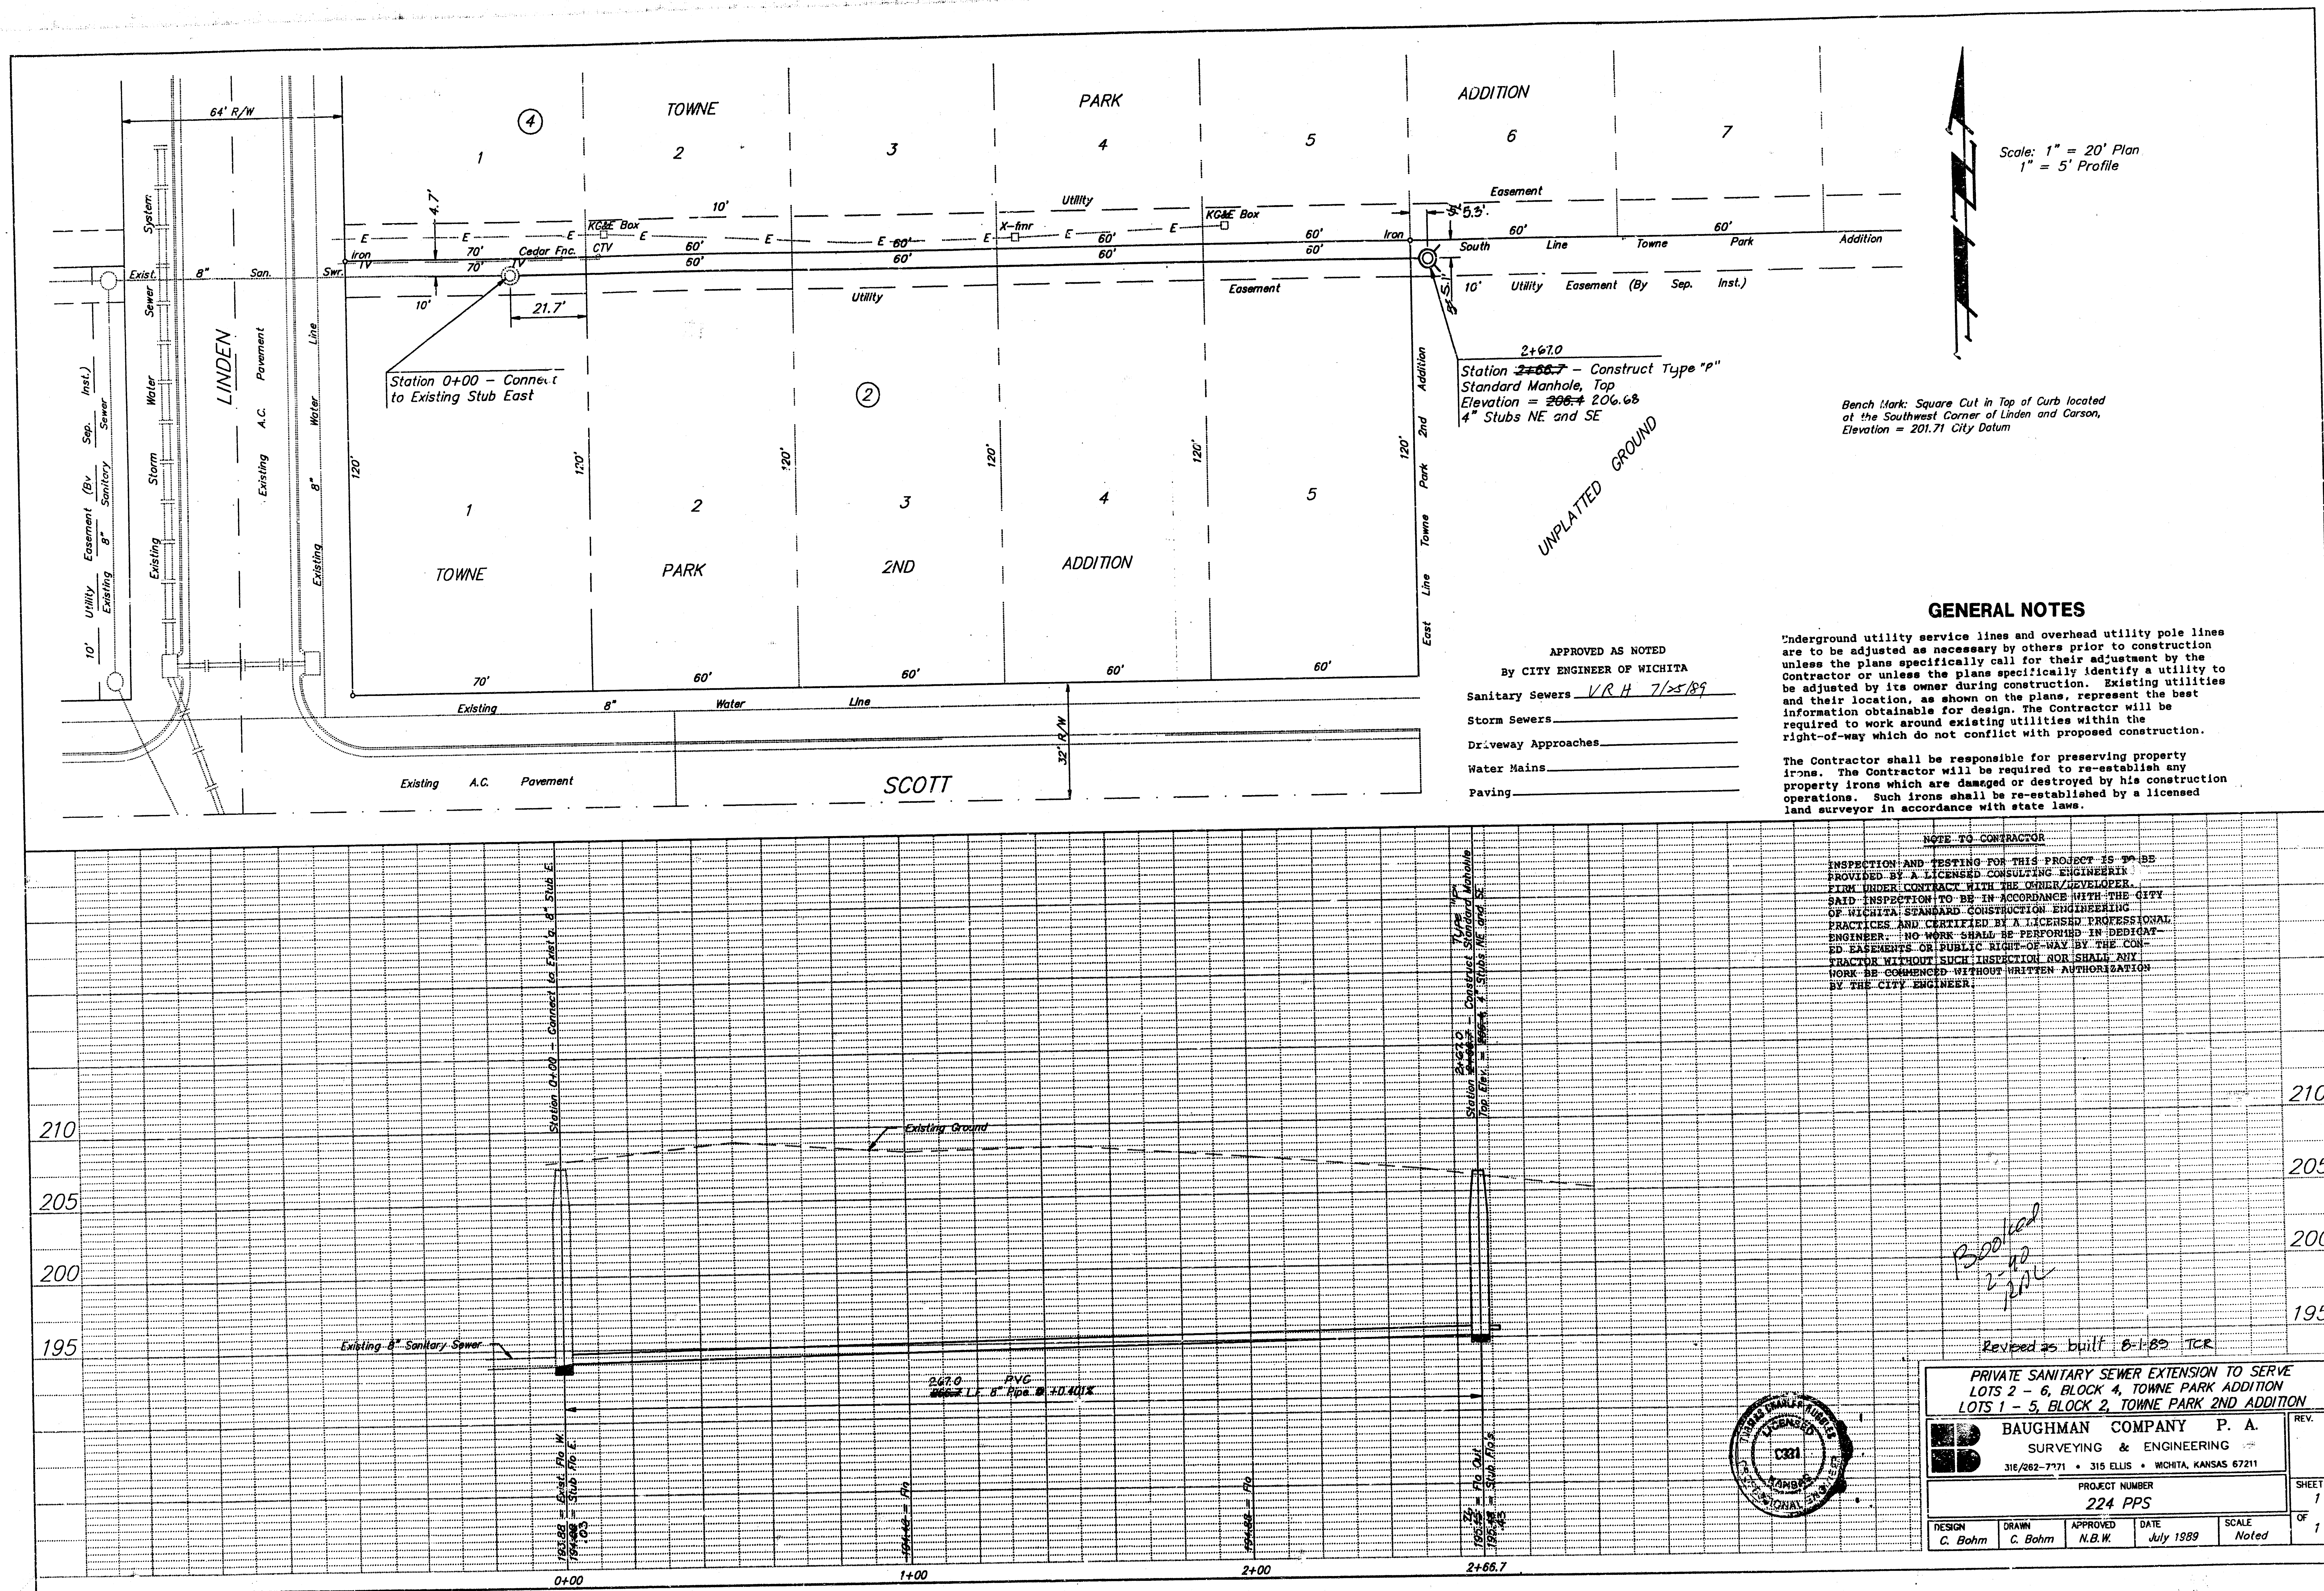

GENERAL NOTES

Underground utility service lines and overhead utility pole lines are to be adjusted as necessary by others prior to construction unless the plans specifically call for their adjustment by the Contractor or unless the plans specifically identify a utility to be adjusted by its owner during construction. Existing utilities and their location, as shown on the plans, represent the best information obtainable for design. The Contractor will be required to work around existing utilities within the right-of-way which do not conflict with proposed construction.

The Contractor shall be responsible for preserving property irons. The Contractor will be required to re-establish any property irons which are damaged or destroyed by his construction operations. Such irons shall be re-established by a licensed land surveyor in accordance with state laws.

NOTE TO CONTRACTOR

INSPECTION AND TESTING FOR THIS PROJECT IS TO BE PROVIDED BY A LICENSED CONSULTING ENGINEERIN FIRM UNDER CONTRACT WITH THE OWNER/DEVELOPER. SAID INSPECTION TO BE IN ACCORDANCE WITH THE CITY OF WICHITA STANDARD CONSTRUCTION ENGINEERING PRACTICES AND CERTIFIED BY A LICENSED PROFESSIONAL ENGINEER. NO WORK SHALL BE PERFORMED IN DEDICATED EASEMENTS OR PUBLIC RIGHT-OF-WAY BY THE CONTRACTOR WITHOUT SUCH INSPECTION AND AUTHORIZATION BY THE CITY ENGINEER.

Revised as built 8-1-89 TCR

PRIVATE SANITARY SEWER EXTENSION TO SERVE LOTS 2 - 6, BLOCK 4, TOWNE PARK ADDITION LOTS 1 - 5, BLOCK 2, TOWNE PARK 2ND ADDITION

BAUGHMAN COMPANY P. A. SURVEYING & ENGINEERING 315 ELLIS • WICHITA, KANSAS 67211		REV.
PROJECT NUMBER 224 PPS		SHEET 1 OF 1
DESIGN C. Bohm	DRAWN C. Bohm	APPROVED N.B.W.
DATE July 1989		SCALE Noted

FILMED FROM THE BEST AVAILABLE COPY....

Scale: 1" = 20' Plan
1" = 5' Profile

Bench Mark: Square Cut in Top of Curb located at the Southwest Corner of Linden and Carson, Elevation = 201.71 City Datum

GENERAL NOTES

Underground utility service lines and overhead utility pole lines are to be adjusted as necessary by others prior to construction unless the plans specifically call for their adjustment by the Contractor or unless the plans specifically identify a utility to be adjusted by its owner during construction. Existing utilities and their location, as shown on the plans, represent the best information obtainable for design. The Contractor will be required to work around existing utilities within the right-of-way which do not conflict with proposed construction.

The Contractor shall be responsible for preserving property irons. The Contractor will be required to re-establish any property irons which are damaged or destroyed by his construction operations. Such irons shall be re-established by a licensed land surveyor in accordance with state laws.

APPROVED AS NOTED
By CITY ENGINEER OF WICHITA

Sanitary Sewers VRH 7/25/89

Storm Sewers

Driveway Approaches


Water Mains

Paving

NOTE TO CONTRACTOR

INSPECTION AND TESTING FOR THIS PROJECT IS TO BE PROVIDED BY A LICENSED CONSULTING ENGINEERING FIRM UNDER CONTRACT WITH THE OWNER/DEVELOPER. SAID INSPECTION TO BE IN ACCORDANCE WITH THE CITY OF WICHITA STANDARD CONSTRUCTION ENGINEERING PRACTICES AND CERTIFIED BY A LICENSED PROFESSIONAL ENGINEER. NO WORK SHALL BE PERFORMED IN DEDICATED EASEMENTS OR PUBLIC RIGHT-OF-WAY BY THE CONTRACTOR WITHOUT SUCH INSPECTION NOR SHALL ANY WORK BE COMMENCED WITHOUT WRITTEN AUTHORIZATION BY THE CITY ENGINEER.

PRIVATE SANITARY SEWER EXTENSION TO SERVE LOTS 2 - 6, BLOCK 4, TOWNE PARK ADDITION LOTS 1 - 5, BLOCK 2, TOWNE PARK 2ND ADDITION			
BAUGHMAN COMPANY P. A. SURVEYING & ENGINEERING 316/262-7271 • 315 ELLIS • WICHITA, KANSAS 67211		REV.	
PROJECT NUMBER 224 PPS		SHEET 1 OF 1	
DESIGN C. Bohm	DRAWN C. Bohm	APPROVED N.B.W.	DATE July 1989
SCALE Noted		2/	

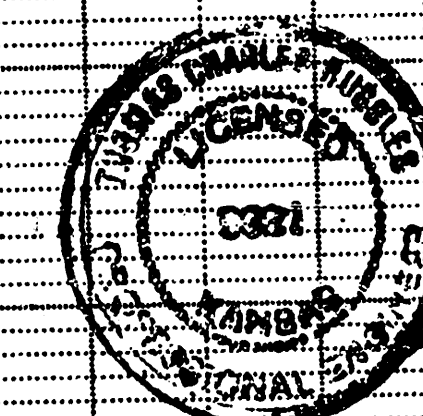

FILMED FROM THE BEST
AVAILABLE COPY