


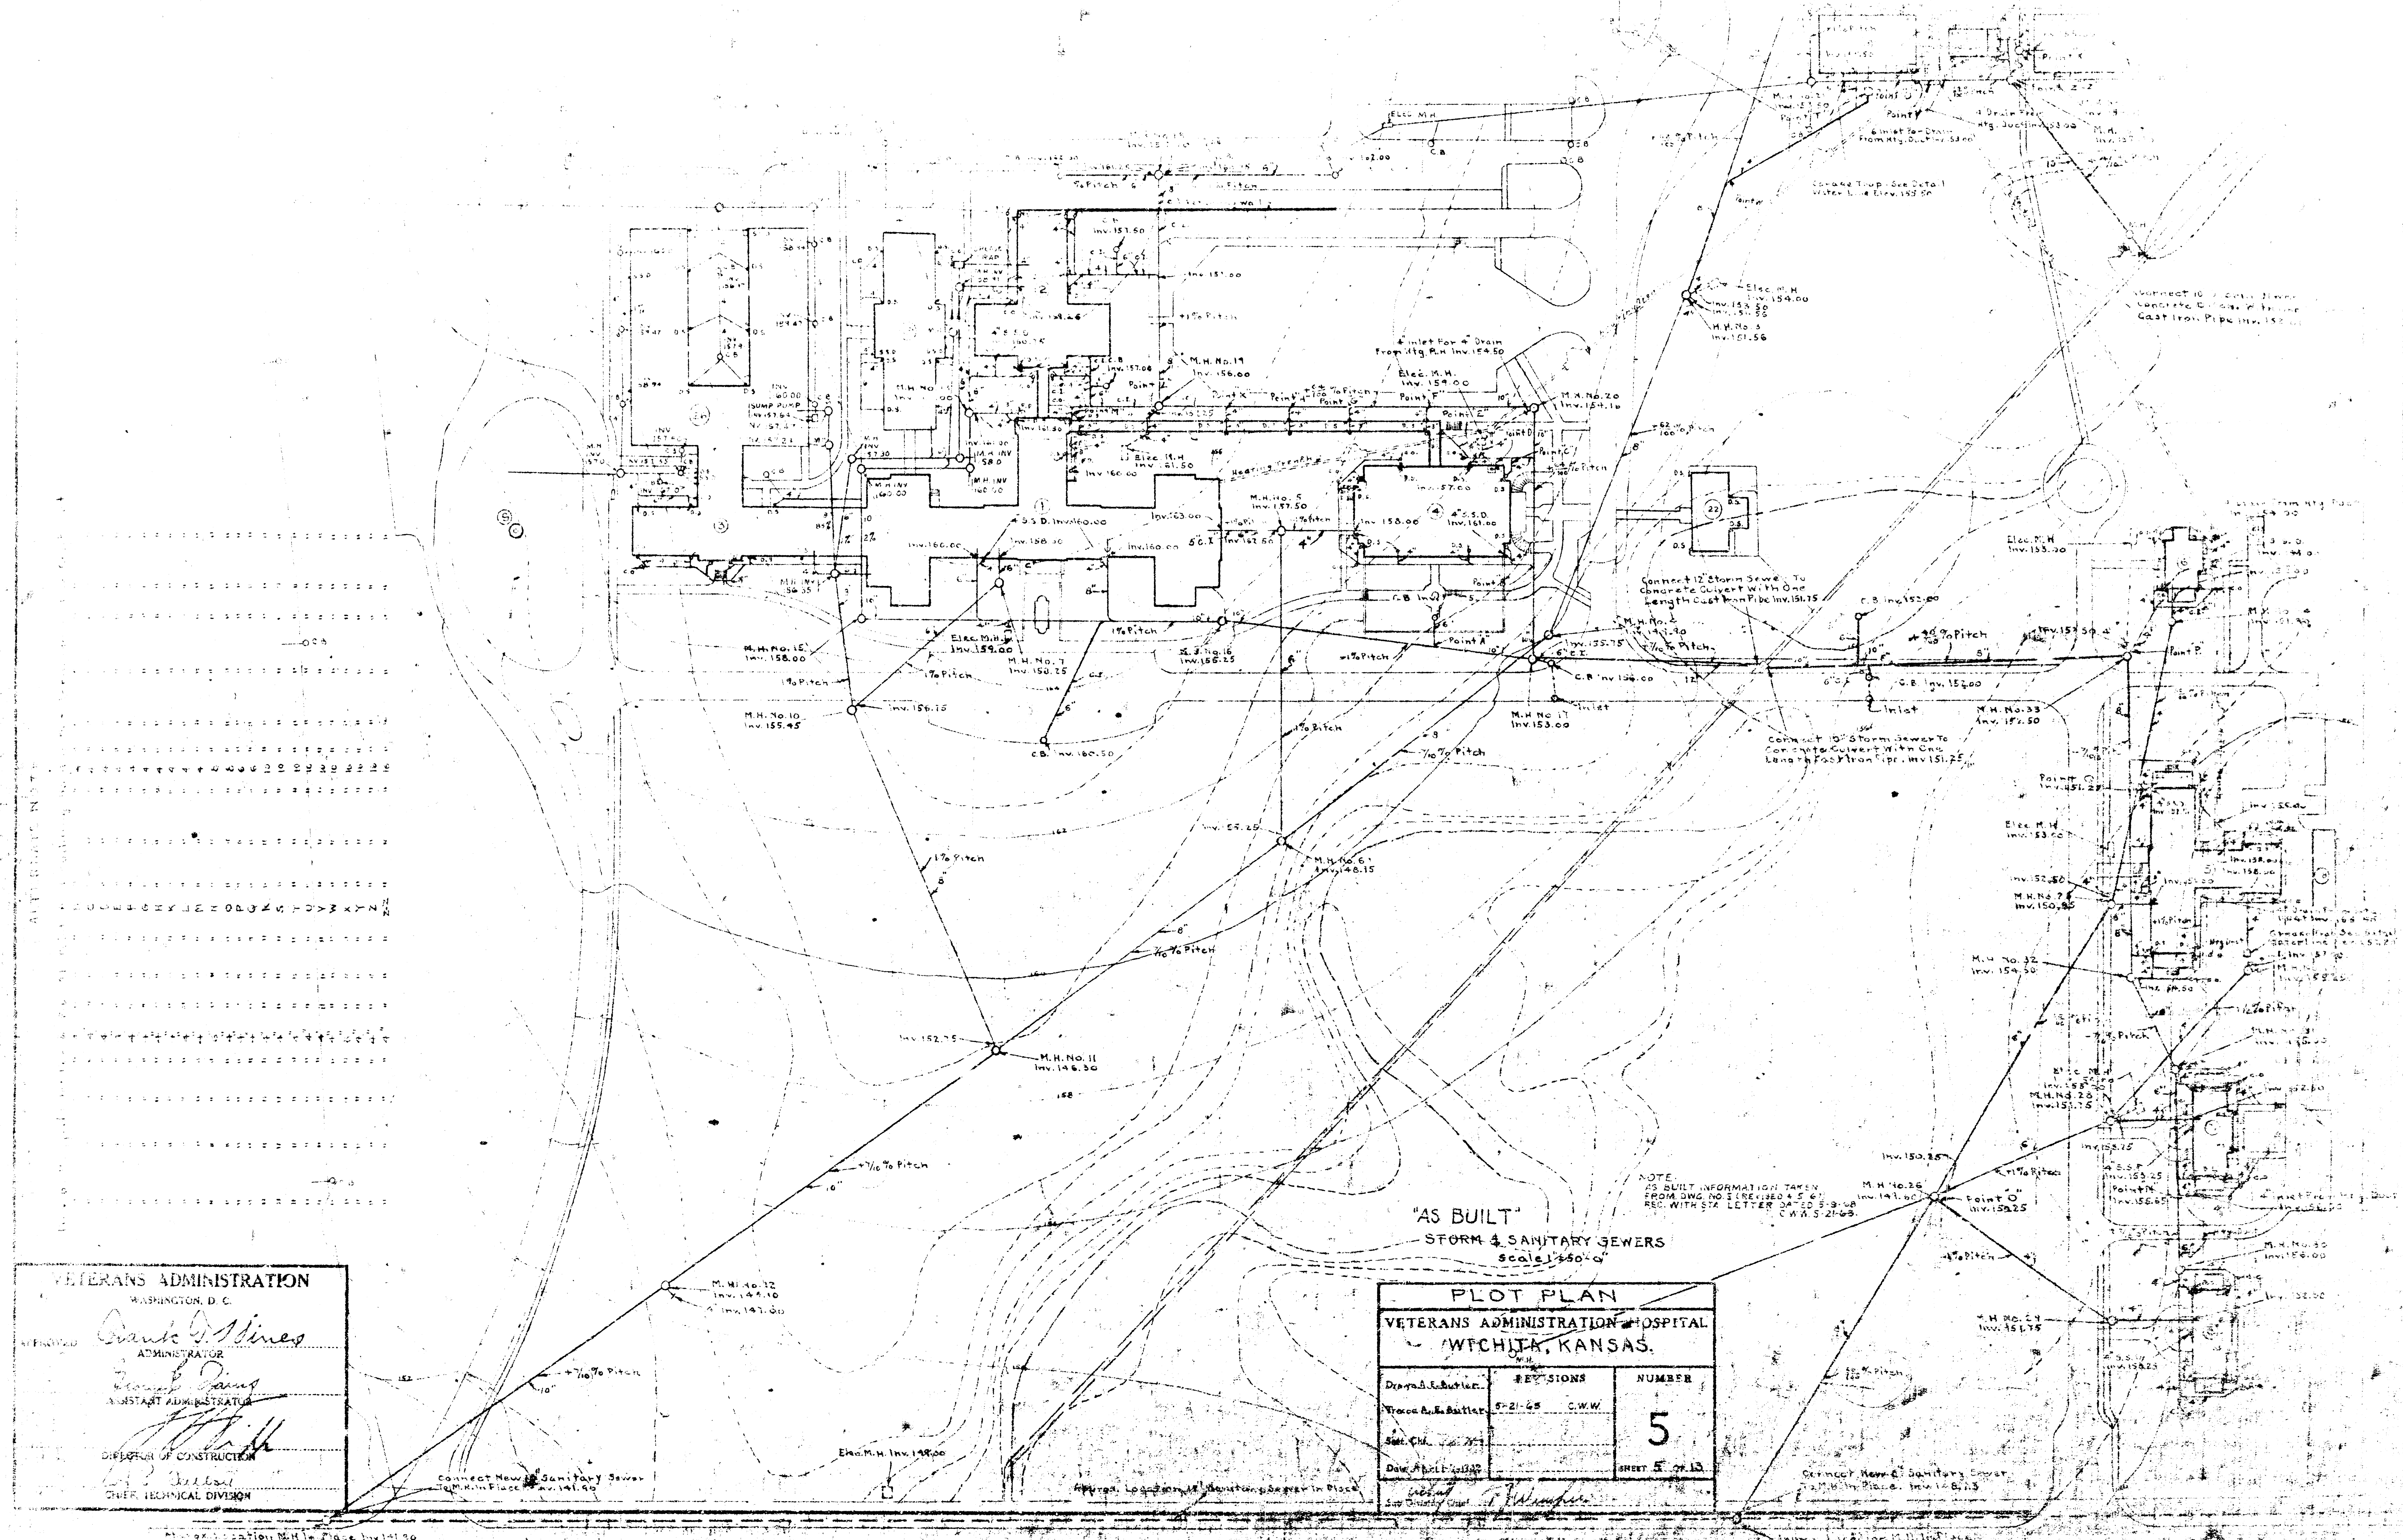

VETERANS ADMINISTRATION
WASHINGTON, D. C.

APPROVED *Frank G. Hines*
ADMINISTRATOR
George B. Jones
ASSISTANT ADMINISTRATOR

DIRECTOR OF CONSTRUCTION
W. H. Melvin
CHIEF, TECHNICAL DIVISION

Water and Meter Pk. Furnished
And Installed By Water Co.
Connect 8" Hard Water
To 6" City Water At Curb

8" Water Main Installed By Water Co.

NOTE:
AS BUILT INFORMATION TAKEN FROM
DWG. NO. 6 (REVISED 6-6-57) REC.
WITH STA. LETTER DATED 3-9-58
C.W.W. 6 3-58

"AS BUILT"
WATER & GAS

PLOT PLAN
VETERANS ADMINISTRATION HOSPITAL
WICHITA, KANSAS

Drawn By	REVISIONS	NUMBER
Tracy H. Smith		6
Sett. Chg. 4-1-57		
Date April 2, 1957		SHEET 6 OF 15
Sub-Division Chief <i>J. H. Smith</i>		

RETURN TO: 1000 10th St. N.W.

FILE FOLDER NO.