
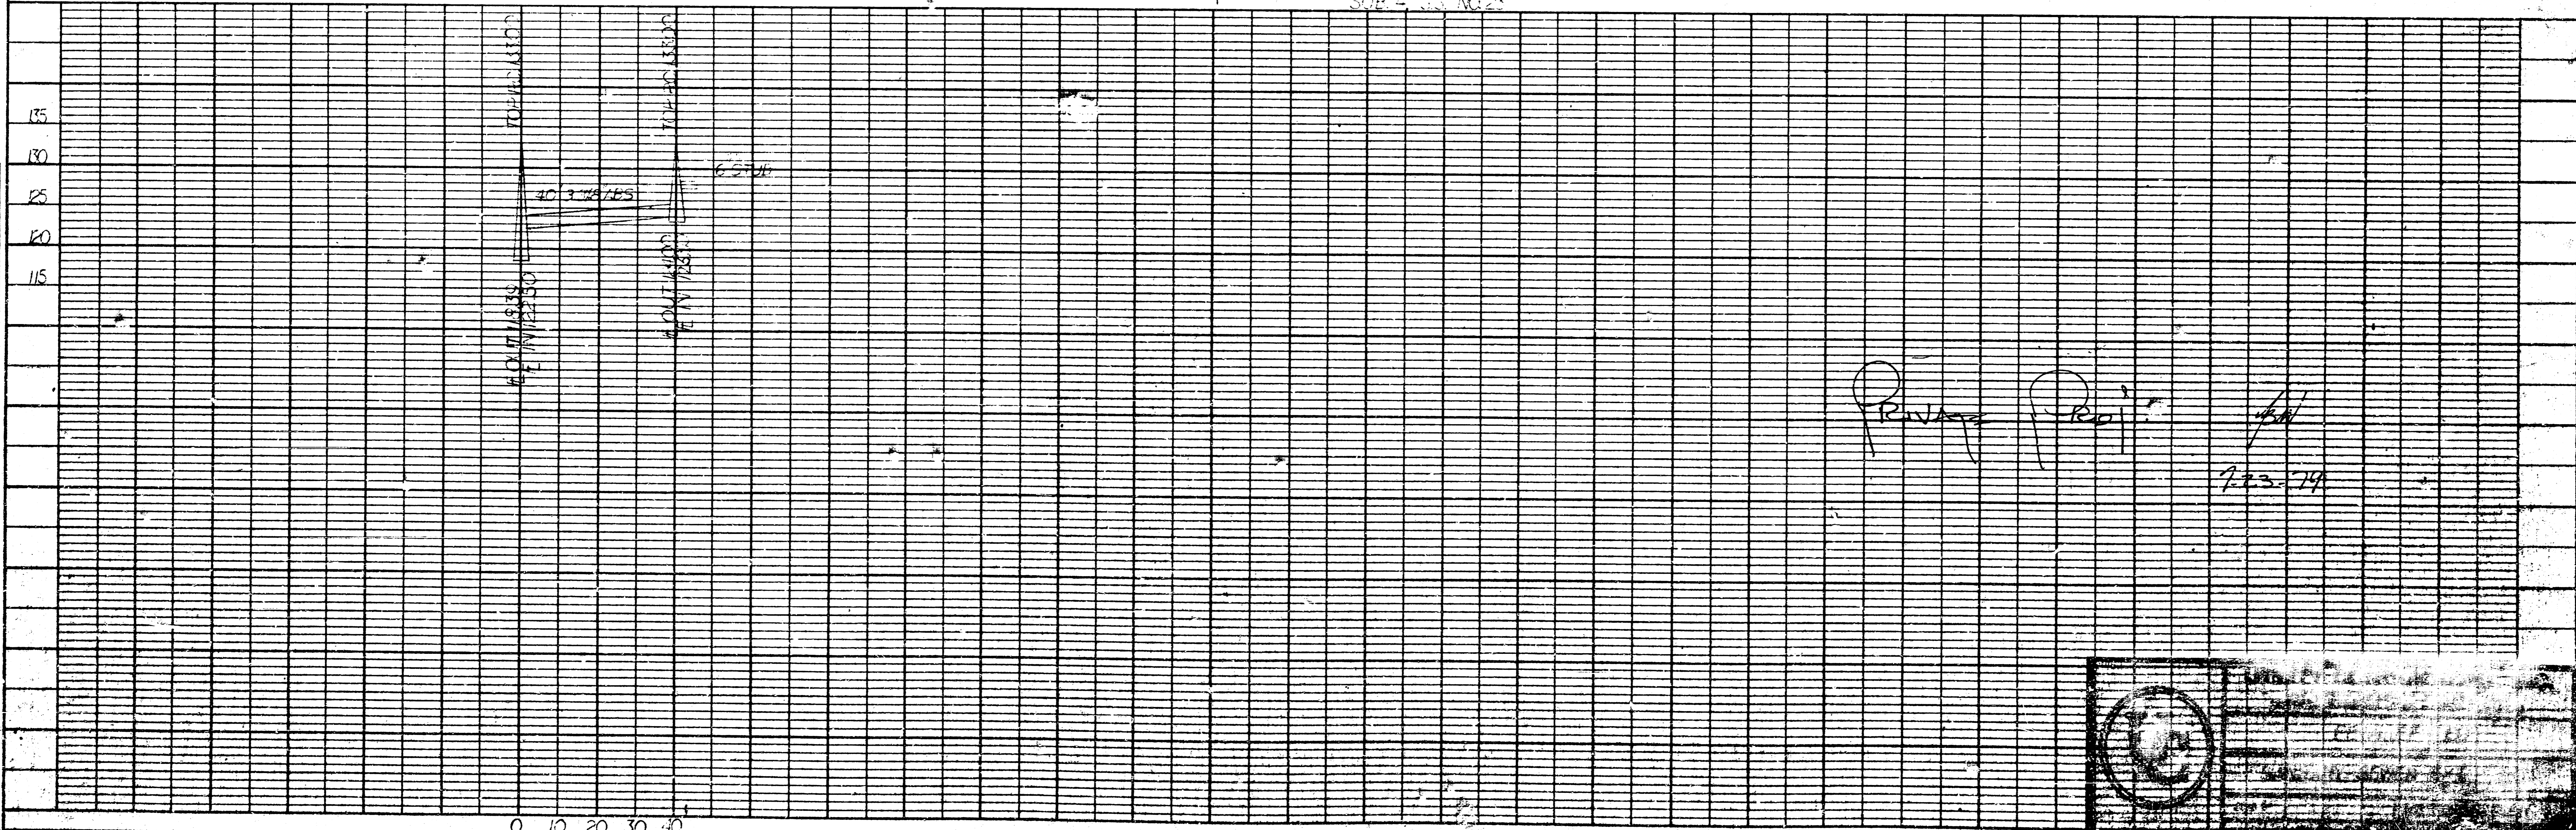


PLAN
 DATE: _____
 BY: _____
 CHECKED: _____
 IN CHARGE: _____
 NOTE: BOOK ALIGNED CHECKED
 NO. _____

PROFILE
 DATE: _____
 BY: _____
 CHECKED: _____
 IN CHARGE: _____
 NOTE: BOOK ALIGNED CHECKED
 NO. _____

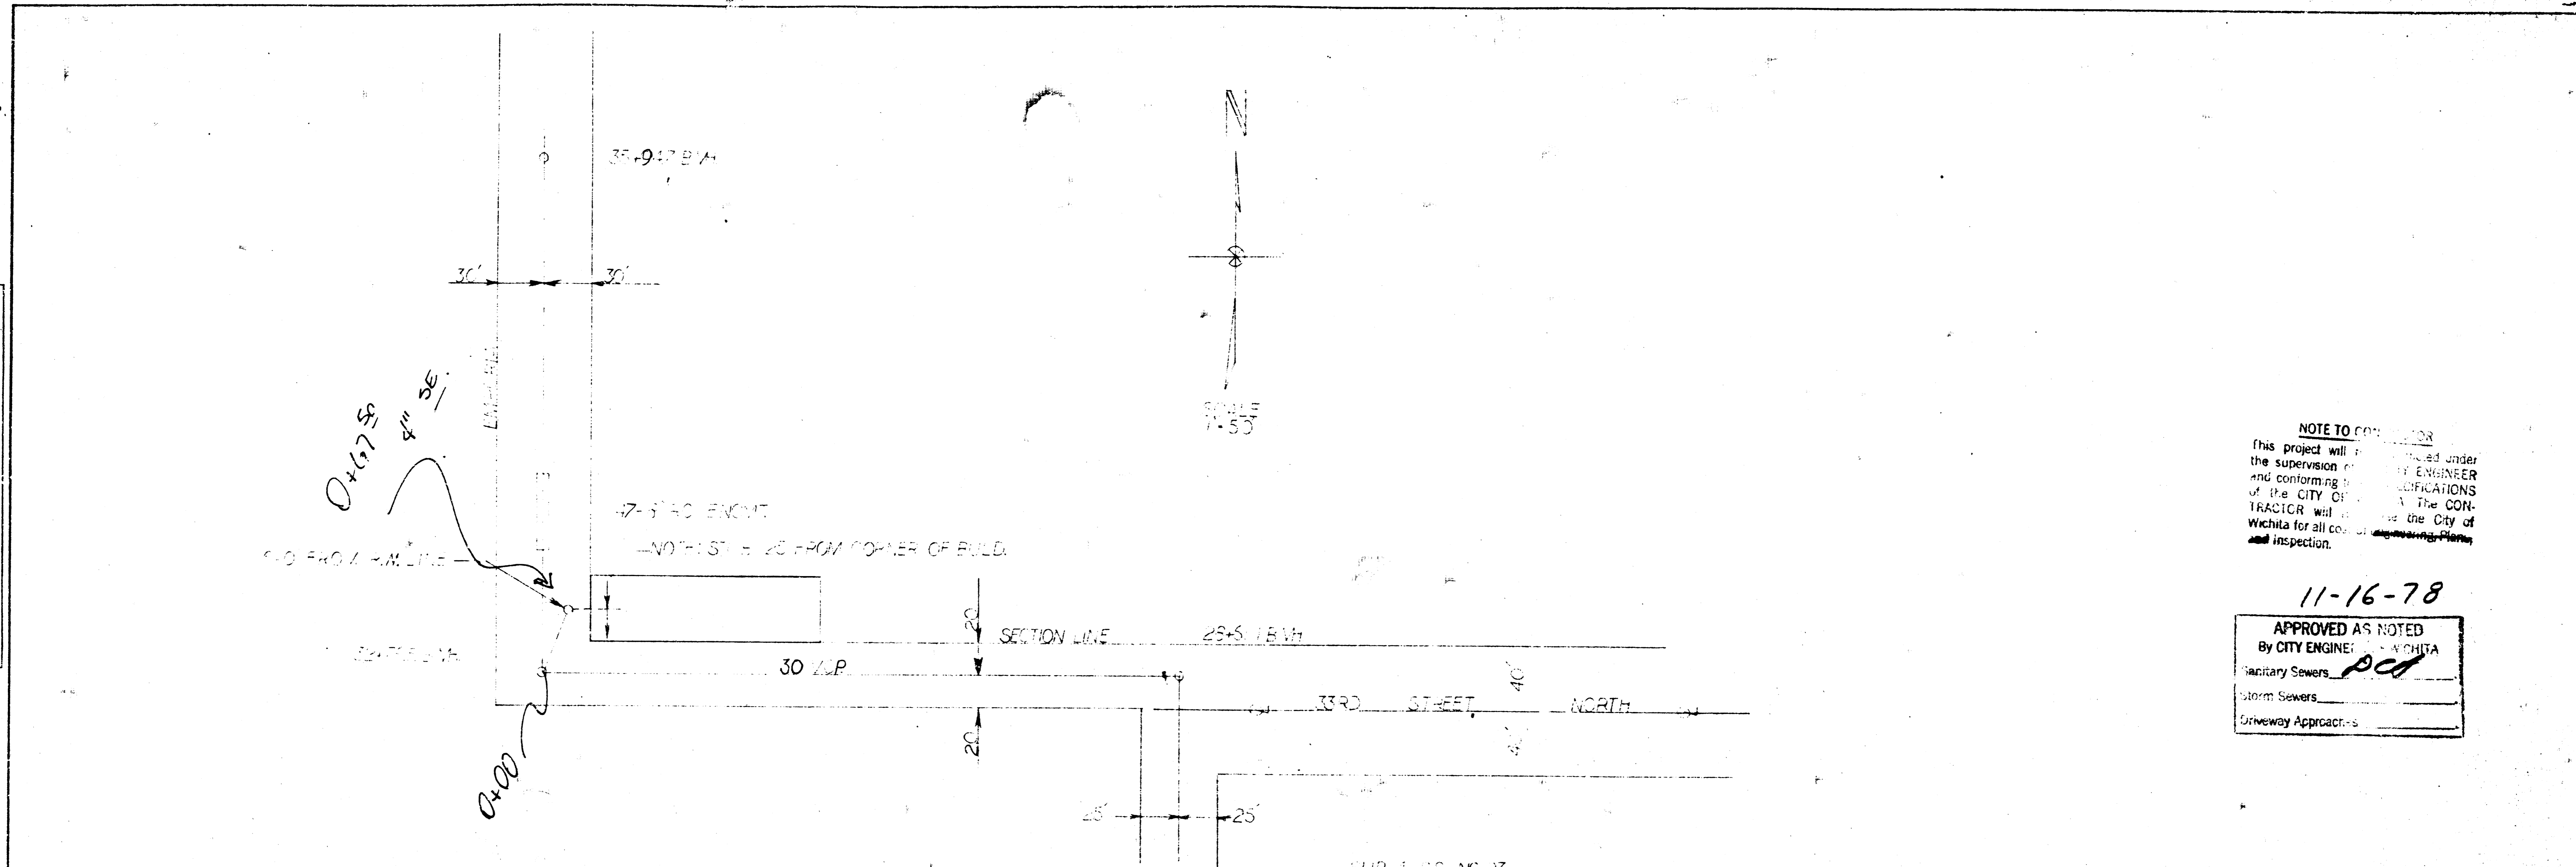

NOTE TO CONTRACTOR
 This project will be installed under the supervision of the CITY ENGINEER and conforming to the SPECIFICATIONS of the CITY OF WICHITA. The CONTRACTOR will be responsible for the City of Wichita for all costs of ~~inspecting~~ inspection.

11-16-78
 APPROVED AS NOTED
 By CITY ENGINEER WICHITA
 Sanitary Sewers *PCA*
 Storm Sewers _____
 Driveway Approaches _____

Private Property
 723-74

