

B. M. 102.82 R.R. Spk. S.S. H.L.P. 30' S. of N.L.
 110' W. Ind. Addn. 4' to E. of West St.

B. M. 109.07 R.R. Spk. E. face P.P. 30.5' N. of C.R.
 May St. 38.9' W. of C.R. West St.

B. M. 111.58 R.R. Spk. W. face tale. Pole NE cor.
 Dora and West.

Sta. -0110.0 Const.
 Std. M.H. Type "A"
 Install 8" Plug SW

Sta. 0100.0 Remove
 Clust. M.H.
 Beg. 8" Clay Pipe
 Plug Pipe east

Sta. 0149.5 Const.
 Std. M.H. Type "A"
 45' 8" from West

Sta. 0149.5 Const.
 Std. M.H. Type "A"
 45' 8" from West

Sta. 0149.5 Const.
 Std. M.H. Type "A"
 45' 8" from West

NOTE:
 Contractor to uncover
 12" Pipe at Sta. -1130.0-31+
 to verify Flo Elev.
 prior to construction.

Sta. -1130.0 Const.
 Std. M.H. Type "A"
 over Exst. 12" S.S.
 Plug Pipe West.


Sta. 0149.5 Const.
 Std. M.H. Type "A"
 45' 8" from West

Sta. 1162.0 Const.
 Std. M.H. Type "A"
 Sta. 0100.0 Line No. 2

Sta. 1162.0 Const.
 Std. M.H. Type "A"
 Sta. 0100.0 Line No. 3

Sta. 0135.0 Const.
 Std. M.H. Type "A"
 Sta. 0100.0 Line No. 4

Sta. 0145.0 Const.
 Std. M.H. Type "A"
 Plug pipe.

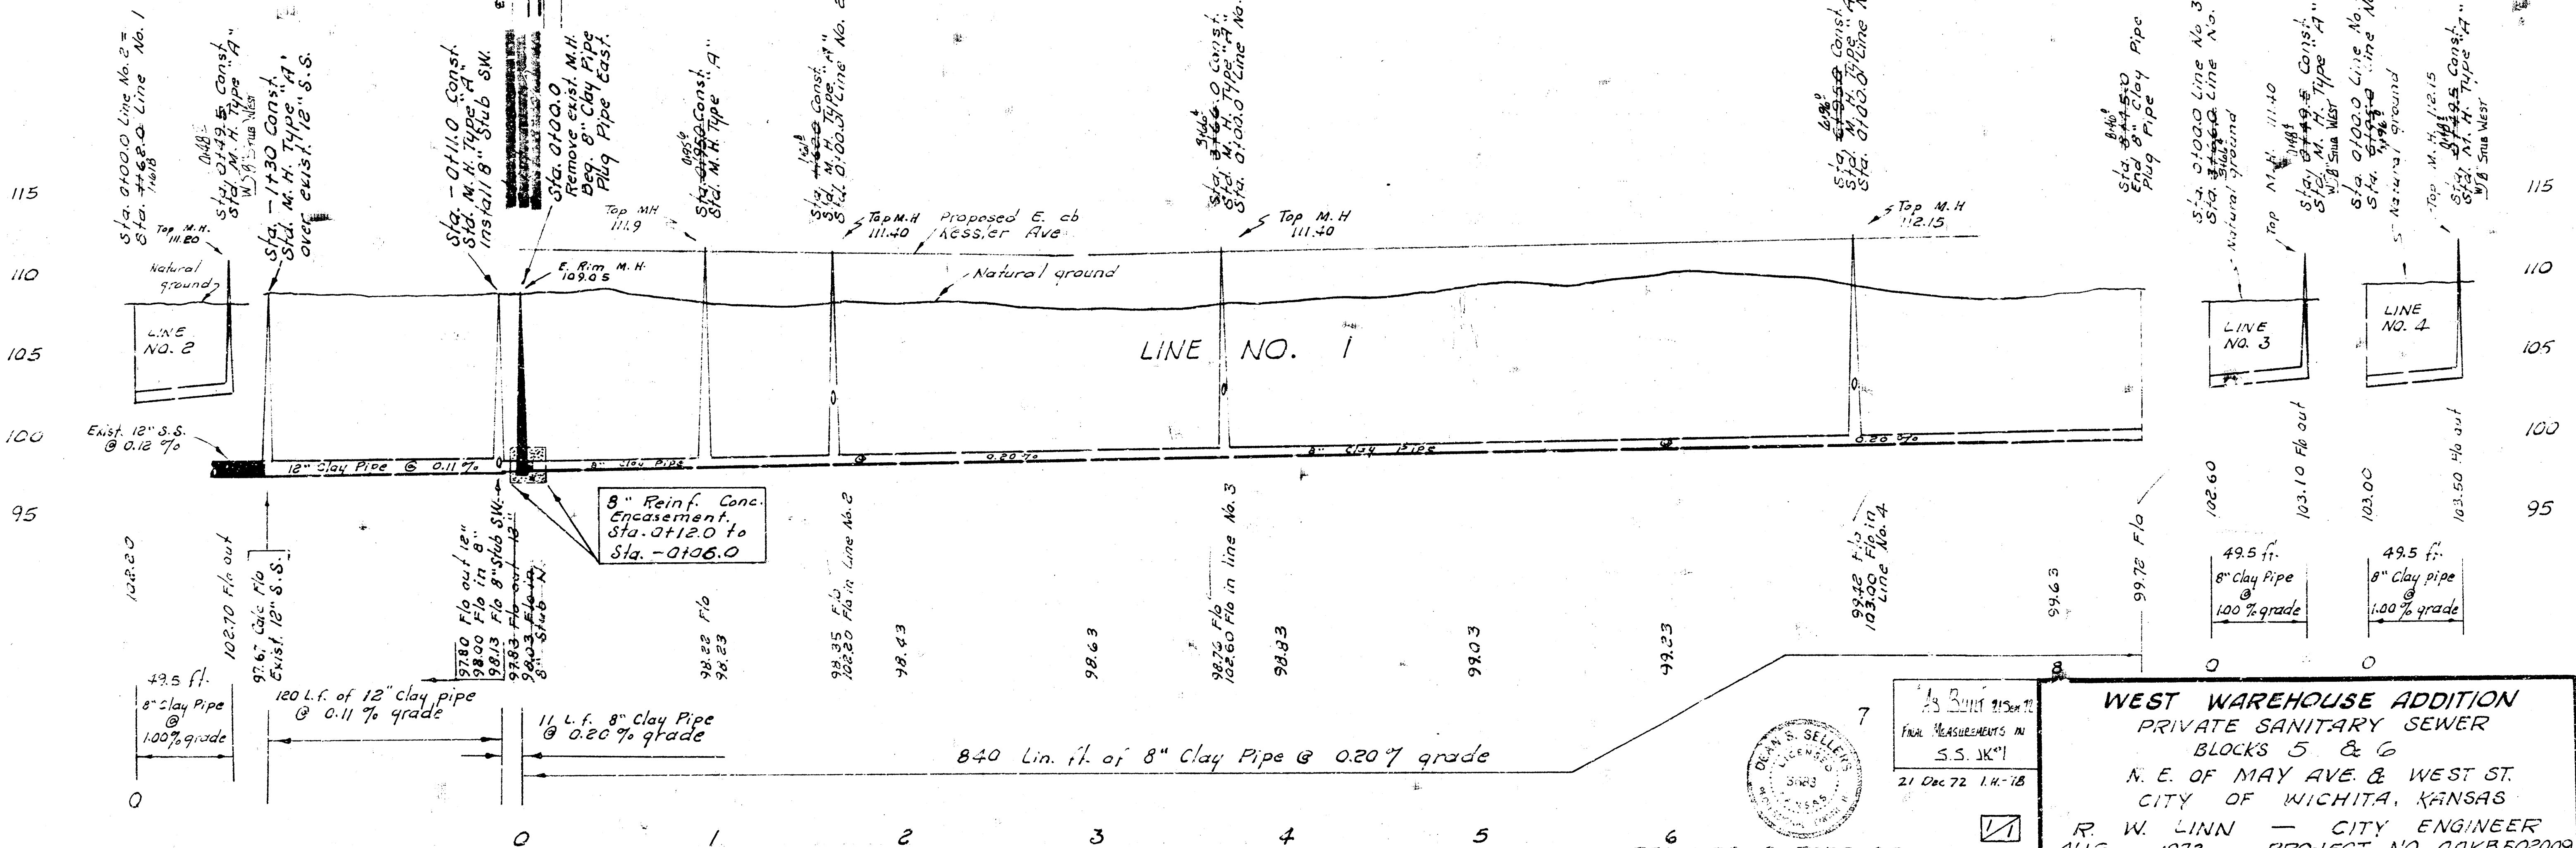

Plan Scale 1" = 40' Horiz.
 Profile Scale 1" = 5' Vert.

WEST WAREHOUSE ADDITION
 PRIVATE SANITARY SEWER
 BLOCKS 5 & 6
 N. E. OF MAY AVE. & WEST ST.
 CITY OF WICHITA, KANSAS
 R. W. LINN — CITY ENGINEER
 AUG. 1972 PROJECT NO. AAKB502009

B. M. 109.82 R. R. Sph. S.S. H.L.P. 30' S. of N.L.
Alcorn Ind. Adn. & 70' E. of West St.

B. M. 109.07 R. R. Sph. E. face P.P. 30.5' N. of ctr.
May St. - 38.8' W. of Ctr. West St.

B. M. 111.58 R. R. Sph. W. face tele. Pole NE
Dora and West.

Sta. - 0+110.0 Const.
Std. M. H. Type "A"
Install 8" Stub SW

Sta. 0+100.0 Remove
Exist. M. H.
Beg. 8" Clay Pipe
Plug Pipe East

8" Reinf. Concrete
Encasement. Sta. 0+120
to Sta. - 0+06.0

Sta. 0+149.5 Const.
Std. M. H. Type "A"
5'8" Stub West

Sta. 0+149.5 Const.
Std. M. H. Type "A"
5'8" Stub West

Sta. 0+149.5 Const.
Std. M. H. Type "A"
5'8" Stub West

NOTE:
Contractor to uncover
12" Pipe at Sta. 1+134.0-3+8
to Verify Fio Elev.
prior to construction.

Sta. - 1+34.0 Const.
Std. M. H. Type "A"
over Exist. 12" S.S.
Plug Pipe West.

Sta. 0+195.0 Const.
Std. M. H. Type "A"

Sta. 1+62.0 Const. Std. M. H.
Type "A"

Sta. 0+166.0 Const.
Std. M. H. Type "A"
Sta. 0+100.0 Line No. 3

Sta. 0+195.0 Const.
Std. M. H. Type "A"
Sta. 0+100.0 Line No. 4

Sta. 0+450.0 Const.
End 8" Clay Pipe
Plug pipe.

Plan Scale 1" = 40'
Profile Scale 1" = 40' Horiz.
1" = 5' Vert.

