
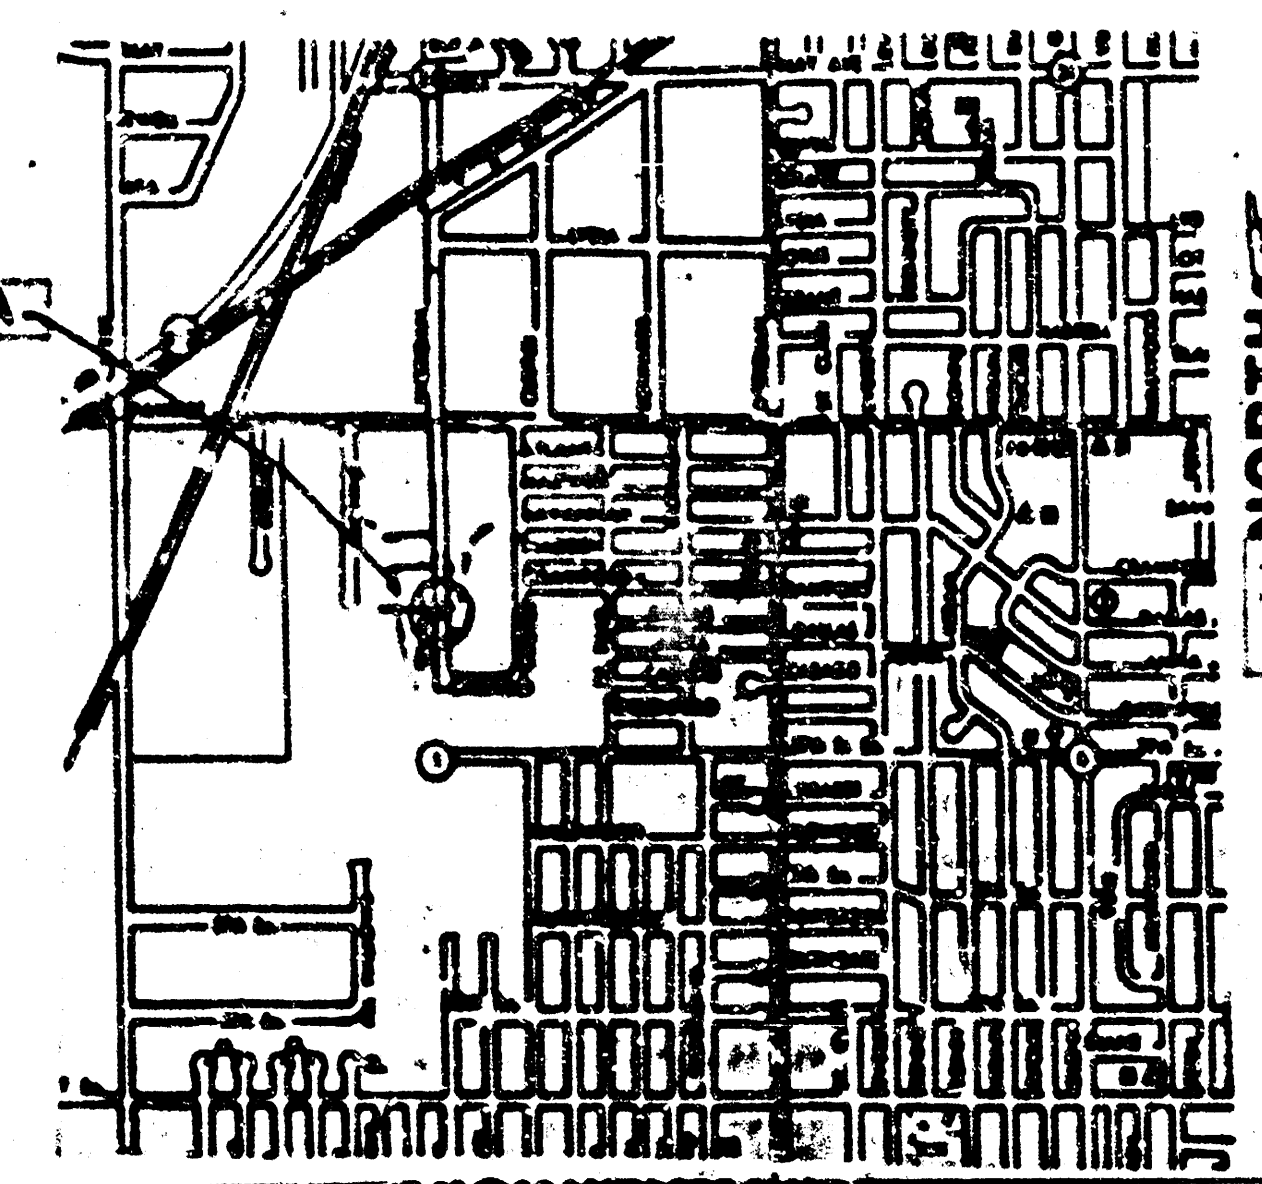


BENCH MARK: City 0130 @ Pawnee and Sheridan, Elev=103.29 City Datum  
 "X" Cur on High Edge West Side of Sheridan 107  
 South Line of Lot 1, Block 1, Westport Industrial Park First Addition = 102.68

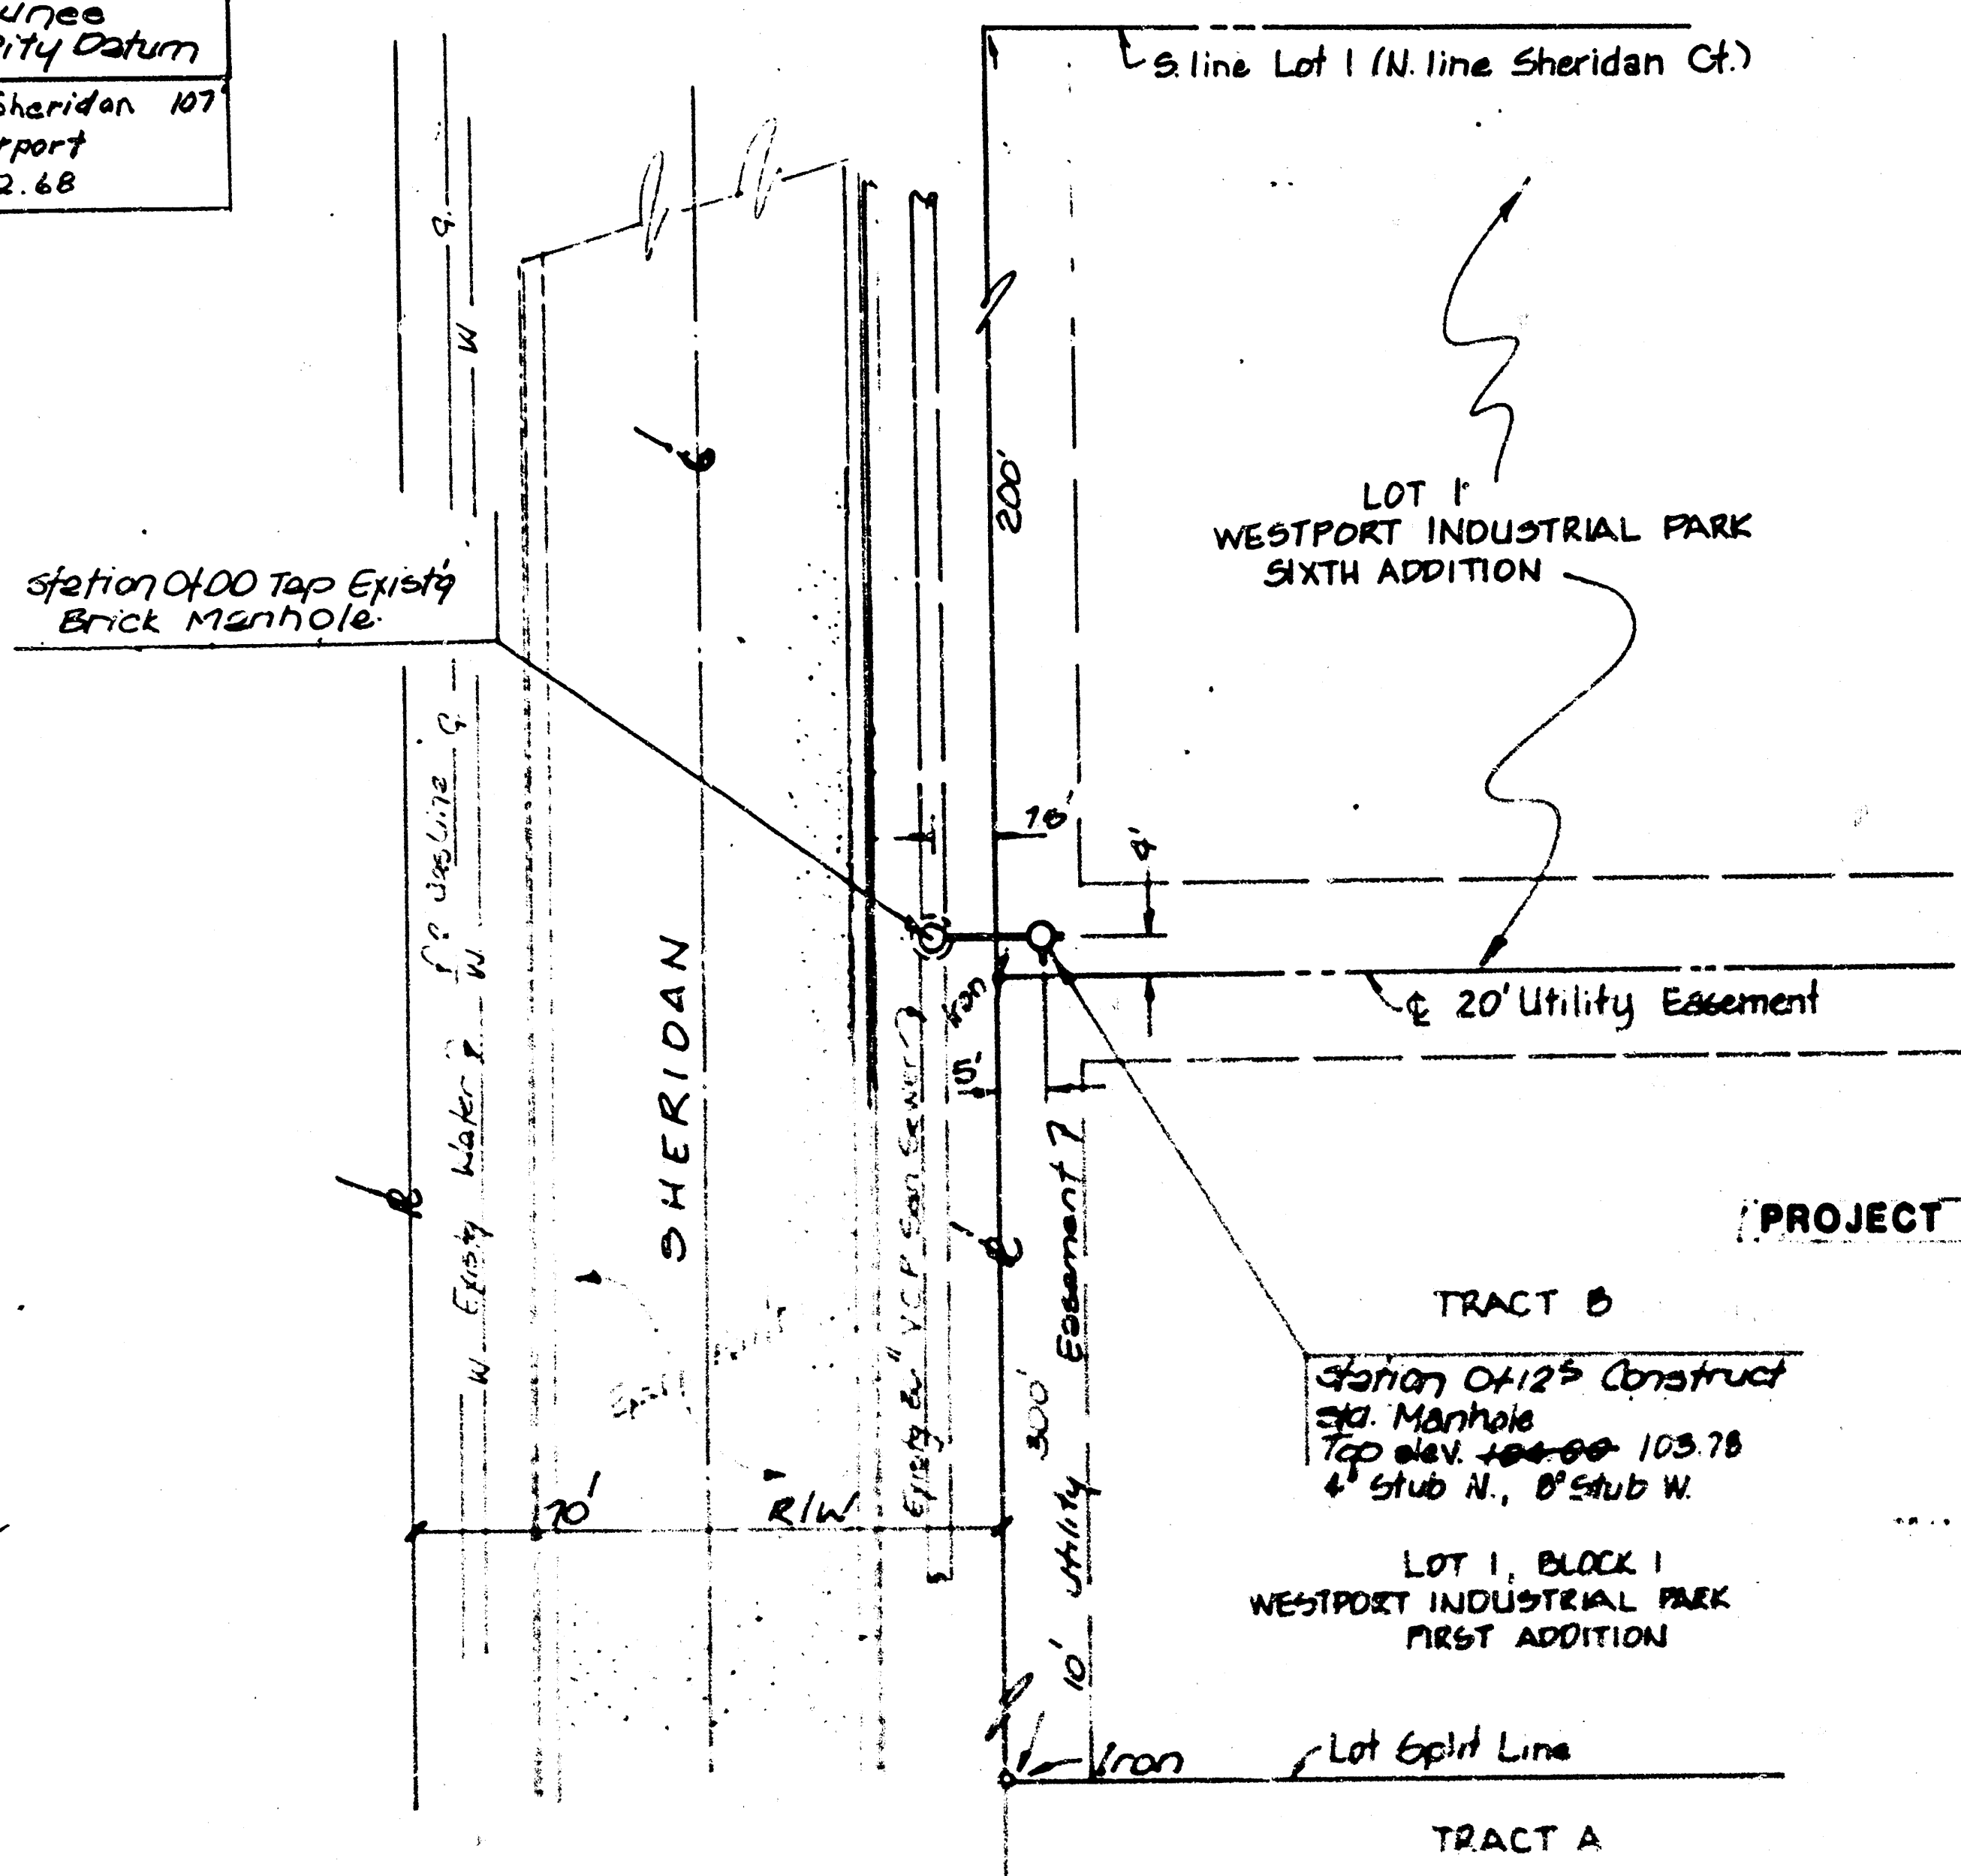

### GENERAL NOTES


- Contractor will be required to provide a minimum advance notice of twenty-four (24) hours to utility companies prior to starting any excavation as follows:  
 Kansas One-Call 1-800-344-7233  
 The Contractor must notify the following in case of an emergency:  
 Cable vision 262-4270 or 263-2061  
 K.P. & L. Gas Service Company 263-7511  
 Kansas Gas & Electric 264-1141  
 Arkla Gas Company 942-8350 or 263-8161  
 Southwest Bell Telephone Company 1-571-2611  
 City of Wichita Water Department 268-4908  
 City of Wichita Sewer Maintenance 268-4071
- Underground utility service lines and overhead utility pole lines are to be adjusted as necessary by others prior to construction unless the plans specifically call for their adjustment by the Contractor. Existing utilities and their location, as shown on the plans, represent the best information obtainable for design. The Contractor will be required to work around existing utilities within the right-of-way which do not conflict with proposed construction.
- The Contractor shall be responsible for maintaining continuous flow of sewage through construction. Contractor's proposed method for maintaining sewage flow shall be approved by the Engineer. Cost of maintaining flow of sewage through construction will not be paid for directly and this cost shall be considered as subsidiary to the other pay items of work.
- The Contractor shall be responsible for preserving property irons. The Contractor will be required to re-establish any property irons which are damaged or destroyed by his construction operations. Such irons shall be re-established by a licensed land surveyor or a licensed professional engineer in accordance with state laws.
- Contractor to verify the top of manhole elevation and the need for service line stubs prior to construction. Contact Dan Lies at 942-9592.

APPROVED AS NOTED  
 By CITY ENGINEER OF WICHITA  
 Sanitary Sewers *[Signature]* 5/1/10  
 Storm Sewers  
 Driveway Approaches  
 Water Mains  
 Paving

NOTE TO CONTRACTOR  
 INSPECTION AND TESTING FOR THIS PROJECT IS TO BE PROVIDED BY A LICENSED CONSULTING ENGINEERING FIRM UNDER CONTRACT WITH THE OWNER/DEVELOPER. SAID INSPECTION TO BE IN ACCORDANCE WITH THE CITY OF WICHITA STANDARD CONSTRUCTION ENGINEERING PRACTICES AND CERTIFIED BY A LICENSED PROFESSIONAL ENGINEER. NO WORK SHALL BE PERFORMED IN DEDICATED EASEMENTS OR PUBLIC RIGHT-OF-WAY BY THE CONTRACTOR WITHOUT SUCH INSPECTION NOR SHALL ANY WORK BE COMMENCED WITHOUT WRITTEN AUTHORIZATION BY THE CITY ENGINEER.

Revised as built 10-8-90 TCR  
**PRIVATE SANITARY SEWER  
 EXTENSION TO SERVE S. 300' OF LOT 1,  
 BLK. 1, WESTPORT INDUSTRIAL PARK  
 FIRST ADDN.  
 CITY OF WICHITA, KS**

PROJECT NO. 4-259 PPS 607861  
**BAUGHMAN COMPANY, P.A.**  
 SURVEYING & ENGINEERING  
 318/262-7271 • 315 ELLIS • WICHITA, KANSAS 67211 1/1



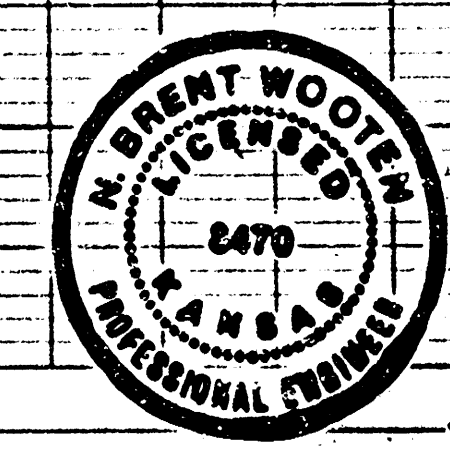


Aug. 1990

HIGHWAY FEDERAL AID SHEET  
 PLATE 1-SINGLE PLAN AND PROFILE-FULL LINE  
 11/10/90  
 PRINTED IN U.S.A.

FILMED FROM THE BEST  
 AVAILABLE COPY

BENCH MARK: City D.300 @ Pawnee and Sheridan, Elev. = 103.29 City Datum  
 X Cut on High Edge West Side of Sheridan 107  
 South Line of Lot 1, Block 1, Westport Industrial Park First Addition = 102.68

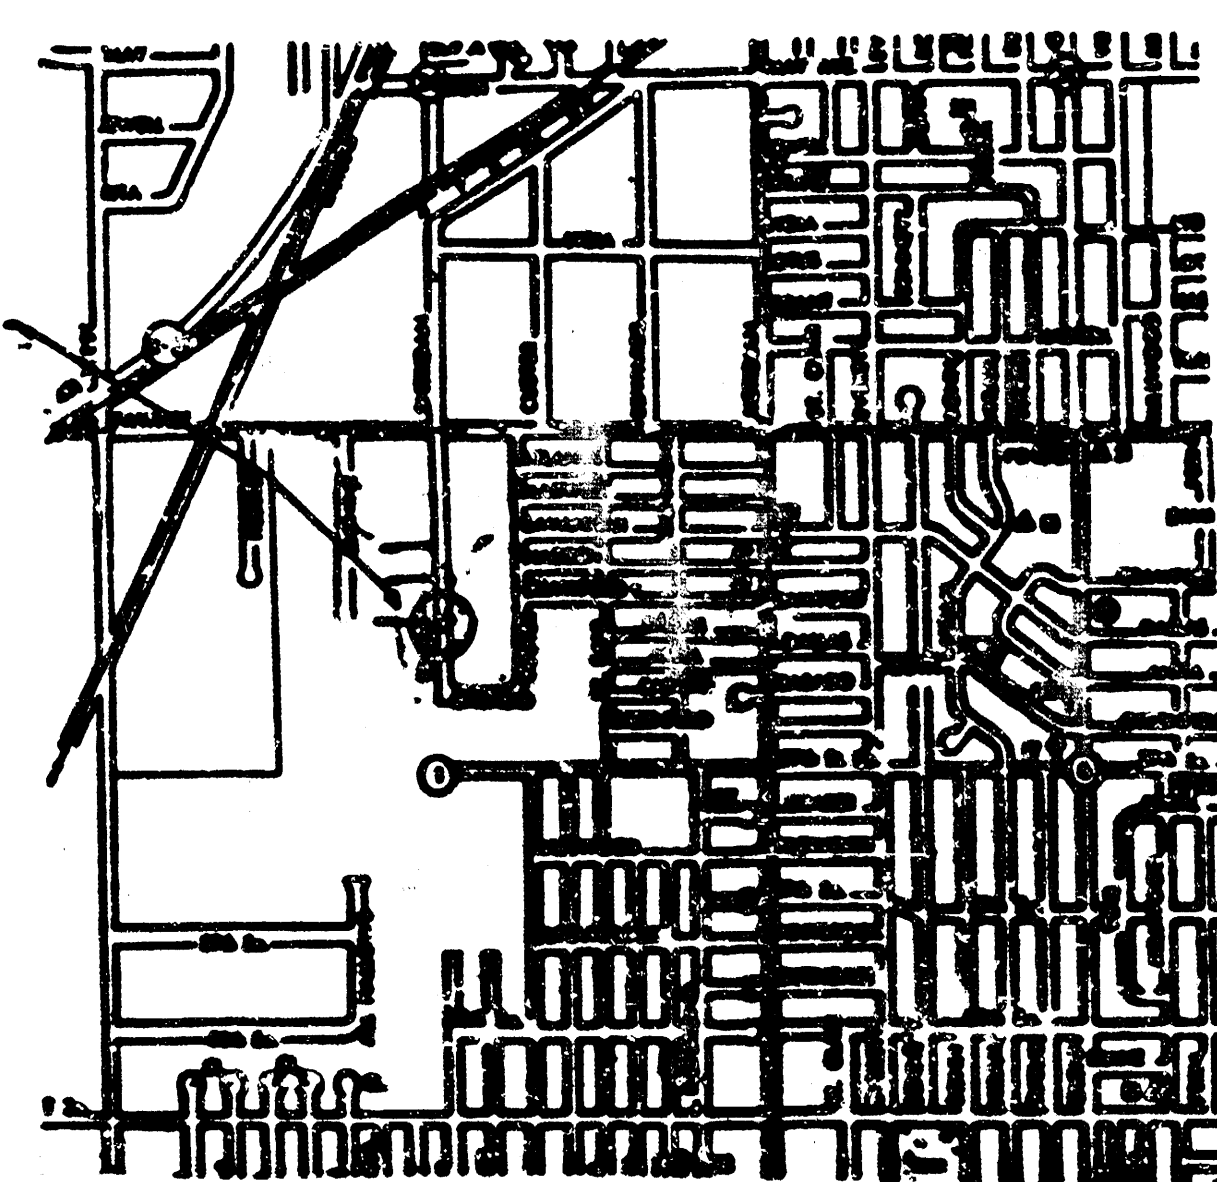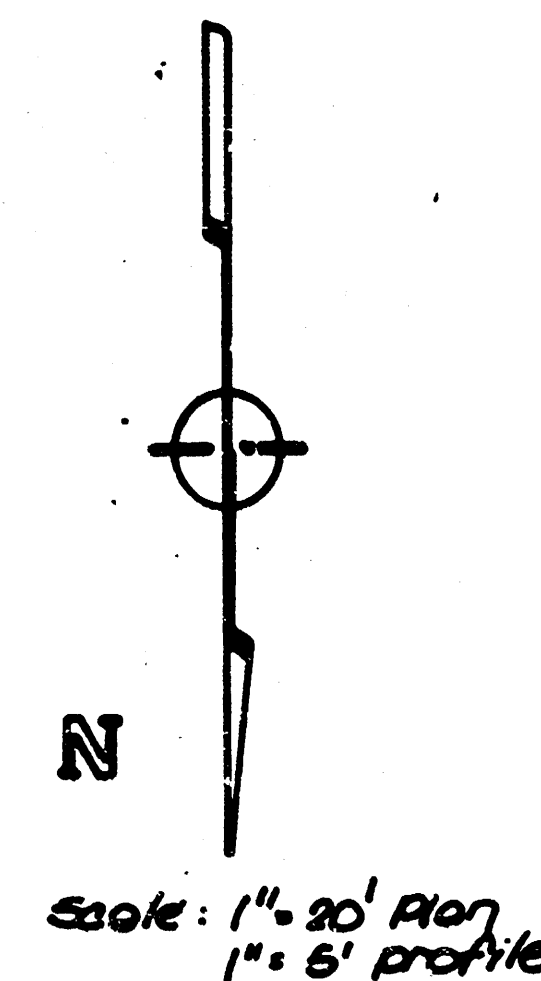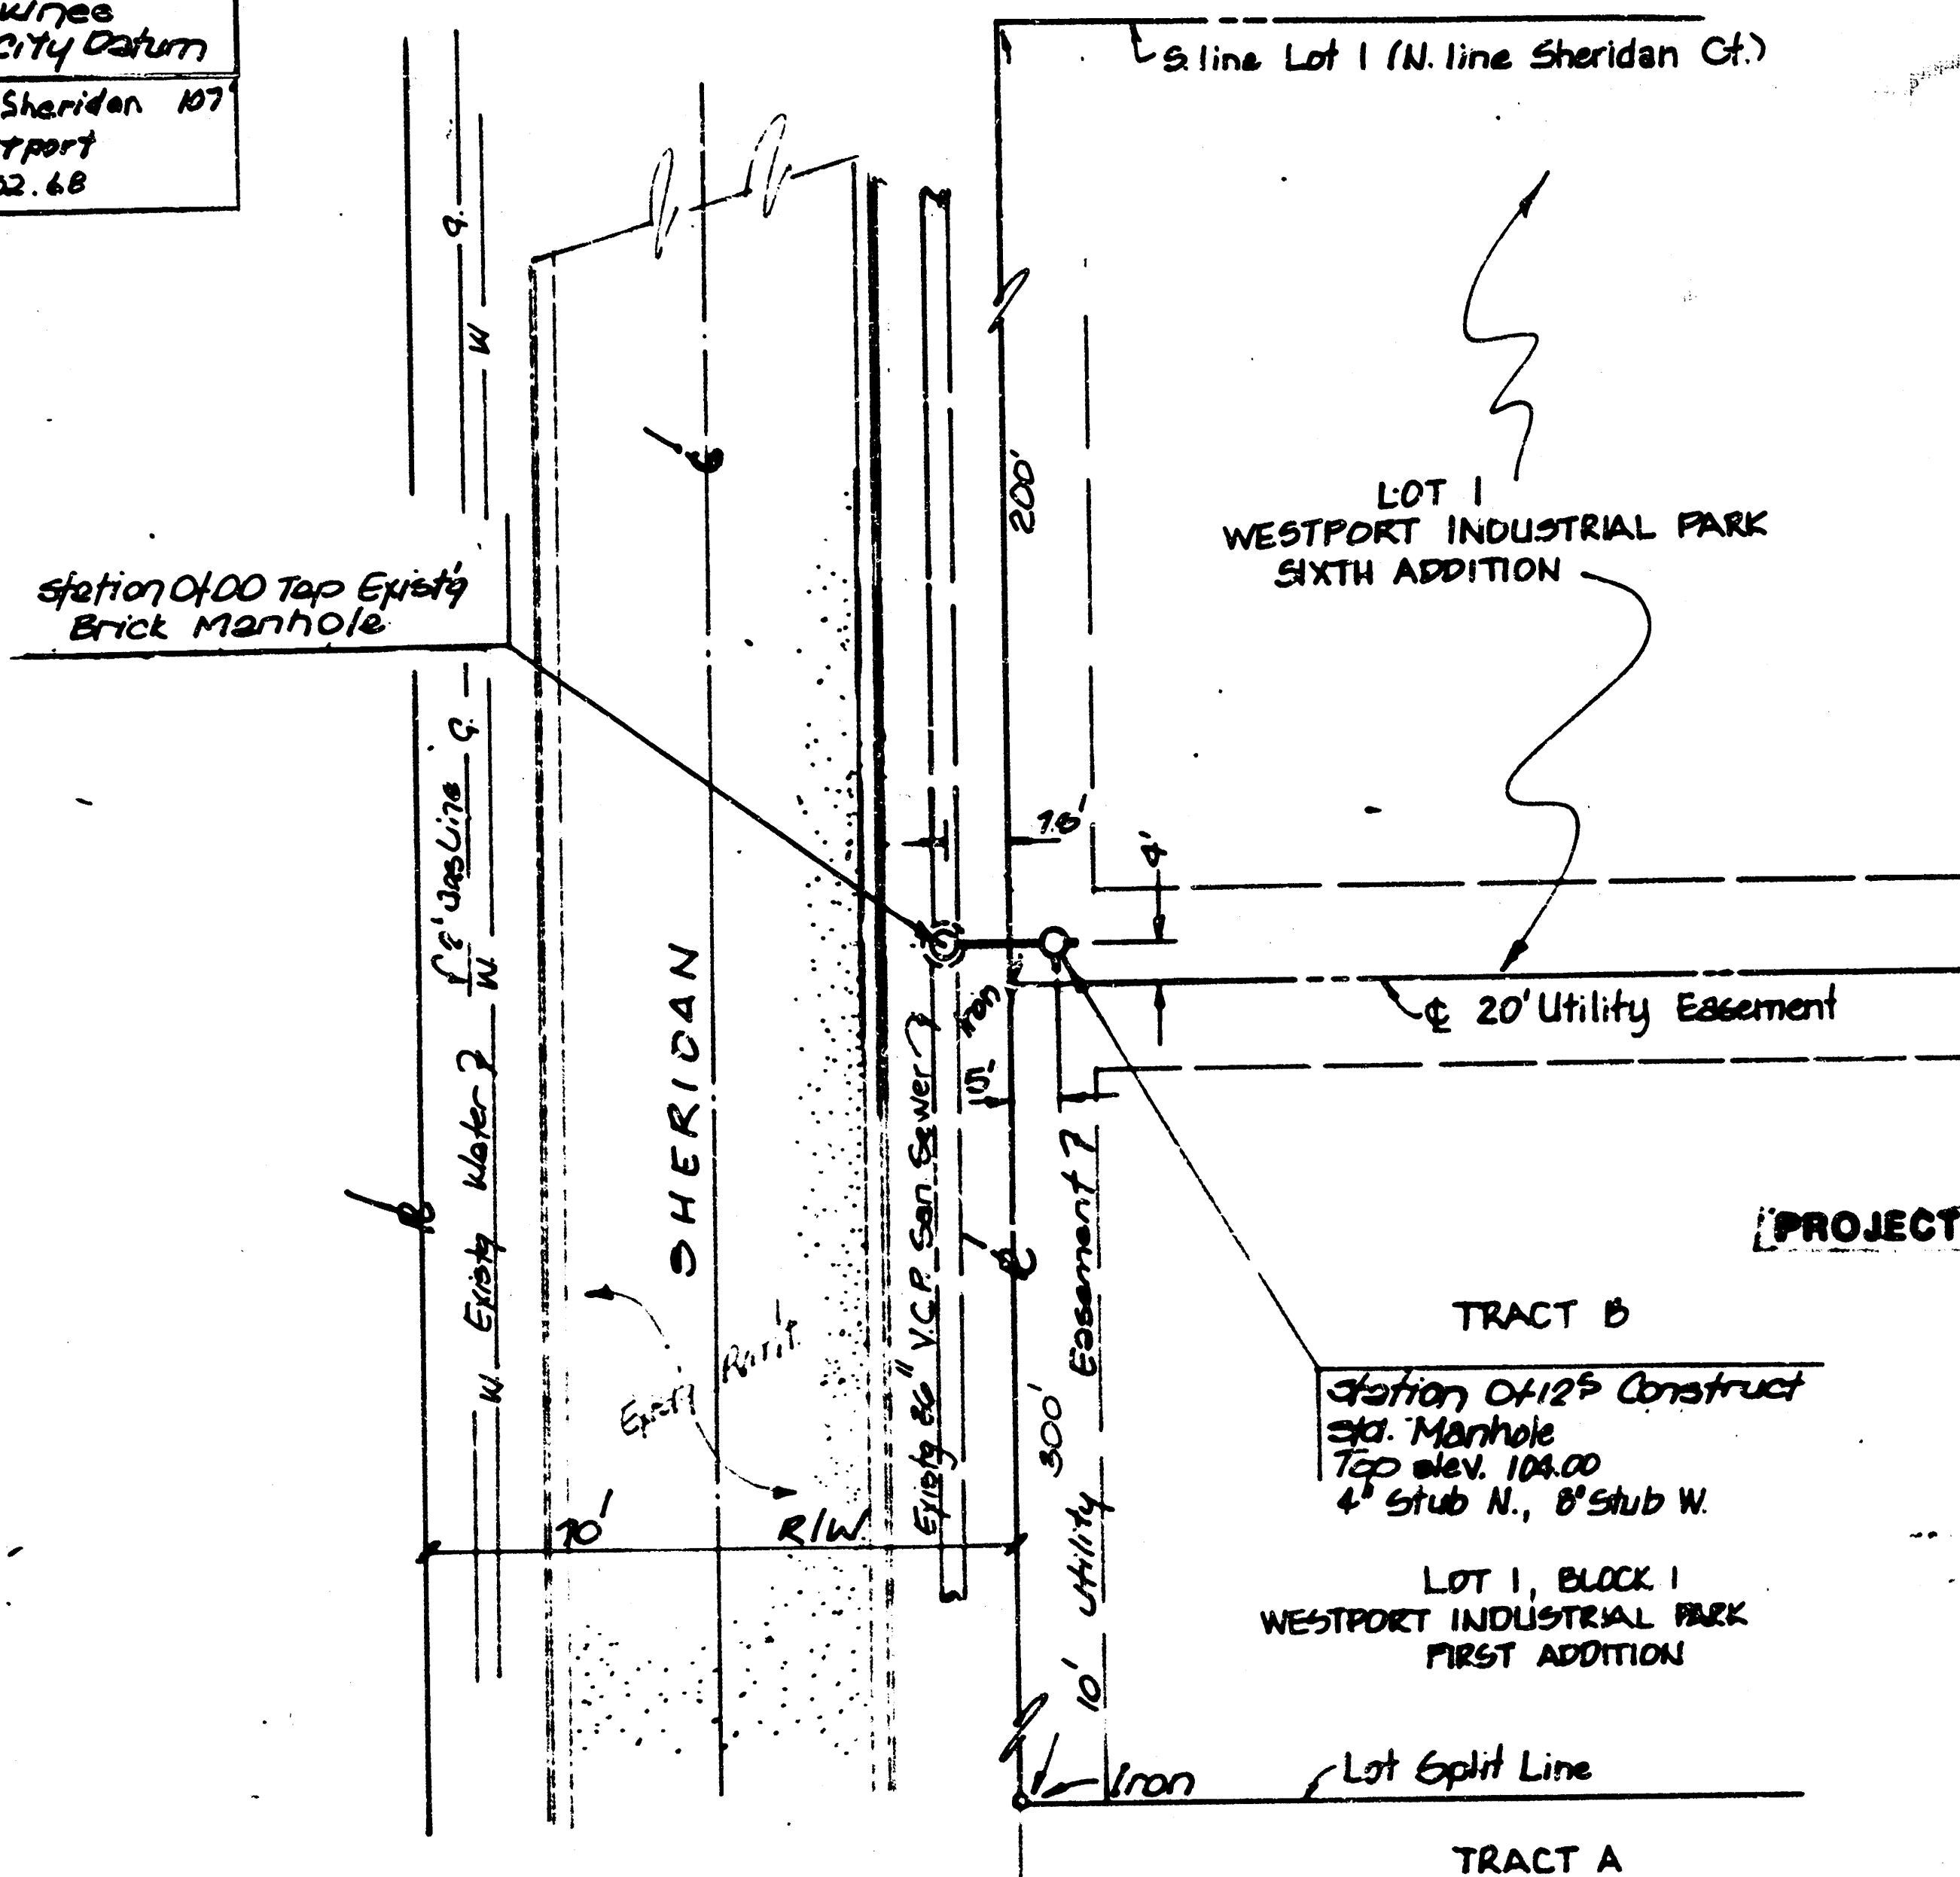

# GENERAL NOTES

- Contractor will be required to provide a minimum advance notice of twenty-four (24) hours to utility companies prior to starting any excavation as follows:

|                                                                   |                      |
|-------------------------------------------------------------------|----------------------|
| Kansas One-Call                                                   | 1-800-344-7233       |
| The Contractor must notify the following in case of an emergency: |                      |
| Cable vision                                                      | 262-4270 or 263-2061 |
| K.P. & L. Gas Service Company                                     | 263-7811             |
| Kansas Gas & Electric                                             | 264-1141             |
| Arkia Gas Company                                                 | 942-8350 or 263-8181 |
| Southwest Bell Telephone Company                                  | 1-877-2611           |
| City of Wichita Water Department                                  | 268-4908             |
| City of Wichita Sewer Maintenance                                 | 268-4071             |

- Underground utility service lines and overhead utility pole lines are to be adjusted as necessary by others prior to construction unless the plans specifically call for their adjustment by the Contractor. Existing utilities and their location, as shown on the plans, represent the best information obtainable for design. The Contractor will be required to work around existing utilities within the right-of-way which do not conflict with proposed construction.
- The Contractor shall be responsible for maintaining continuous flow of sewage through construction. Contractor's proposed method for maintaining sewage flow shall be approved by the Engineer. Cost of maintaining flow of sewage through construction will not be paid for directly and this cost shall be considered as subsidiary to the other pay items of work.
- The Contractor shall be responsible for preserving property irons. The Contractor will be required to re-establish any property irons which are damaged or destroyed by his construction operations. Such irons shall be re-established by a licensed land surveyor or a licensed professional engineer in accordance with state laws.
- Contractor to verify the top of manhole elevation and the need for service line stubs prior to construction. Contact Dan Lee at 242-3322.

APPROVED AND SUBMITTED  
 By City Engineer of Wichita  
 Signature: *[Signature]*  
 Date: \_\_\_\_\_  
 Title: \_\_\_\_\_  
 City: \_\_\_\_\_

NOTES TO CONTRACTOR  
 INSPECTION AND TESTING FOR THIS PROJECT IS TO BE PROVIDED BY A LICENSED PROFESSIONAL ENGINEERING FIRM UNDER CONTRACT WITH THE ENGINEER/DESIGNER. MAJOR INSPECTIONS TO BE IN ACCORDANCE WITH THE CITY OF WICHITA STANDARD CONSTRUCTION SPECIFICATIONS FOR SEWERS AND SANITARY SEWERS. THE CONTRACTOR SHALL BE RESPONSIBLE FOR THE PROTECTION OF ALL EXISTING UTILITIES AND STRUCTURES. THE CONTRACTOR SHALL BE RESPONSIBLE FOR THE PROTECTION OF ALL EXISTING UTILITIES AND STRUCTURES. THE CONTRACTOR SHALL BE RESPONSIBLE FOR THE PROTECTION OF ALL EXISTING UTILITIES AND STRUCTURES.

PRIVATE SANITARY SEWER  
 EXTENSION TO SERVE S. 300' OF LOT 1,  
 BLK. 1, WESTPORT INDUSTRIAL PARK  
 FIRST ADDITION  
 CITY OF WICHITA, KS  
 PROJECT NO. 1 259PPS 807861

BAUGHMAN COMPANY, P.A.  
 SURVEYING & ENGINEERING  
 2100 S. W. 10TH ST. - 2ND FL. - WICHITA, KANSAS 67211



FILMED FROM THE BEST  
 AVAILABLE COPY