
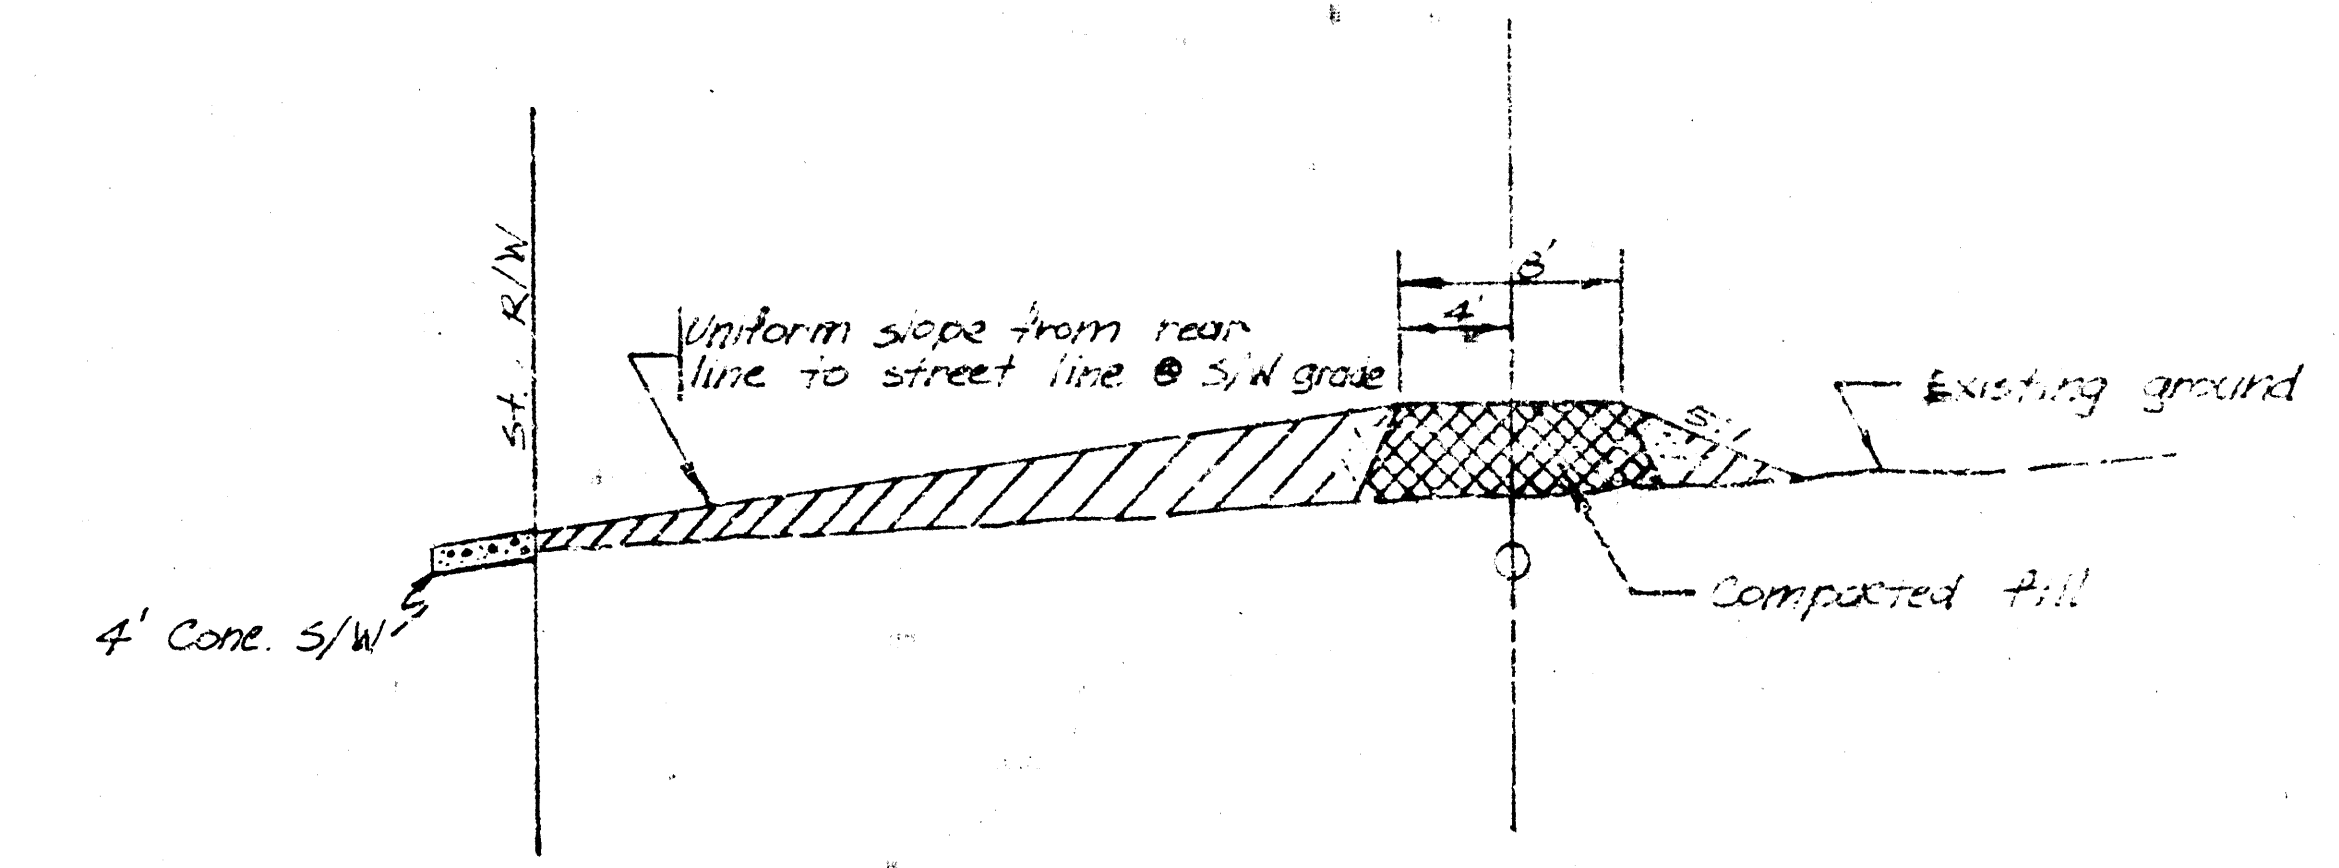




9-7-76
 APPROVED AS NOTED
 By CITY ENGINEER
 Sanitary Sewers O.E.S.
 Storm Sewers _____
 Driveway Approaches _____

NOTE TO CONTRACTOR
 This project will be constructed under the supervision of the City Engineer and conforming to the standards of the CITY OF WICHITA. The CONTRACTOR will retain the responsibility for all cost of construction and inspection.

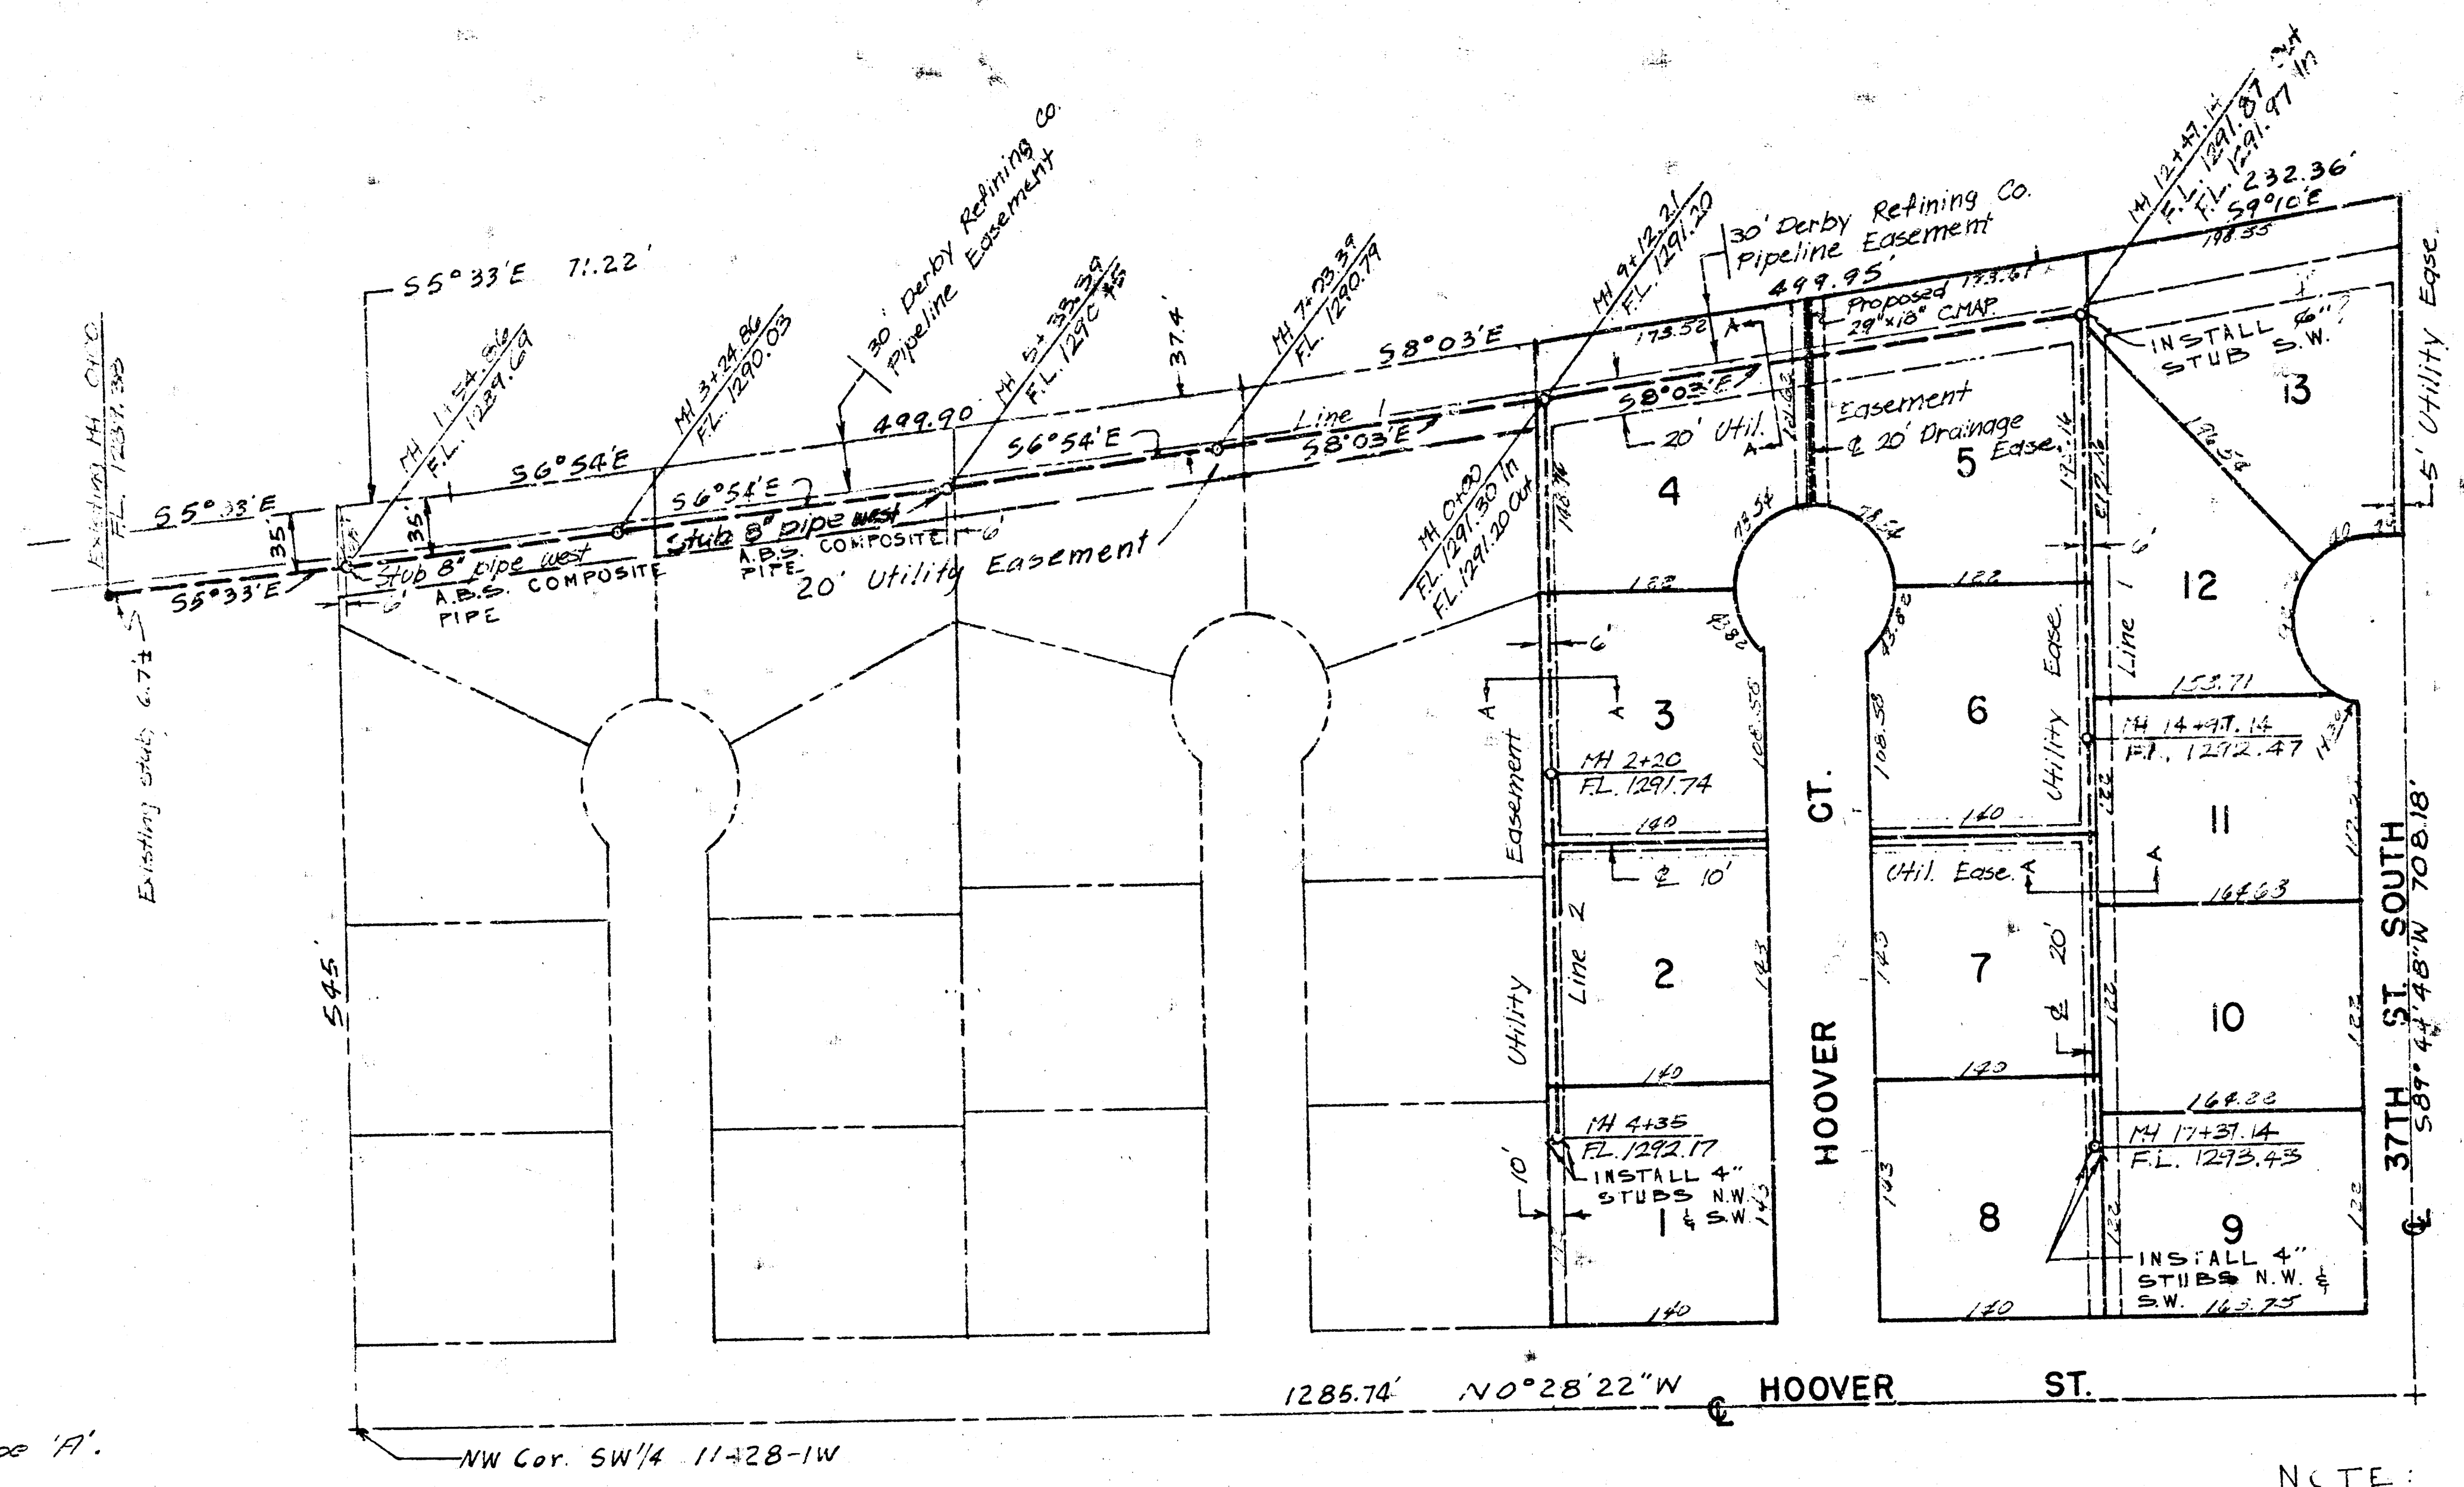

NOTE:
 B.M. = ELEV. 1289.38 MEAN SEA LEVEL DATUM =
 ELEV. 101.98 CITY OF WICHITA DATUM.
 SUBTRACT 1187.4 FROM MEAN SEA LEVEL DATUM
 TO OBTAIN CITY OF WICHITA DATUM.

B.M. = ELEV. 1289.38 : FLOW LINE OF EXISTING
 MH 0+00, LINE 1.

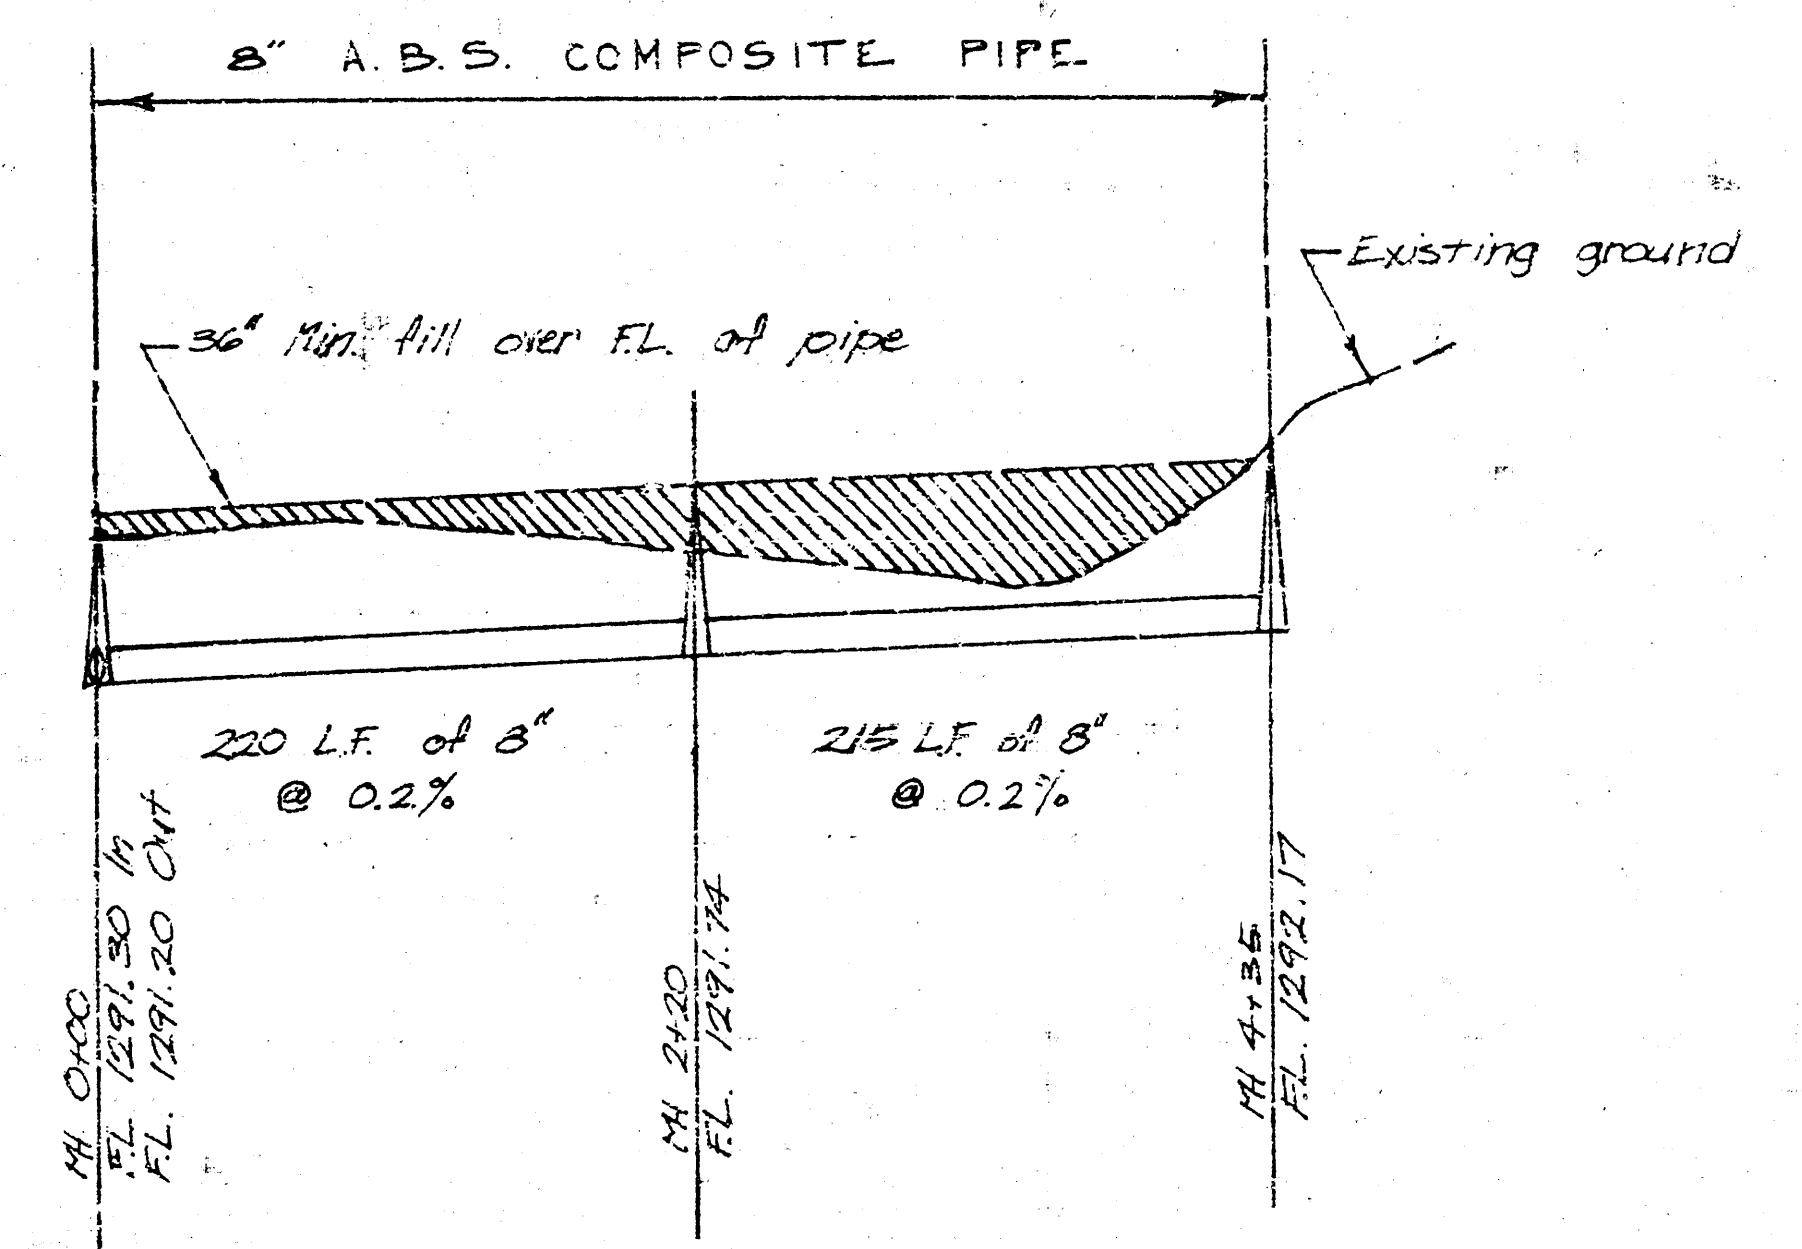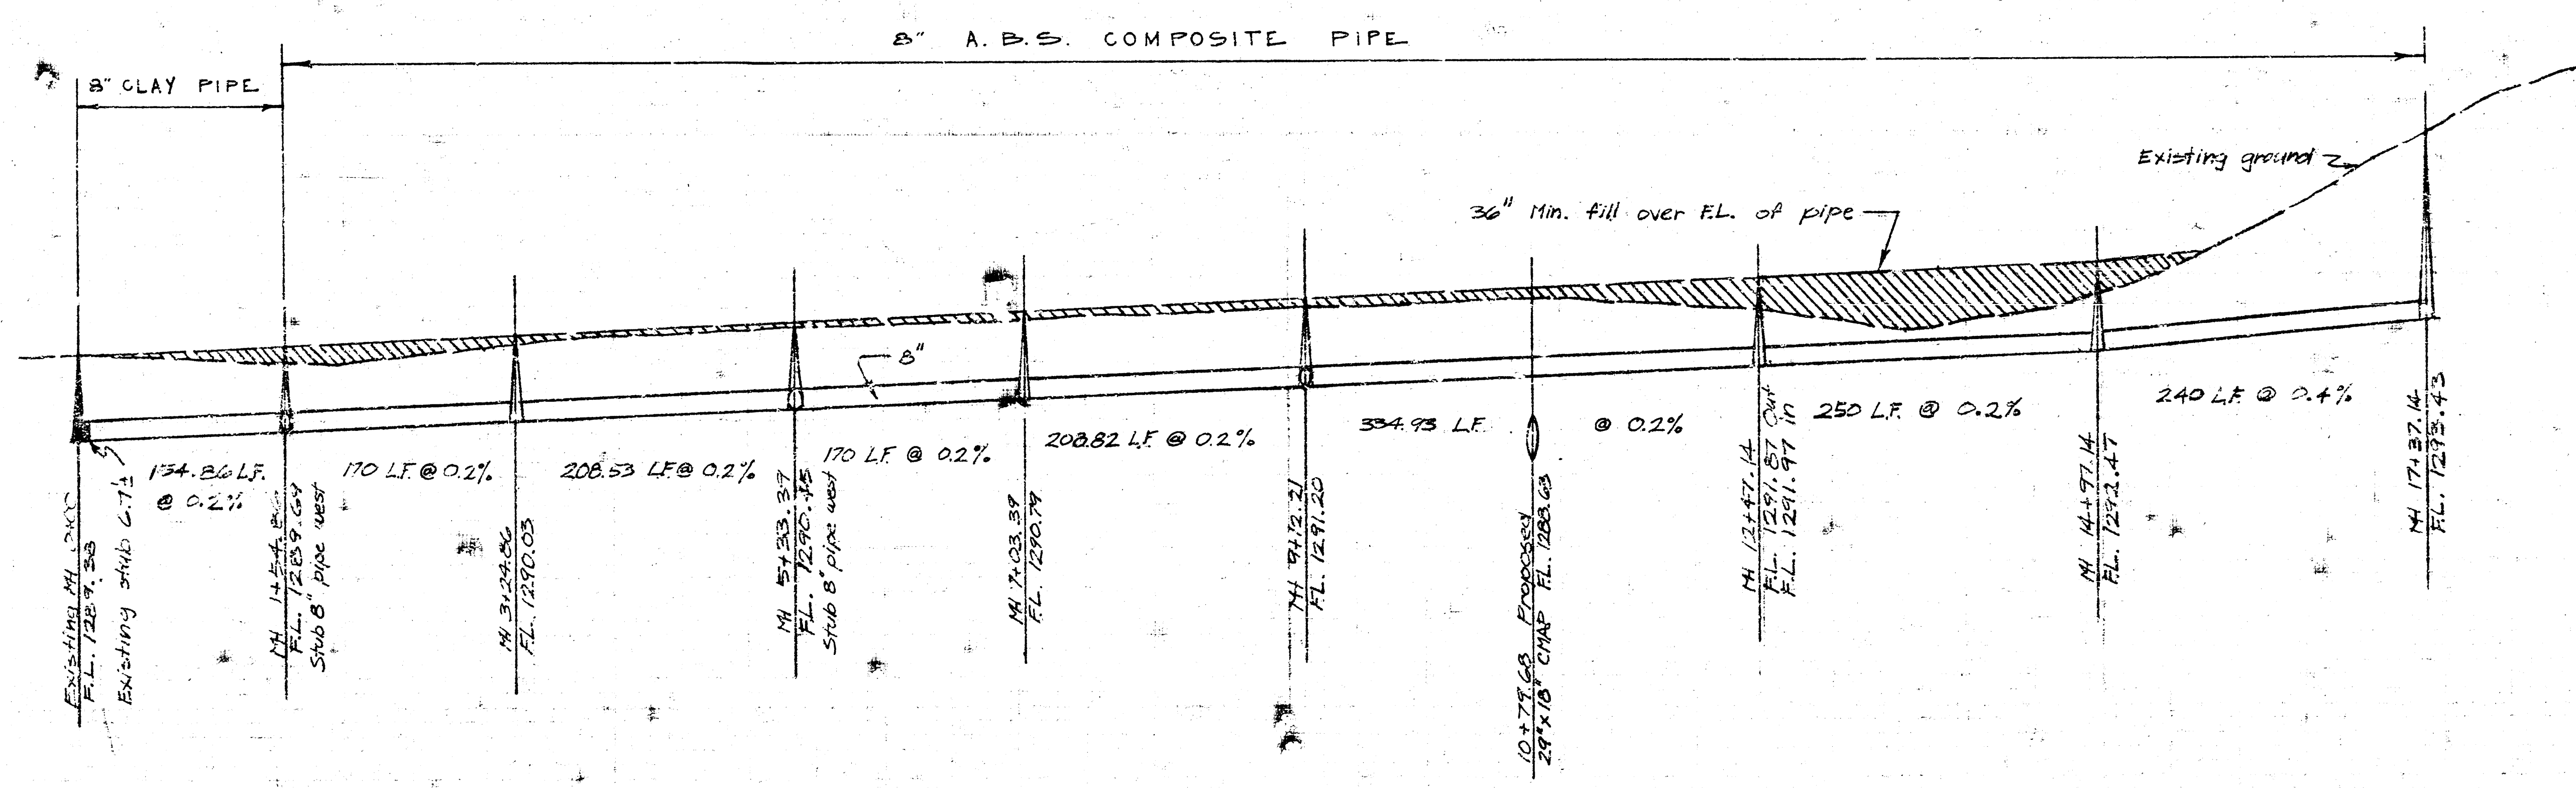

SANITARY SEWER
 WHEATLAND PLACE ADD.
 K.O. TAYLOR, P.E.
 AUGUST 2, 1976

