


NORTH

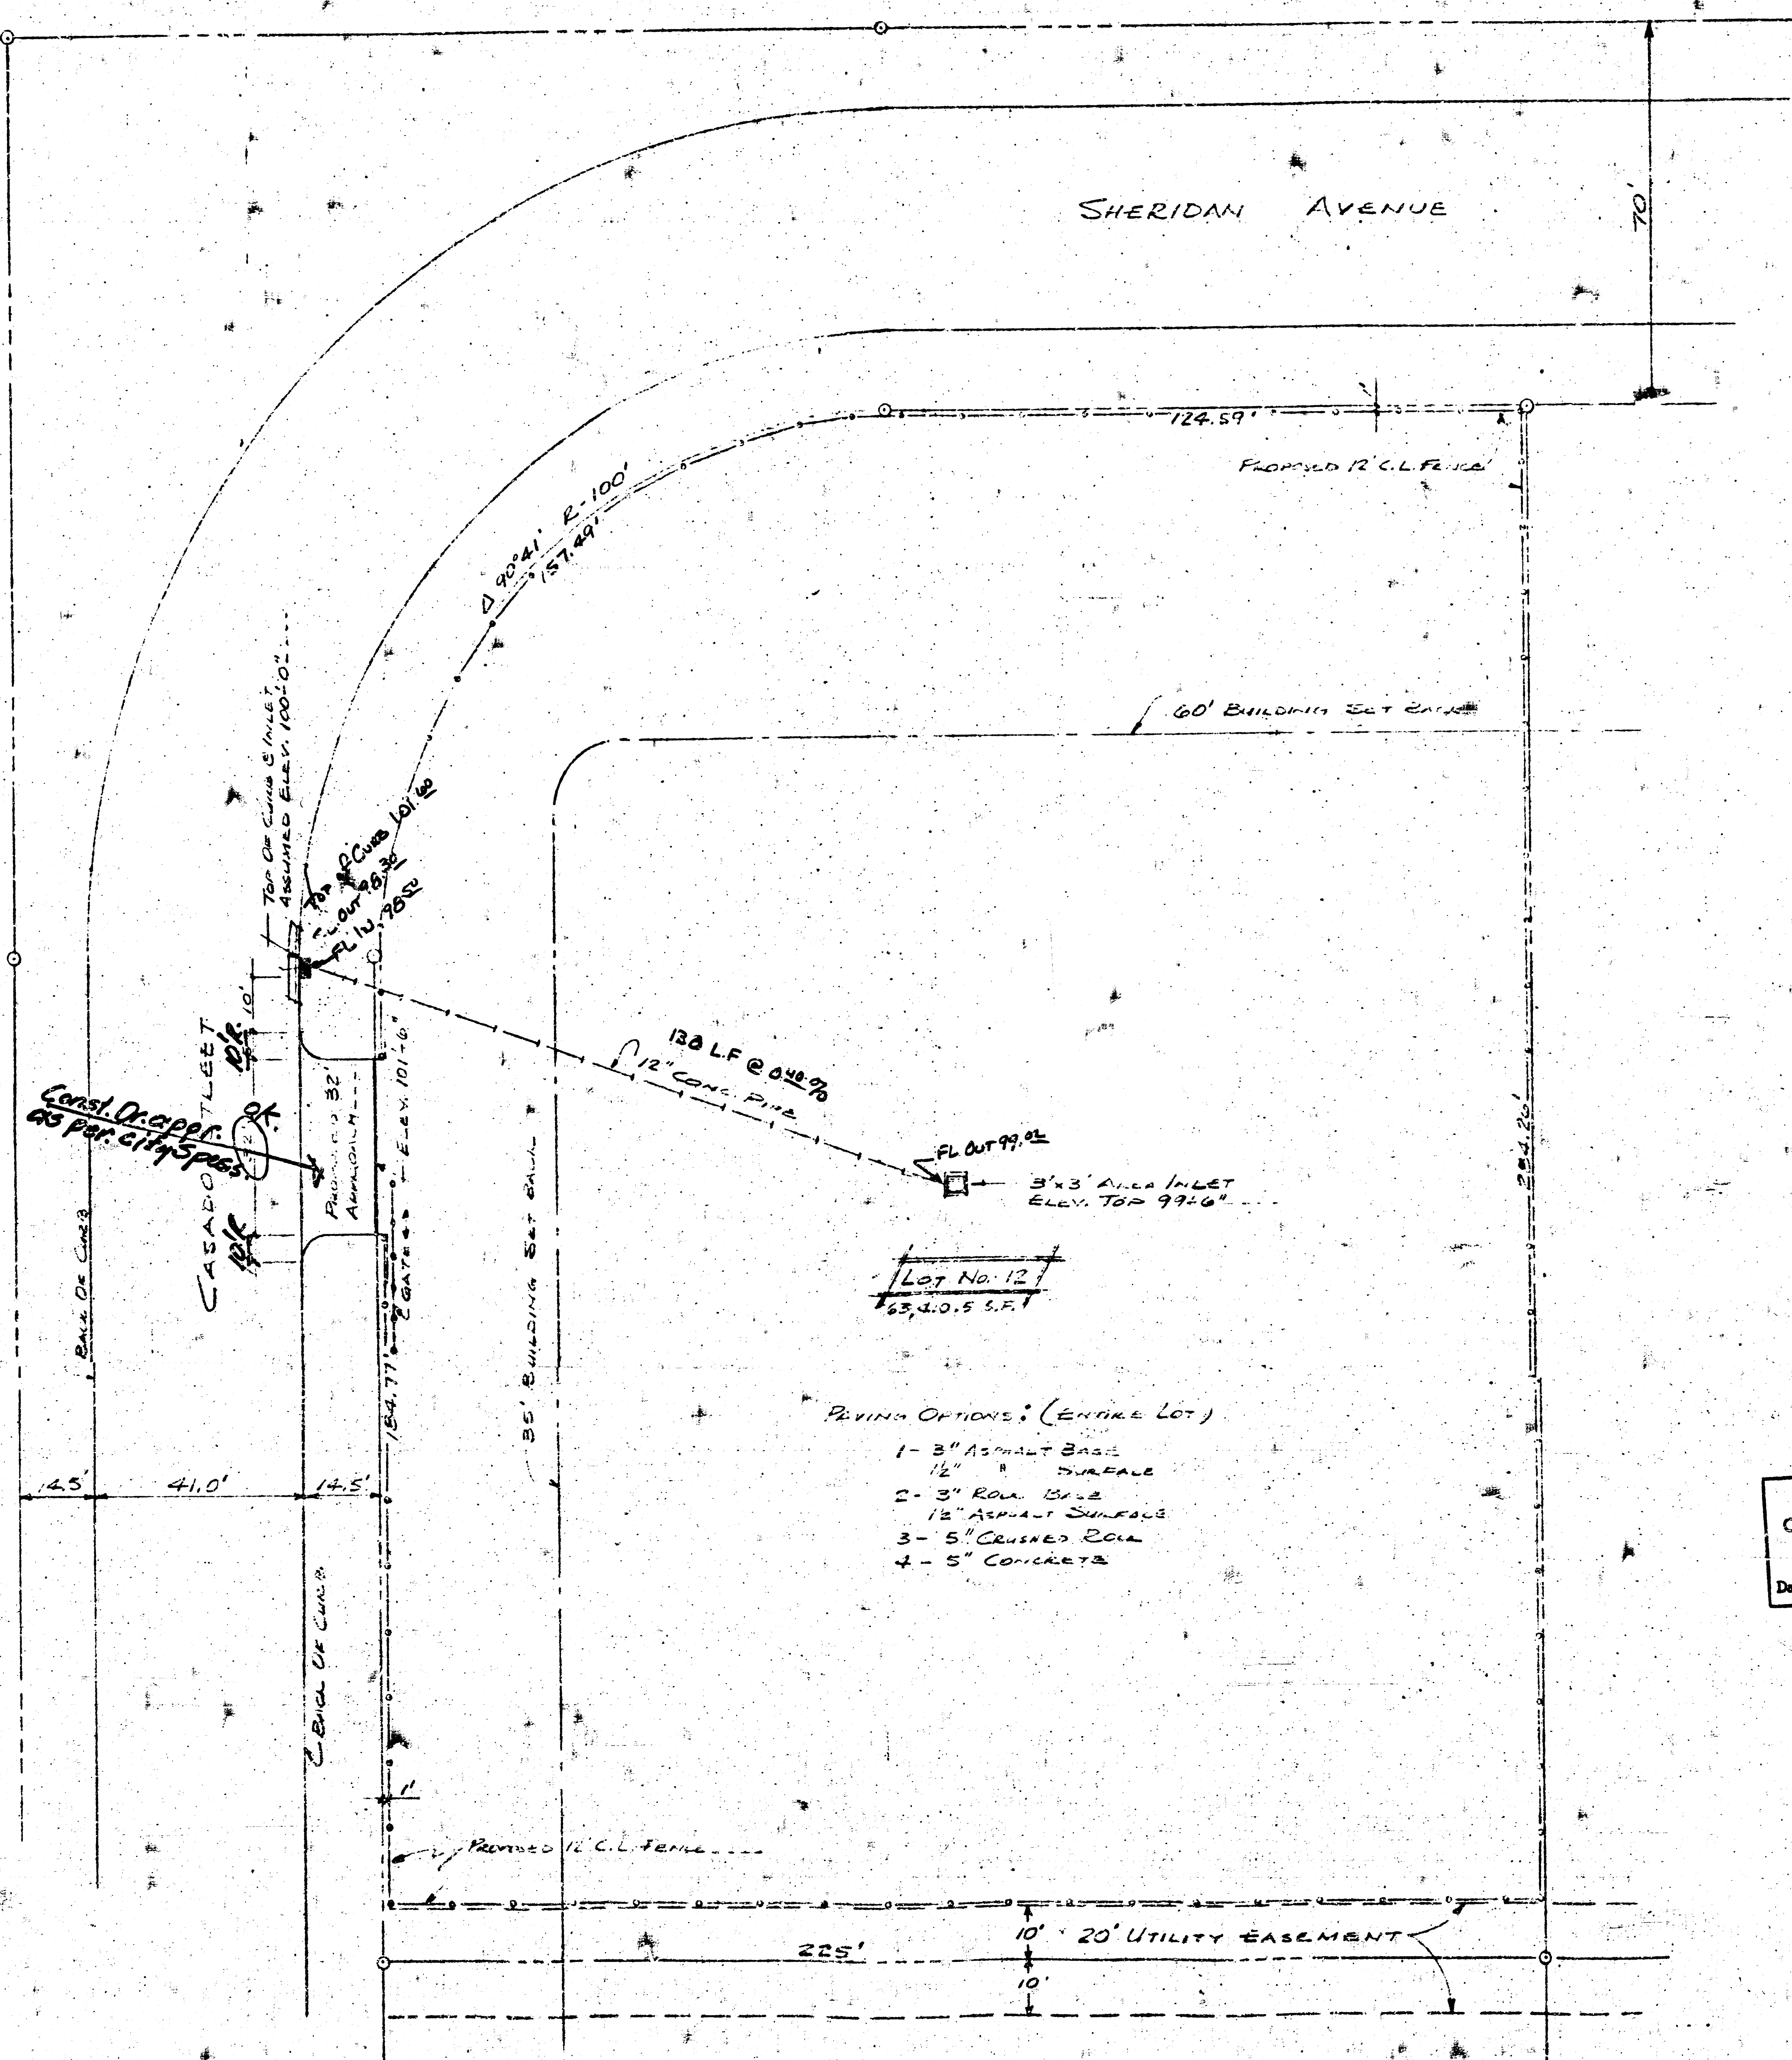

6-20-75
APPROVED AS NOTED
By CITY ENGINEER OF WICHITA
Sanitary Sewers _____
Storm Sewers D.E.I.
Driveway Approaches _____

APPROVED
CENTRAL INSPECTION DIVISION
CITY OF WICHITA
Date 6-16-75 By R. J. Meier

APPROVED AS NOTED
By CITY ENGINEER OF WICHITA
Sanitary Sewers _____
Storm Sewers _____
Driveway Approaches _____

City Proj. # D.W. 705 017
Approved WDM 6-16-75