


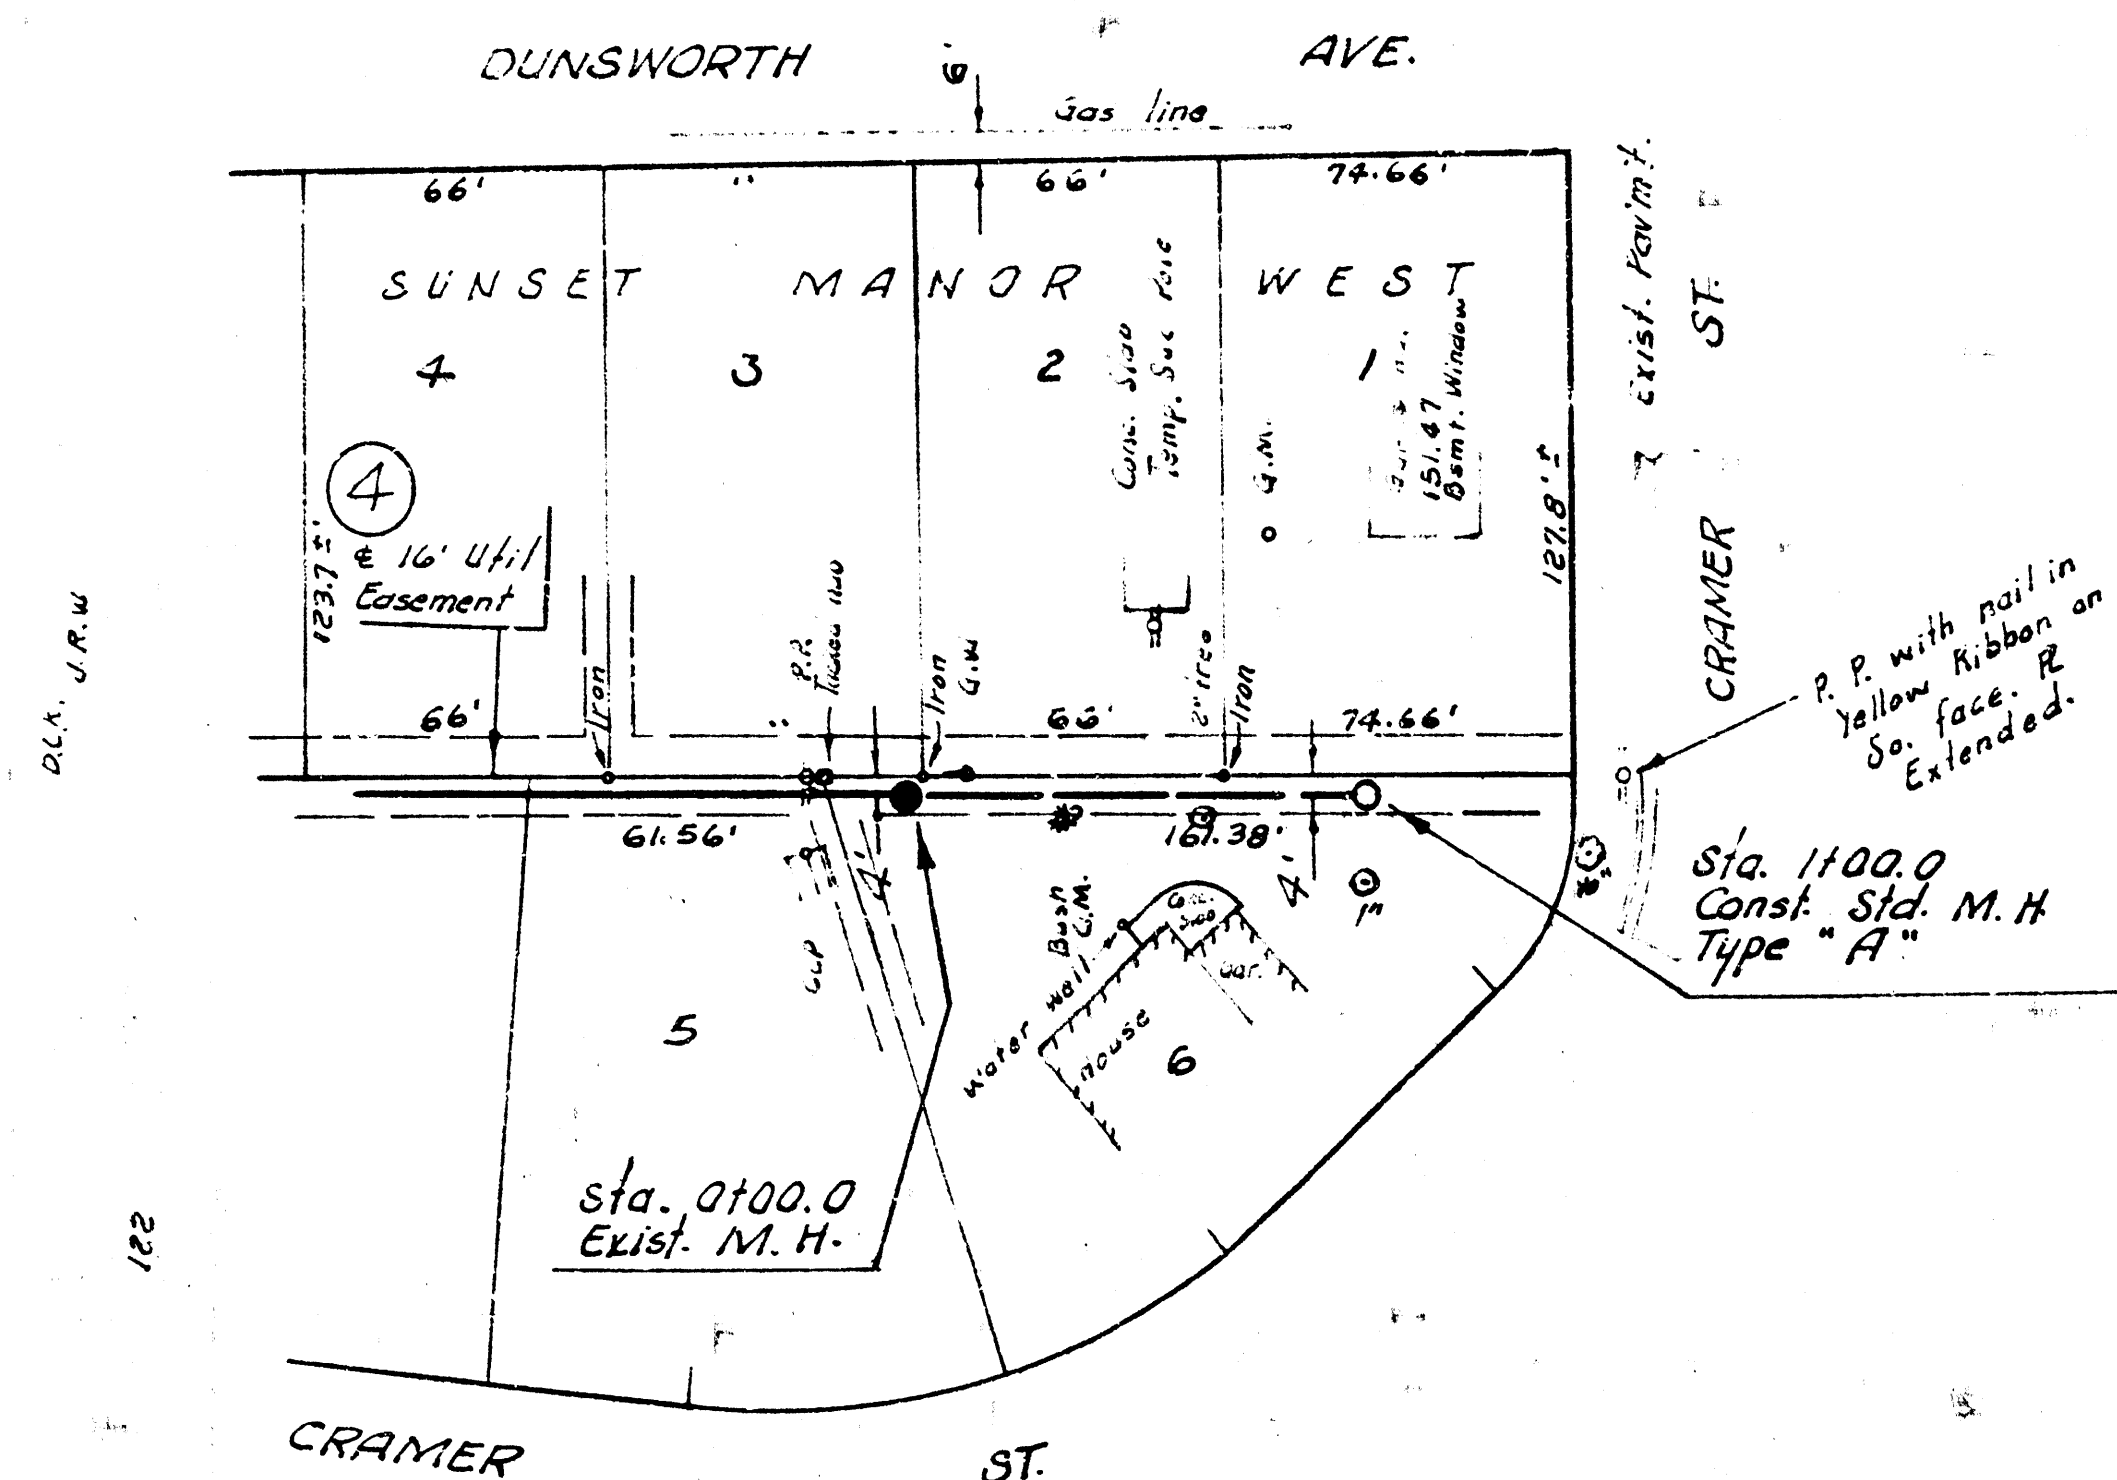


Plan Scale 1" = 40' Horiz.
Profile Scale 1" = 5' Vert.


B.M. 151.47 SE con. conc. porch
No. 1266 Cramer

NOTE TO CONTRACTOR

This project will be constructed under the supervision of the CITY ENGINEER and conforming to the SPECIFICATIONS of the CITY OF WICHITA. The CONTRACTOR will reimburse the City of Wichita for all cost of Engineering, Plans, and Inspection.

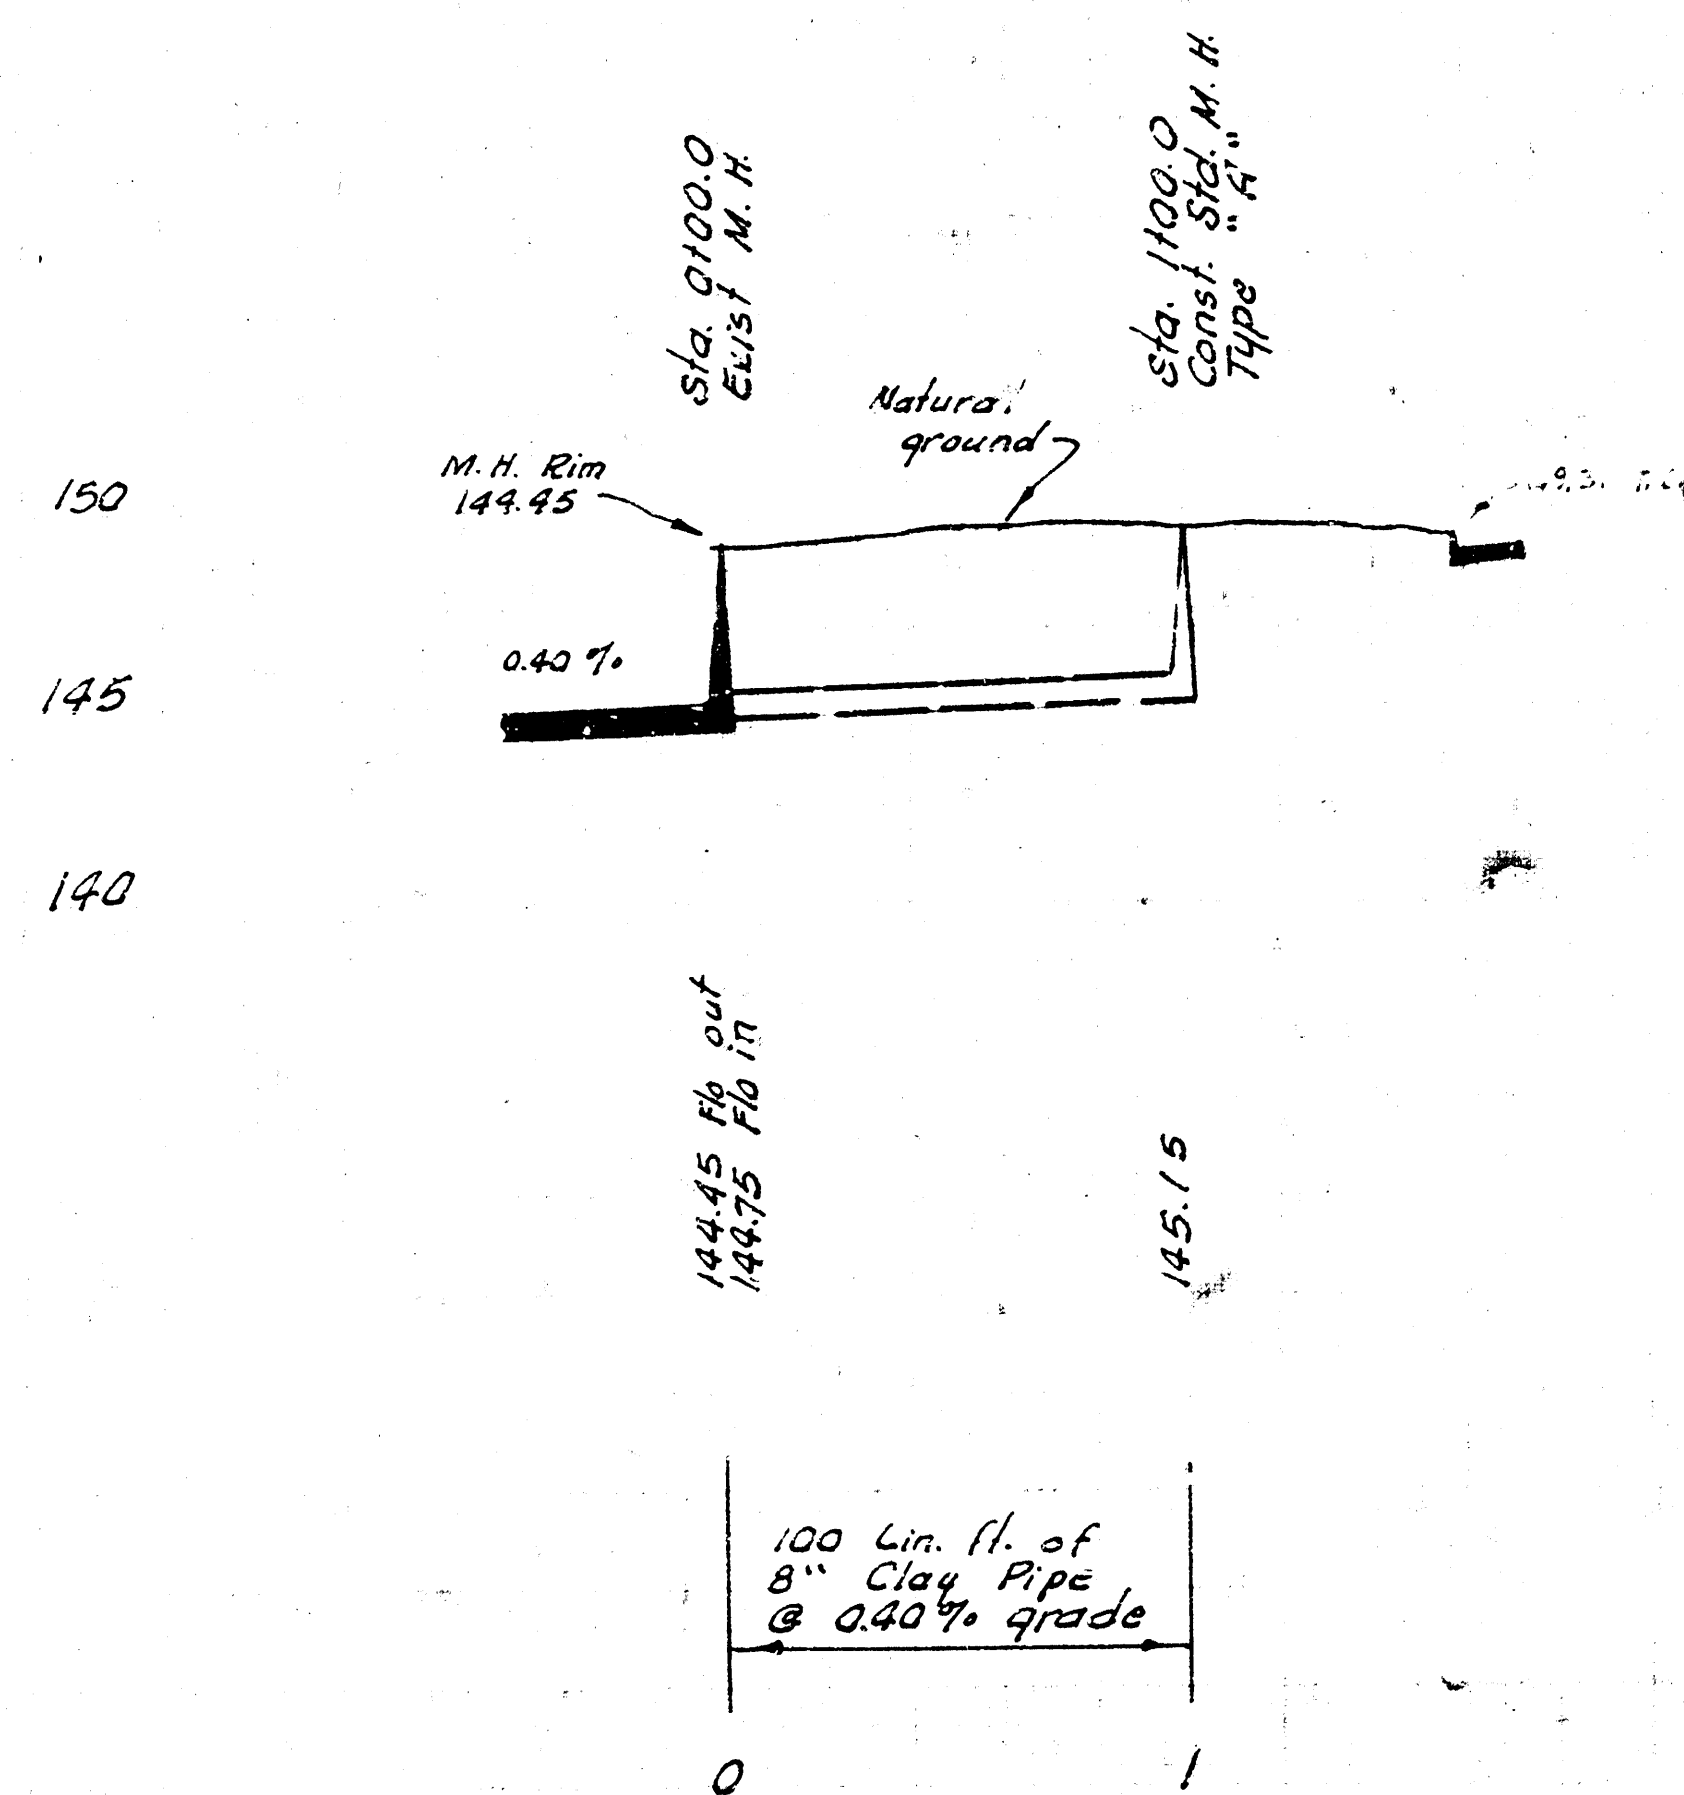

EXTENSION TO LAT. C-1-D
COUNTY ACRES IMPROVEMENT DIST.
CITY OF WICHITA, KANSAS
R. W. LINN — CITY ENGINEER
MARCH 1973, PROJECT NO. BHKBS0314

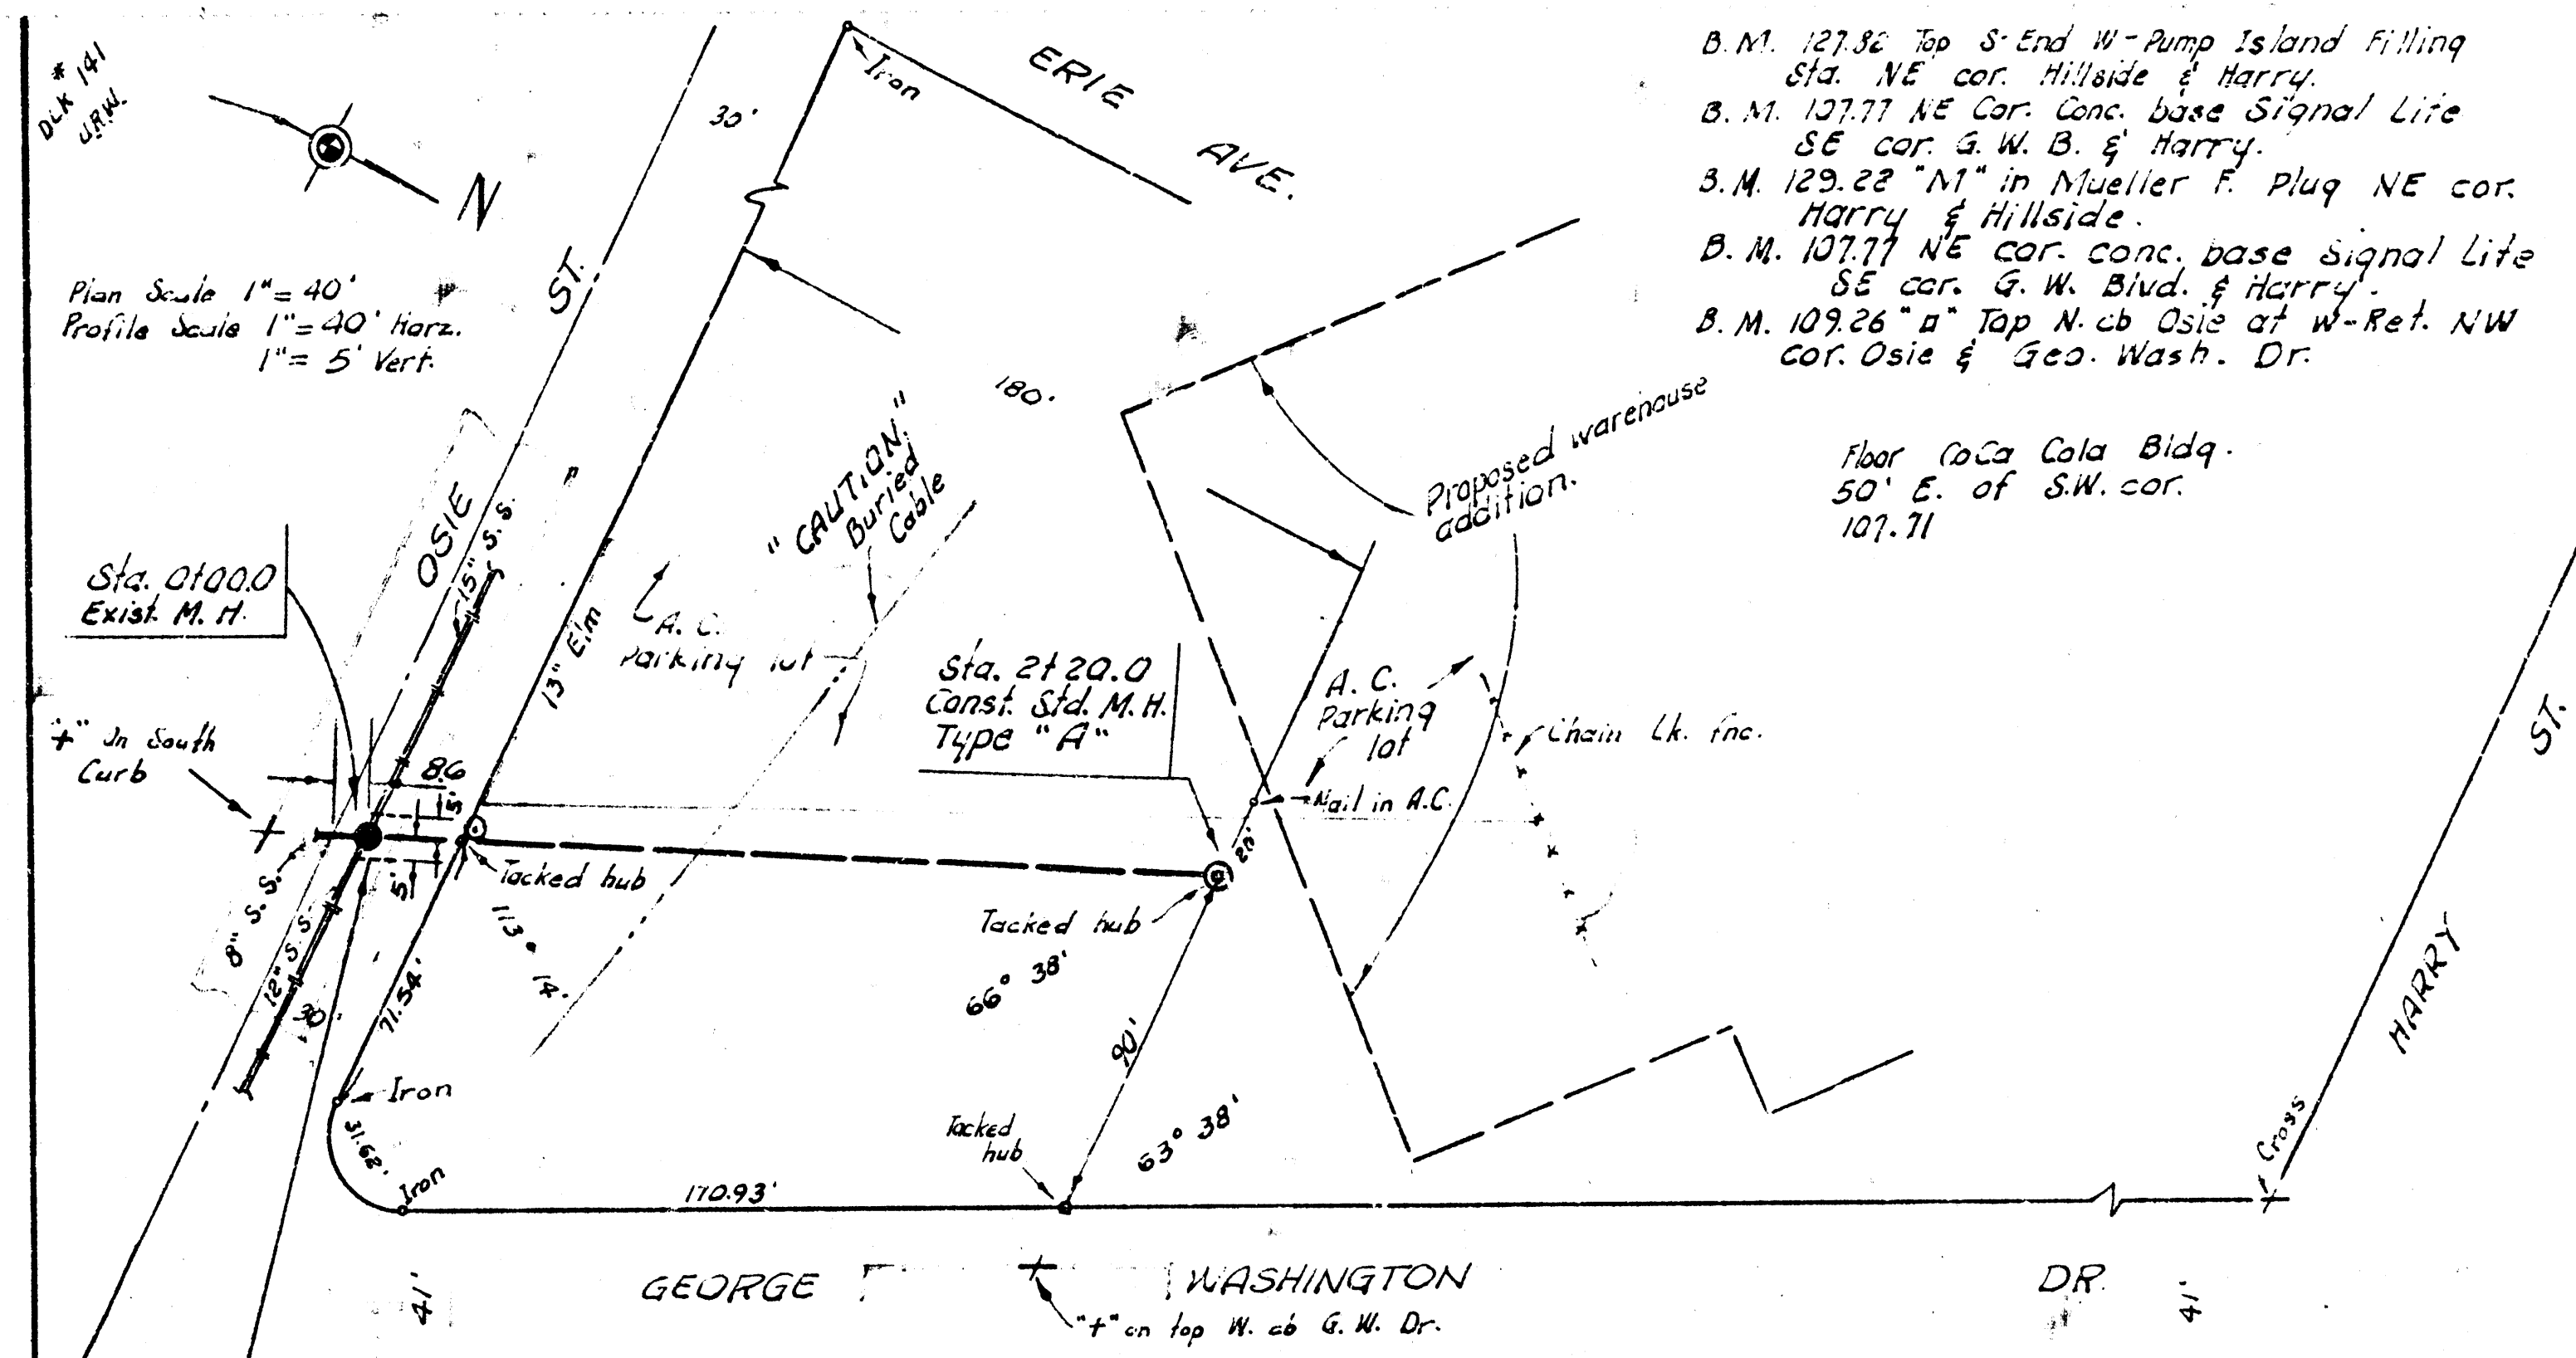


Plan Scale 1" = 40' Horiz.
Profile Scale 1" = 5' Vert.

B.M. 127.36 Top S-End W-Ramp Island Filling
Sta. NE cor. Millside & Harry.
B.M. 127.77 NE Cor. Conc. base Signal Life
SE cor. G.W. B. & Harry.
B.M. 129.22 "M" in Mueller F. Plug NE cor.
Harry & Hillside.
B.M. 127.77 NE cor. conc. base Signal Life
SE cor. G.W. Blvd. & Harry.
B.M. 109.26 "D" Top N. ab. Osie of W-Ref. NW
cor. Osie & Geo. Wash. Dr.

NOTE:
Sew. joint.
Replace pavement to
City of Wichita specifications.

NOTE TO CONTRACTOR

This project will be constructed under the supervision of the CITY ENGINEER and conforming to the SPECIFICATIONS of the CITY OF WICHITA. The CONTRACTOR will reimburse the City of Wichita for all cost of Engineering, Plans, and Inspection.

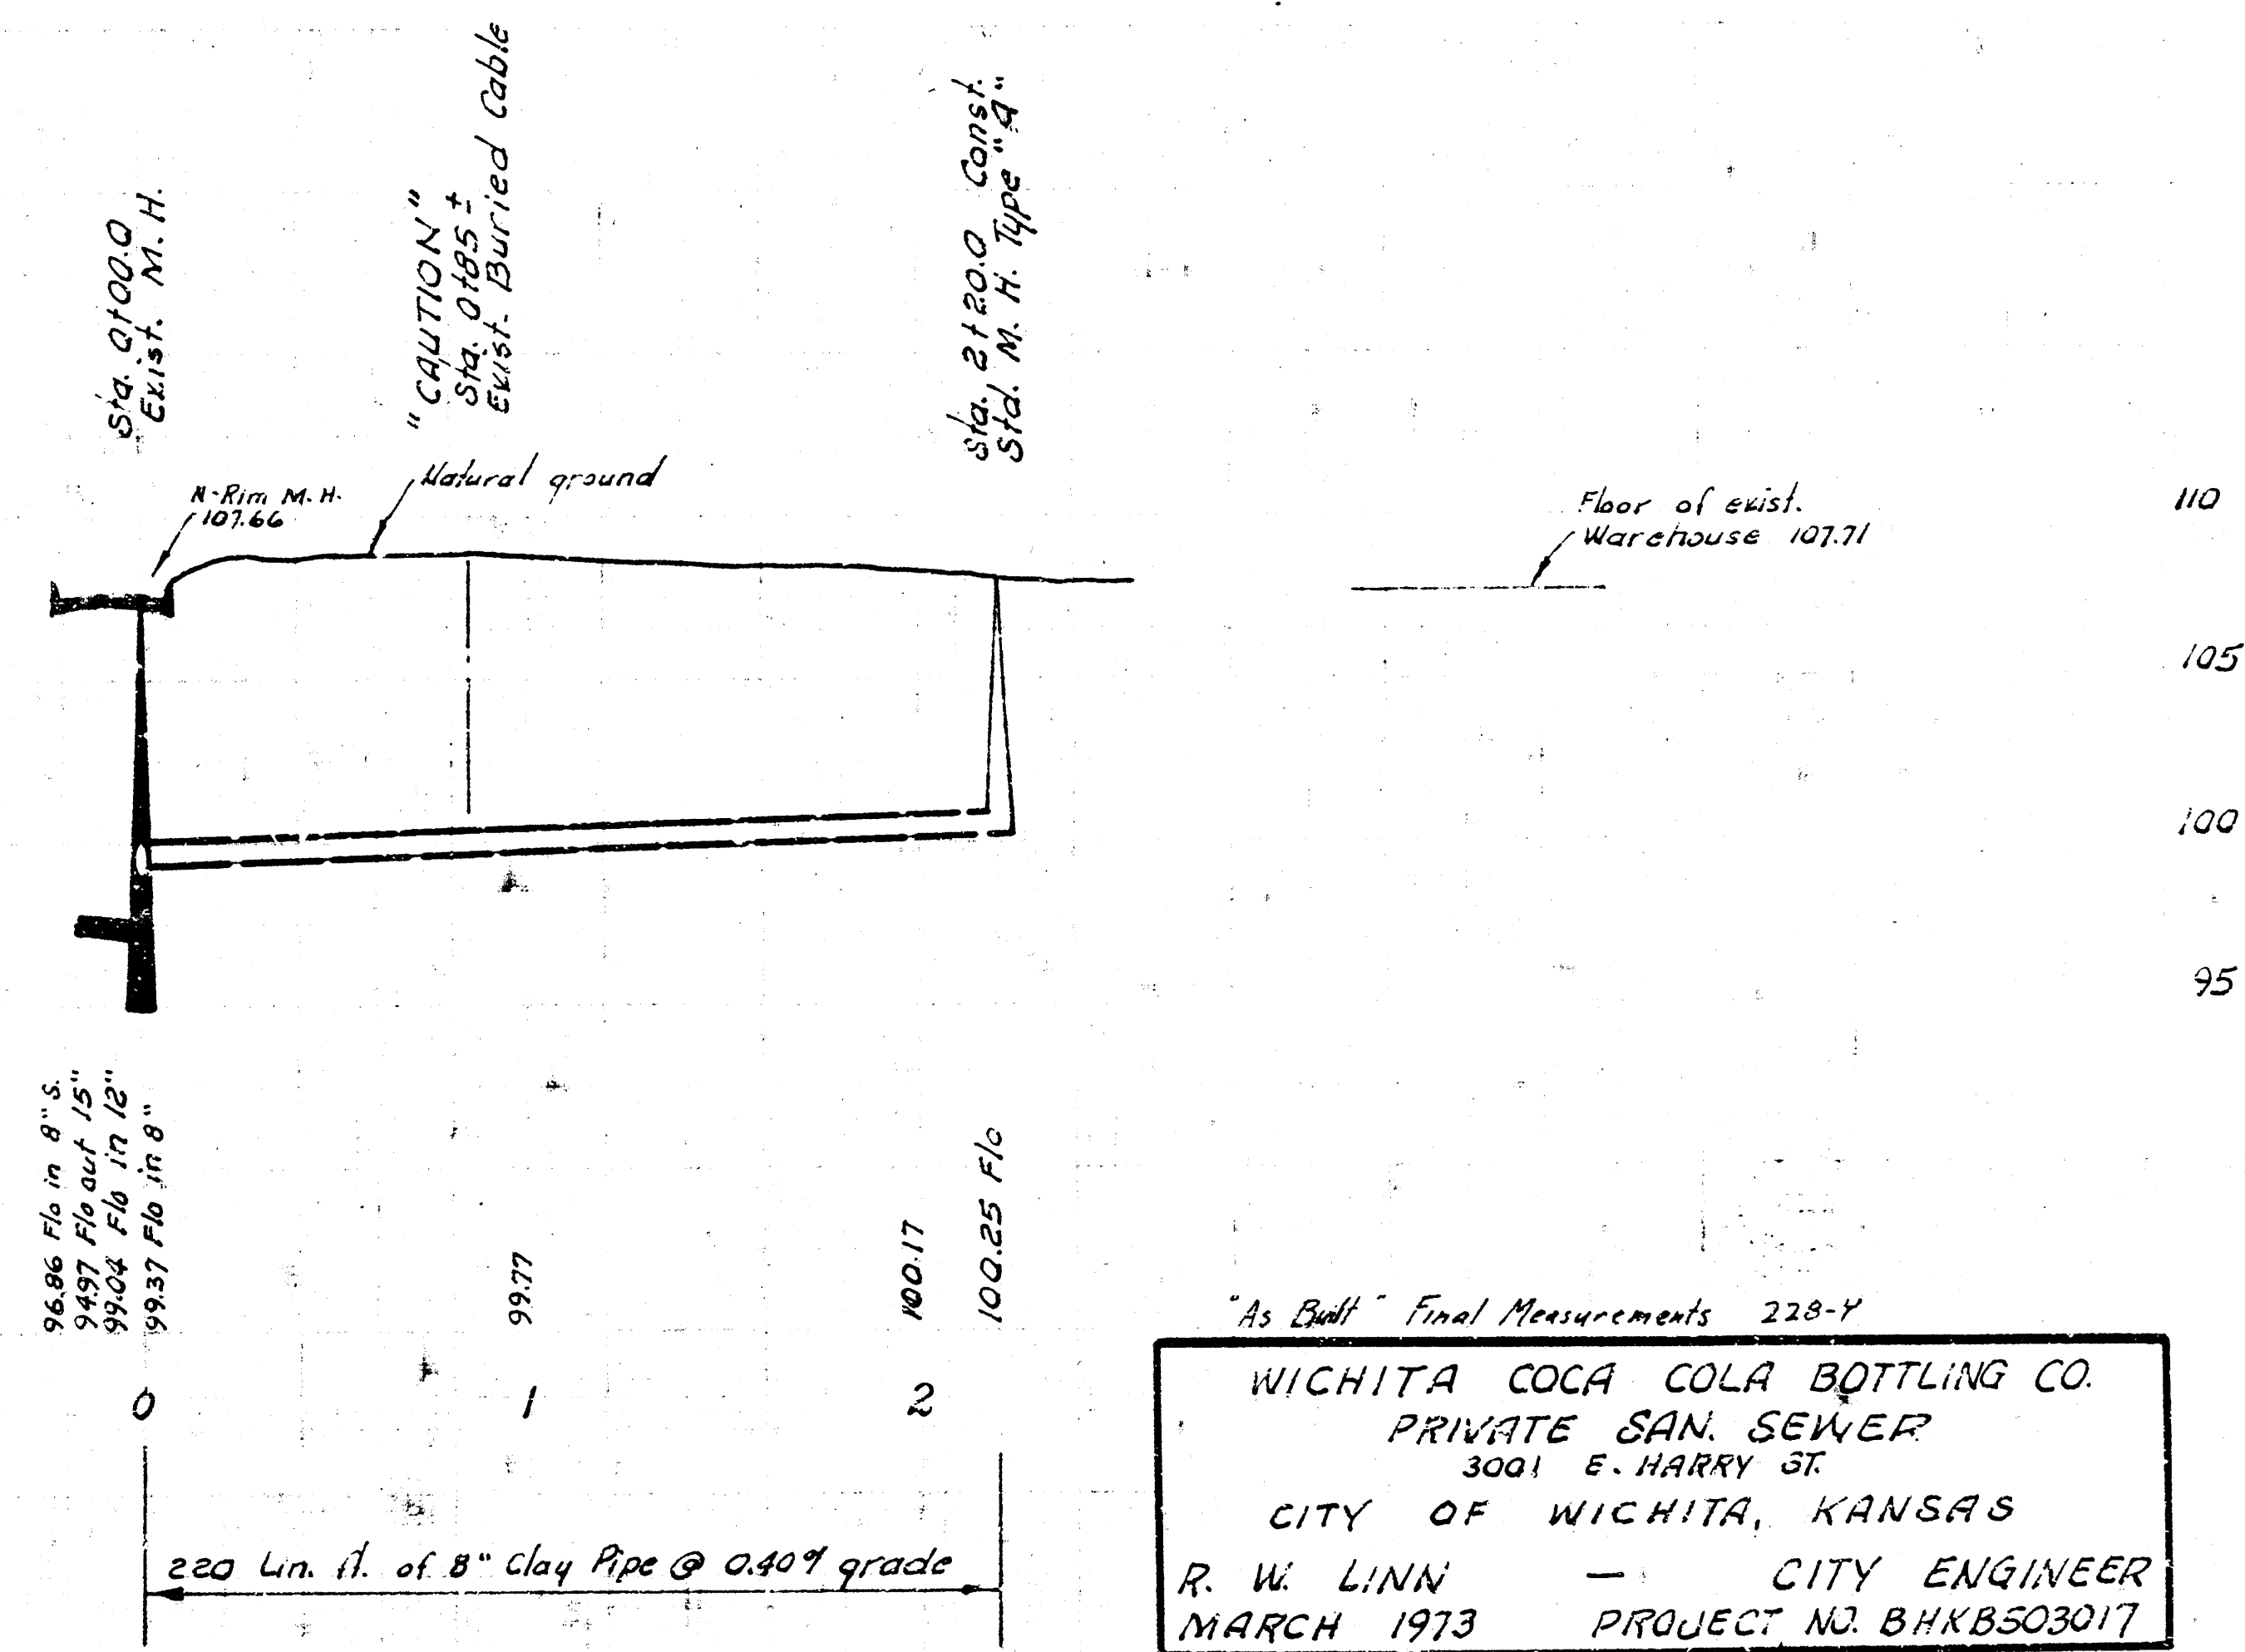

"As Built" Final Measurements 228-Y
WICHITA COCA COLA BOTTLING CO.
PRIVATE SAN. SEWER
3001 E. HARRY ST.
CITY OF WICHITA, KANSAS
R. W. LINN — CITY ENGINEER
MARCH 1973, PROJECT NO. BHKBS03017