


B.M. N Side EAST M.H. Rim Elev. 128.81

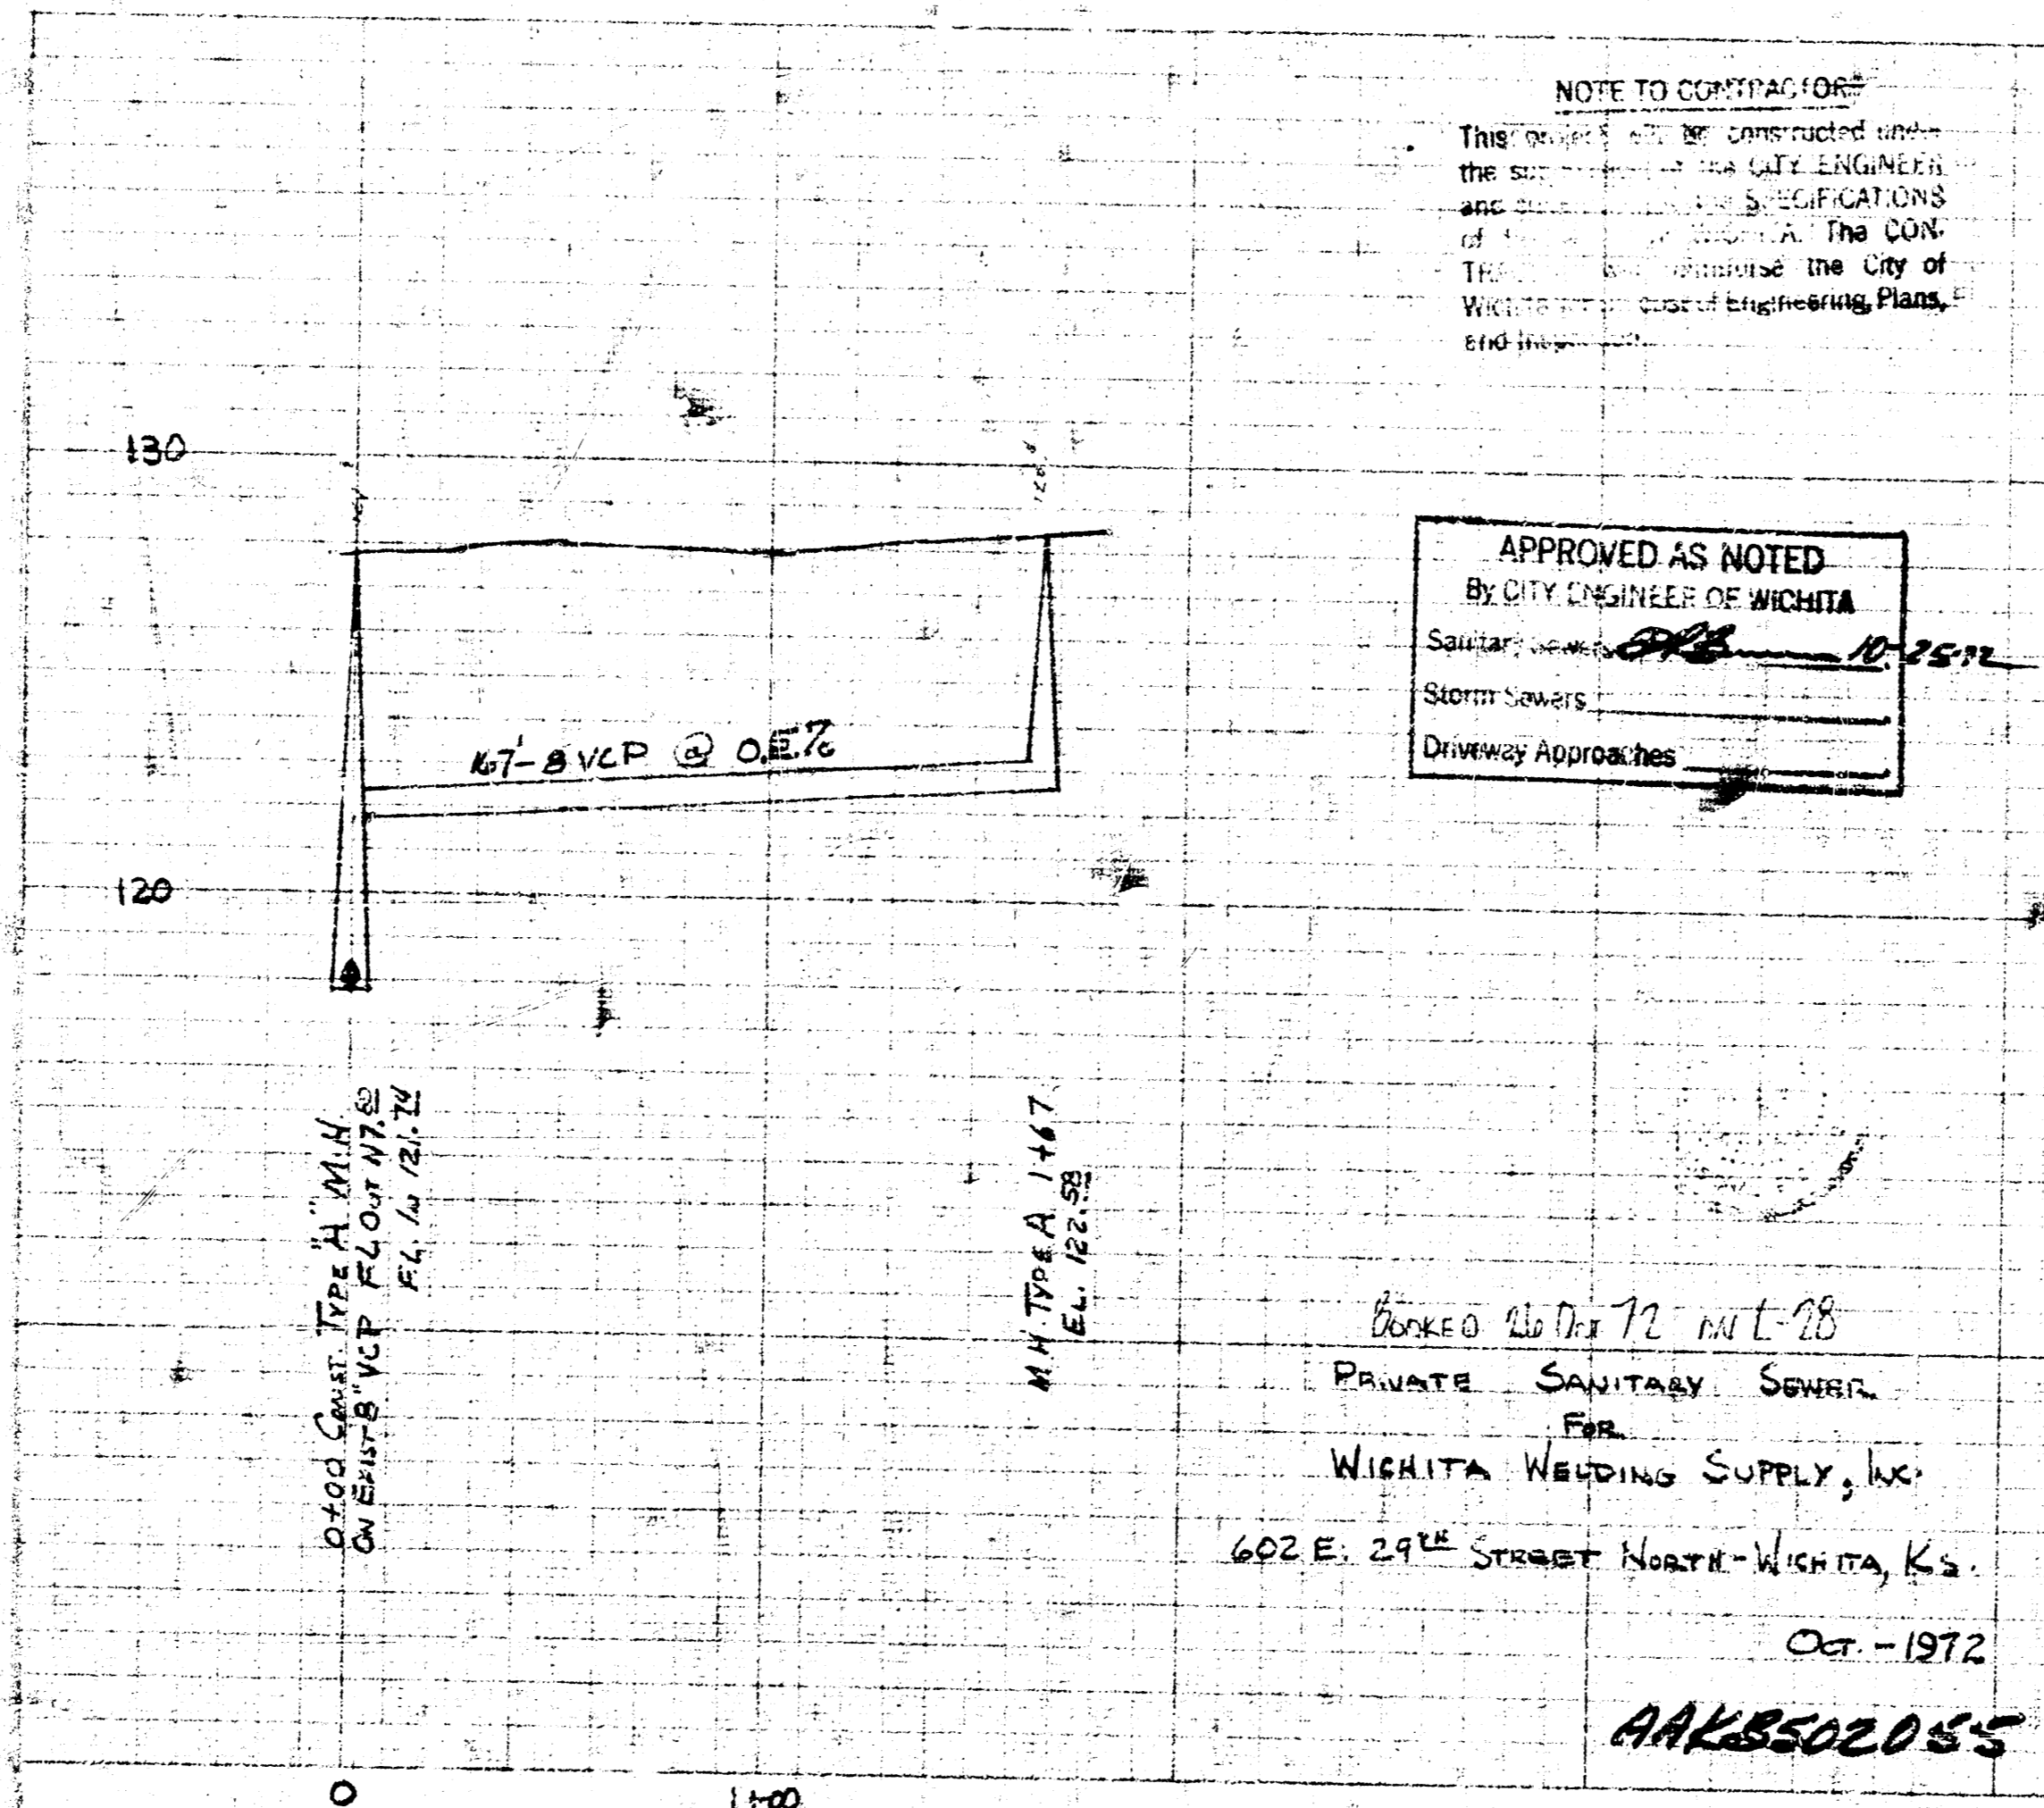

Checked by: *[Signature]* 10-1-72
Private Sanitary Sewer
For
WICHITA WELDING SUPPLY, INC.
602 E. 29th Street North - Wichita, Ks.

Oct - 1972
RAKESZDSS