

APPROVED AS NOTED
By CITY ENGINEER OF WICHITA
Sanitary Sewers *P.C.A.*
Storm Sewers
Driveway Approaches

NOTE TO CONTRACTOR

This project will be constructed under the supervision of the CITY ENGINEER and conforming to the SPECIFICATIONS of the CITY OF WINSTON. The CONTRACTOR will retain the City of Winston for all cost of Engineering, Plans, and Construction.

DETAIL 'A'

ELEV. OF METER CENTER

METER CENTER BY KGE
INSTALLED BY ELEC. CONTR.
(TYPICAL) SEE DETAIL "A"
THIS SHEET.

UNDERGROUND
SERVICE. THE FIRST LOT
SICKLE FOR ALL REPAIRS, \$1.00 PER
DAY. NO. 2. \$1.00 PER FIFTY FEET.
VEHICLE NO. 4. \$1.00 PER

* SECTION 4.3

NOTE: SJLWEN ¹WARS TO THE ARMS CROSS ²PER ³15/11 1968 ⁴20
 1/10/1968 was ⁵WEDNESDAY 11/11/1968 ⁶11/11/1968 ⁷11/11/1968
 11/11/1968 ⁸11/11/1968 ⁹11/11/1968 ¹⁰11/11/1968
 11/11/1968 ¹¹11/11/1968 ¹²11/11/1968 ¹³11/11/1968
 11/11/1968 ¹⁴11/11/1968 ¹⁵11/11/1968 ¹⁶11/11/1968
 11/11/1968 ¹⁷11/11/1968 ¹⁸11/11/1968 ¹⁹11/11/1968
 11/11/1968 ²⁰11/11/1968 ²¹11/11/1968 ²²11/11/1968
 11/11/1968 ²³11/11/1968 ²⁴11/11/1968 ²⁵11/11/1968
 11/11/1968 ²⁶11/11/1968 ²⁷11/11/1968 ²⁸11/11/1968
 11/11/1968 ²⁹11/11/1968 ³⁰11/11/1968 ³¹11/11/1968
 11/11/1968 ³²11/11/1968 ³³11/11/1968 ³⁴11/11/1968
 11/11/1968 ³⁵11/11/1968 ³⁶11/11/1968 ³⁷11/11/1968
 11/11/1968 ³⁸11/11/1968 ³⁹11/11/1968 ⁴⁰11/11/1968
 11/11/1968 ⁴¹11/11/1968 ⁴²11/11/1968 ⁴³11/11/1968
 11/11/1968 ⁴⁴11/11/1968 ⁴⁵11/11/1968 ⁴⁶11/11/1968
 11/11/1968 ⁴⁷11/11/1968 ⁴⁸11/11/1968 ⁴⁹11/11/1968
 11/11/1968 ⁵⁰11/11/1968 ⁵¹11/11/1968 ⁵²11/11/1968
 11/11/1968 ⁵³11/11/1968 ⁵⁴11/11/1968 ⁵⁵11/11/1968
 11/11/1968 ⁵⁶11/11/1968 ⁵⁷11/11/1968 ⁵⁸11/11/1968
 11/11/1968 ⁵⁹11/11/1968 ⁶⁰11/11/1968 ⁶¹11/11/1968
 11/11/1968 ¹⁵⁵11/11/1968 ¹⁵⁶11/11/1968 ¹⁵⁷11/11/1968
 11/11/1968 ¹⁵⁸11/11/1968 ¹⁵⁹11/11/1968 ¹⁶⁰11/11/1968
 11/11/1968 ¹⁶¹11/11/1968 ¹⁶²11/11/1968 ¹⁶³11/11/1968
 11/11/1968 ¹⁶⁴11/11/1968 ¹⁶⁵11/11/1968 ¹⁶⁶11/11/1968
 11/11/1968 ¹⁶⁷11/11/1968 ¹⁶⁸11/11/1968 ¹⁶⁹11/11/1968
 11/11/1968 ¹⁷⁰11/11/1968 ¹⁷¹11/11/1968 ¹⁷²11/11/1968
 11/11/1968 ¹⁷³11/11/1968 ¹⁷⁴11/11/1968 ¹⁷⁵11/11/1968
 11/11/1968 ¹⁷⁶11/11/1

10	100	100	100
1	100	100	100
2	100	100	100
3	100	100	100
4	100	100	100
5	100	100	100
6	100	100	100
7	100	100	100

[illegible]

Water main extension, into lower main; and stream down to main line.

Gas main and service to High St. Gas Service Co.

All other services / 4 PRC schools to District Court. 1 meter to, 4000 ft. North West - 1000 ft. South



Pl. Domestic Sewers. 4" PVC 54' T. 1

[illegible]

about 1919
the 1st of 1919

street number

Install stubs in man holes as

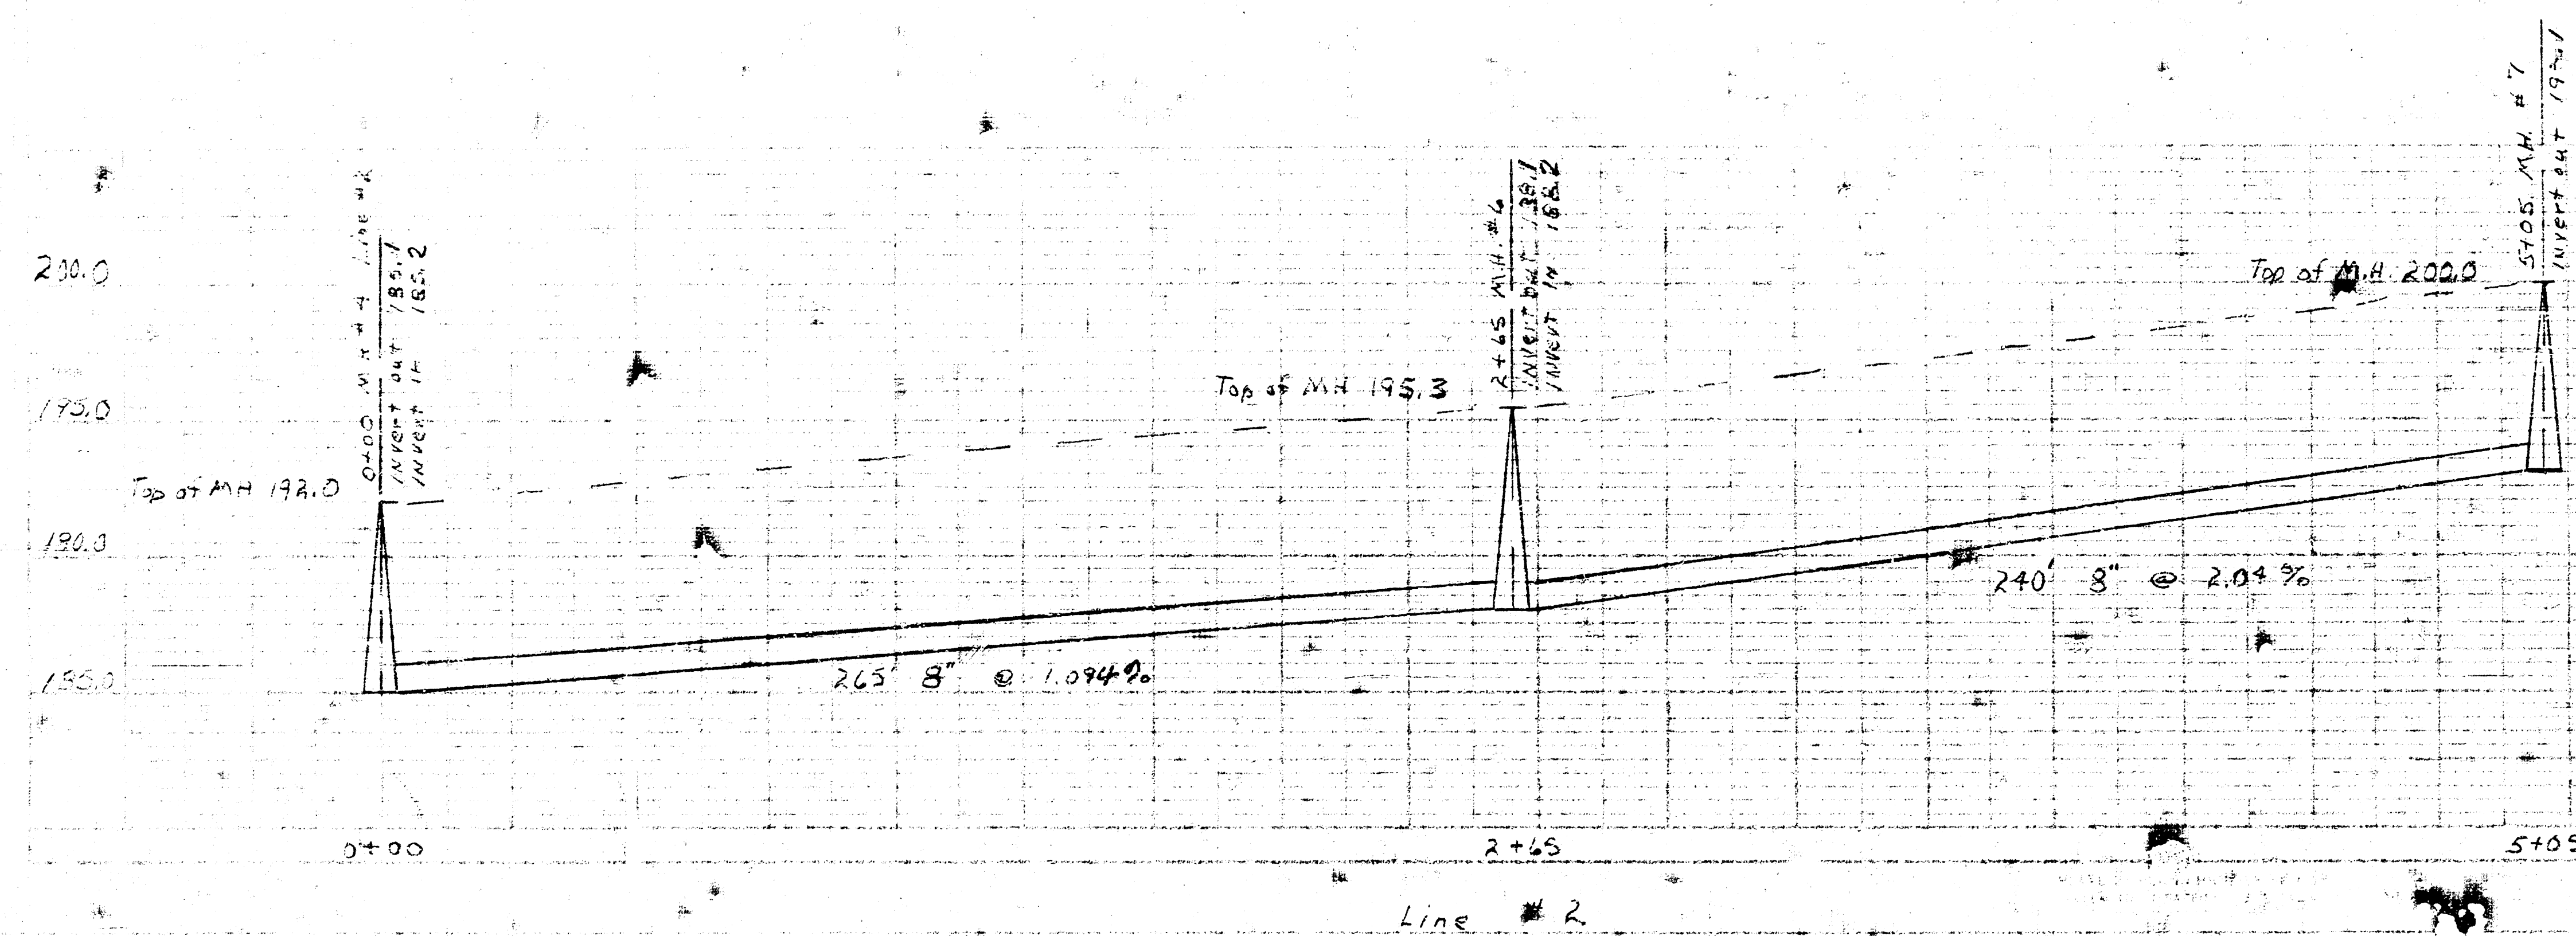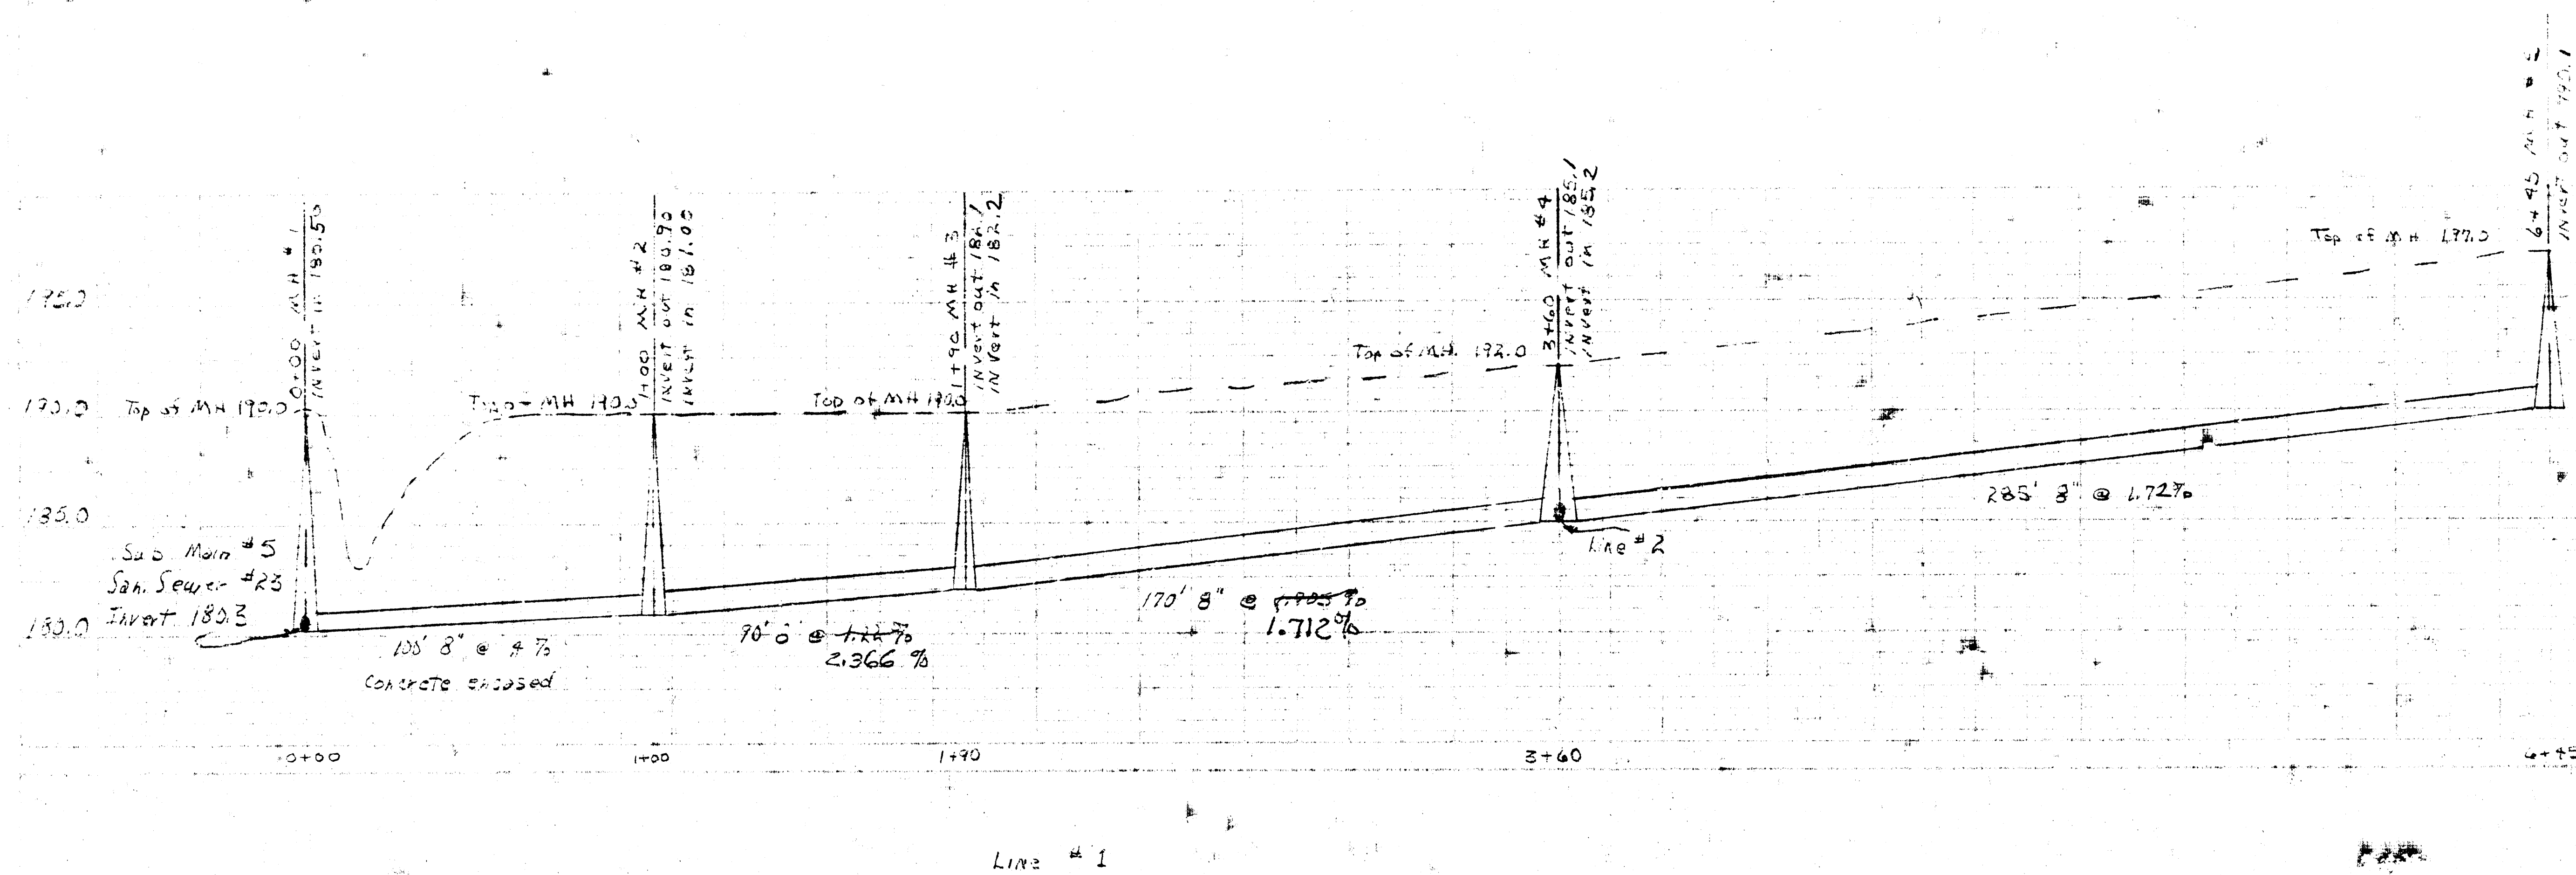

PRAIRIE VILLA SAN SEWER PROFILE

14 3 3 1