

SANITARY SEWER

LATERAL 34 MAIN 5A WAR INDUSTRIAL SEWER IN ROCKWOOD SOUTH 5TH ADD.

PROJ. NO. 468-76-245-80787-000-000-001


CITY OF WICHITA, KANSAS

DEPT. OF PUBLIC WORKS—ENG. DIV.

DEAN SELLERS, ACTING CITY ENGINEER

BY LAW/KINGDON, P.A., WICHITA, KANSAS

DATE: _____

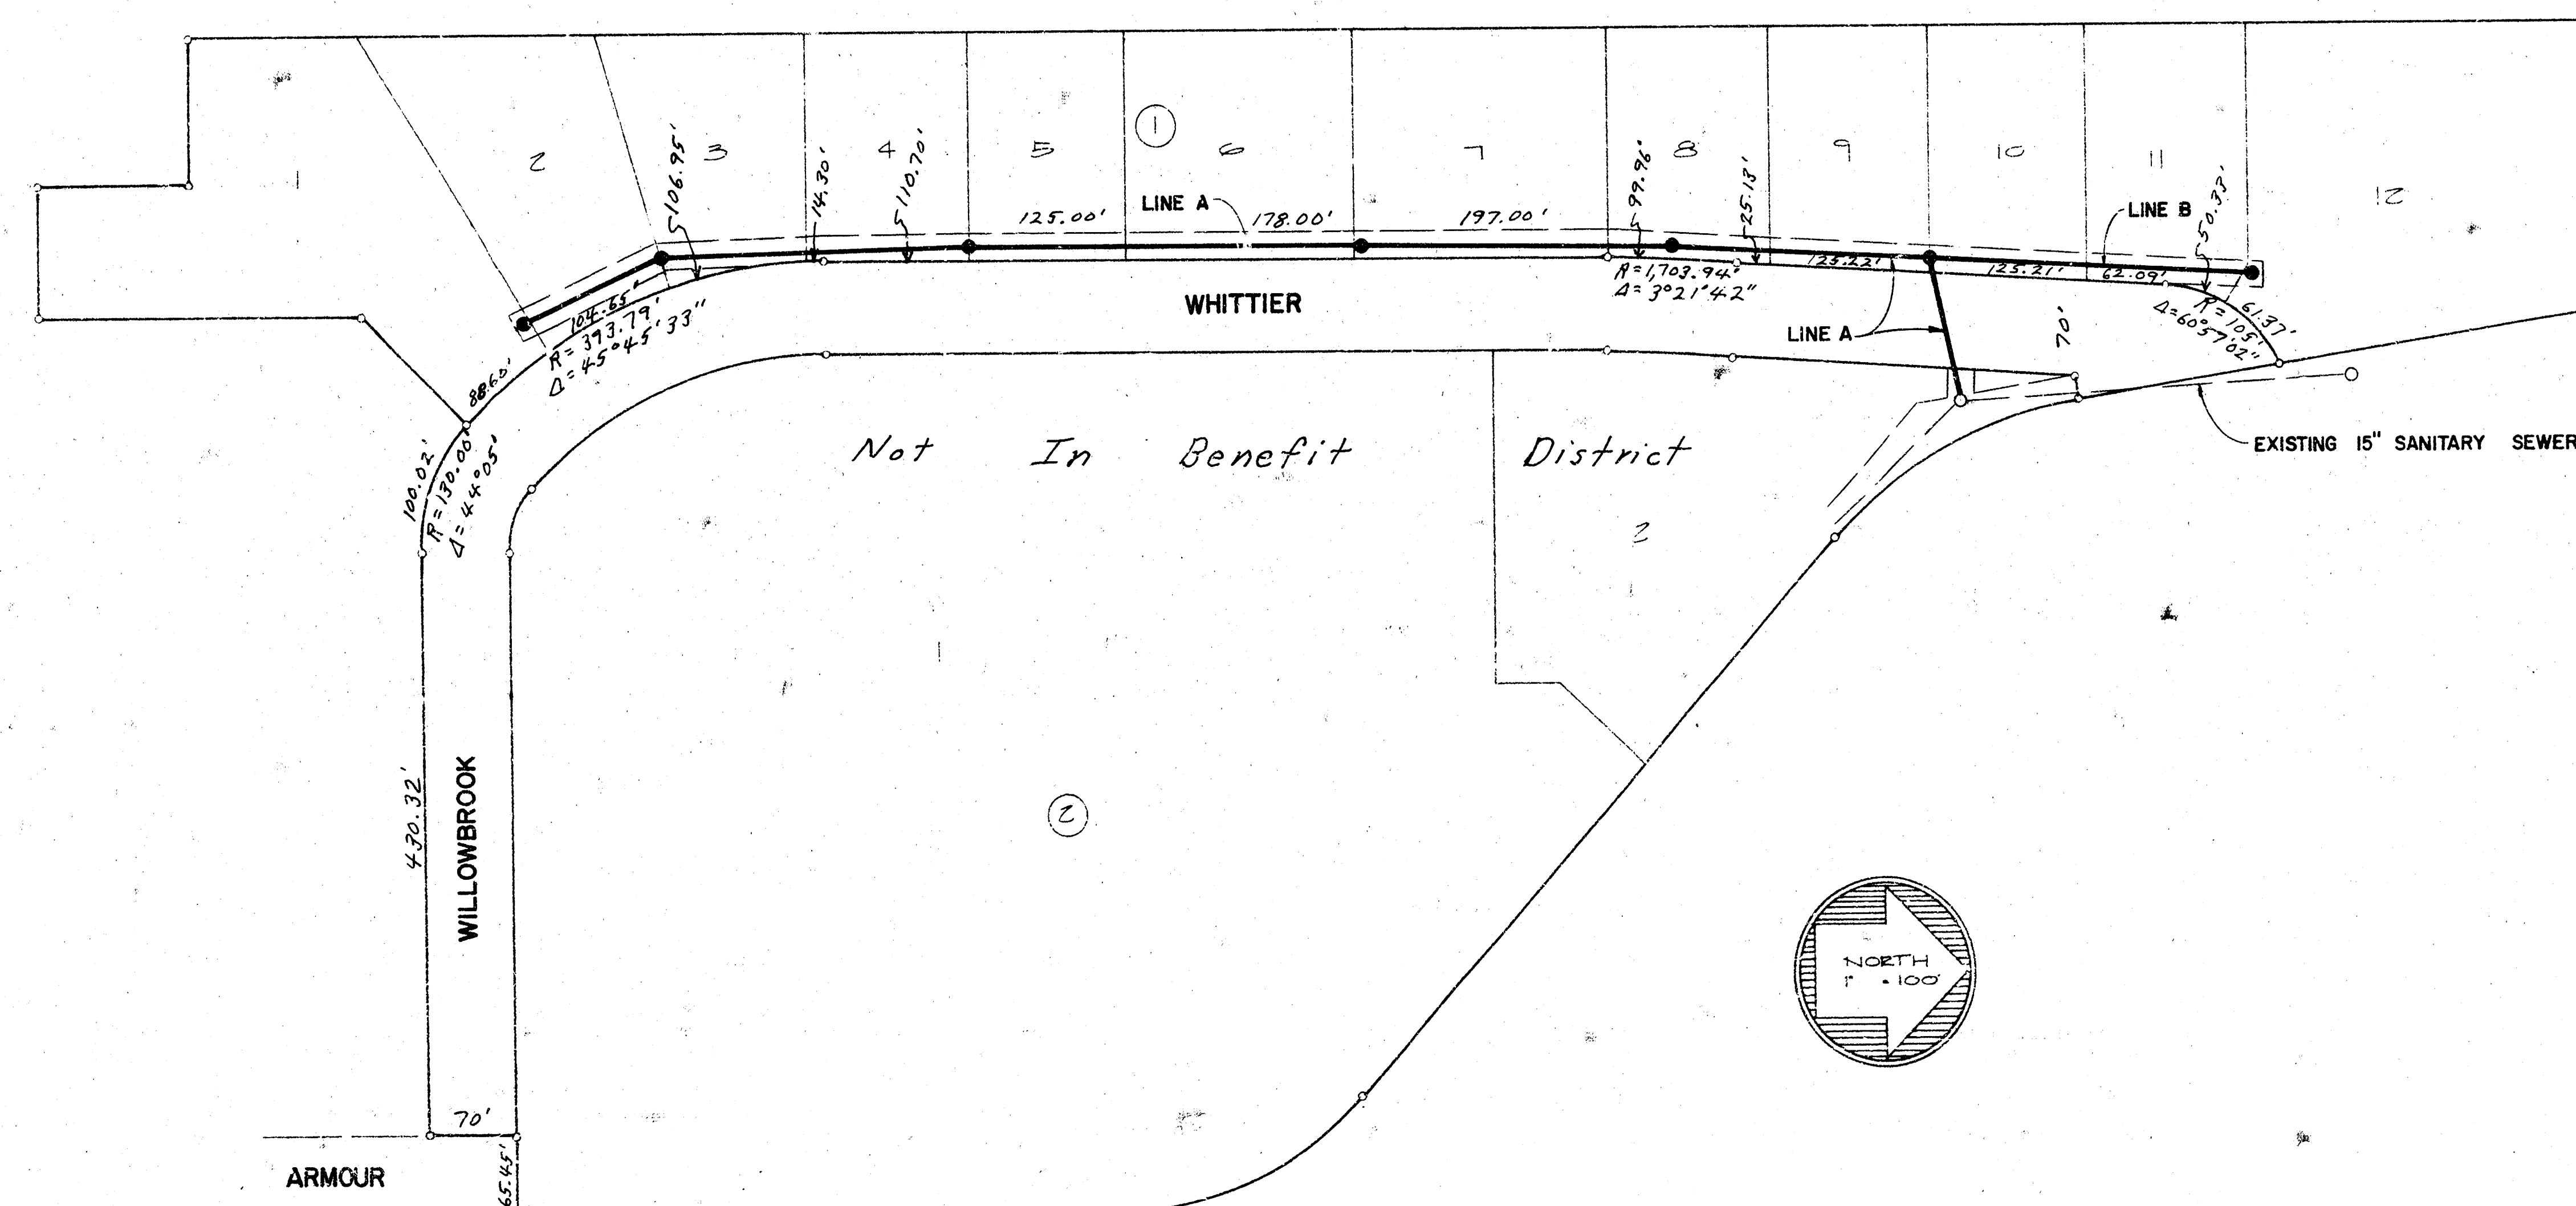

As Built
4/8/81
J.S.

