


B. M. 167.69 Rock Rd. & Central City B. M. a chiseled on S.E. cor. conc. valve box NW cor. intersection S. N. of N. cb on Central.

B. M. 156.23 set a chiseled on S.E. cor. conc. pkg. lot behind Privy Shop 366 # Rock Rd.

Sta. 0100.0 Const. Std. M. H. Type "A" over exist. 12" S.S.

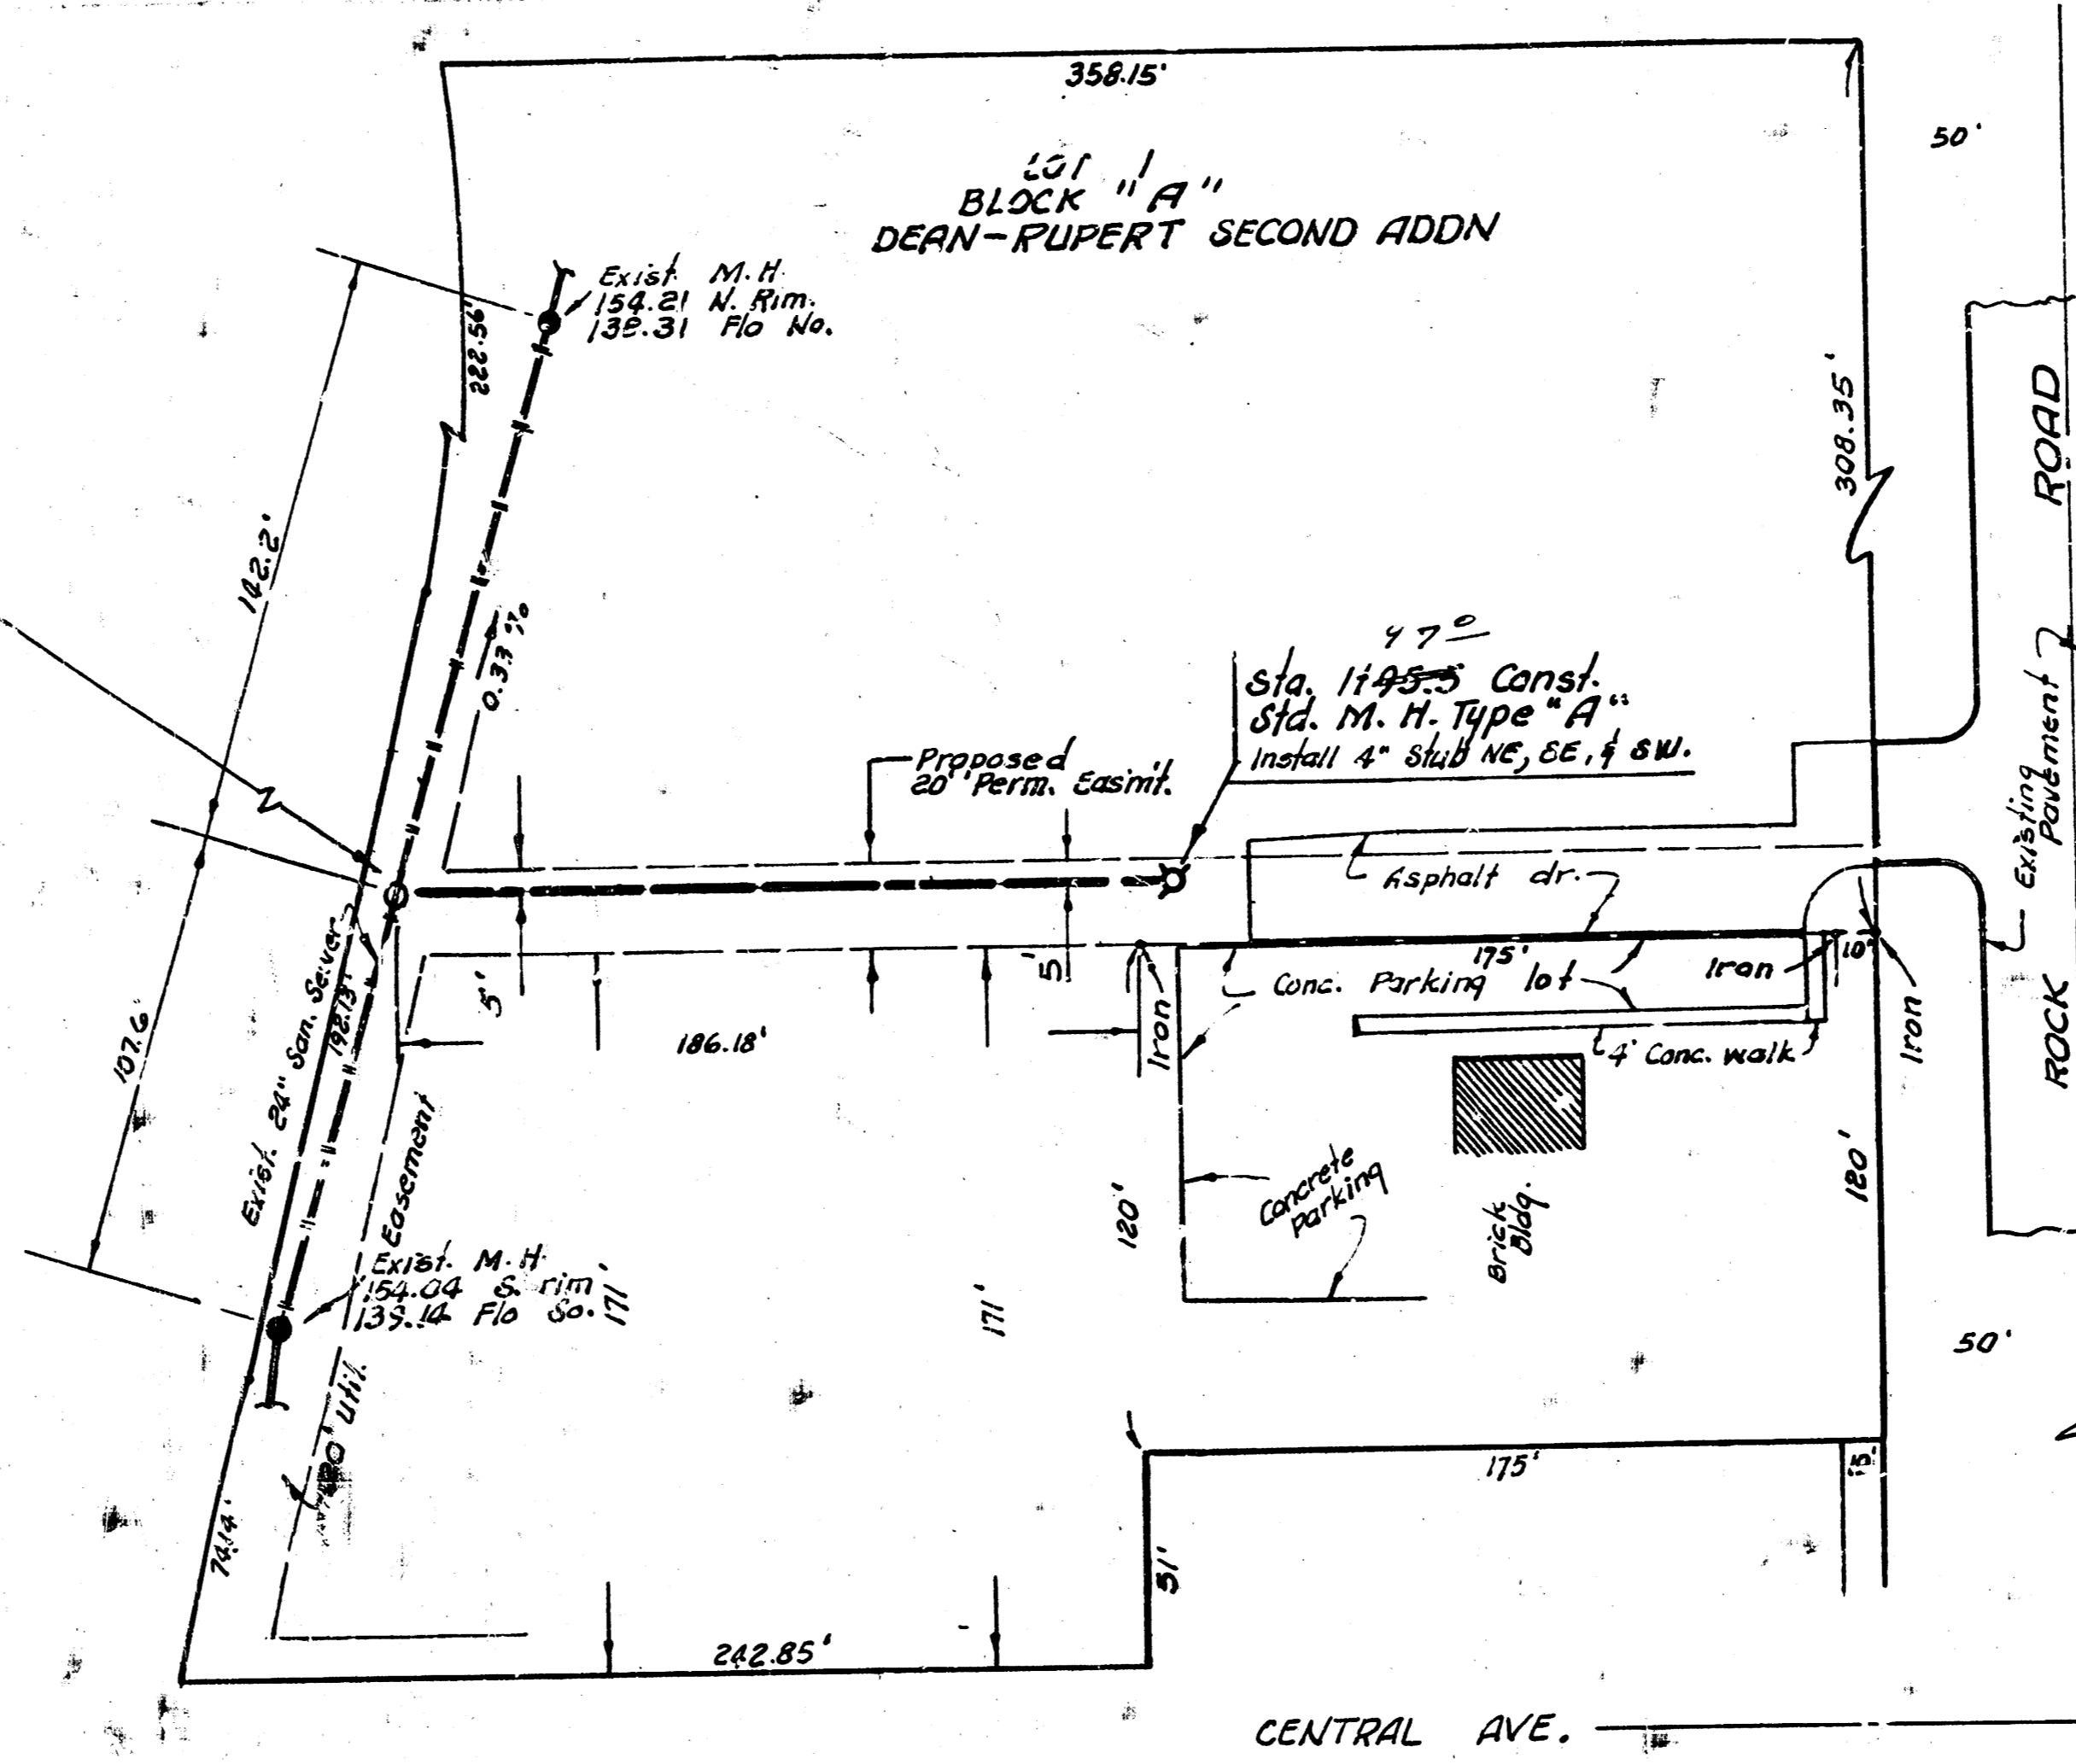

Plan Scale 1" = 40'
Profile Scale 1" = 5' Vert.


A.R.W.

76


Sta. 0100.0 Const. Std. M. H. Type "A" over exist. 12" S.S.

Sta. 1195.5 Const. Std. M. H. Type "A" install 4" slab NE, SE & SW.

160
155
150
145
140
135

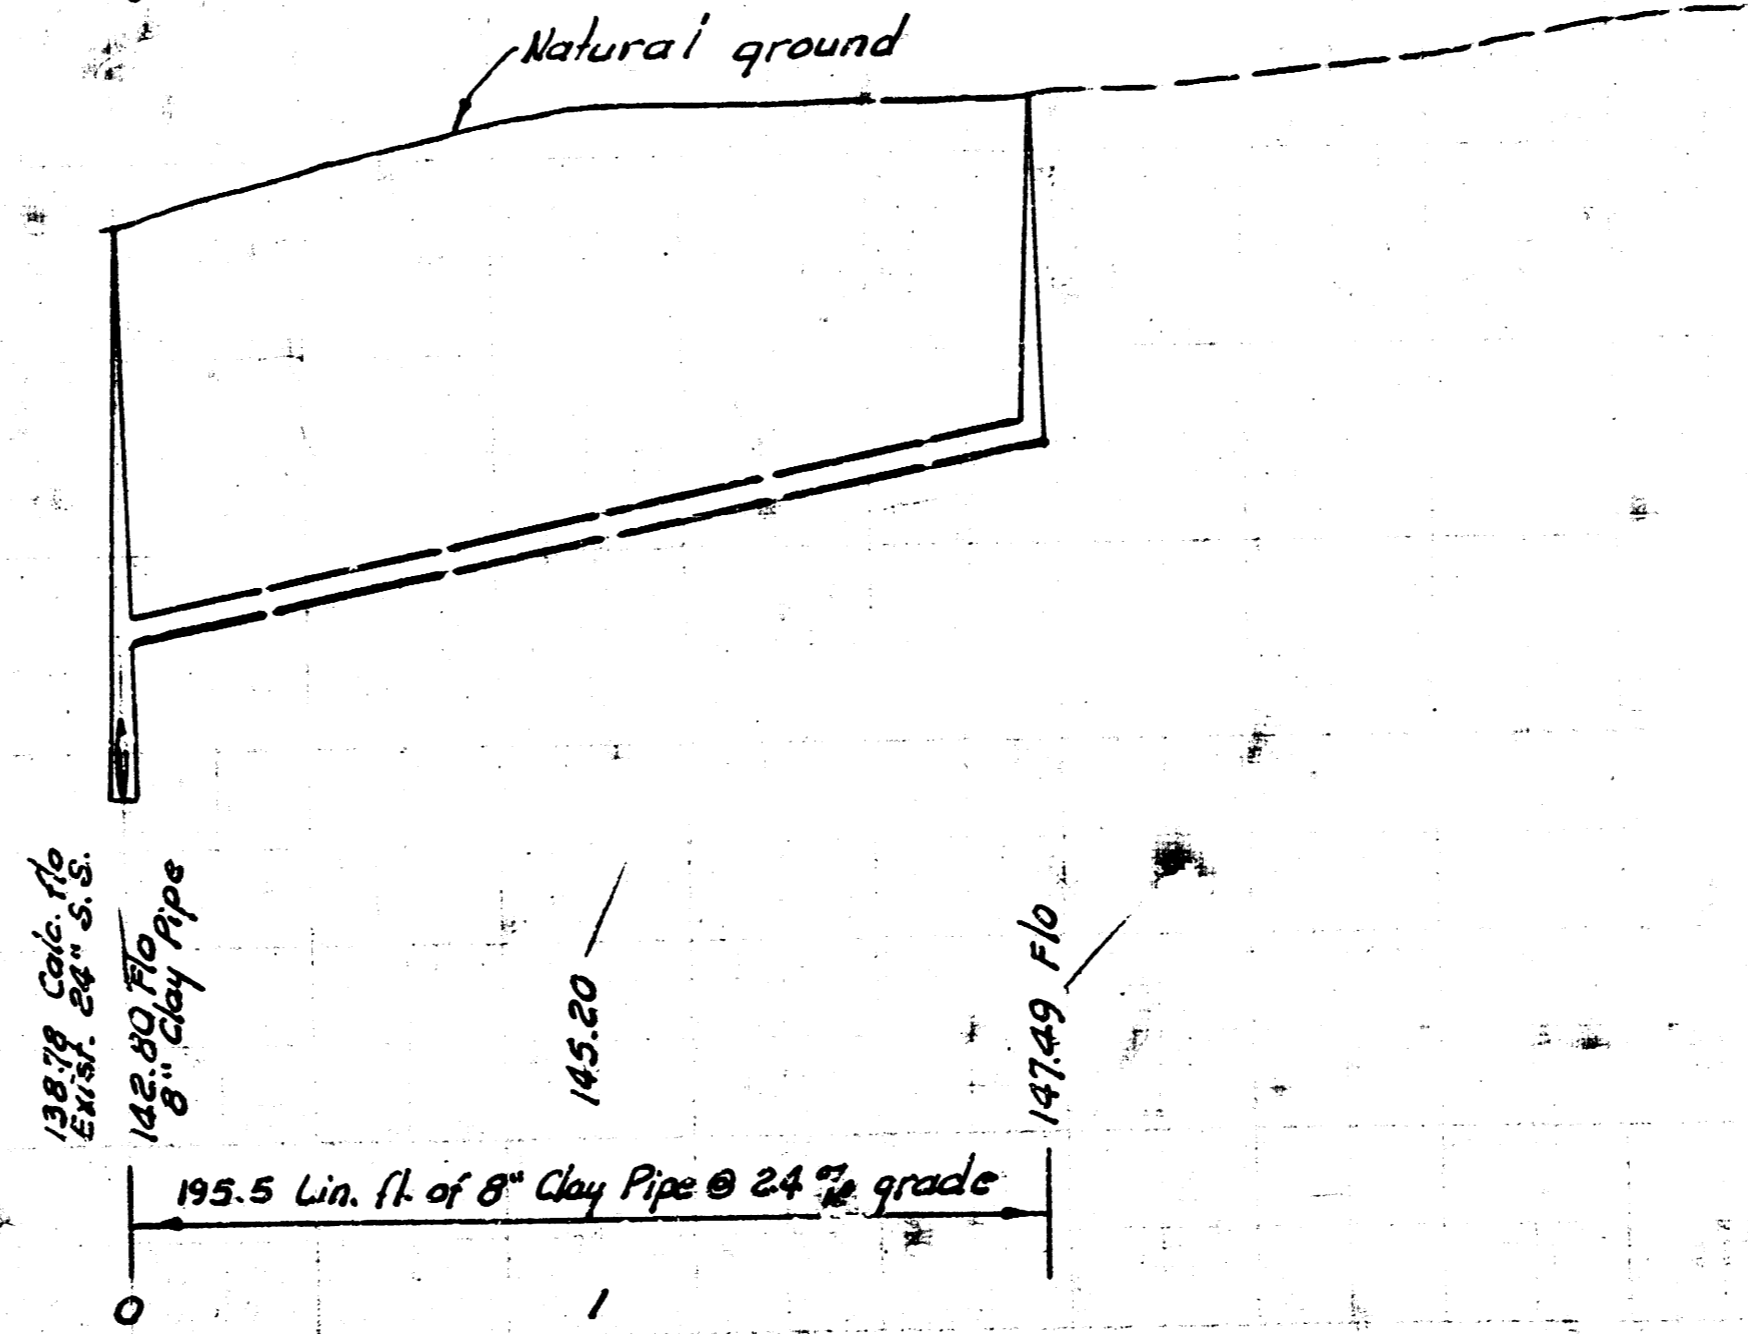

160
155
150
145
140
135

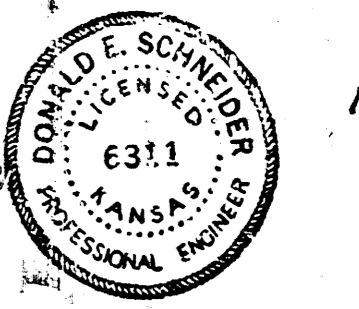

As Built Final Plans TH-75
LAT. 22, MAIN 9, W. I. S.
CITY OF WICHITA, KANSAS
R. W. LINN — CITY ENGINEER
MAR. 1974 PROJECT NO. DBKL574007

FILMED FROM THE BEST AVAILABLE COPY