



R-2, 117
R. Loomis

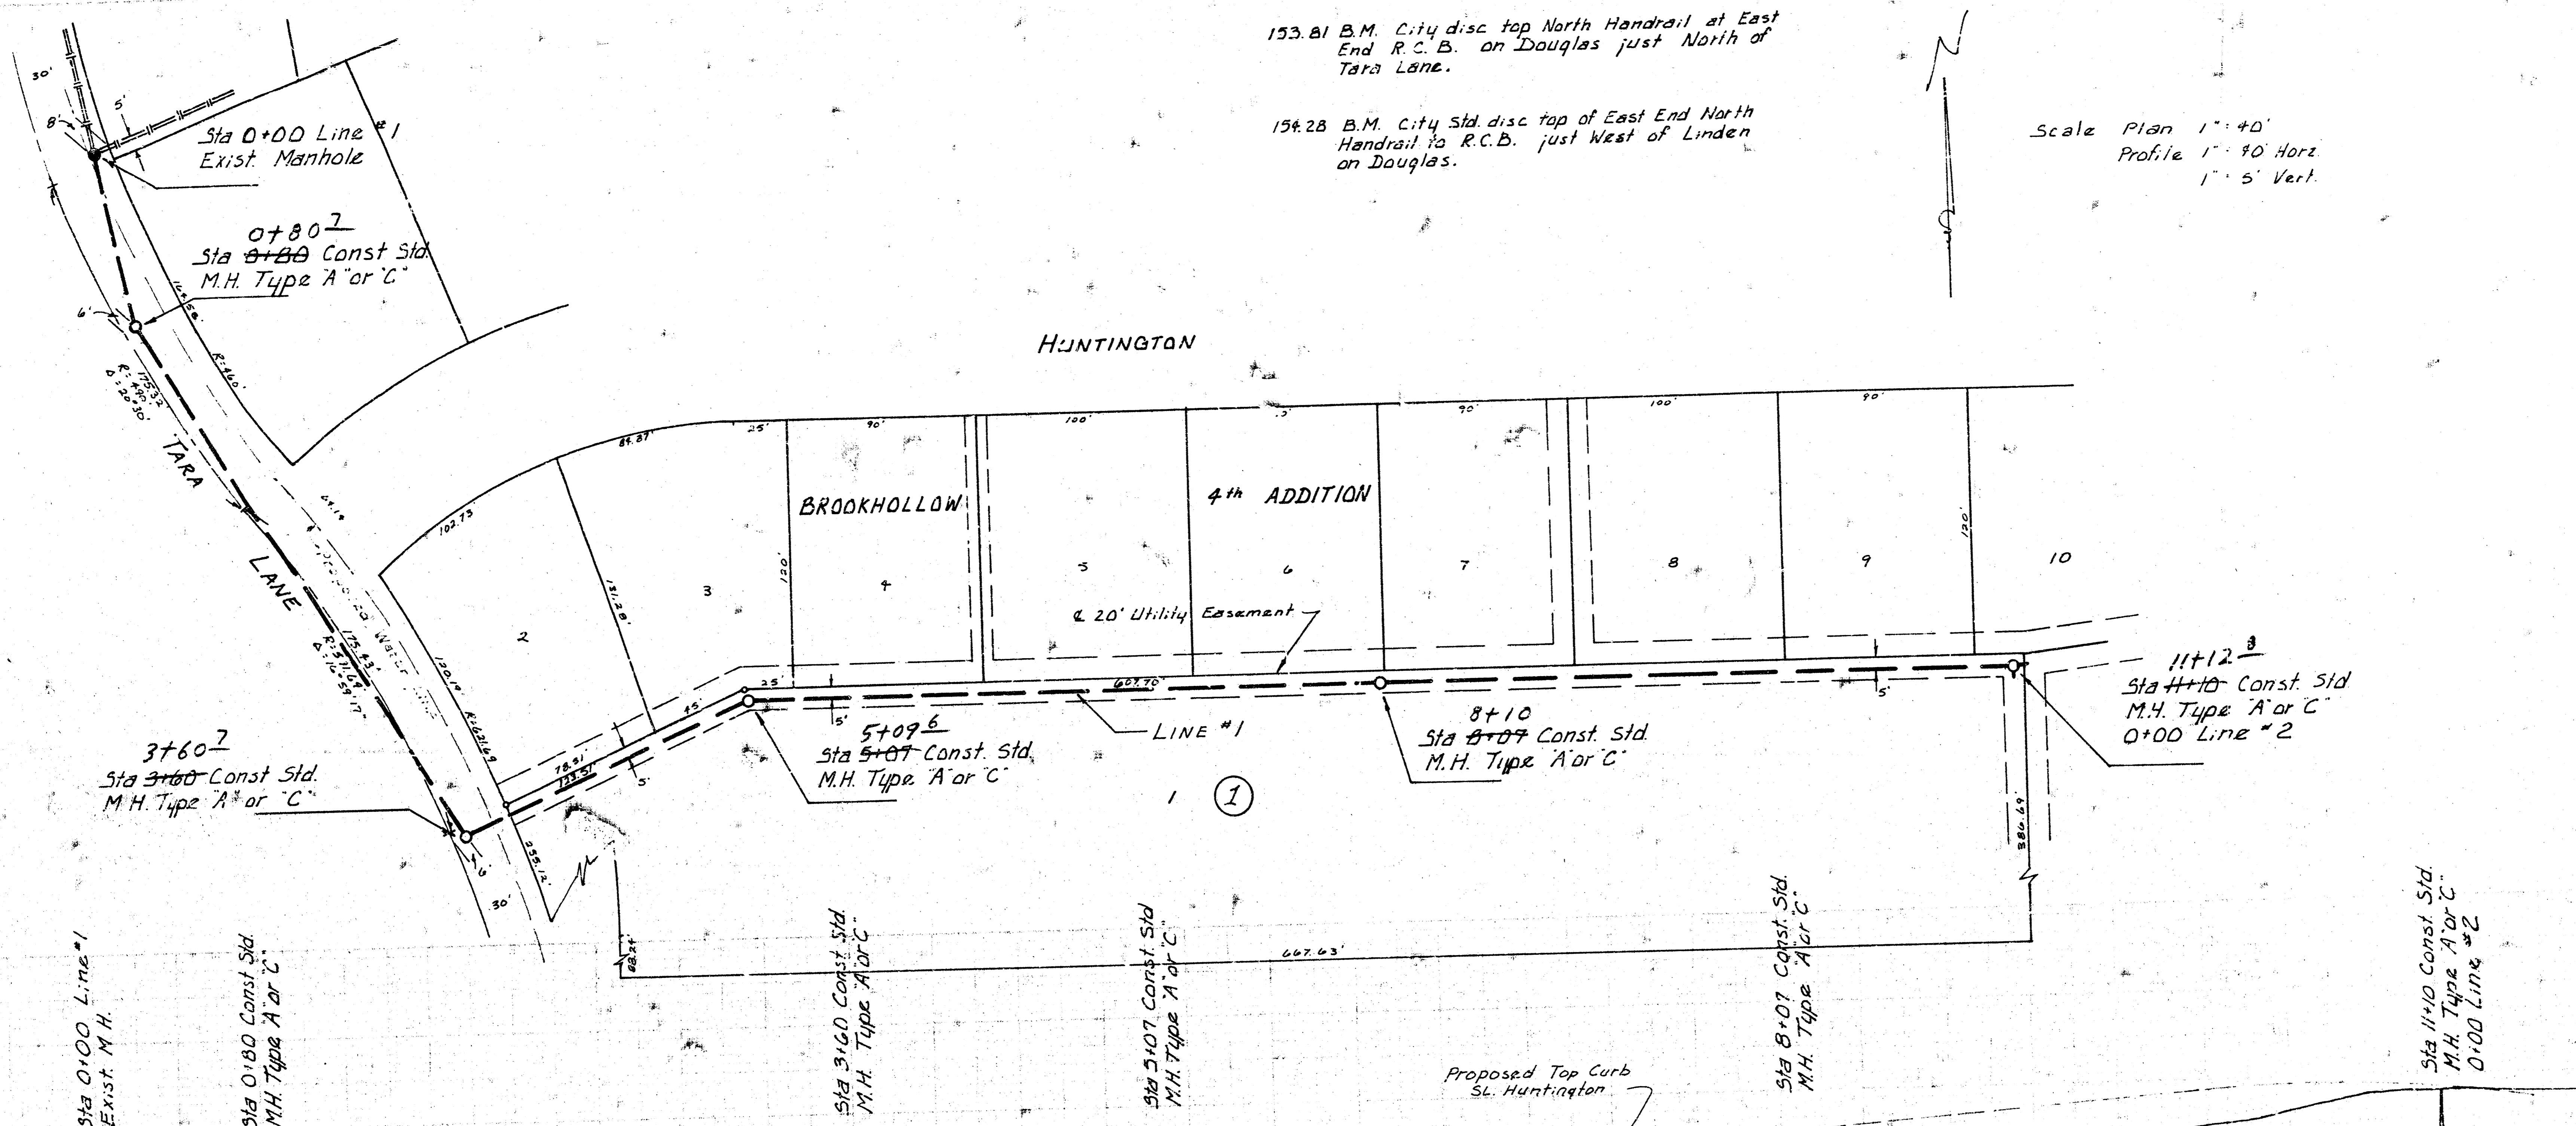

Scale Plan 1" = 40'
Profile 1" = 40' Horiz.
1" = 5' Vert.

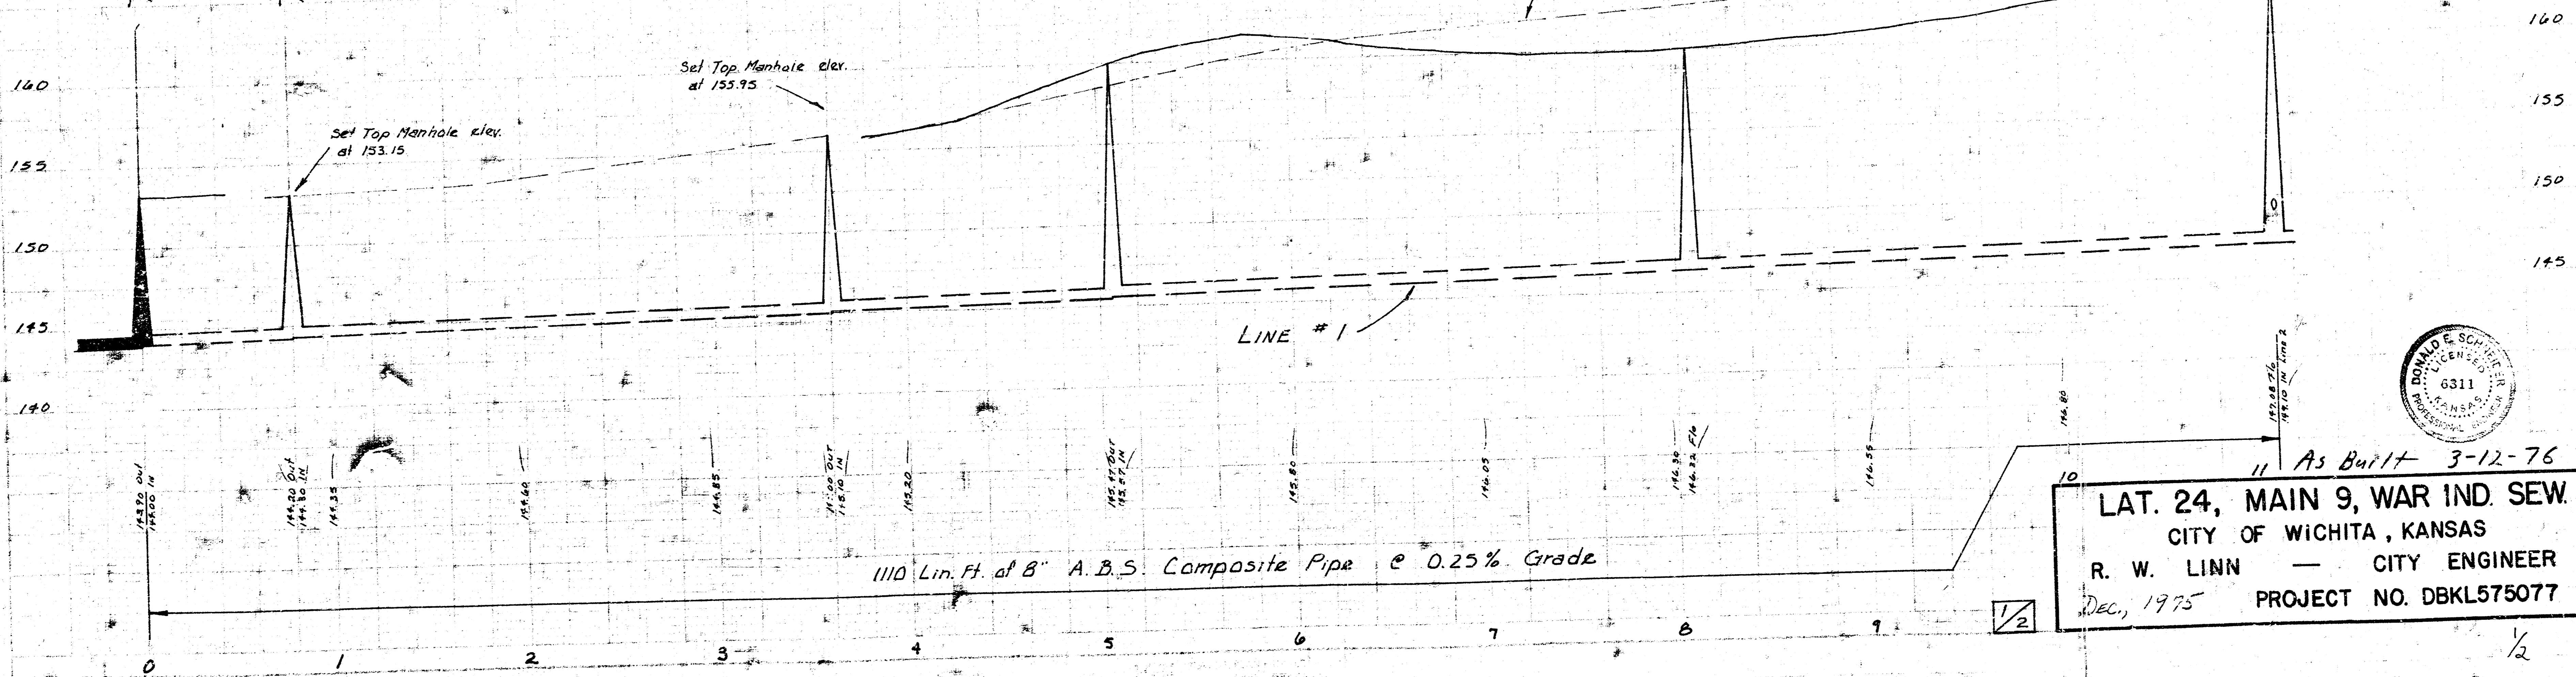

As Built 3-12-76
LAT. 24, MAIN 9, WAR IND. SEW.
 CITY OF WICHITA, KANSAS
 R. W. LINN — CITY ENGINEER
 Dec, 1975 PROJECT NO. DBKL575077

