



BM 172.8 City Std. at George Wash. Blvd. & 31st St. South
 BM 141.4 R.R. spike W. side large Elm Tree W. Side Geo. Wash. Blvd.
 Approx. 220' N. of N. Line of New Jersey Dr.
 BM 134.13 "X" cut on SE cor. conc. Paving, at NE Cor. Brick Apt.
 Bldg. No. 2904 Bunker Hill Dr.

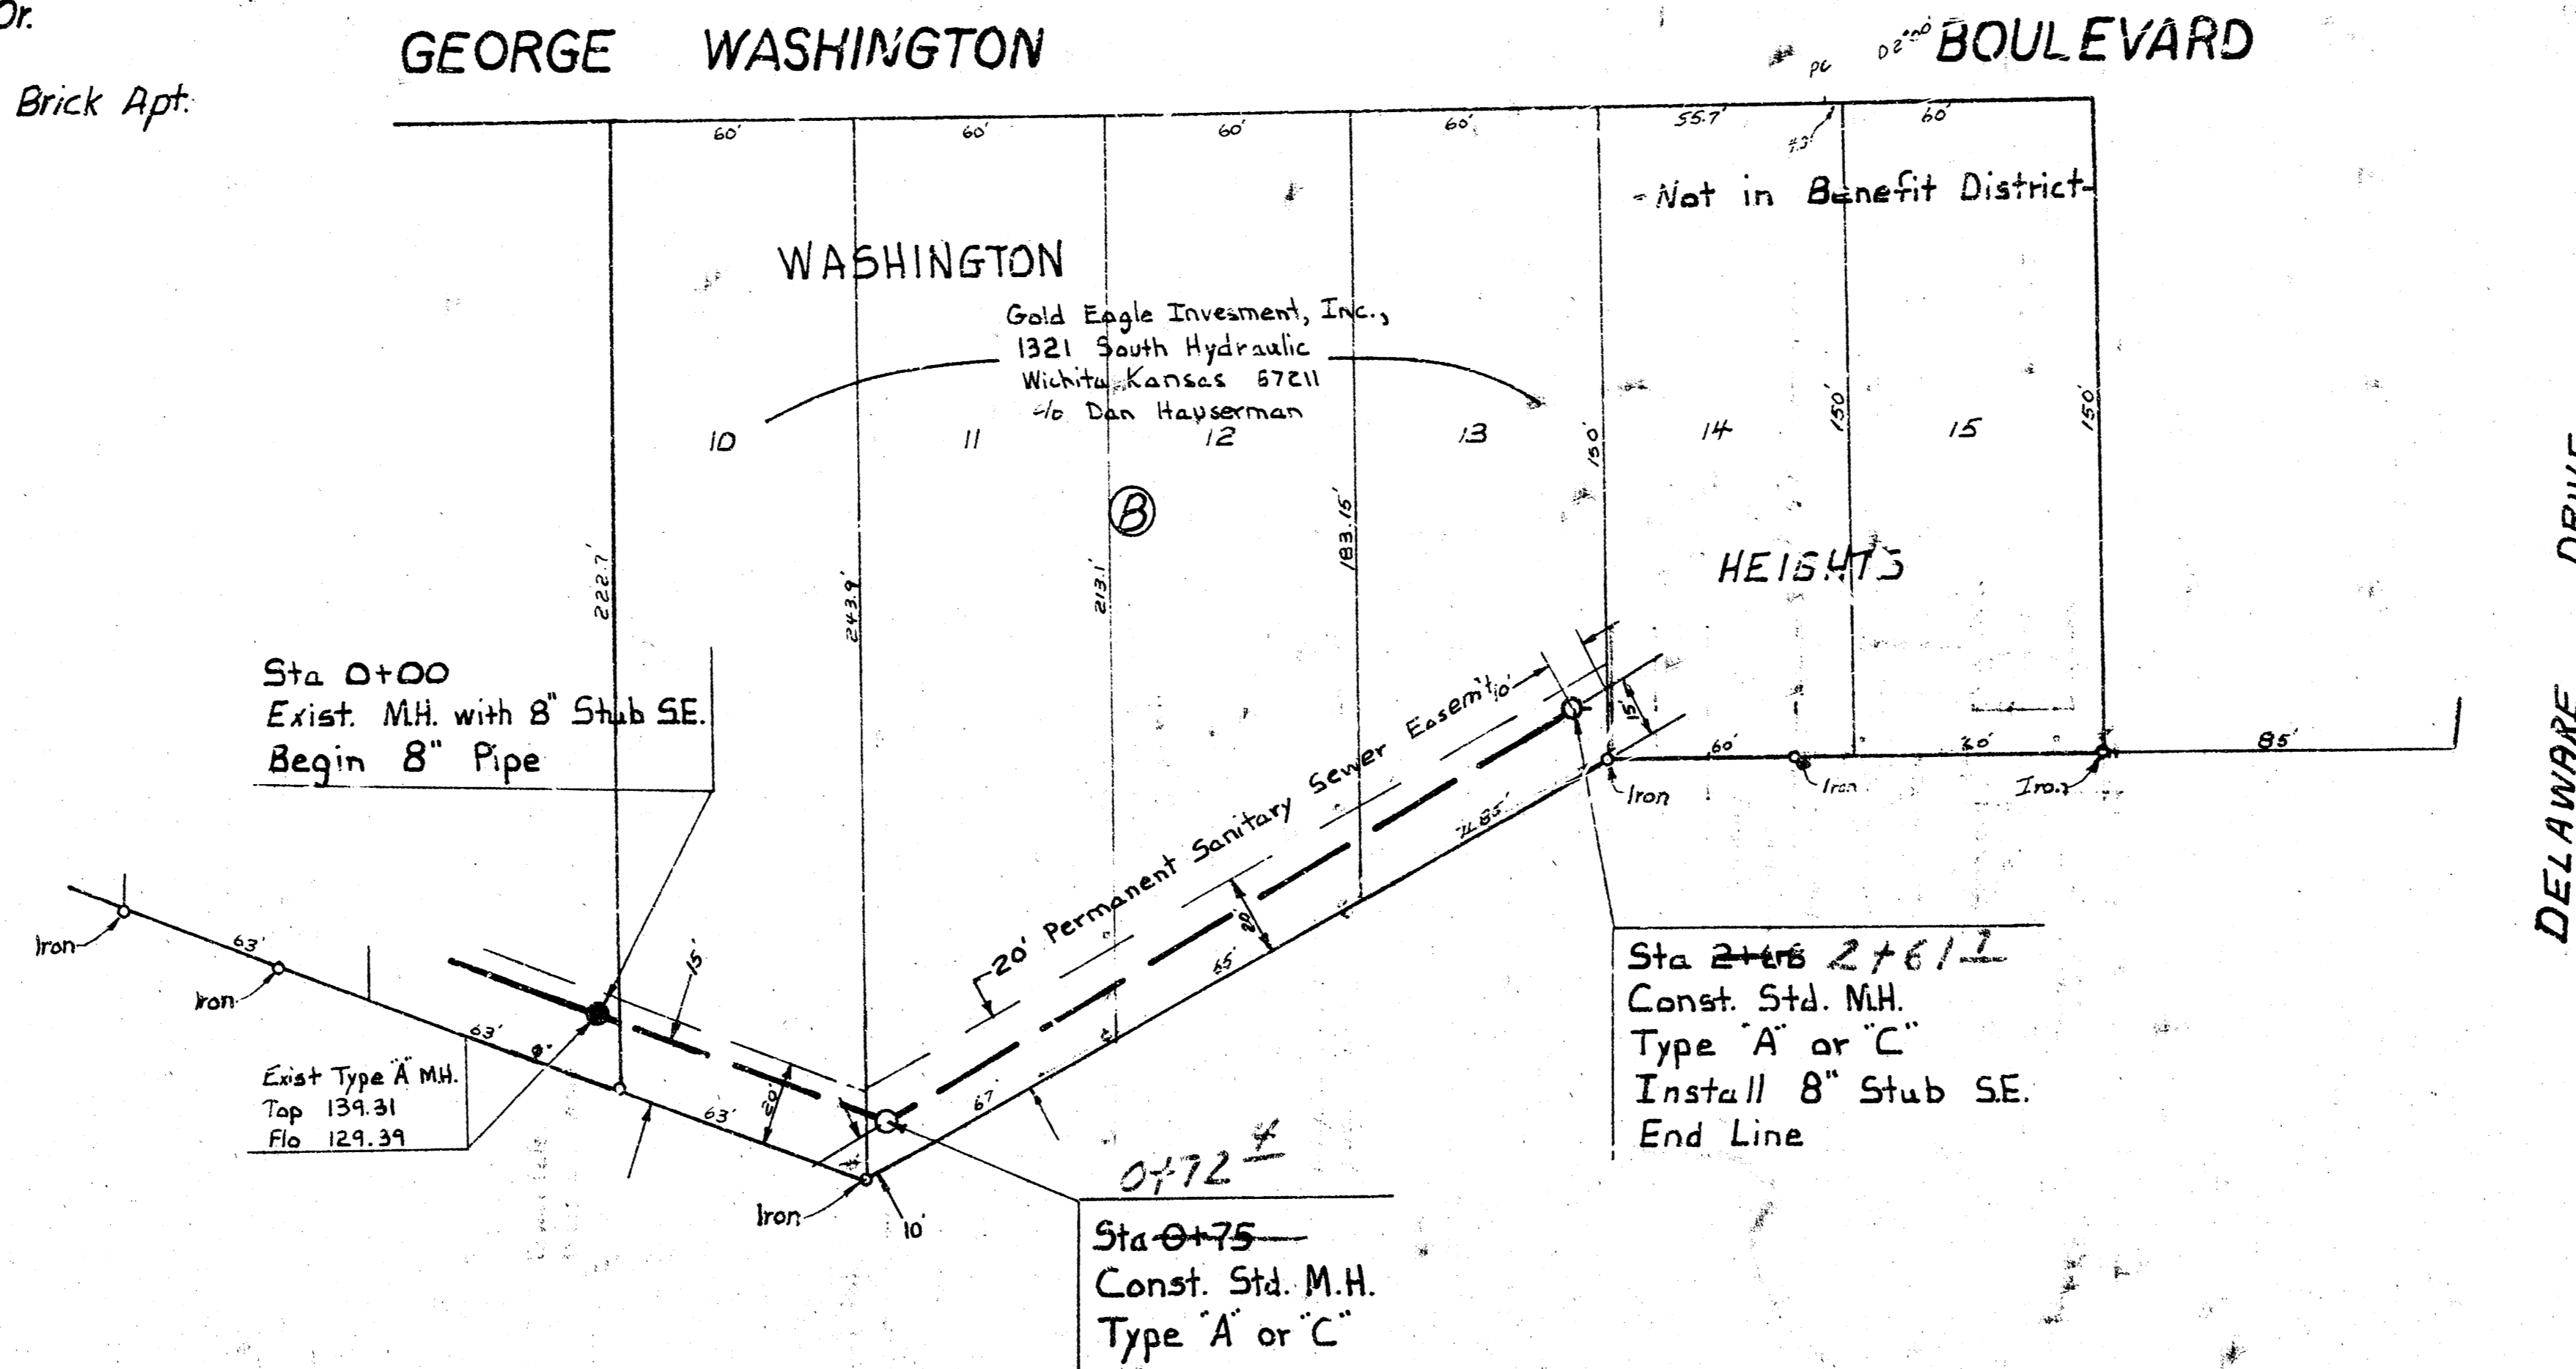

Plan Scale 1" = 40'
 Profile Scale 1" = 40' Horz.
 1" = 5' Vert.

150
 145
 140
 135
 130
 125

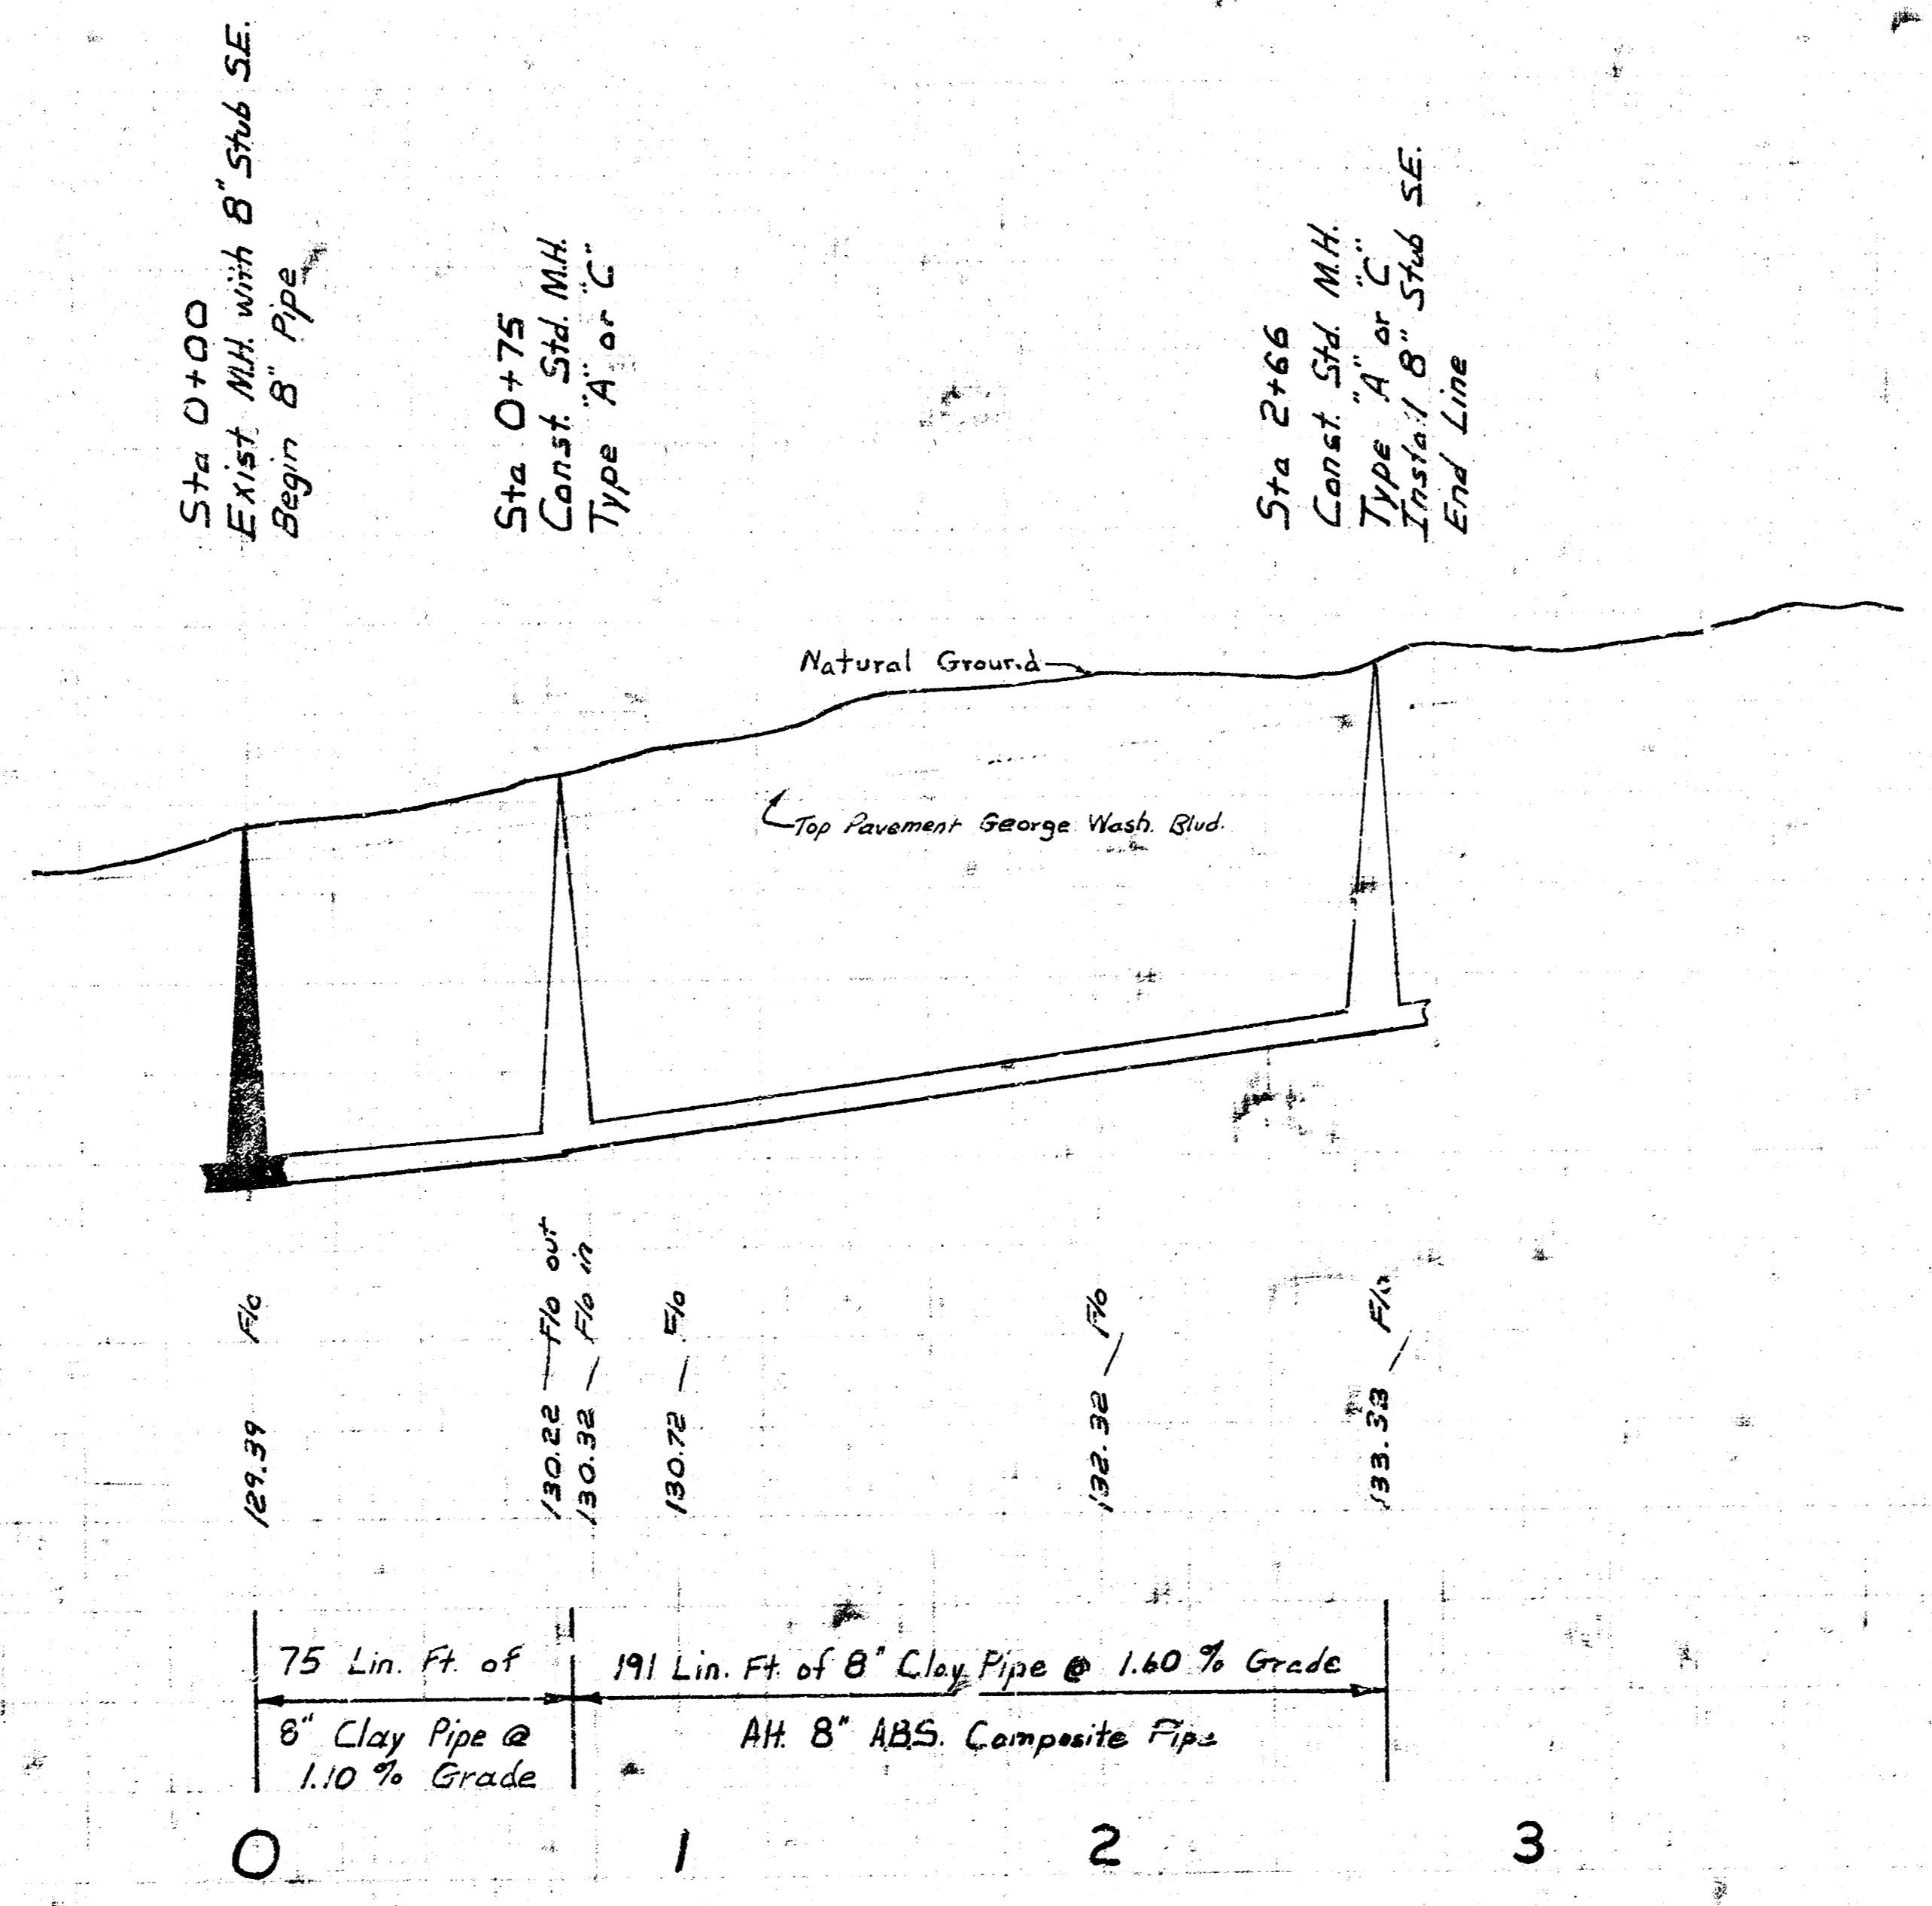

As built 4-15-77
 LAT. 15 MAIN IO WAR INDUST. SEWER
 CITY OF WICHITA, KANSAS
 R. W. LINN CITY ENGINEER
 November 1976 PROJECT NO DBKL 576049